

6422

Being 9 acres of land. Lying in the N E 1/4 of Sec. 19 and the S E 1/4 of Sec. 18 T 25 N 10 W. Commencing 420 ft. S and 421 ft. W of Sec. Corner 1718 1920 and running thence S 1 1/2° W 231 ft. Thence S 9 1/2° W 166 ft. Thence northerly and westerly along river to fence running N 86 1/2° W of commencement. Thence N 24 ft. Thence E 203 ft. Thence N 29 1/4° E 295.8 ft. Thence S 45 1/8° E 368 ft. to beginning.

Surveyed Nov. 16, 1908. E. Strong Surveyor

Dedication: We Alexander Price and Alzina Price his wife as proprietors have surveyed platted and named Price Addition, and dedicated fully by us the streets herein shown are given to public use.

In presence of

Silas A. Wright Alexander Price Owner Seal
Elaie Baldwin Alzina Price Owner Seal

State of Michigan County of Kalamazoo On this 2nd day of March 1909 before me a Notary Public in and for said County personally came the above named Alexander Price and Alzina Price his wife known to me to be the persons who executed this plat and acknowledged the same to be their free act and deed.

Wallace W. Baldwin Notary Public Com. expires March 30, 1911 Comstock Mich

Received for record March 28th 1909 at 3 o'clock P M and recorded in Book 8 of Plats on page 4

Examined and approved March 23, 1909 Nathan F. Simpson Register of Deeds Deputy Auditor General.

State of Michigan County of Kalamazoo We S. H. Carlton Register of Deeds and E. Strong Surveyor hereby certify that we have each carefully compared this copy with the original plat of Price Addition to Comstock and that it is an exact copy thereof and of the whole of such original plat.

S. H. Carlton Register of Deeds

Monuments	
a. Oak 16 West?	2 1/2 ft.
b. W. Ash 5 E?	2 "
c. River corner	10 "
d. Willow 7 S 5° W	5 "
e. " 7 S 8°	2 1/2 "
f. W Oak 24 N 70° W	7 1/2 "
g. fence West	7 1/2 "
h. W Oak 20 N 80° E	7 1/2 "
i. Choke Cherry 6 N 15° W	32 1/2 "
j. Walnut 20 S 15° E	37 1/2 "
k. Oak 10 S 45° W	11 1/2 "
l. Willow 12 N 10° W	8 "
m. " 7 South	9 "
n. Locust 12 N 40° E	15 1/2 "
o. Blue Ash 7 N 60° W	1 1/2 "
p. Maple Chump 12 South	20 1/2 "
q. Cherry 14 N 45° E	2 1/2 "
r. W Oak 14 N 75° E	18 "
s. " 24 S 45° E	23 "
t. W Oak 8 N 45° E	22 1/2 "
u. Common Trolley rail N	1 "
v. Maple 12 S 20° E	50 1/2 "
w. Pine 10 S 20° E	72 "
x. Iron stakes at all lot corners	

I hereby certify that I have made a survey of the above titled plat of land and as represented and have planted iron for monuments said monuments are found 18 1/4 x 1 1/4 at all intersections of streets and angles of the Plat marked O.

E. Strong Surveyor

State of Michigan County of Kalamazoo We S. H. Carlton Register of Deeds and E. Strong Surveyor hereby certify that we have each carefully compared the amended copy with the plat of Price Addition to Comstock now of record in the office of said Register of Deeds and that it is a true transcript therefrom and of the whole of such record.

S. H. Carlton Register of Deeds

STATE OF MICHIGAN


Notary Public

March 28, 1909

S. H. Carlton

Price Addition

To
Comstock
Kalamazoo County

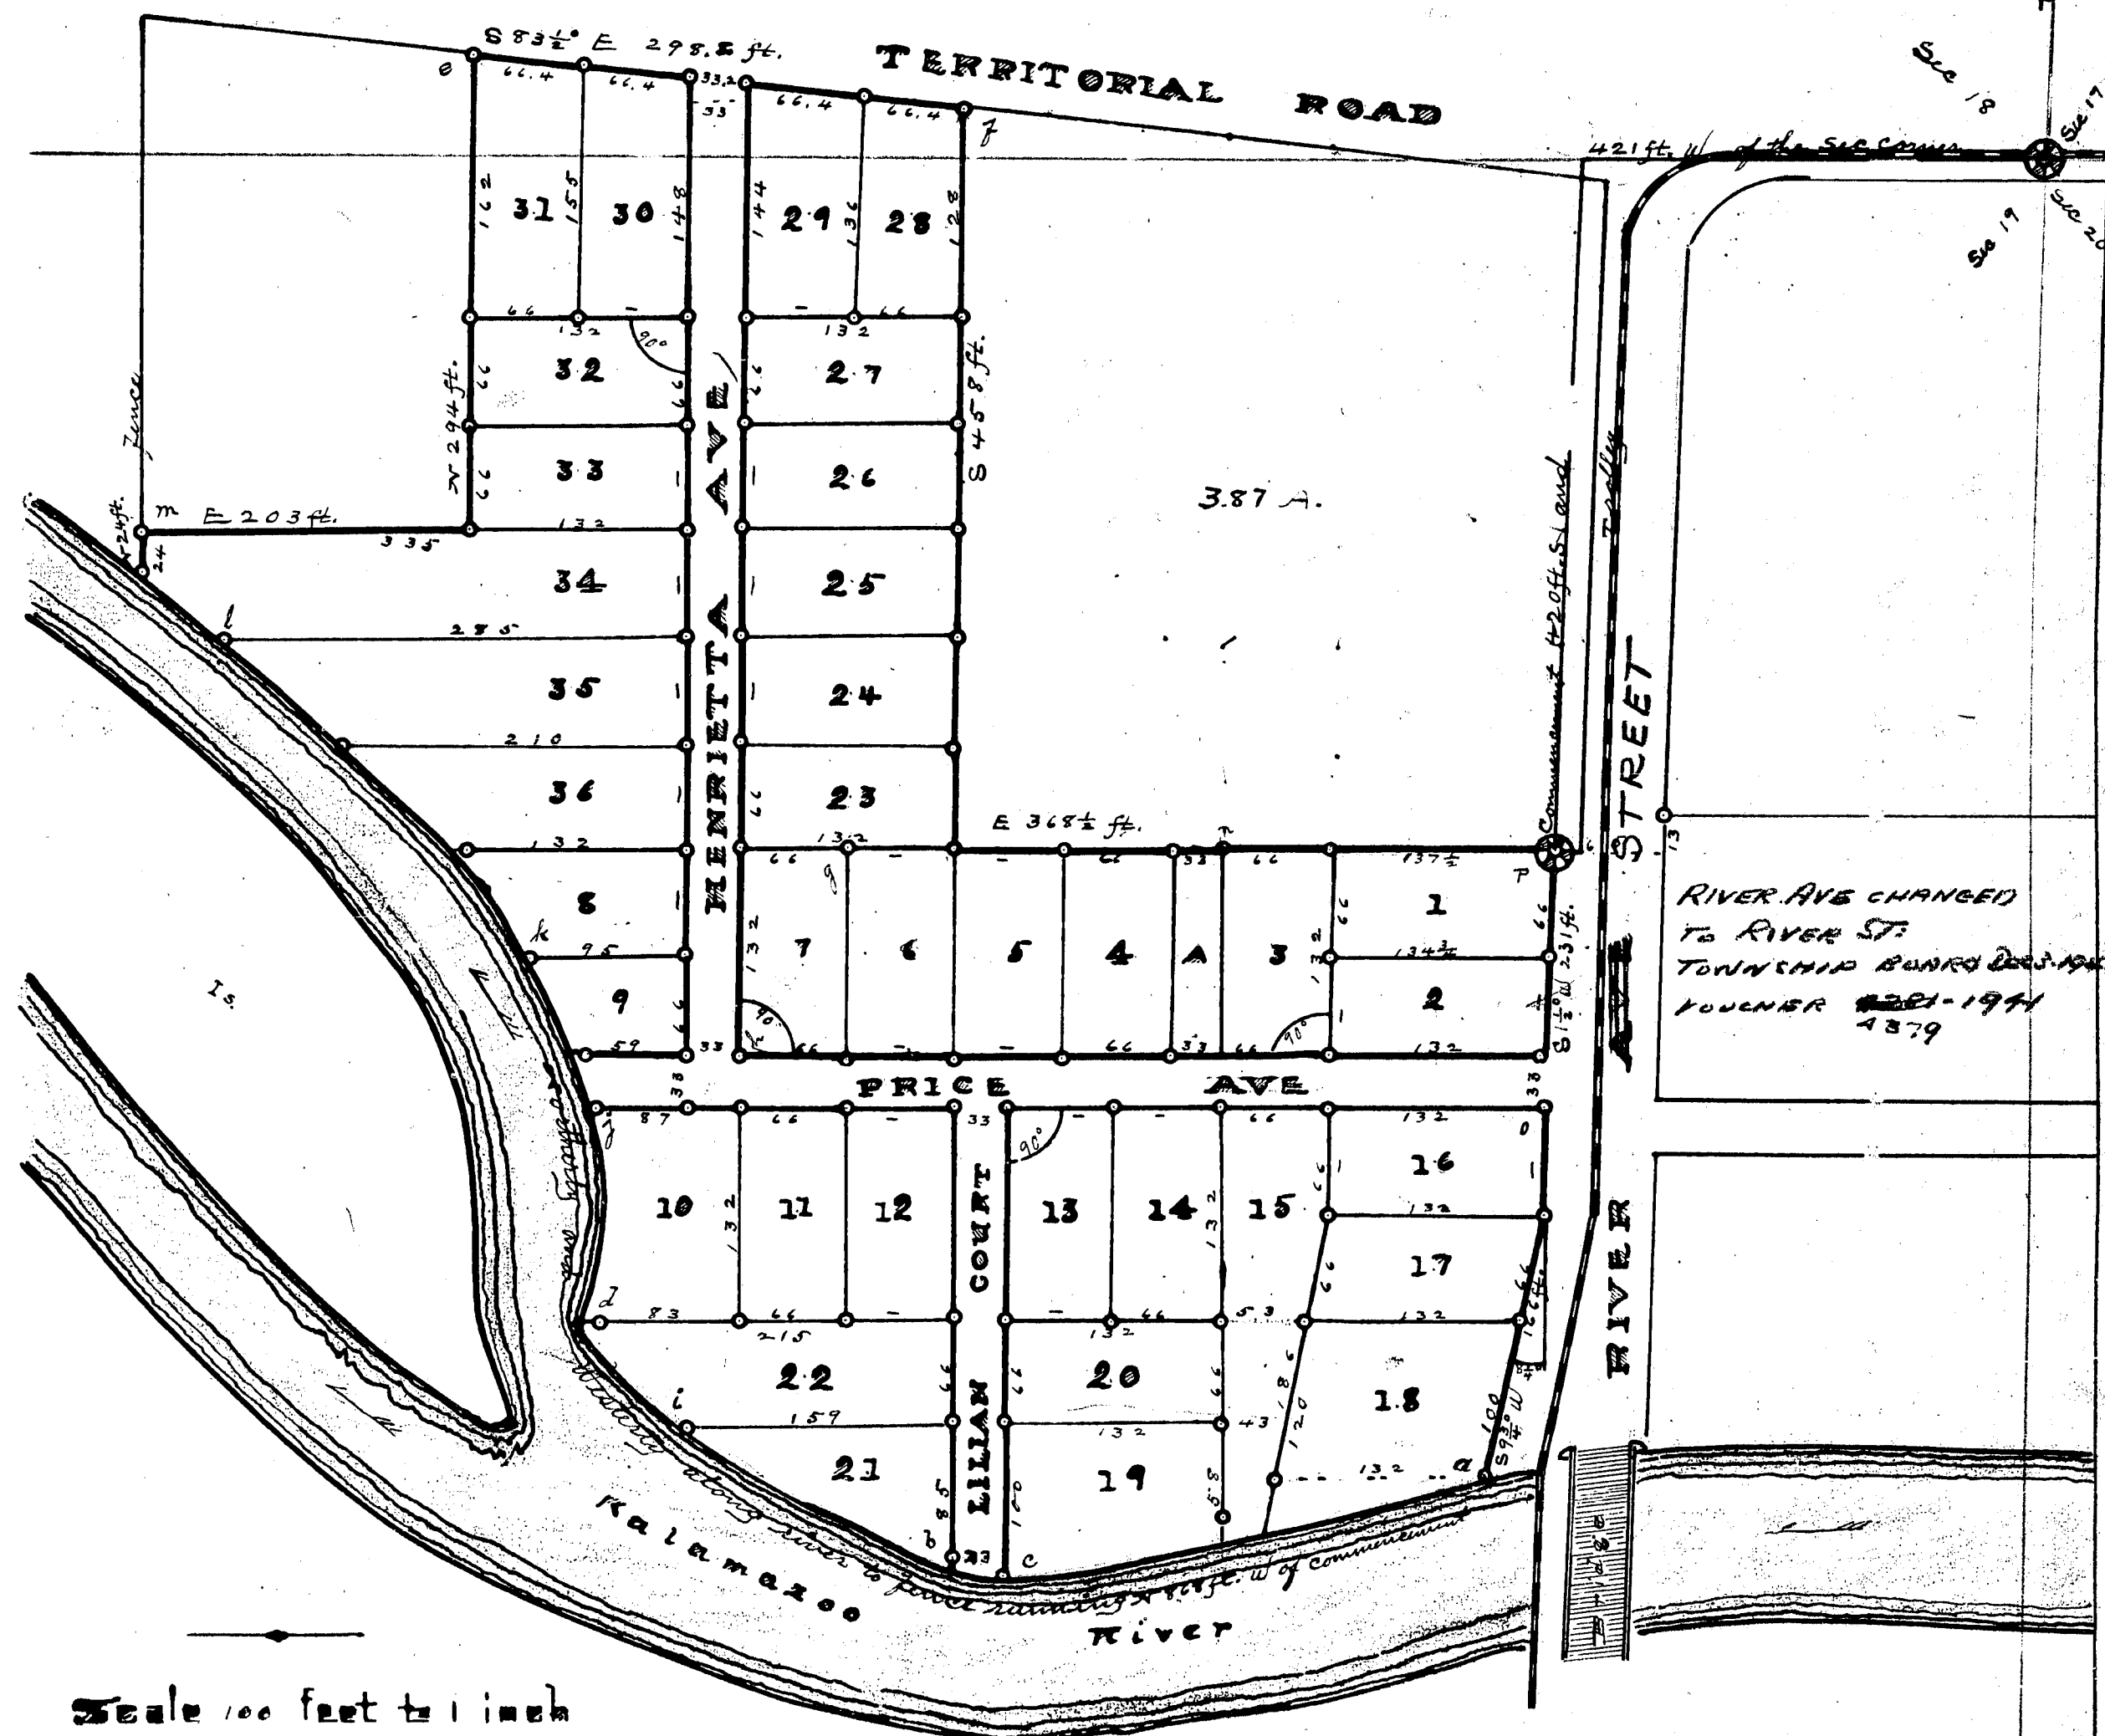

Scale 100 feet to 1 inch

RECEIVED AND FILED.
IN AUDITOR GENERAL'S OFFICE,

Nathan F. Simpson
Deputy Auditor General

13208

6422.

Being 9 acres of land. Lying in the N E 1/4 of Sec. 19 and the S E 1/4 of Sec. 18 T 25 N 10 W. Commencing 420 ft. S and 421 ft. W of Sec. Corner 1718 1920 and running thence S 1 1/2° W 231 ft. Thence S 9 1/2° W 166 ft. Thence northerly and Westerly along river to fence running N 86 1/2° W of commencement. Thence N 24 ft. Thence E 20 7/8 ft. Thence N 29 4 ft. Thence S 83 1/2° E 298.8 ft. Thence S 45 1/8 ft. Thence E 368 1/2 ft. to beginning.

Surveyed Nov. 16, 1908. E Strong Surveyor

Dedication: We Alexander Price and Alzina Price his wife as proprietors have surveyed platted and named Price Addition and dedicated fully by us the streets herein shown are given to public use.

In presence of

Silas A. Wright Alexander Price Owner Seal
Elsie Baldwin Alzina Price Owner Seal

State of Michigan, County of Kalamazoo. On this 2nd day of March 1909 before me a Notary Public in and for said County personally came the above named Alexander Price and Alzina Price his wife known to me to be the persons who executed this plat and acknowledged the same to be their free act and deed.

Wallace W. Baldwin Notary Public Com. expires March 30, 1911 Comstock Mich.

Received for record March 28th 1909 at 3 o'clock P.M. and recorded in Book 8 of Plats on page 7

Examined and approved March 23, 1909 Nathan F. Simpson Register of Deeds
S. H. Carlton Deputy Auditor General.

State of Michigan, County of Kalamazoo. We S. H. Carlton Register of Deeds and E. Strong Surveyor hereby certify that we have each carefully compared this copy with the original plat of Price Addition to Comstock and that it is an exact copy thereof and of the whole of such original plat.

E. Strong Surveyor

S. H. Carlton Register of Deeds

Monuments	
a 13 Oak 16 West?	26 1/2 ft.
b W Oak 5 E?	2 "
c River South	10 "
d Willow 7 S 5 1/2° W	5 "
e 7 S E	2 1/2 "
f W Oak 2 1/2 N 70° W	9 1/2 "
g fence West	71 "
h W Oak 20 N 80° E	7 1/2 "
i Choke Cherry 6 N 15° W	32 1/2 "
j B. Walnut 20 S 15° E	39 1/2 "
k B. Oak 10 S 45° W	11 1/2 "
l Willow 12 N 10° E?	8 "
m 7 South?	9 "
n 20 East 12 N 40° E	15 1/2 "
o Blue Oak 7 N 60° W	1 1/2 "
p Maple Chump 12 South	20 1/2 "
q Cherry 14 N 45° E	2 1/2 "
r W Oak 1 1/2 N 75° E	18 "
s 2 1/2 S 45° E	23 "
t W Oak 8 N 45° E	22 1/2 "
u Corner Trolley rail N	1 "
v Maple 12 S 20° E	50 1/2 "
w Pine 10 S 20° E	72 "
o iron stakes at all lot corners	

I hereby certify that I have made a survey of the above titled plat of land and as represented and have planted iron for monuments (said monuments are round 18 1/4 x 3/4) at all intersections of streets and angles of the plat marked o.

E. Strong Surveyor

State of Michigan, County of Kalamazoo. We S. H. Carlton Register of Deeds and E. Strong Surveyor hereby certify that we have each carefully compared the annexed copy with the plat of Price Addition to Comstock now of record in the office of said Register of Deeds and that it is a true transcript therefrom and of the whole of such record.

S. H. Carlton Register of Deeds


March 28 1909

S. H. Carlton

Price Addition

To
Comstock

Kalamazoo County

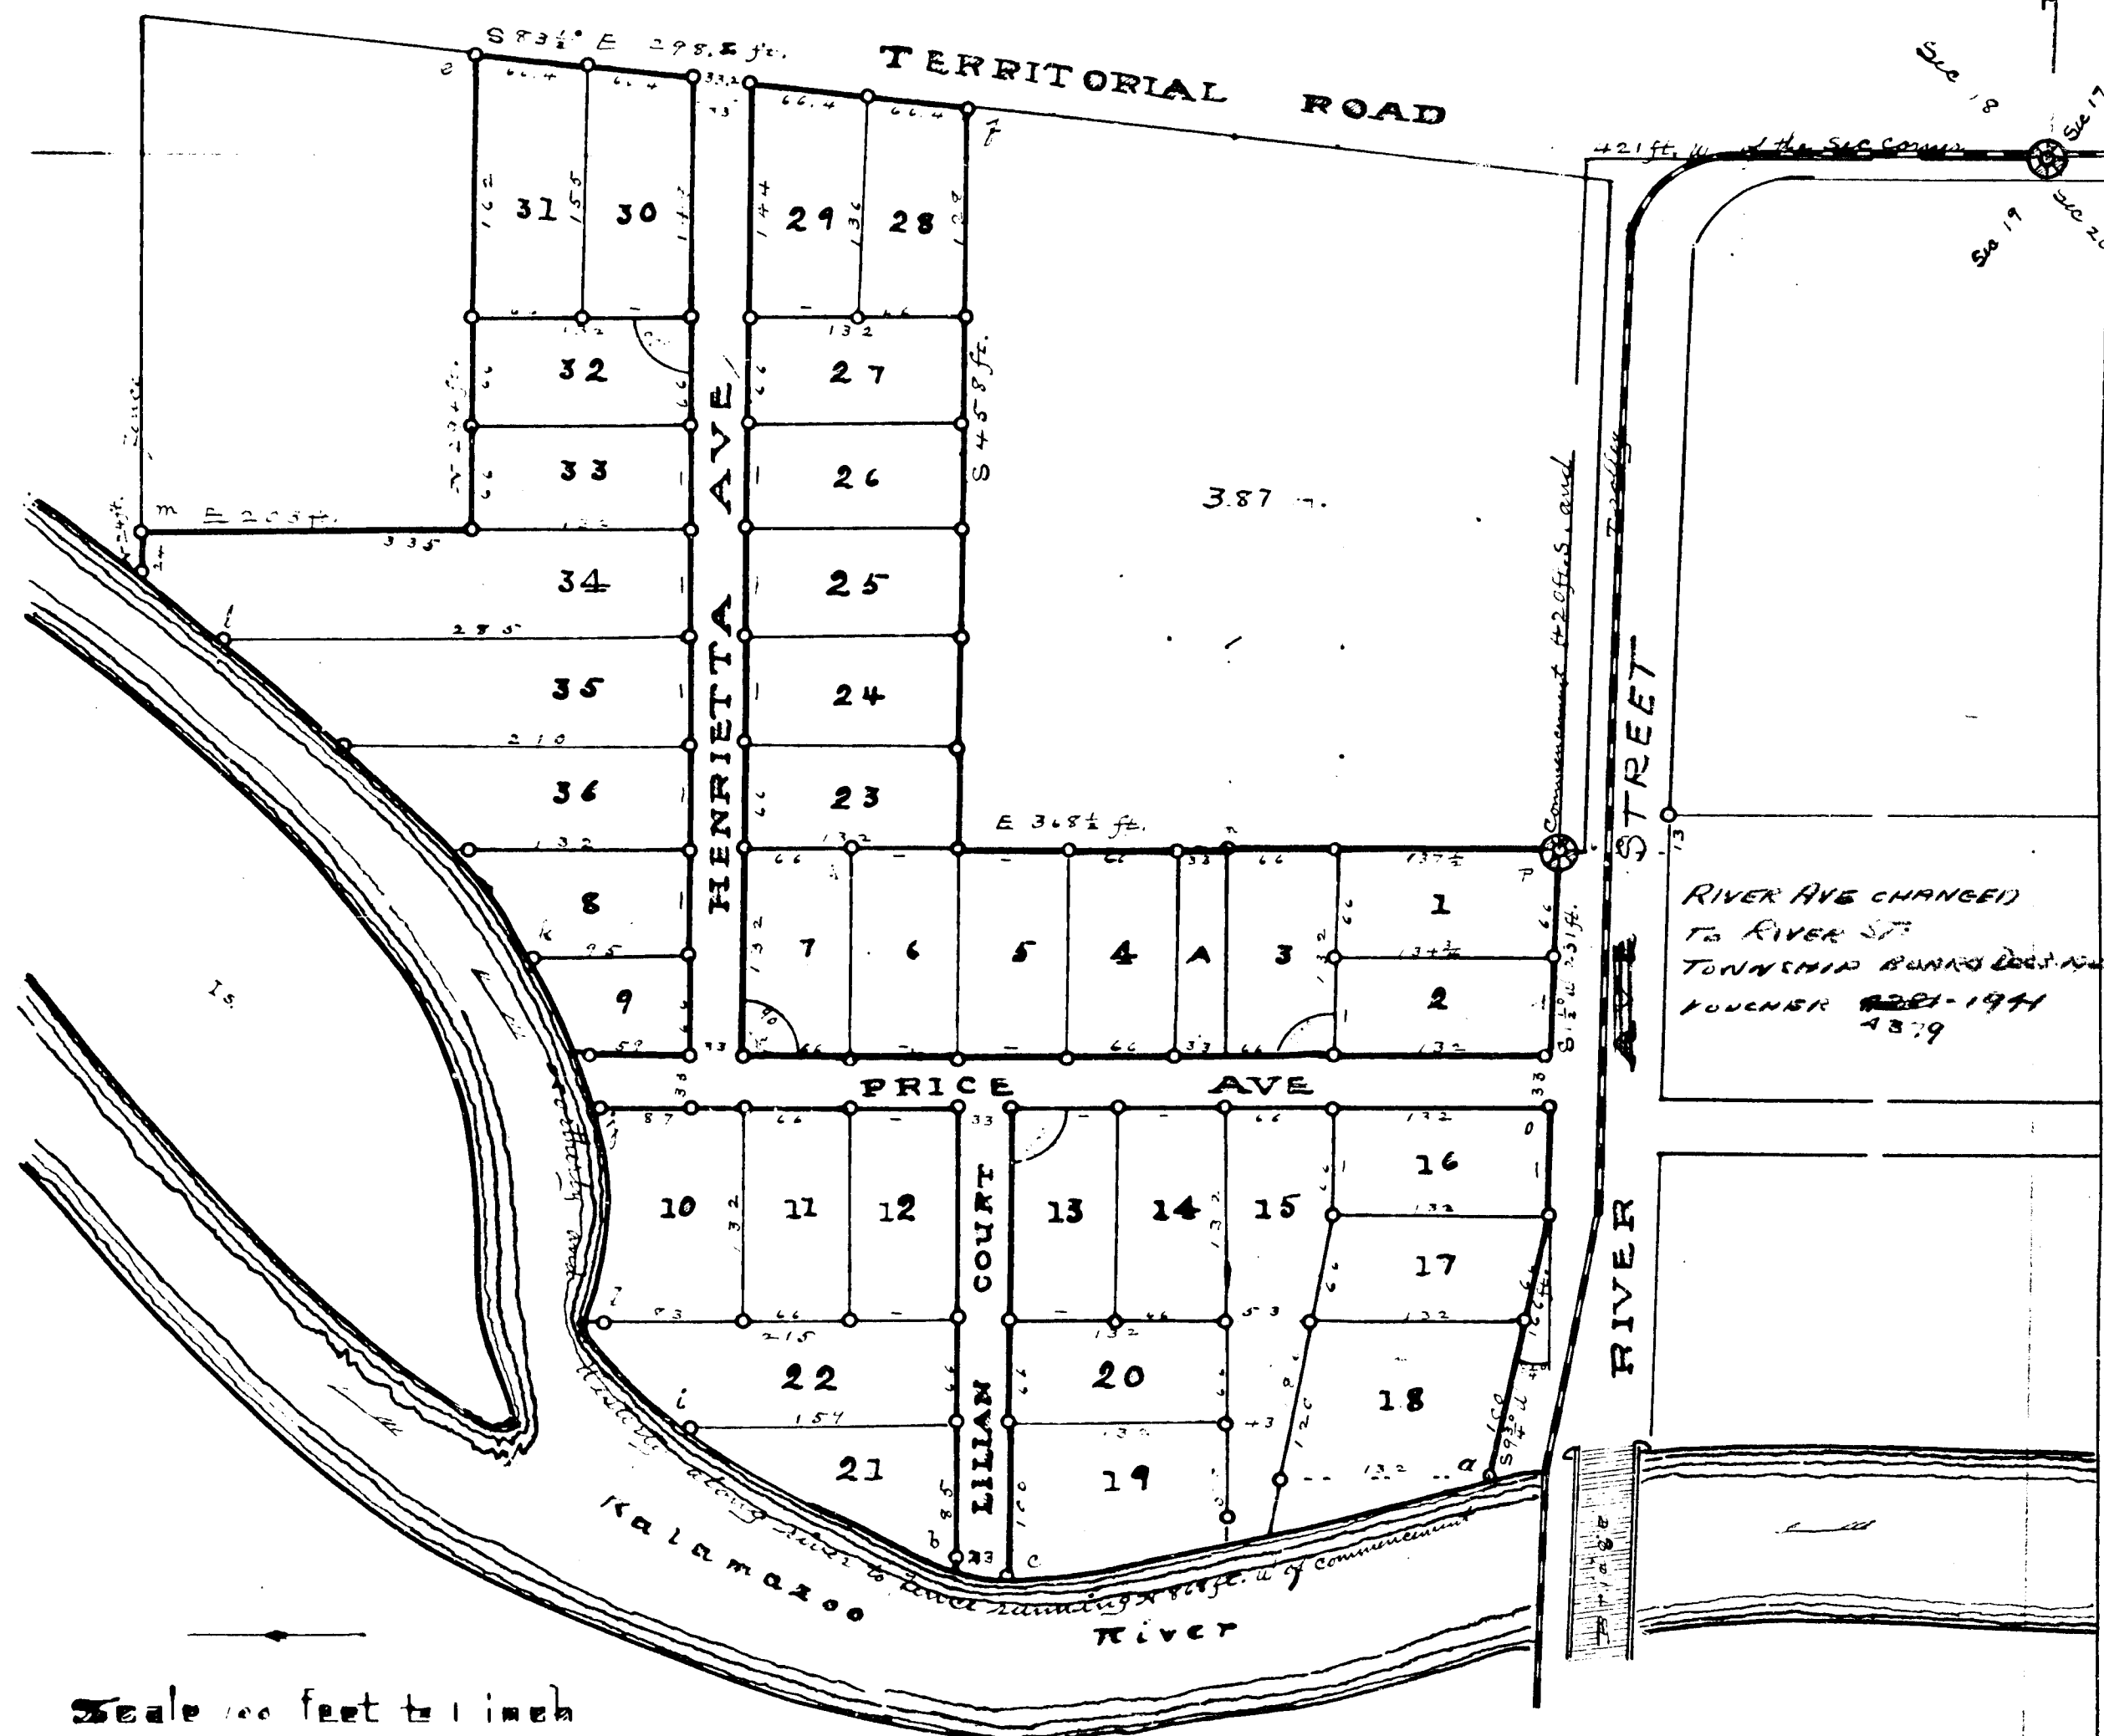

Scale 100 feet to 1 inch

RECEIVED AND FILED.
IN AUDITOR GENERAL'S OFFICE,

Nathan F. Simpson
Deputy Auditor General

13208