

PLAT OF WOODLAWN PARK

Kalamazoo Township,
Kalamazoo County, Michigan

SURVEY BY
MICHIGAN ENGINEERING CO.
Kalamazoo, Michigan

Scale 1 inch to 180 feet



DESCRIPTION OF LAND PLATTED

The land embraced in the annexed plat of Woodlawn Park is described as follows: Commencing at a point 888.88 feet North and 174.5 feet West of the South $\frac{1}{4}$ post of Section 20, T. 2, S. R. 11, W. and running thence West 972 feet; thence North 720 feet; thence West 780 feet; thence North 588.62 feet to the center line of Michigan Avenue; thence N. 68° 52' E. 1672.38 feet along the center line of Michigan Avenue; thence South 792 feet; thence N. 68° 52' E. 206.86 feet; thence South 1190.15 feet to the place of beginning.

SURVEYOR'S CERTIFICATE

I hereby certify that the plat hereon delineated is a correct one, and that permanent monuments consisting of iron rods $\frac{3}{8}$ inches in diameter and thirty inches long have been planted at all points marked thus (o) as hereon shown, at all angles in the boundaries of the land platted and at all intersections of streets or streets and avenues.

Glass C. Wheaton
Surveyor.

DEDICATION

KNOW ALL MEN BY THESE PRESENTS: That we, Le Roy Hornbeck and Florence M. Hornbeck, his wife, as proprietors, have caused the land embraced in the annexed plat to be surveyed, laid out and platted, to be known as WOODLAWN PARK, Kalamazoo, Michigan, and that the streets and avenues as shown on said plat are hereby dedicated to the public.

Le Roy Hornbeck [L. S.]
Florence M. Hornbeck [L. S.]

Witnessed by

Blanche M. Hornbeck
W. J. Loomer

STATE OF MICHIGAN } ss.
COUNTY OF KALAMAZOO }

On this 28th day of January, A. D. 1911, before me, appeared Le Roy Hornbeck and Florence M. Hornbeck, his wife, known to me to be the persons who executed the above dedication and acknowledged the same to be their free act and deed.

W. J. Loomer
Notary Public, Kalamazoo County, Michigan.

My commission expires July 29, 1914.

TOWNSHIP OF KALAMAZOO } ss.
COUNTY OF KALAMAZOO }

The annexed plat of Woodlawn Park was approved by the Township Board in regular meeting Jan...
28th 1911.

STATE OF MICHIGAN } ss.
COUNTY OF KALAMAZOO }


I hereby certify that I have examined the records in my office relating to the description of lands in the plat of WOODLAWN PARK, dated Jan. 28, 1911, and from such examination it appears that the taxes have been fully paid for the five years preceding said date, and that there are no tax liens or titles held by the State or individuals for five years preceding said date.

Kalamazoo, Mich. Feb 2, 1911
Arthur Tiffany
County Treasurer.

Examined and Approved

FEB 27 1911

Geo. R. Hauser
Deputy Auditor General.

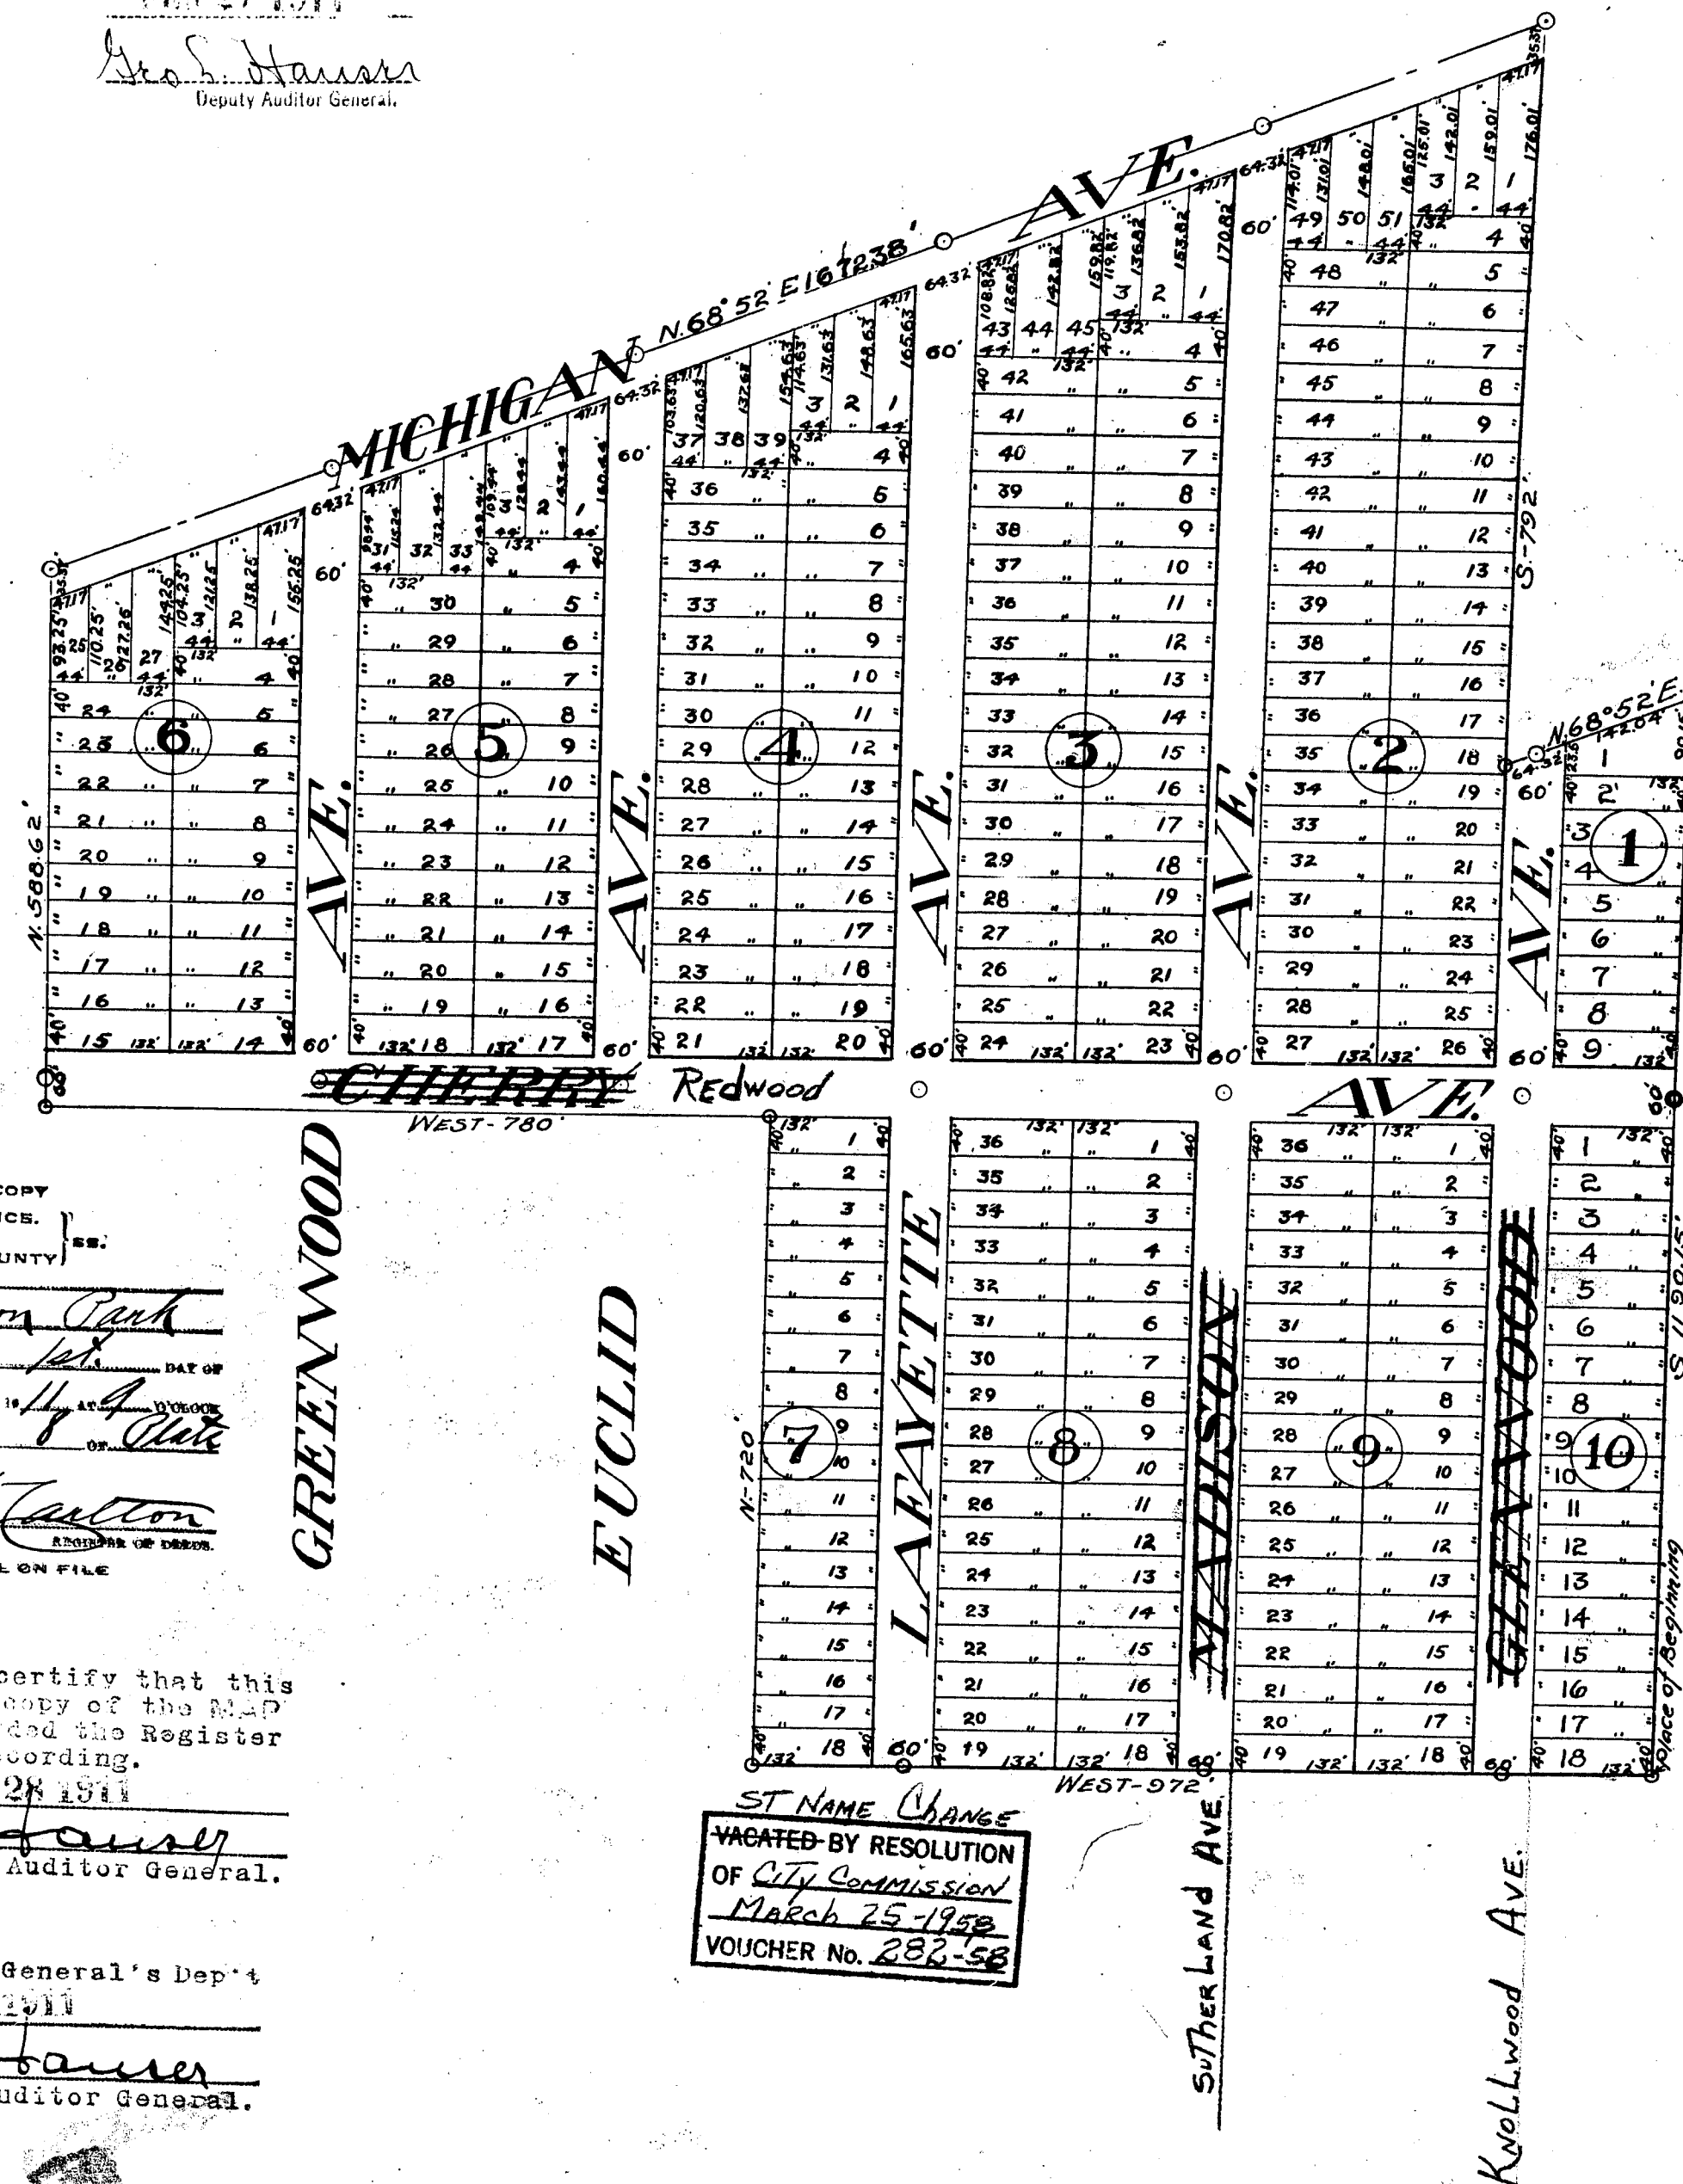

COPY
REGISTER'S OFFICE,
Kalamazoo County
Plat of
Woodlawn Park
Will be recorded this 1st day of Feb
A. D. 1911 at 11 o'clock
of AM
ON FILE
J. H. Taitton
Recorder of Deeds.
ORIGINAL ON FILE

I hereby certify that this copy is a true copy of the plat or plat forwarded the Register of Deeds for recording.

Compared FEB 24 1911
Geo. R. Hauser
Deputy Auditor General.

Filed in Auditor General's Dep't
MAR 4-1911
Geo. R. Hauser
Deputy Auditor General.

ST NAME CHANGE
VACATED BY RESOLUTION
OF CITY COMMISSION
March 25-1912
VOUCHER No. 282-58

13226

PLAT OF WOODLAWN PARK

Kalamazoo Township,
Kalamazoo County, Michigan

SURVEY BY
MICHIGAN ENGINEERING CO.
Kalamazoo, Michigan

Scale 1 inch to 180 feet

DESCRIPTION OF LAND PLATTED

The land embraced in the annexed plat of Woodlawn Park is described as follows: Commencing at a point 888.83 feet North and 174.5 feet West of the South $\frac{1}{4}$ post of Section 20, T. 2, S. R. 11, W. and running thence West 972 feet; thence North 720 feet; thence West 780 feet; thence North 589.62 feet to the center line of Michigan Avenue; thence N. $68^{\circ} 52' E$. 1672.38 feet along the center line of Michigan Avenue; thence South 792 feet; thence N. $68^{\circ} 52' E$. 206.36 feet; thence South 1190.15 feet to the place of beginning.

SURVEYOR'S CERTIFICATE

I hereby certify that the plat hereon delineated is a correct one, and that permanent monuments consisting of iron rods $\frac{5}{8}$ inches in diameter and thirty inches long have been planted at all points marked thus (o) as hereon shown, at all angles in the boundaries of the land platted and at all intersections of streets or streets and avenues.

Charles C. Wheaton
Surveyor.

DEDICATION

KNOW ALL MEN BY THESE PRESENTS: That we, Le Roy Hornbeck and Florence M. Hornbeck, his wife, as proprietors, have caused the land embraced in the annexed plat to be surveyed, laid out and platted, to be known as WOODLAWN PARK, Kalamazoo, Michigan, and that the streets and avenues as shown on said plat are hereby dedicated to the public.

Le Roy Hornbeck [L. S.]
Florence M. Hornbeck [L. S.]

Witnessed by

Wanda M. Hornbeck
Charles C. Wheaton

STATE OF MICHIGAN }
COUNTY OF KALAMAZOO } ss.

On this 28th day of January, A. D. 1911, before me, appeared Le Roy Hornbeck and Florence M. Hornbeck, his wife, known to me to be the persons who executed the above dedication and acknowledged the same to be their free act and deed.

My commission expires Jan 1, 1912

Notary Public, Kalamazoo County, Michigan.

TOWNSHIP OF KALAMAZOO }
COUNTY OF KALAMAZOO } ss.
STATE OF MICHIGAN }

The annexed plat of Woodlawn Park was approved by the Township Board in regular meeting Jan 28th 1911.

STATE OF MICHIGAN }
COUNTY OF KALAMAZOO } ss.

I hereby certify that I have examined the records in my office relating to the description of lands in the plat of WOODLAWN PARK, dated Jan 28, 1911, and from such examination it appears that the taxes have been fully paid for the five years preceding said date, and that there are no tax liens or titles held by the State or individuals for five years preceding said date.


Kalamazoo, Mich., Feb 2, 1911

Arthur Tiffany
County Treasurer.

COPY
REGISTERED OFFICE
Kalamazoo County
Plat of
Woodlawn Park
March 11/4
J. H. Taitton
ORIGINAL ON FILE

I hereby certify that this copy is a true and correct copy of the original as filed in the office of the Auditor General.
Geo. R. Hauser
Auditor General.

Filed in Auditor General's office
Geo. R. Hauser
Auditor General.

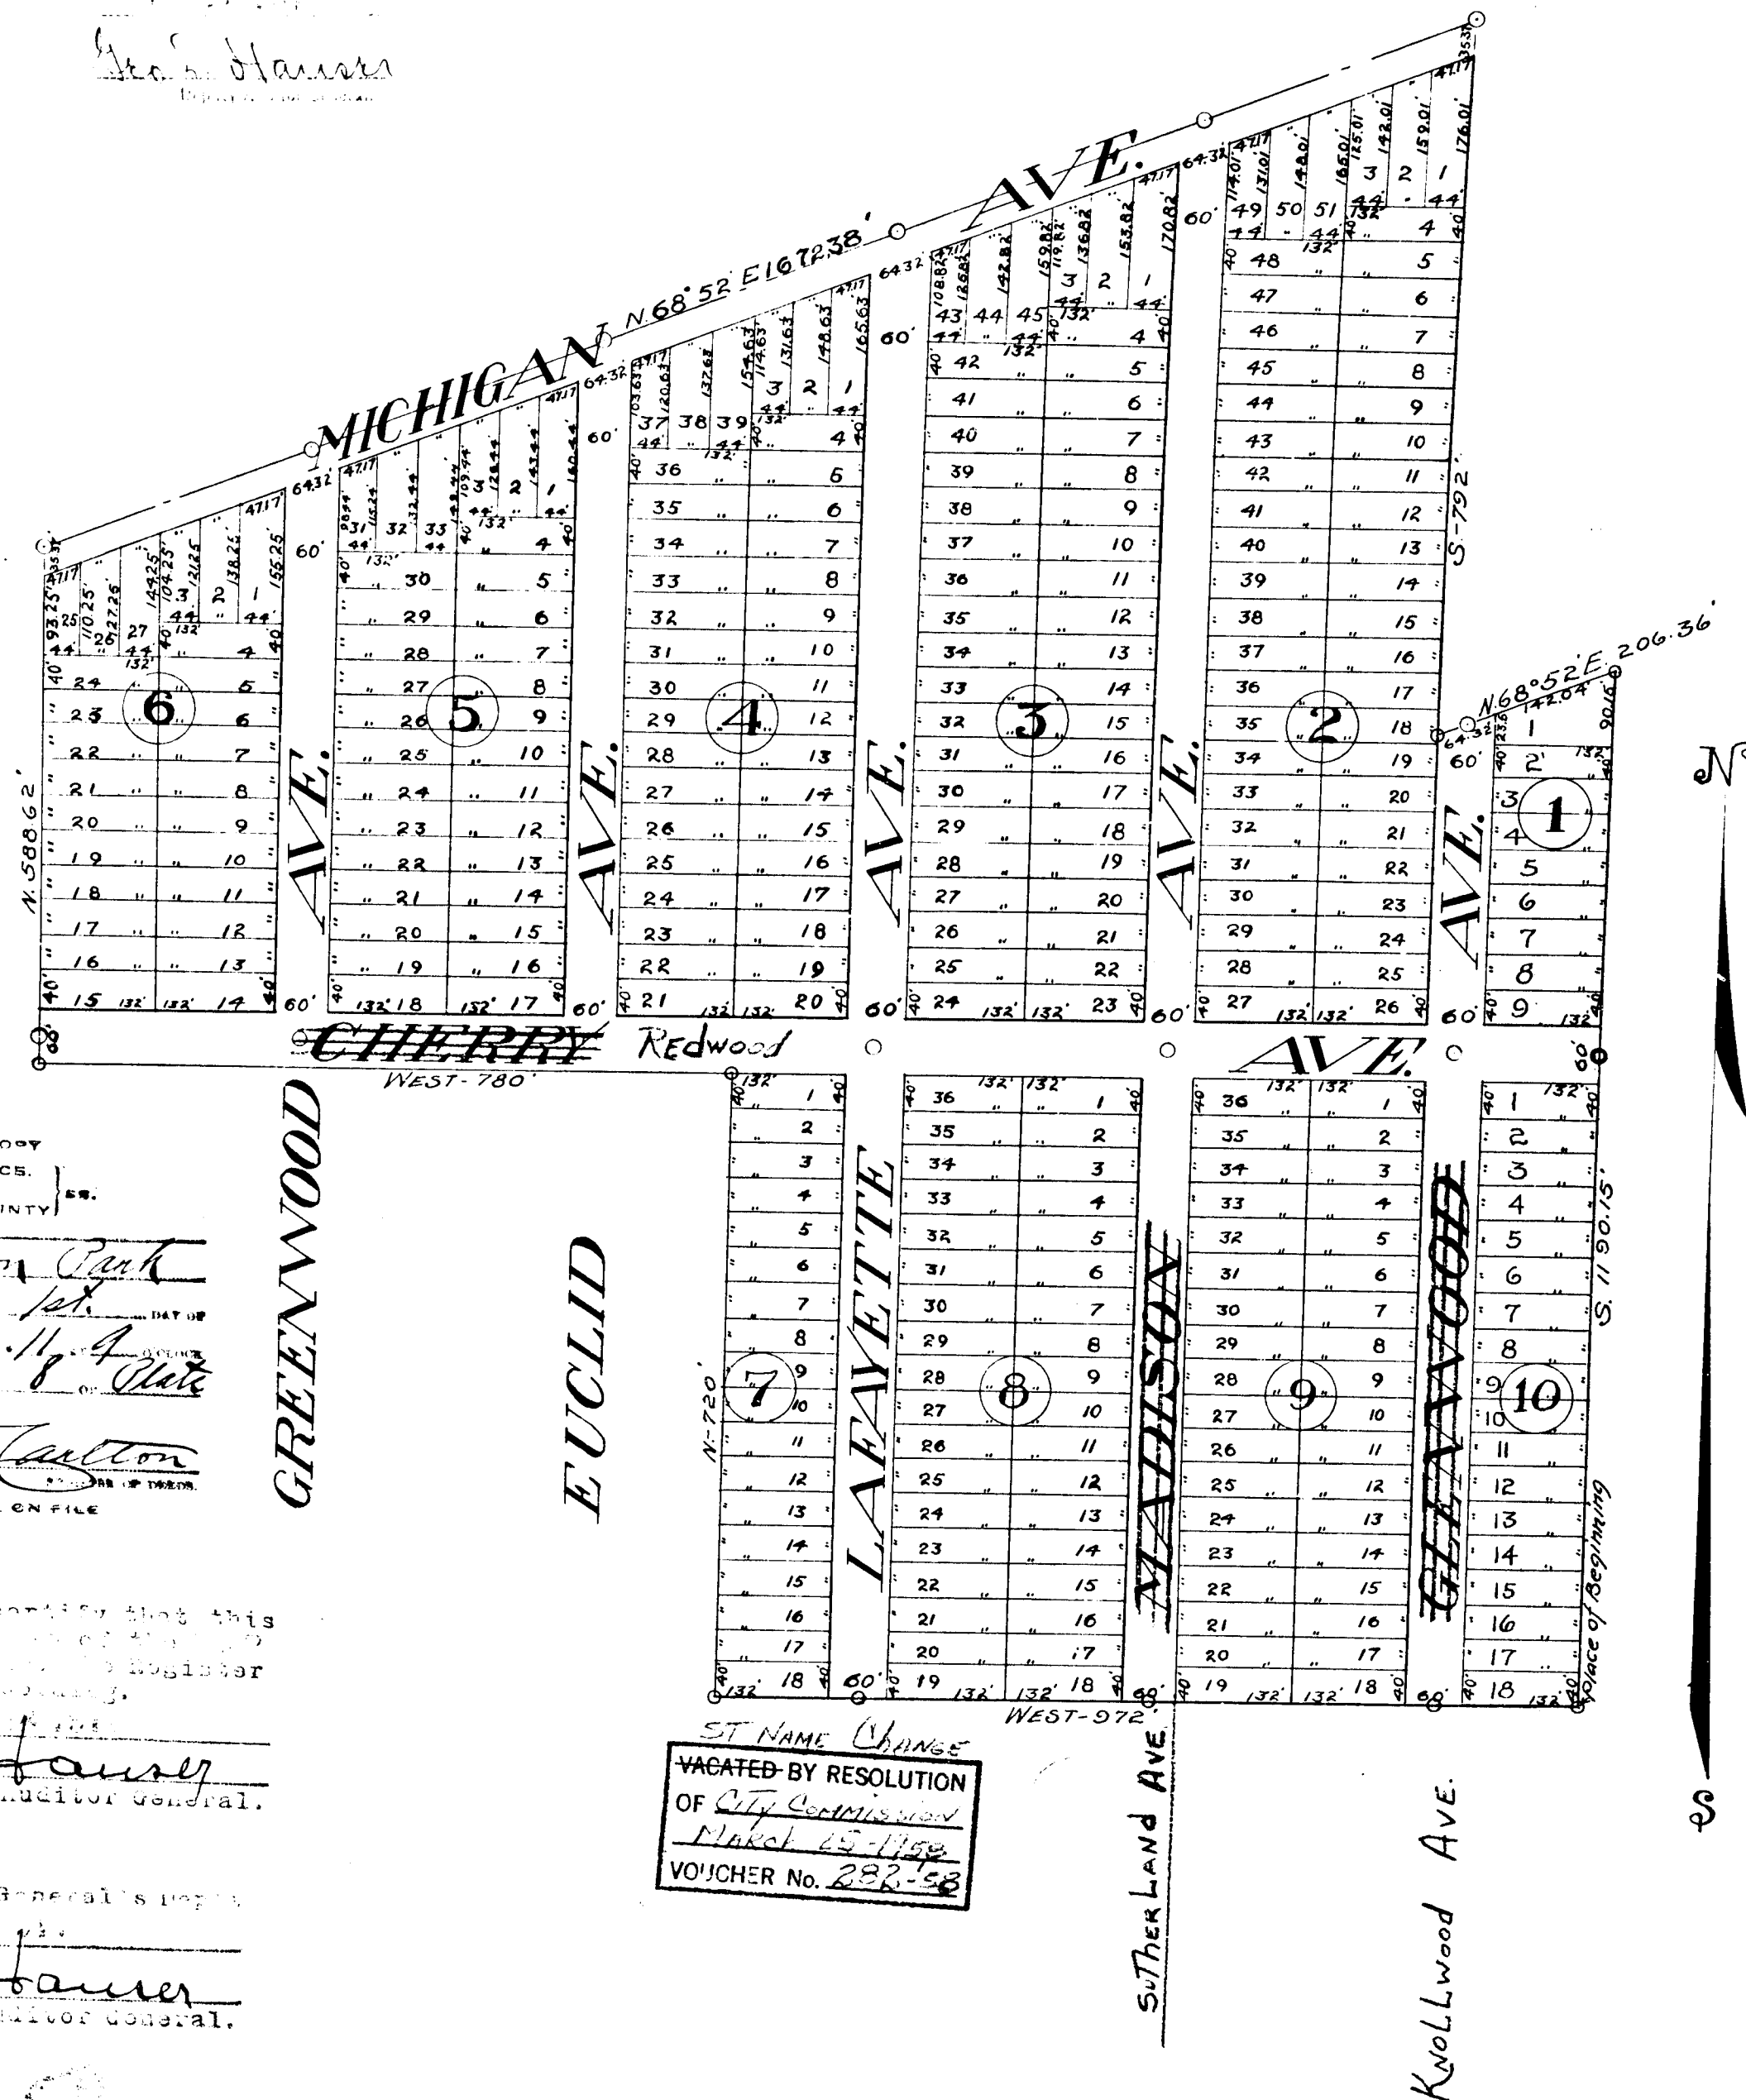

13226

8759

11
2-

CLERK-REGISTER

PRESENT, Commissioners: Ferraro, Haan, LaForge, Lipsey, Straits, Vice Mayor Moore, Mayor Annen

ABSENT, Commissioners: None

WHEREAS, it appears necessary and advisable to vacate the

the North line of Lot 48, Block 2 of the Flat of ~~the~~ the Park, Sec. 20, T. 2 S., R. 11 W., Kalamazoo County, Michigan.

holding of a hearing by the City Commission, it appears that said street/alley no longer is necessary or useful for public purposes

the same is hereby vacated and shall henceforth not be considered
a part of the public right-of-way; SAVING AND RESERVING, HOWEVER,

copy of this resolution to be recorded in the Office of the Register of Deeds for this county and another certified copy to be

13226


LIBER 1487 PAGE 1368

RESOLUTION DECLARED ADOPTED.

CERTIFICATE

meeting held on January 7, 1991. Public notice was given and the meeting was conducted in full compliance with the Michigan Open Meetings Act (PA 267, 1976). Minutes of the meeting will be available as required by the Act.

Ruth G. Tydeman, City Clerk

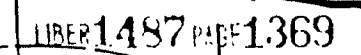

16 X