

CONY
Kalamazoo County, MI
I hereby certify that this copy is a true copy of the original of record for recording.
Comptroller JUL 26 1911
Filed in Auditor General's Dept. 6 JUL 29 1911
Deputy Auditor General.
Wm. H. French
Deputy Auditor General.
ORIGINAL ON FILE

Examined and Approved
JUL 26 1911
Wm. H. French
Deputy Auditor General.

Kalamazoo Park

Kalamazoo County

Being 18.8 acres of land. Lying in the NE 1/4 of Sec. 19 T 25 R 10 W. Beginning 1000 Ft. north of the E 1/2 Post and running thence E 2 1/2 x 511.5 Ft. thence north 1689 Ft. thence S 68° 40' W 303 Ft. thence S 57° W 77 Ft. thence S 52° W 212 Ft. to the 1/4 line, thence South the 1/4 line 1426 Ft. to Lot 5, to beginning.

Surveyed July 22, 1910. Ed Longmeyer


DEED: The Frederick C Knight and Margaret M. Knight his wife as proprietors have conveyed plotted and named Knight's plat and dedicated fully by us the said herein named are given to public use. The Park and adjacent river front are also given to public use but the river front to Lot 14 and 15 goes with the lot title.

Wm. French Frederick C Knight
Wallace Deery Margaret M. Knight

STATE OF MICHIGAN: This is day of April 1911 before me a Notary Public in and for said County personally came the above named Frederick C Knight Margaret M. Knight his wife known to me to be the persons who executed this plat and acknowledged the same to be their free act and deed.

My Commission Expires June 1913
Wm. French Notary Public
STATE OF MICHIGAN: I hereby certify that the plat of Kalamazoo Park has been fully paid for five years preceding this date in Knight's plat and that there are no tax liens or title claimed by the state or individuals during five years prior date hereof.

Dated April 15th 1911
Wm. French Deputy County Treasurer
Approved by Township of Comstock this 19th day of May 1911
Frank R. Mendenberg Township Clerk

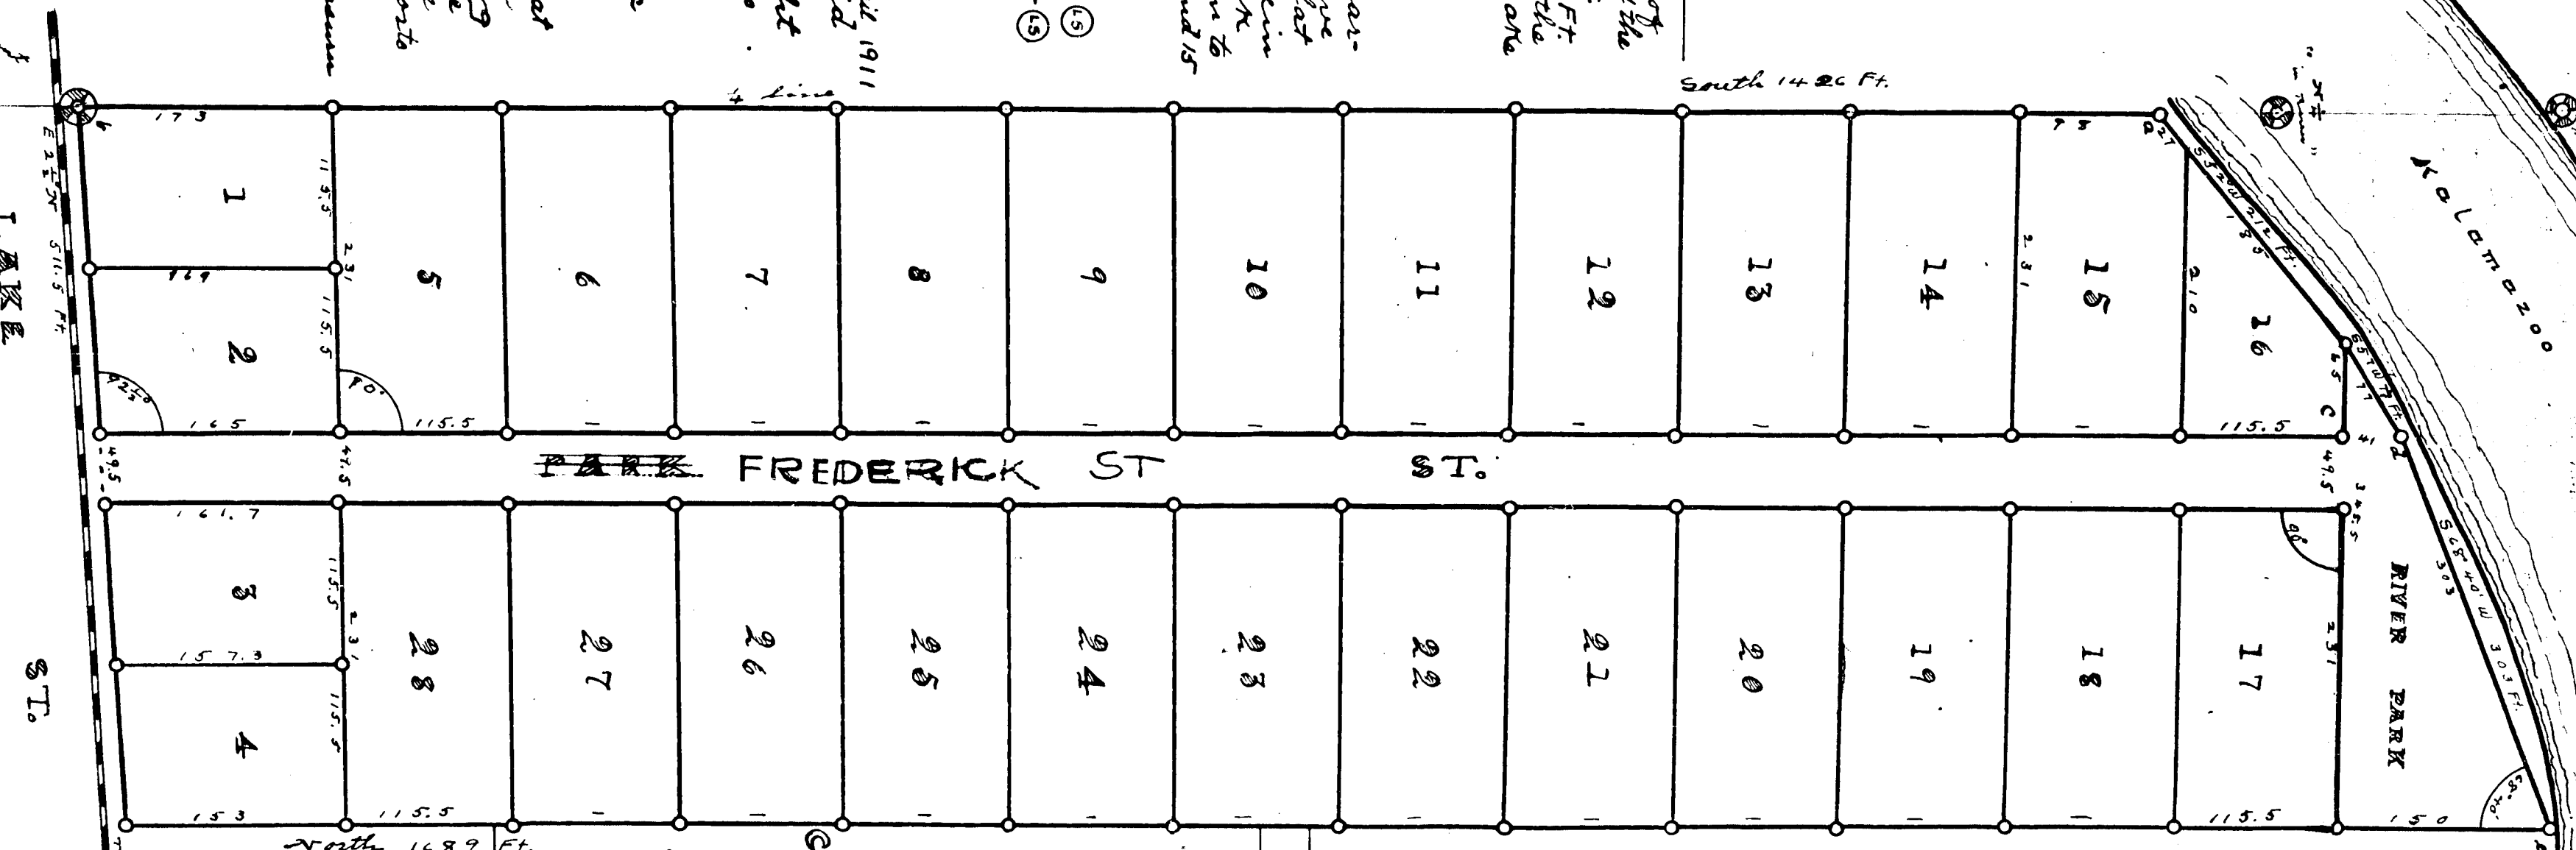

- Measurements
- a 13 Aht. 12 x 40 9' W 6 Ft
 - b 13 Aht. 12 x 40 9' W 6 Ft
I hereby certify the plat herein delineated is a correct one and permanent monuments of iron round 1 1/2 x 1/2 are placed at points marked O at all angles of the plat boundaries and intersections of streets.

Ed Longmeyer
TOWNSHIP CHANGED TO FREDERICK C
TOWNSHIP BOARD DEC 31 1910
VOLUME 4379-1911
Scale 100 Ft. to 1 inch