

DESCRIPTION OF LAND PLATTED

The land embraced in the annexed plat of WAITE'S ADDITION, Kalamazoo, Mich., is located in the N. E. ¼ of section 29, T. 2, S. R. 11, W. and is more particularly described as follows: Commencing at a point 33 feet North and 1323.8 feet West of the East ¼ post of section 29, T. 2, S. R. 11, W. and running thence East parallel with the E. and W. ¼ line of said section 29, 1083.85 feet; thence N. 17° 11' E. along the West line of Asylum Ave. 732.1 feet; thence N. 81° 56' E. 88.07 feet, to the East line of said section 29; thence N. 0° 12' W. and along the East line of said section 29, 77.6 feet; thence N. 74° 9' W. 248.9 feet; thence around a 11° 30' curve to the right 610.14 feet; thence N. 3° 59' W. 398.15 feet; thence S. 86° 1' W. 699.15 feet; thence S. 0° 16' E. 1872 feet to the place of beginning.

SURVEYOR'S CERTIFICATE

I hereby certify that the plat hereon delineated is a correct one, and that permanent monuments consisting of iron pipe one inch in diameter and twenty-four inches long, have been planted at all points marked thus (o) as thereon shown, at all angles in the boundaries of the land platted and at the intersection of the streets.

Glenn C. Wheaton
Surveyor.

DEDICATION

KNOW ALL MEN BY THESE PRESENTS: That we, E. B. Russel and Amelia Russel, his wife, W. T. Waite and Jessie D. Waite, his wife, as proprietors, have caused the land embraced in the annexed plat to be surveyed, laid out and platted to be known as WAITE'S ADDITION, Kalamazoo, Mich., and that the Avenues as shown on said plat are hereby dedicated to the public.

Witnessed by

Lu Russel
J. G. O'Brien

E. B. Russel [L. S.]
Amelia Russel [L. S.]
W. T. Waite [L. S.]
Jessie D. Waite [L. S.]

STATE OF MICHIGAN }
COUNTY OF KALAMAZOO } ss.

On this First day of May, A. D. 1911, before me, appeared E. B. Russel and Amelia Russel, his wife, and W. T. Waite and Jessie D. Waite, his wife, to me personally known, who being by the duly sworn, did acknowledge the above instrument to be their free act and deed.

My commission expires Aug. 13 1911

James J. O'Brien
Notary Public, Kalamazoo County, Mich.

TOWNSHIP OF KALAMAZOO }
COUNTY OF KALAMAZOO } ss.
STATE OF MICHIGAN

The annexed plat of WAITE'S ADDITION, Kalamazoo, Mich., was approved by the Township Board in regular meeting August 1st 1911.

Wesley French
Township Clerk.

TAX CERTIFICATE

STATE OF MICHIGAN }
COUNTY OF KALAMAZOO } ss.

I hereby certify that I have examined the records in my office relating to the description of lands in the plat of WAITE'S ADDITION, Kalamazoo, Mich., dated May 1st 1911, and from such examination it appears that the taxes have been fully paid for the five years preceding said date, and that there are no liens or titles held by the State or individuals for the five years preceding said date.

Kalamazoo, Mich. Aug. 3rd 1911

Arthur Tiffany
County Treasurer.

ST. NAME CHANGE
VACATED BY RESOLUTION
OF CITY COMMISSION
FEBRUARY 24-1908
VOUCHER NO. 282-53

PLAT OF WAITE'S ADDITION


KALAMAZOO, MICHIGAN

SURVEY BY
MICHIGAN ENGINEERING CO.

Scale 100 feet per inch

0' 100' 200' 300'

Taken into city
1928
G.S.C.

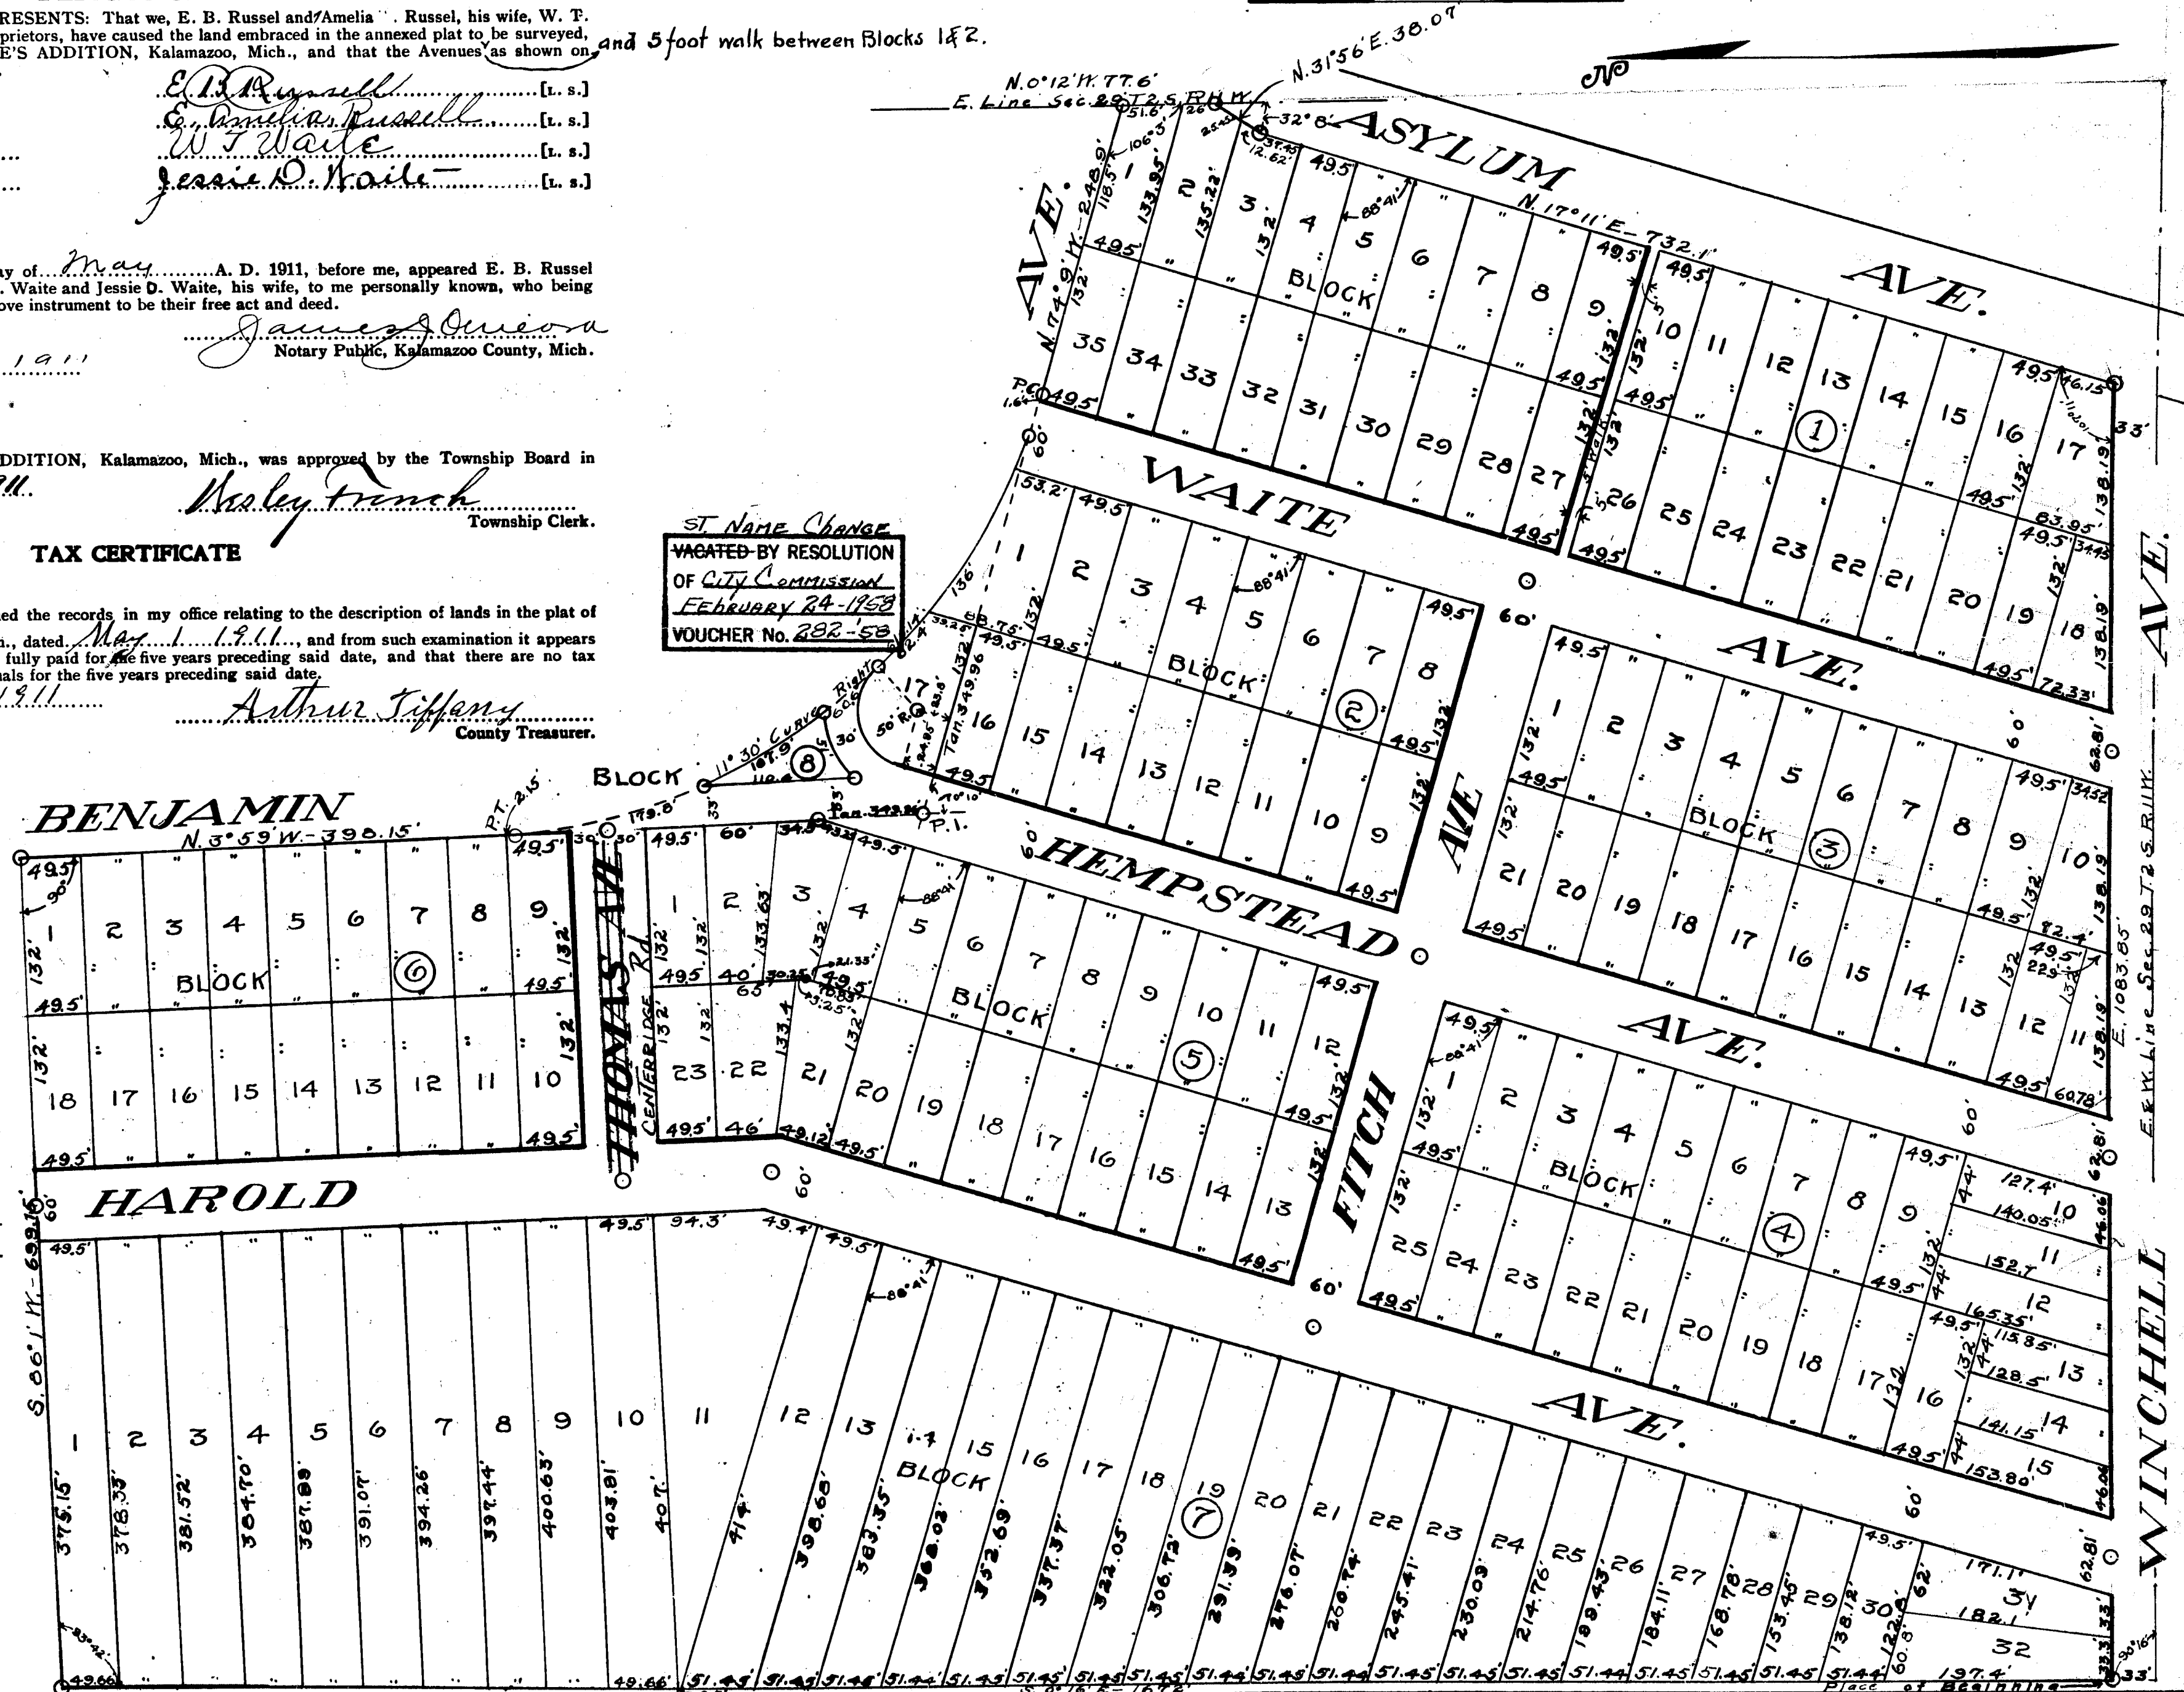

COPY
REGISTERED IN OFFICE
COUNTY OF KALAMAZOO } ss.
PLAT OF
Waite's Addition
WAS RECORDED THIS 22 DAY OF
Aug A. D. 1911 BY
M. E. LUND OF BLOCK
ON PAGE 8 OF BOOK
W. T. Waite
REGISTERED OF DEEDS.
ORIGINAL ON FILE

I hereby certify that this copy is a true copy of the M. & P. or PLAT forwarded the Register of Deeds for recording.

Compared AUG 21 1911
Glenn C. Wheaton
Deputy Auditor General.

Filed in Auditor General's Dep't
AUG 23 1911

Glenn C. Wheaton
Deputy Auditor General.

13232

DESCRIPTION OF LAND PLATTED

The land embraced in the annexed plat of WAITE'S ADDITION, Kalamazoo, Mich., is located in the N. E. 1/4 of section 29, T. 2, S. R. 11, W. and is more particularly described as follows: Commencing at a point 33 feet North and 1323.8 feet West of the East 1/4 post of section 29, T. 2, S. R. 11, W. and running thence East parallel with the E. and W. 1/4 line of said section 29, 1083.55 feet; thence N. 17° 11' E. along the West line of Asylum Ave. 732.1 feet; thence N. 31° 56' E. 38.07 feet, to the East line of said section 29; thence N. 0° 12' W. and along the East line of said section 29, 77.6 feet; thence N. 74° 9' W. 248.9 feet; thence around a 11° 30' curve to the right 610.14 feet; thence N. 3° 59' W. 398.15 feet; thence S. 86° 1' W. 699.15 feet; thence S. 0° 16' E. 1672 feet to the place of beginning.

SURVEYOR'S CERTIFICATE

I hereby certify that the plat hereon delineated is a correct one, and that permanent monuments consisting of iron pipe one inch in diameter and twenty-four inches long, have been planted at all points marked thus (o) as thereon shown, at all angles in the boundaries of the land platted and at the intersection of the streets.

Ellen C. Wheaton
Surveyor.

DEDICATION

KNOW ALL MEN BY THESE PRESENTS: That we, E. B. Russel and Amelia Russel, his wife, W. T. Waite and Jessie D. Waite, his wife, as proprietors, have caused the land embraced in the annexed plat to be surveyed, laid out and platted to be known as WAITE'S ADDITION, Kalamazoo, Mich., and that the Avenues as shown on said plat are hereby dedicated to the public.

Witnessed by

L. J. Russell
J. J. Russell

E. B. Russel [L. S.]
Amelia Russel [L. S.]
W. T. Waite [L. S.]
Jessie D. Waite [L. S.]

STATE OF MICHIGAN }
COUNTY OF KALAMAZOO } ss.

On this 1st day of May, A. D. 1911, before me, appeared E. B. Russel and Amelia Russel, his wife, and W. T. Waite and Jessie D. Waite, his wife, to me personally known, who being by me duly sworn, did acknowledge the above instrument to be their free act and deed.

My commission expires 1st 1911

TOWNSHIP OF KALAMAZOO }
COUNTY OF KALAMAZOO } ss.
STATE OF MICHIGAN }

The annexed plat of WAITE'S ADDITION, Kalamazoo, Mich., was approved by the Township Board in regular meeting August 1st 1911.

Wesley French
Township Clerk.

TAX CERTIFICATE

STATE OF MICHIGAN }
COUNTY OF KALAMAZOO } ss.

I hereby certify that I have examined the records in my office relating to the description of lands in the plat of WAITE'S ADDITION, Kalamazoo, Mich., dated May 1st 1911, and from such examination it appears that the taxes have been fully paid for the five years preceding said date, and that there are no tax liens or titles held by the State or individuals for the five years preceding said date.

Kalamazoo, Mich., Aug 3 1911

Arthur Tiffany
County Treasurer.

RECORDS OFFICE,
Kalamazoo County } ss.
White add
Aug 11 1911
ON FILE
W. H. Carlton
RECORDS OFFICE

I hereby certify that this copy is a true copy of the M. P. of P. T. found in the Register of Deeds for recording.

Geo. L. Hauser
Deputy Auditor General.

Filed in Auditor General's Dep't
AUG 23 1911

Geo. L. Hauser
Deputy Auditor General.

PLAT OF WAITE'S ADDITION


KALAMAZOO, MICHIGAN

SURVEY BY
MICHIGAN ENGINEERING CO.

Scale 100 feet per inch

0 100 200 300

Taken into city
1928
C.S.C.

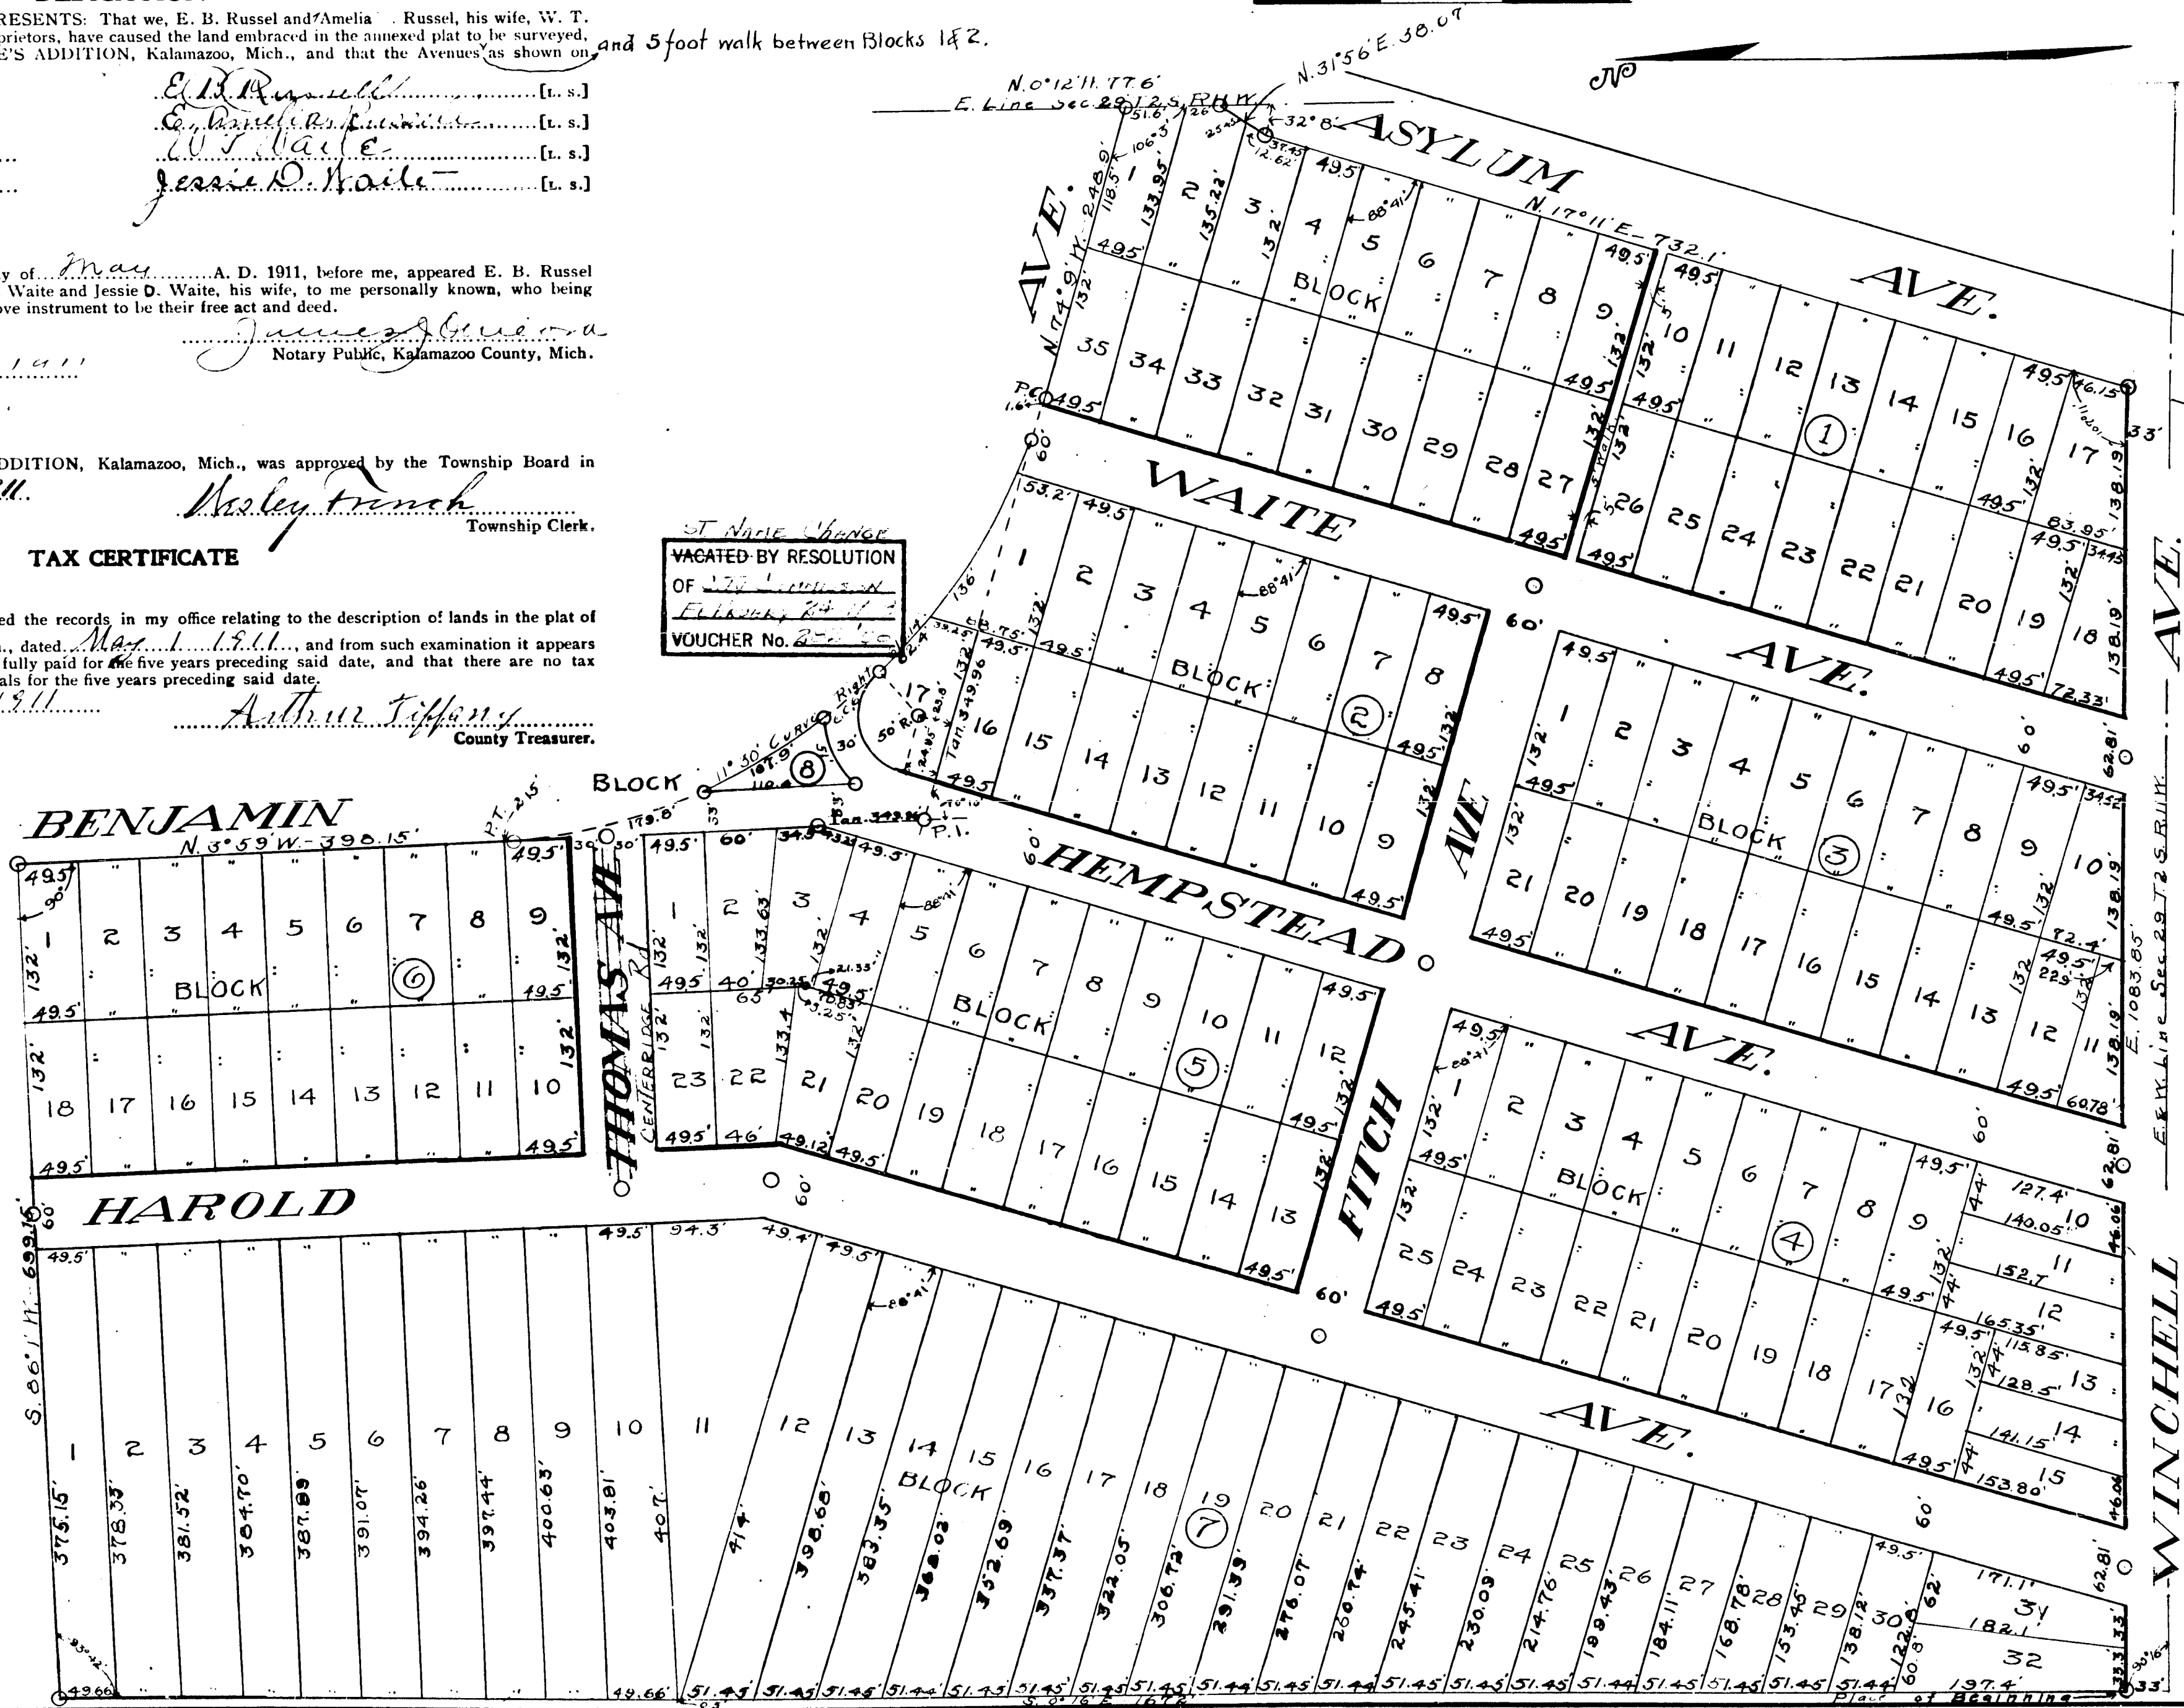

13232