

In
Village of Parchment
Apr 18 1930
Articles of Incorporation

COPY
REGISTER'S OFFICE
Kalamazoo
PLAT OF
GLENDALE
JAN 6-1914
Geo. Ford
Deputy Auditor General

Village of Parchment
Kalamazoo Township, Kalamazoo County,
State of Michigan
1930

REVISED PLAT OF GLENDALE

SURVEY BY
MICHIGAN ENGINEERING COMPANY
KALAMAZOO, MICHIGAN

Examined and Approved
JAN 6-1914
Geo. H. Bauer
Deputy Auditor General

Scale 150 feet per inch

0 100 200 300 400 500

DESCRIPTION OF LAND PLATTED

The land embraced in the annexed plat is located in the east 1/4 of section 8, T. 2, S. R. 11, W. and is more particularly described as follows:

Beginning at the E. 1/4 post of section 8 and running thence north along the east line of said section, 861.8 feet; thence west 439.52 feet; thence N. 2° 19' E., along the west line of the C. K. & S. Ry. right of way, 109.94 feet; thence around a curve to the right 357.38 feet; thence S. 89° 38' W., 1054.6 feet; thence S. 0° 56' W., along the east line of the L. S. & M. S. Ry. right of way, 1055.8 feet; thence S. 89° 4' E., 132 feet; thence S. 0° 56' W., 198 feet; thence S. 89° 4' E., 620.78 feet to the westerly line of the Michigan & Chicago Ry. right of way; thence S. 18° 58' E., along said westerly line of right of way, 428.9 feet; thence S. 89° 30' E., 618.19 feet; thence N. 0° 18' W., 370 feet, along the east line of said section 8, to the place of beginning. Excepting therefrom the right of way of the C. K. & S. Ry. described as a strip of property 66 feet in width lying 33 feet on each side of the following described line; beginning at a point 861.8 feet north and 406.52 feet west of the E. 1/4 post of section 8, T. 2, S. R. 11, W. and running thence S. 2° 19' W., 1228.15 feet; and also excepting therefrom the right of way of the Michigan & Chicago Ry. described as a strip of property 100 feet in width lying 50 feet on each side of the following described line; beginning at a point 566.56 feet N. 89° 30' W. of a point on the east line of section 8, T. 2, S. R. 11, W. which is 370.0 feet S. 0° 18' E. of the E. 1/4 post of said section 8, and running thence N. 18° 58' W., 1737.32 feet.

SURVEYOR'S CERTIFICATE

I hereby certify that the plat hereon delineated is a correct one, and that permanent monuments consisting of iron rods 1/2 inch in diameter and twenty-four inches long, have been placed at all points marked thus (o) as thereon shown, at all angles in the boundaries of the land platted and at the intersection of the streets.

Geo. C. Wheaton
Surveyor

DEDICATION

KNOW ALL MEN BY THESE PRESENTS: That R. M. Gallup, a single man, as proprietor, has caused the land embraced in the annexed plat to be surveyed, laid out and platted, to be known as the Revised Plat of GLENDALE, Kalamazoo Township, Kalamazoo County, State of Michigan, and that the streets and avenues are hereby dedicated to the public.

Witnessed by

Harry Sartori
Geo. C. Wheaton
R. M. Gallup [L. S.]

STATE OF MICHIGAN }
COUNTY OF KALAMAZOO } ss.

On this 23rd day of December, A. D., 1913, before me, appeared R. M. Gallup, a single man, to me personally known, who being by me duly sworn, acknowledged the above instrument to be his free act and deed.

My commission expires Jan 4-1917

Notary Public, Kalamazoo County, Mich.

TOWNSHIP OF KALAMAZOO
COUNTY OF KALAMAZOO }
STATE OF MICHIGAN }

The annexed Revised Plat of GLENDALE, Kalamazoo Township, Kalamazoo County, State of Michigan, was approved by the Township Board Dec 23 1913.

Allen M. Nicholas
Township Clerk

TAX CERTIFICATE

STATE OF MICHIGAN }
COUNTY OF KALAMAZOO }


I hereby certify that I have examined the records in my office relating to the description of lands in the Revised Plat of GLENDALE, Kalamazoo Township, Kalamazoo County, State of Michigan, dated December 23 1913 and from such examination it appears that all the taxes have been fully paid for the five years preceding said date, and that there are no tax liens or titles held by the State or individuals for five years preceding said date.

Kalamazoo, Mich. December 23 1913

County Treas

NOTE:—All dimensions are in feet and decimals thereof.

13256

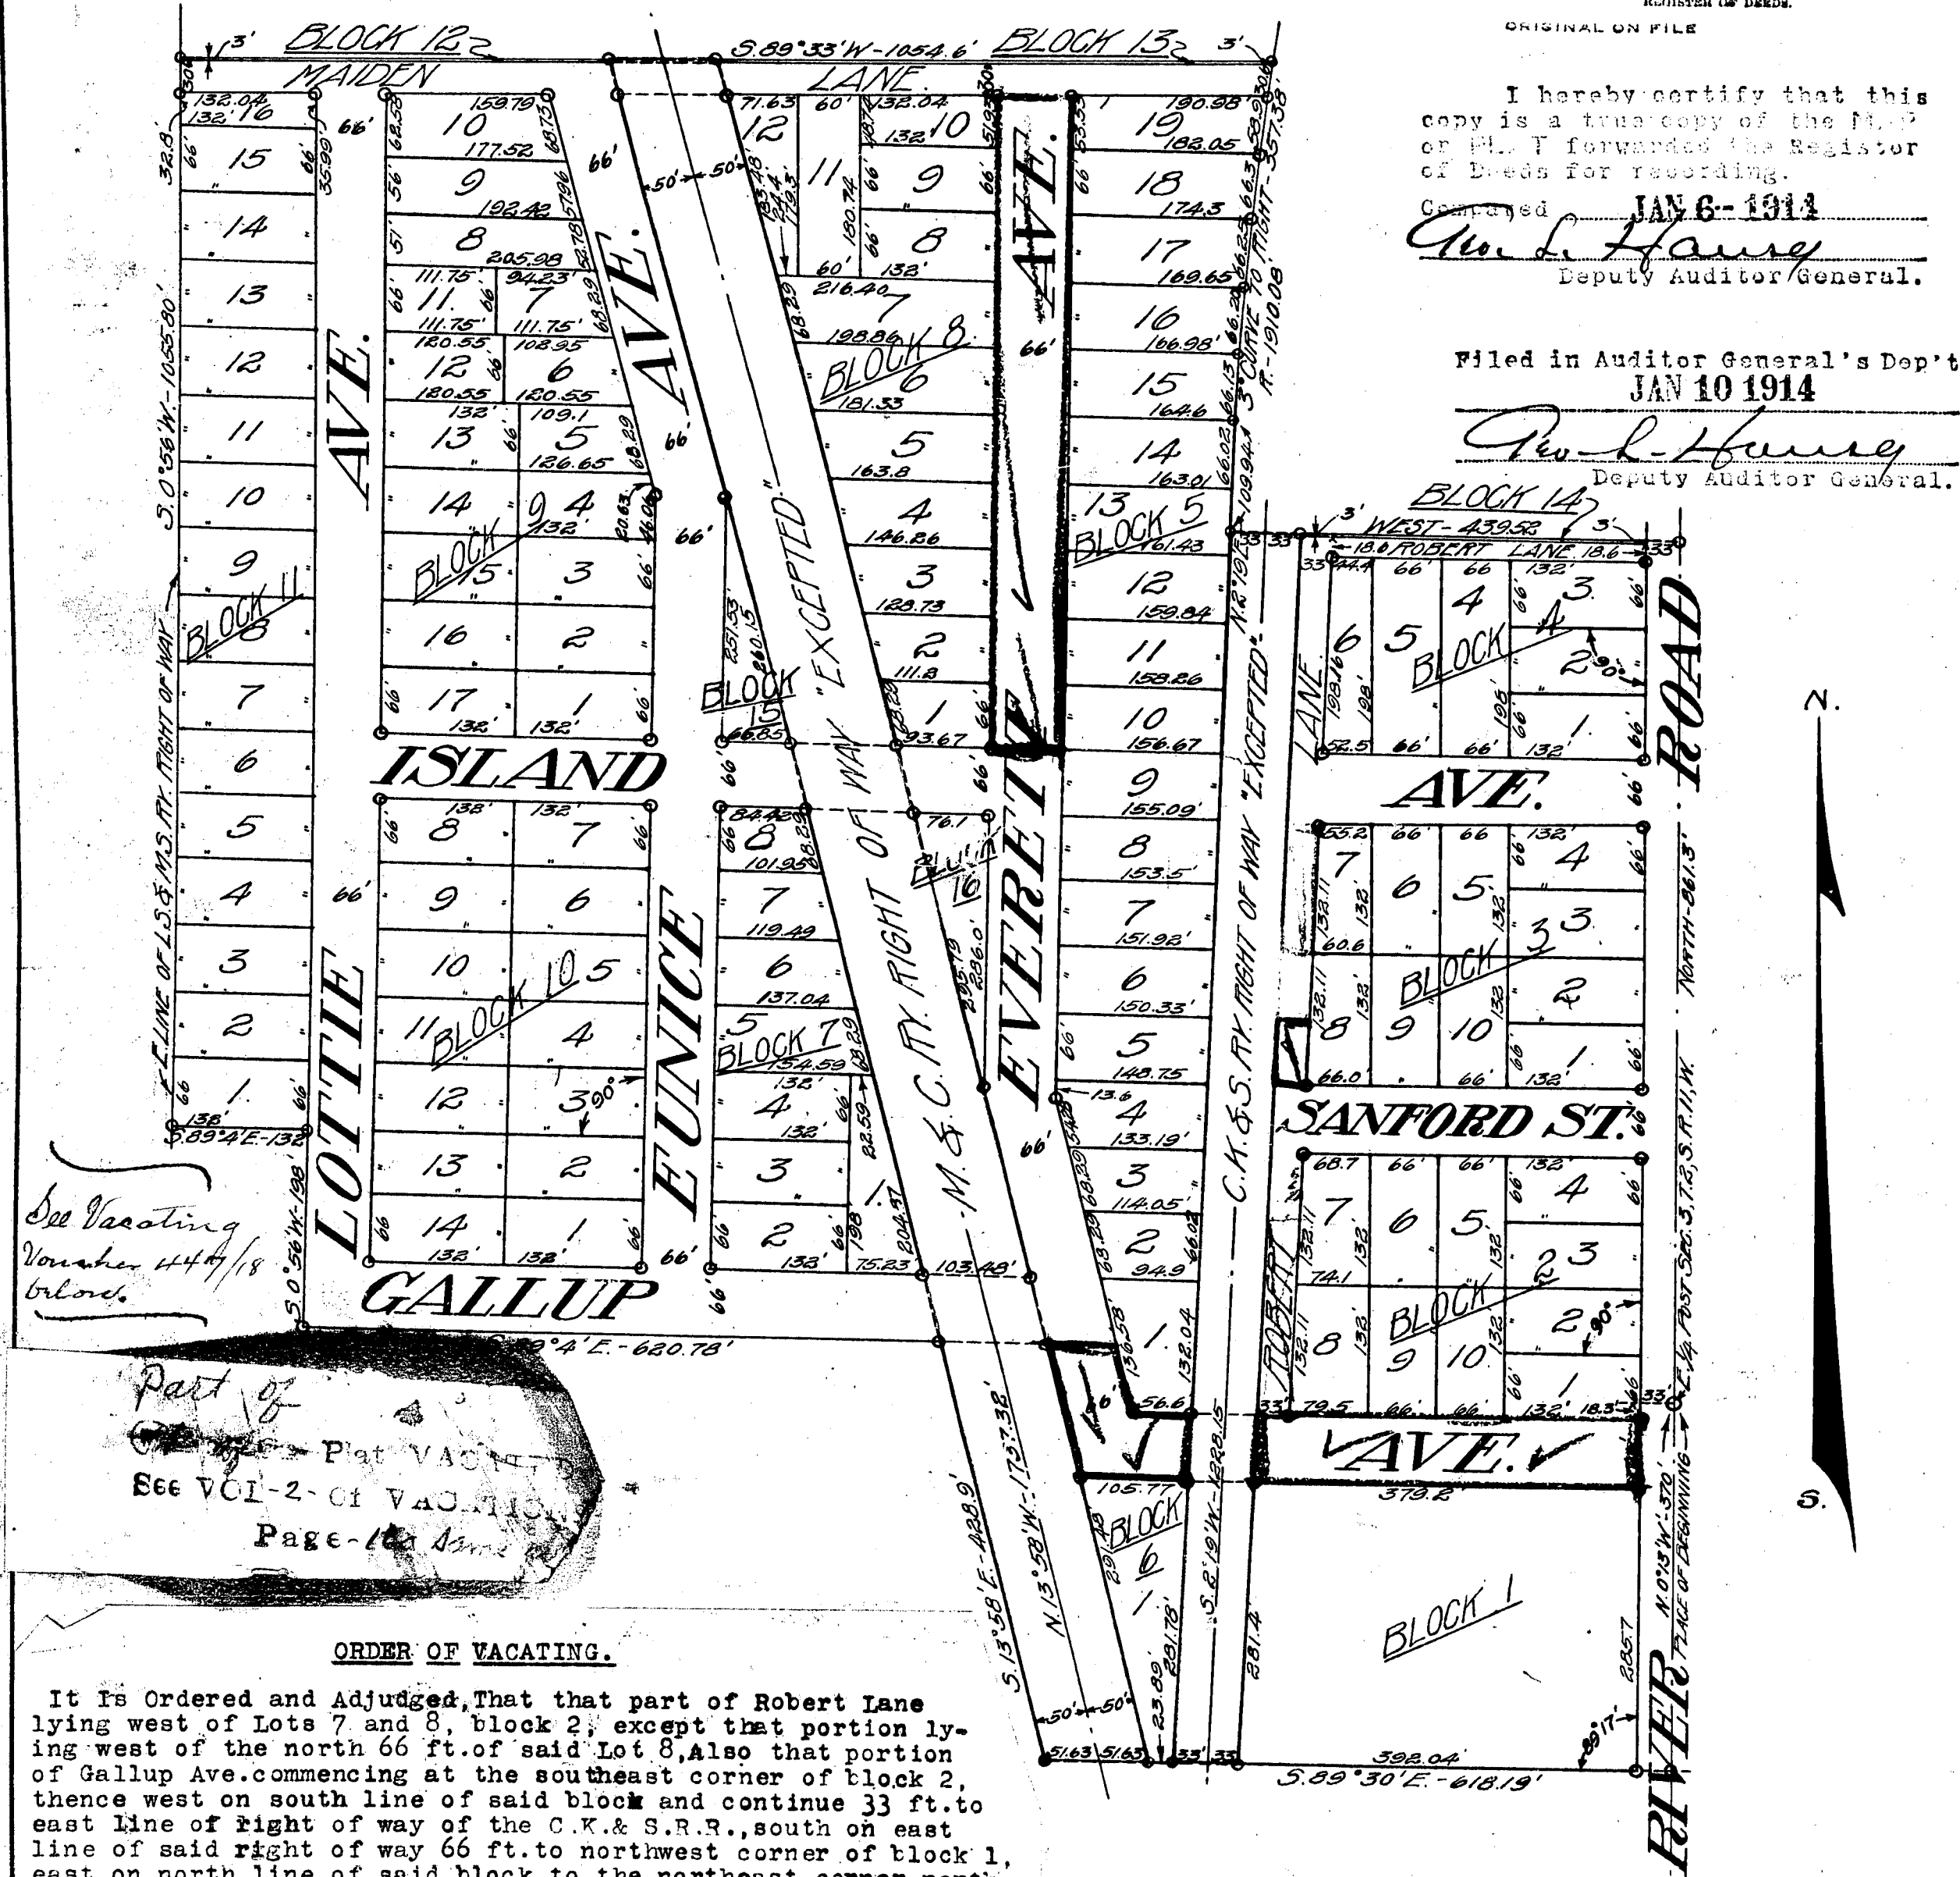

See Vacating
Voucher 447-18
below.

Part of
Plat VACANT
See Vol 2- of VACATING
Page 160

ORDER OF VACATING.

It is Ordered and Adjudged, That that part of Robert Lane lying west of Lots 7 and 8, block 2, except that portion lying west of the north 66 ft. of said lot 8, also that portion of Gallup Ave. commencing at the southeast corner of block 2, thence west on south line of said block and continue 33 ft. to east line of right of way of the C. K. & S. R. R., south on east line of said right of way 66 ft. to northwest corner of block 1, east on north line of said block to the northeast corner, north 66 ft. to place of beginning, also that portion of Gallup Ave. and Everett Ave., commencing at northeast corner of block 6, west 105.77 ft. to the easterly line of M. C. R. R. right of way, thence northwesterly on said line to a point in the south line of Gallup Ave., east 66 ft. to west line of lot 1, Block 5, south-easterly on said line to southwest corner of said lot 1, east on south line of said lot 56.6 ft. to the southeast corner of lot 1, south on west line of the right of way of C. K. & S. R. R. 66 ft. to place of beginning, be and the same are hereby Vacated as Public Grounds. March 6th, 1918 - Filed April 30th, 1918. Voucher 447-1918. Vol 2 - Page 160

Order of Vacation
By order of the Circuit Court, Everett Avenue
(as shown on this plat) extending from north line of
Island Ave. to south line of Robert Lane is hereby
vacated March 13th 1920. Voucher 447-1920
Vol 2 - Page 160

ClibPDF - www.fastio.com

13256

PARCHMENT CITY
KALAMAZOO COUNTY, MICHIGAN
A RESOLUTION VACATING WILSON STREET BETWEEN ISLAND AVENUE AND ROBERTS LANE WITHIN PARCHMENT CITY, KALAMAZOO COUNTY, MICHIGAN
WHEREAS, in order to protect and promote the safety and welfare of the residents of Parchment City; and
WHEREAS, the vacation of Wilson Street between Island Avenue and Roberts Lane is deemed to benefit the residents of Parchment City
IT IS HEREBY RESOLVED that Wilson Street between Island Avenue and Roberts Lane, within Parchment City, be and is hereby vacated with title thereto reverting to the owners of the abutting properties.

Revised Plat of Glendale

[Signature]
Richard Verdon
Parchment City Clerk

[Signature]
Curt Flowers
Deputy Clerk

CERTIFICATE

The foregoing Resolution was adopted by the City Commission of the City of Parchment, Kalamazoo County, Michigan, on September 21, 1987, on motion of Trustee Bussone, supported by trustee Heasley, and the vote upon said Resolution was as follows:

AYES: Bultie, Bussone, Fleckenstein, Heasley, Kurey

NAYS: None

ABSTENTIONS: None

ABSENT: None

[Signature]
Richard Verdon
Parchment City Clerk

[Signature]
Curt Flowers
Deputy Clerk


CERTIFICATION OF RESOLUTION COPY

I hereby certify that the foregoing resolution was adopted by the City Commission of the City of Parchment at a regular meeting held on the 21st day of September, 1987.

[Signature]
Richard Verdon
City Clerk

The portion of Wilson St. vacated by order of the attached resolution is located in the subdivision known as "REVISED PLAT OF GLENDALE" and outlined in red ink below.

[Signature]
Richard Verdon
City Clerk
City of Parchment, Michigan

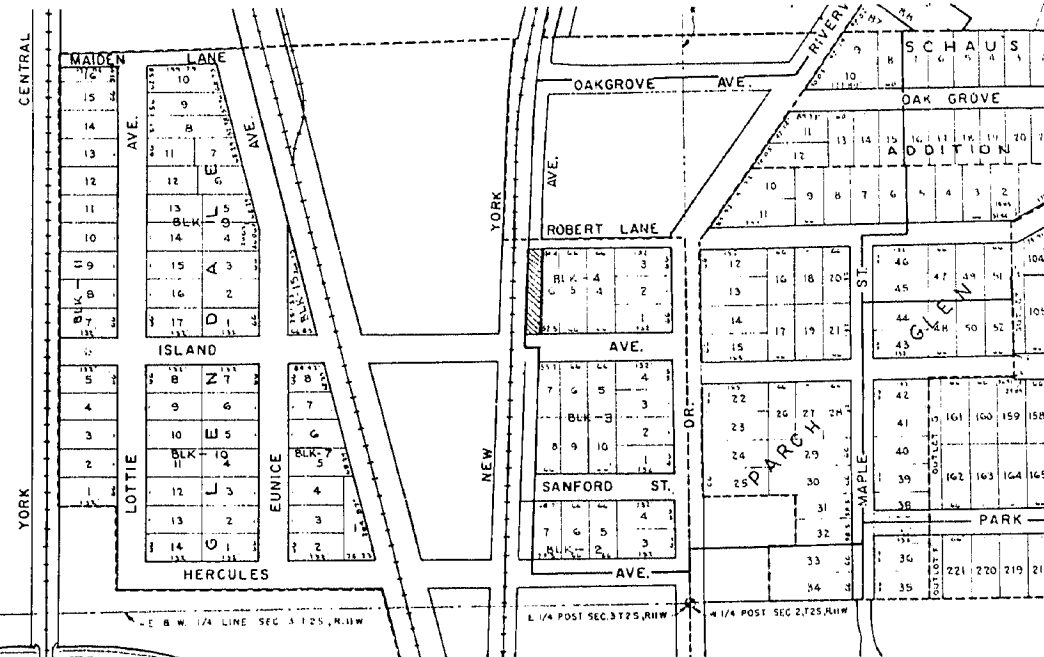

TROWBRIDGE PLACE AND NORTHSIDE ADDITION TO KALAMAZOO

ORDERED that Trowbridge St. and Elnora St. and that portion of Irene St. lying easterly of and that portion of Jerome St. lying southerly of the southerly line of the right of way of the C. K. & S. R. R. siding be vacated.

Vol. 156 page. 13100 ✓
" - 157 " 13113 ✓

GLENDALE.

ORDERED that that part of Robert Lane lying next west of and adjoining Lots 7-8, of Block 2 of the Revised Plat of Glendale, excepting and reserving that portion thereof lying next west of and adjoining the n. 66 ft. of said lot 8, ,

That portion of Gallup Ave. described as commencing at the south east corner of Block 2, of the Revised plat of Glendale and running thence west along the south line of said block and a continuation thereof 33 ft. to the e. line of the right of way of the C.R. & S. Ry., thence south along said e. line of said right of way 66 ft. to the northwest corner of Block 1 of said plat; thence east along

Charles B. Collingwood,
Circuit Judge.
Voucher No. 447 -- 1918.

the north line of said Block 1 to the northeast corner of said Block 1 and thence north 66 ft. to the place of beginning;

That portion of Gallup Ave. and Everett Ave. described as commencing at the northeast corner of Block 6 of said Revised plat of Glendale and running thence west 205.77 ft. to the easterly line of the Michigan Railway Company's right of way as shown on said revised plat; thence northwesterly along said easterly line of said right of way to a point in the south line of said Gallup Ave., thence east 66 ft. more or less to a point on the west line of Lot 1 of Block 5 of said Revised Plat; thence southeasterly along the westerly line of said Lot 1 of Block 5 to the southwest corner of said lot 1, thence east on the south line of said Lot 1 56.6 ft. to the southeast corner of said Lot 1; thence south along the west line of the right of way of said C.M. & S. Ry. Company 66 ft. to the place of beginning.

Be and the same are hereby vacated as public grounds.

Vol. 159 Page. 13 256 ✓