


recognition of the danger of hand
polluted by the fingers of the healthy persons
in the hospital.

State of Michigan proprietors of the adjoining plat of
divided pieces of land into lots, streets and alleys of the
lot fronts on the adjoining maps and plat and which
and divide the same. The boundaries of each piece be-
for said (Q) for land (A) for street (C) for deposit (D) for
on the lines of each. And the portions marked as streets
are bound for the use of the public as streets. And we further
Do witness whereof we have hereunto affixed our hands and
this 2nd day of February A^D 1882
Charles C. D. & Co. Surveyors
R. B. Merrill

In presence of

[illegible]

We the undersigned the Directors
 of the 1st Anti-Slavery Institute and also B. S. Whiting and
 John F. Salisbury his wife
 of the city of Battle Creek county
 do hereby lay out jointly and each respectively his share
 immaterial and with boundaries correct and extent and
 and plat and the certain figures and signs on this page
 bounded by and defined thus the lines (A) standing for North
 and the large figures near the center being the number
 within the above boundaries are hereby released to said Com-
 agree that this plat shall be borne as by the said Christianism Ad-
 of 1 to a feet
 E. D. Murching,
 J. C. Hall
 Wm. Smith
 Directors

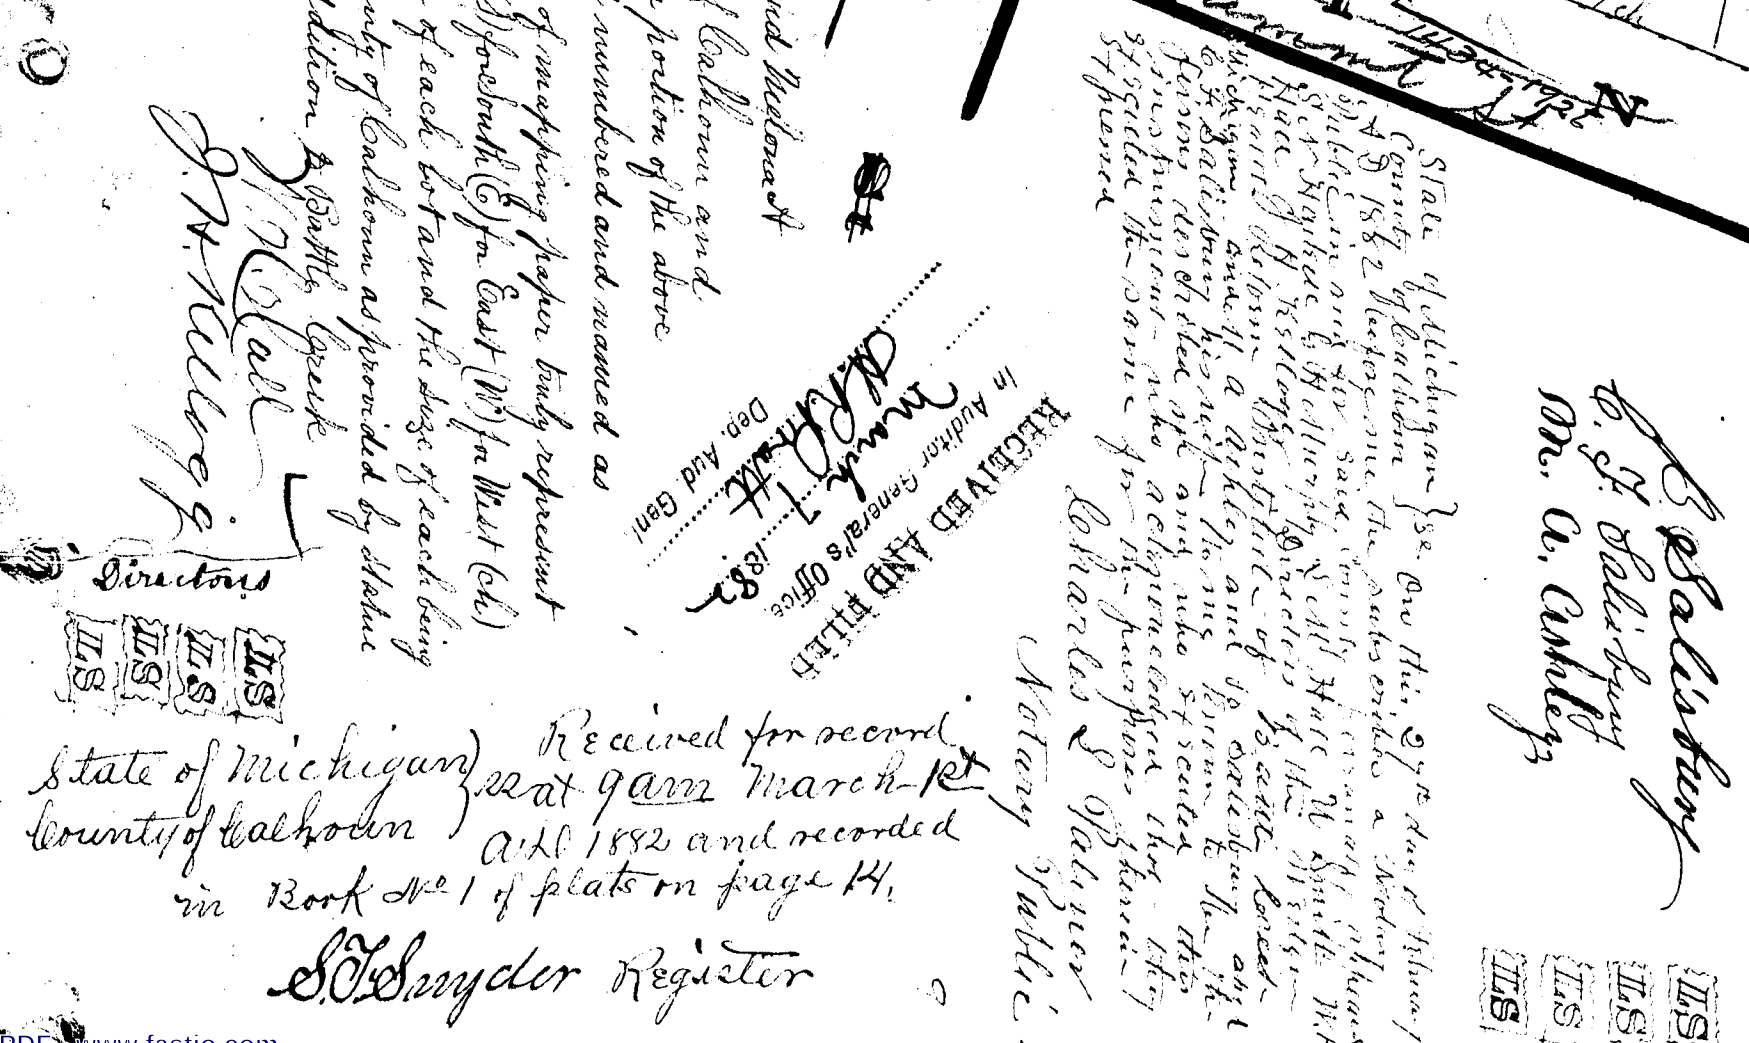

TO BATTLE CREEK.

un)²² We S. F. Snyder Register of
un) Seeds and R. B. Merritt
Civil Engineer hereby
have carefully compared the
the plat of The Sanitarium
to correct now of record in
Register of Seeds and that it
is thereof and of the whole of
S. F. Snyder Register of Seeds
R. B. Merritt Civil Engineer

State of Michigan,
County of Leelanau,
certify that we have
examined plat with the
addition to Battle C.
the office of said Re.
is a true transcript of
such record.

W. B. Salisbury
40, S. Wall Street
New York, N. Y.

State of Michigan } Received for record
County of Calhoun } at 9am March 1st
A.D. 1882 and recorded
in Book No 1 of platens page 14.
S. Schneider Register

ADDITION

13311

to the North East corner of 150th Madison's I found there
ed. 1891 along the North line of said Salimony's land.
I then chained 38th to the links to the Easting line of land
of 150th Madison's I found

certain points of all the legs are marked the fingers 1 & 6
 along said (each) line (1) one chain & (6) right, do you find
 links to the shell line of hand decided by Mr. Gaudin to show
 Barker dated March 20th 1851 James Gaudin says said John R.
 line (8) two chains & (22) hands the links to the place of beginning
 containing (62) shells & (56) do one hundredth of grains and
 of hand matter etc.

State of Michigan) We therefore signed A. H. Smyler
a Justice of the Peace } Register of Deeds said County
H. B. Murritt }
& maker of this great & necessary copy that we have
carefully compared the original copy of the plat of
the Sanbornian Edition to State & we have
found the same to be an exact transcription
of the whole of such map or plat
A. H. Smyler Register of Deeds
H. B. Murritt Atty. Engineer

2 22 43
NUMBER 30/292-2

Edwinder *Register of Land*
H. B. Smith *and Engineer*

[illegible]

W. J. Walcott
Dr. C. A. Phillips

State of Maryland
County of Anne Arundel
I, the undersigned, Clerk of the Court of the
County of Anne Arundel, do hereby certify
that the within and foregoing is a true and
correct copy of the original of the same
as the same is on file in my office.

RECEIVED AND FILED
IN ARK. DIVISION OF
MAY 17 1968
MEMPHIS

[illegible]

In presence of


Y. & M. Hall
Heath & Smith,

LLS H S H S
Directors

J. H. Williams

State of Michigan } Received for record
County of Calhoun } 22nd of June 7th 1824
in Book No 1 of said in page 14.

Snyder Register

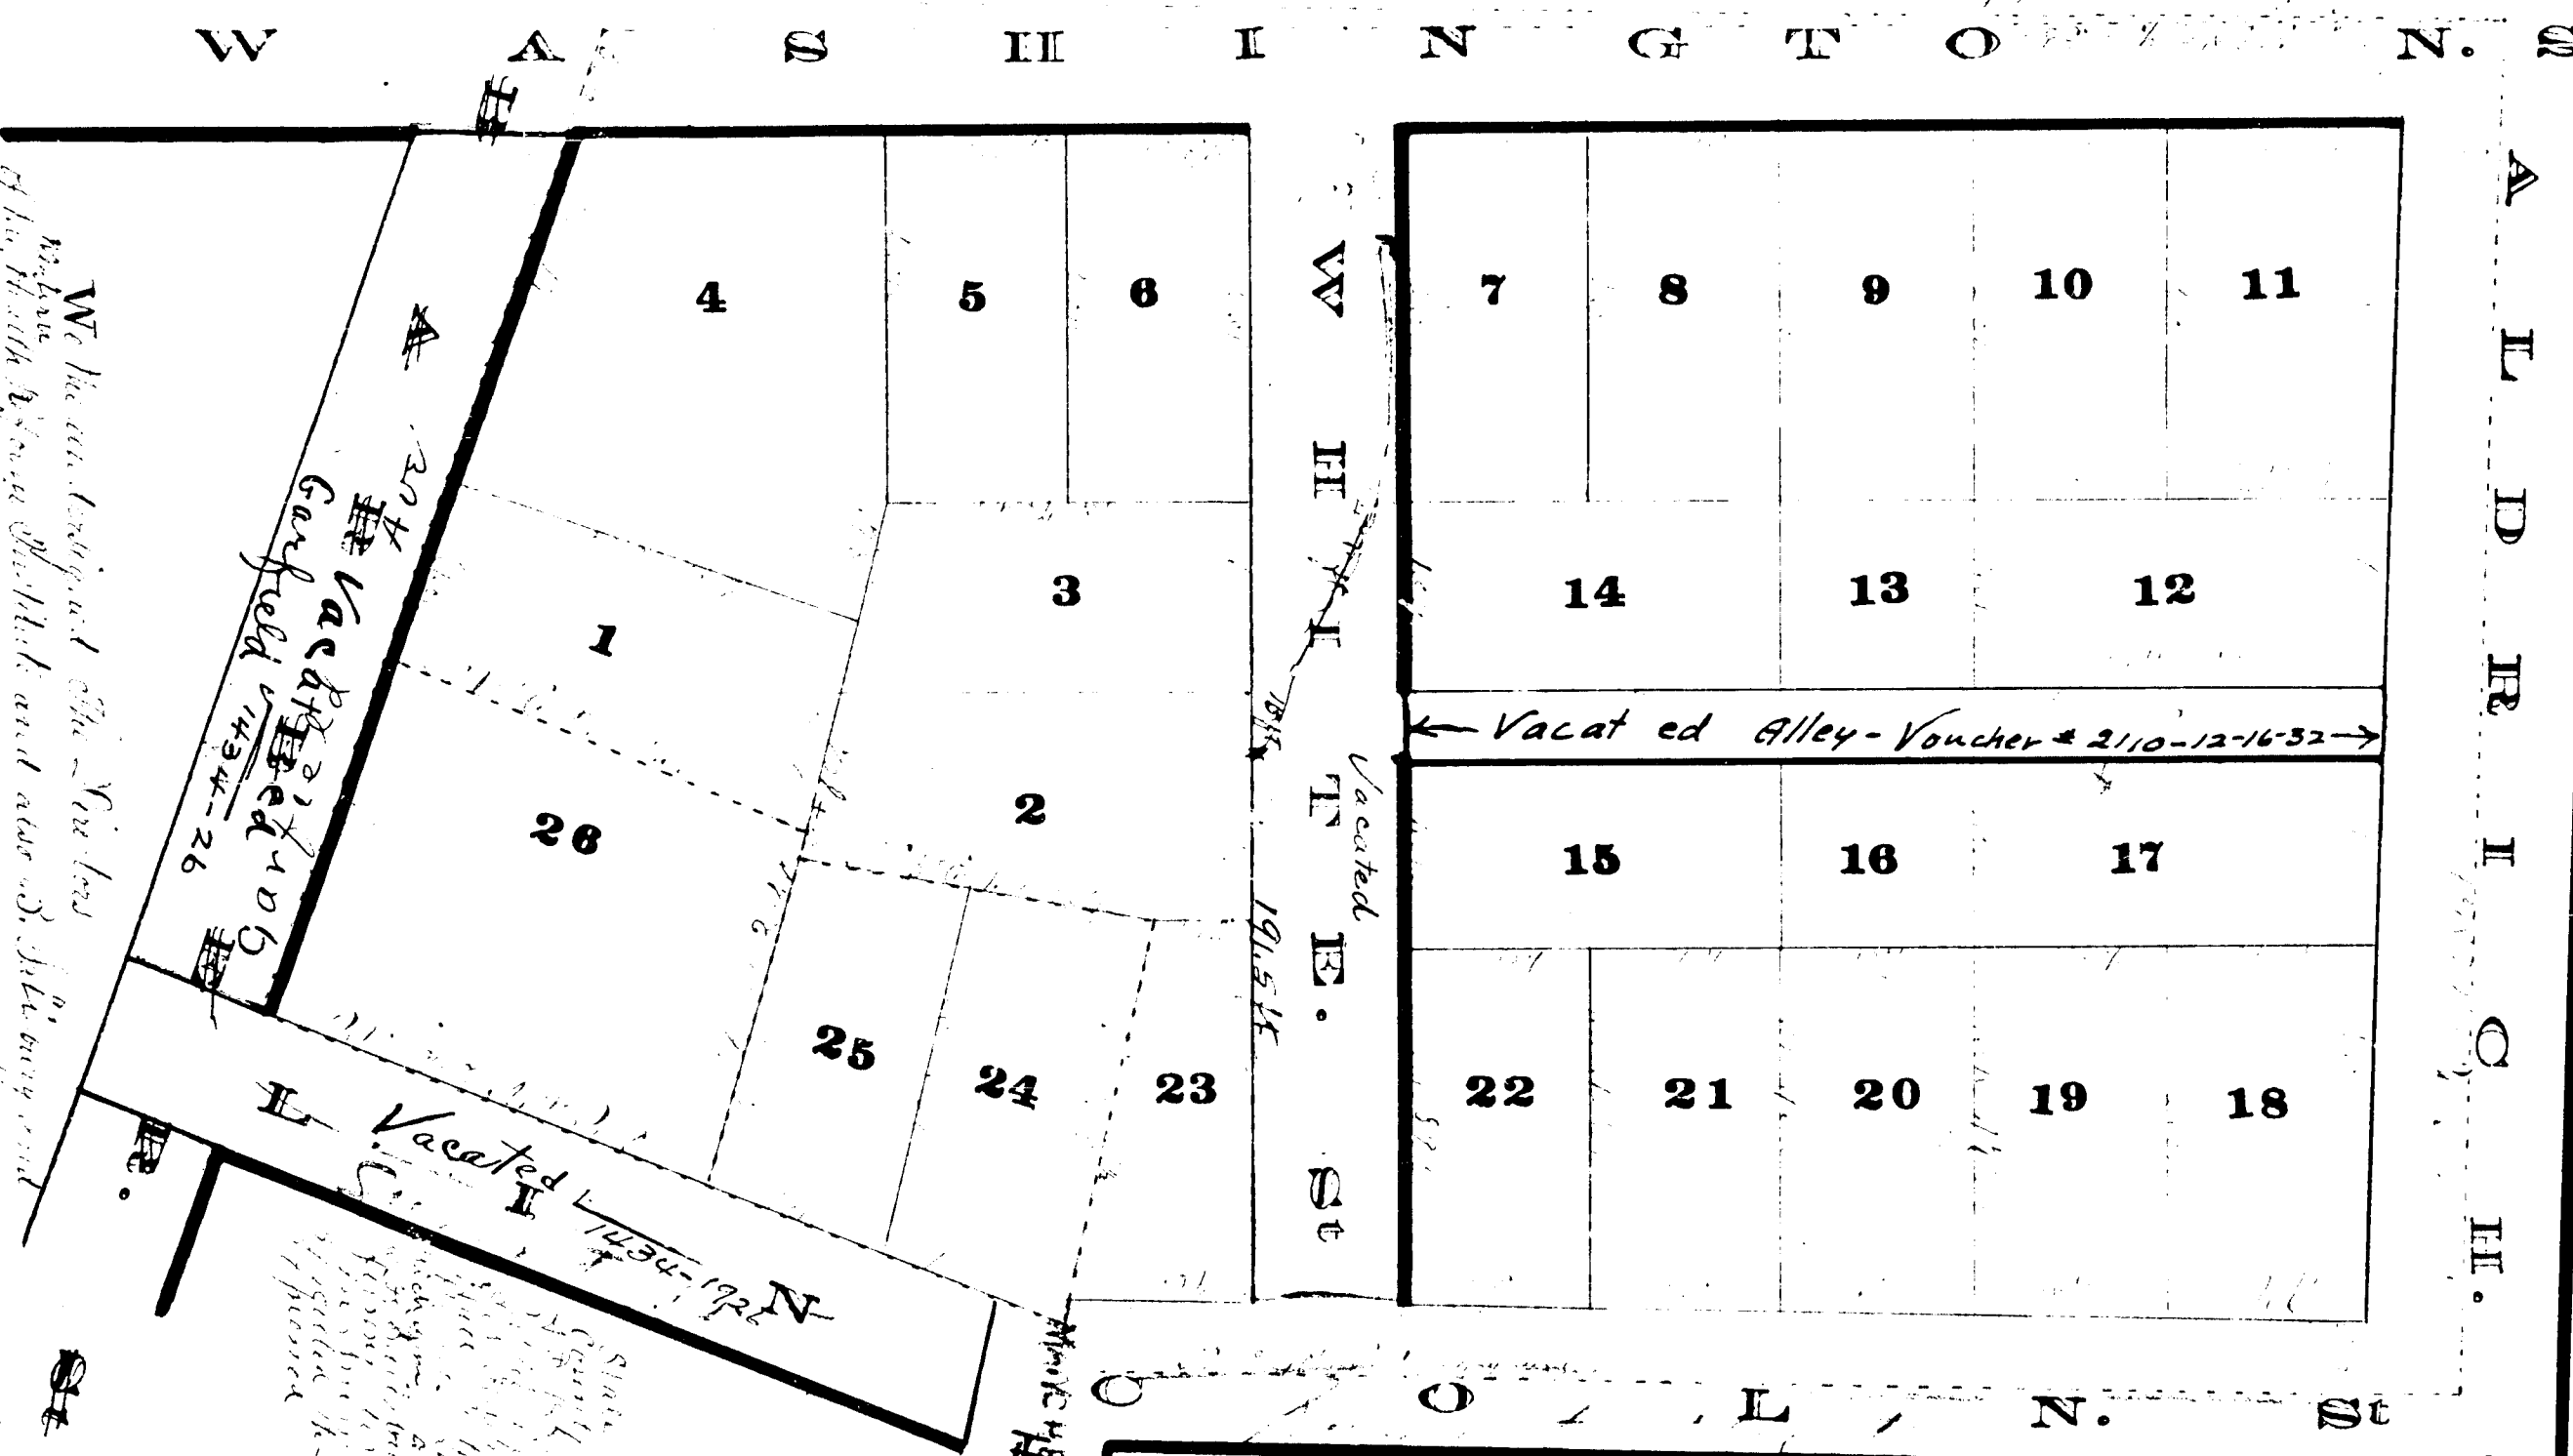[illegible]