


RECEIVED AND FILED

In Auditor General's Office,

June 10th 1884

Dep. Aud. Gen.

BURNHAM'S SUBDIVISION.

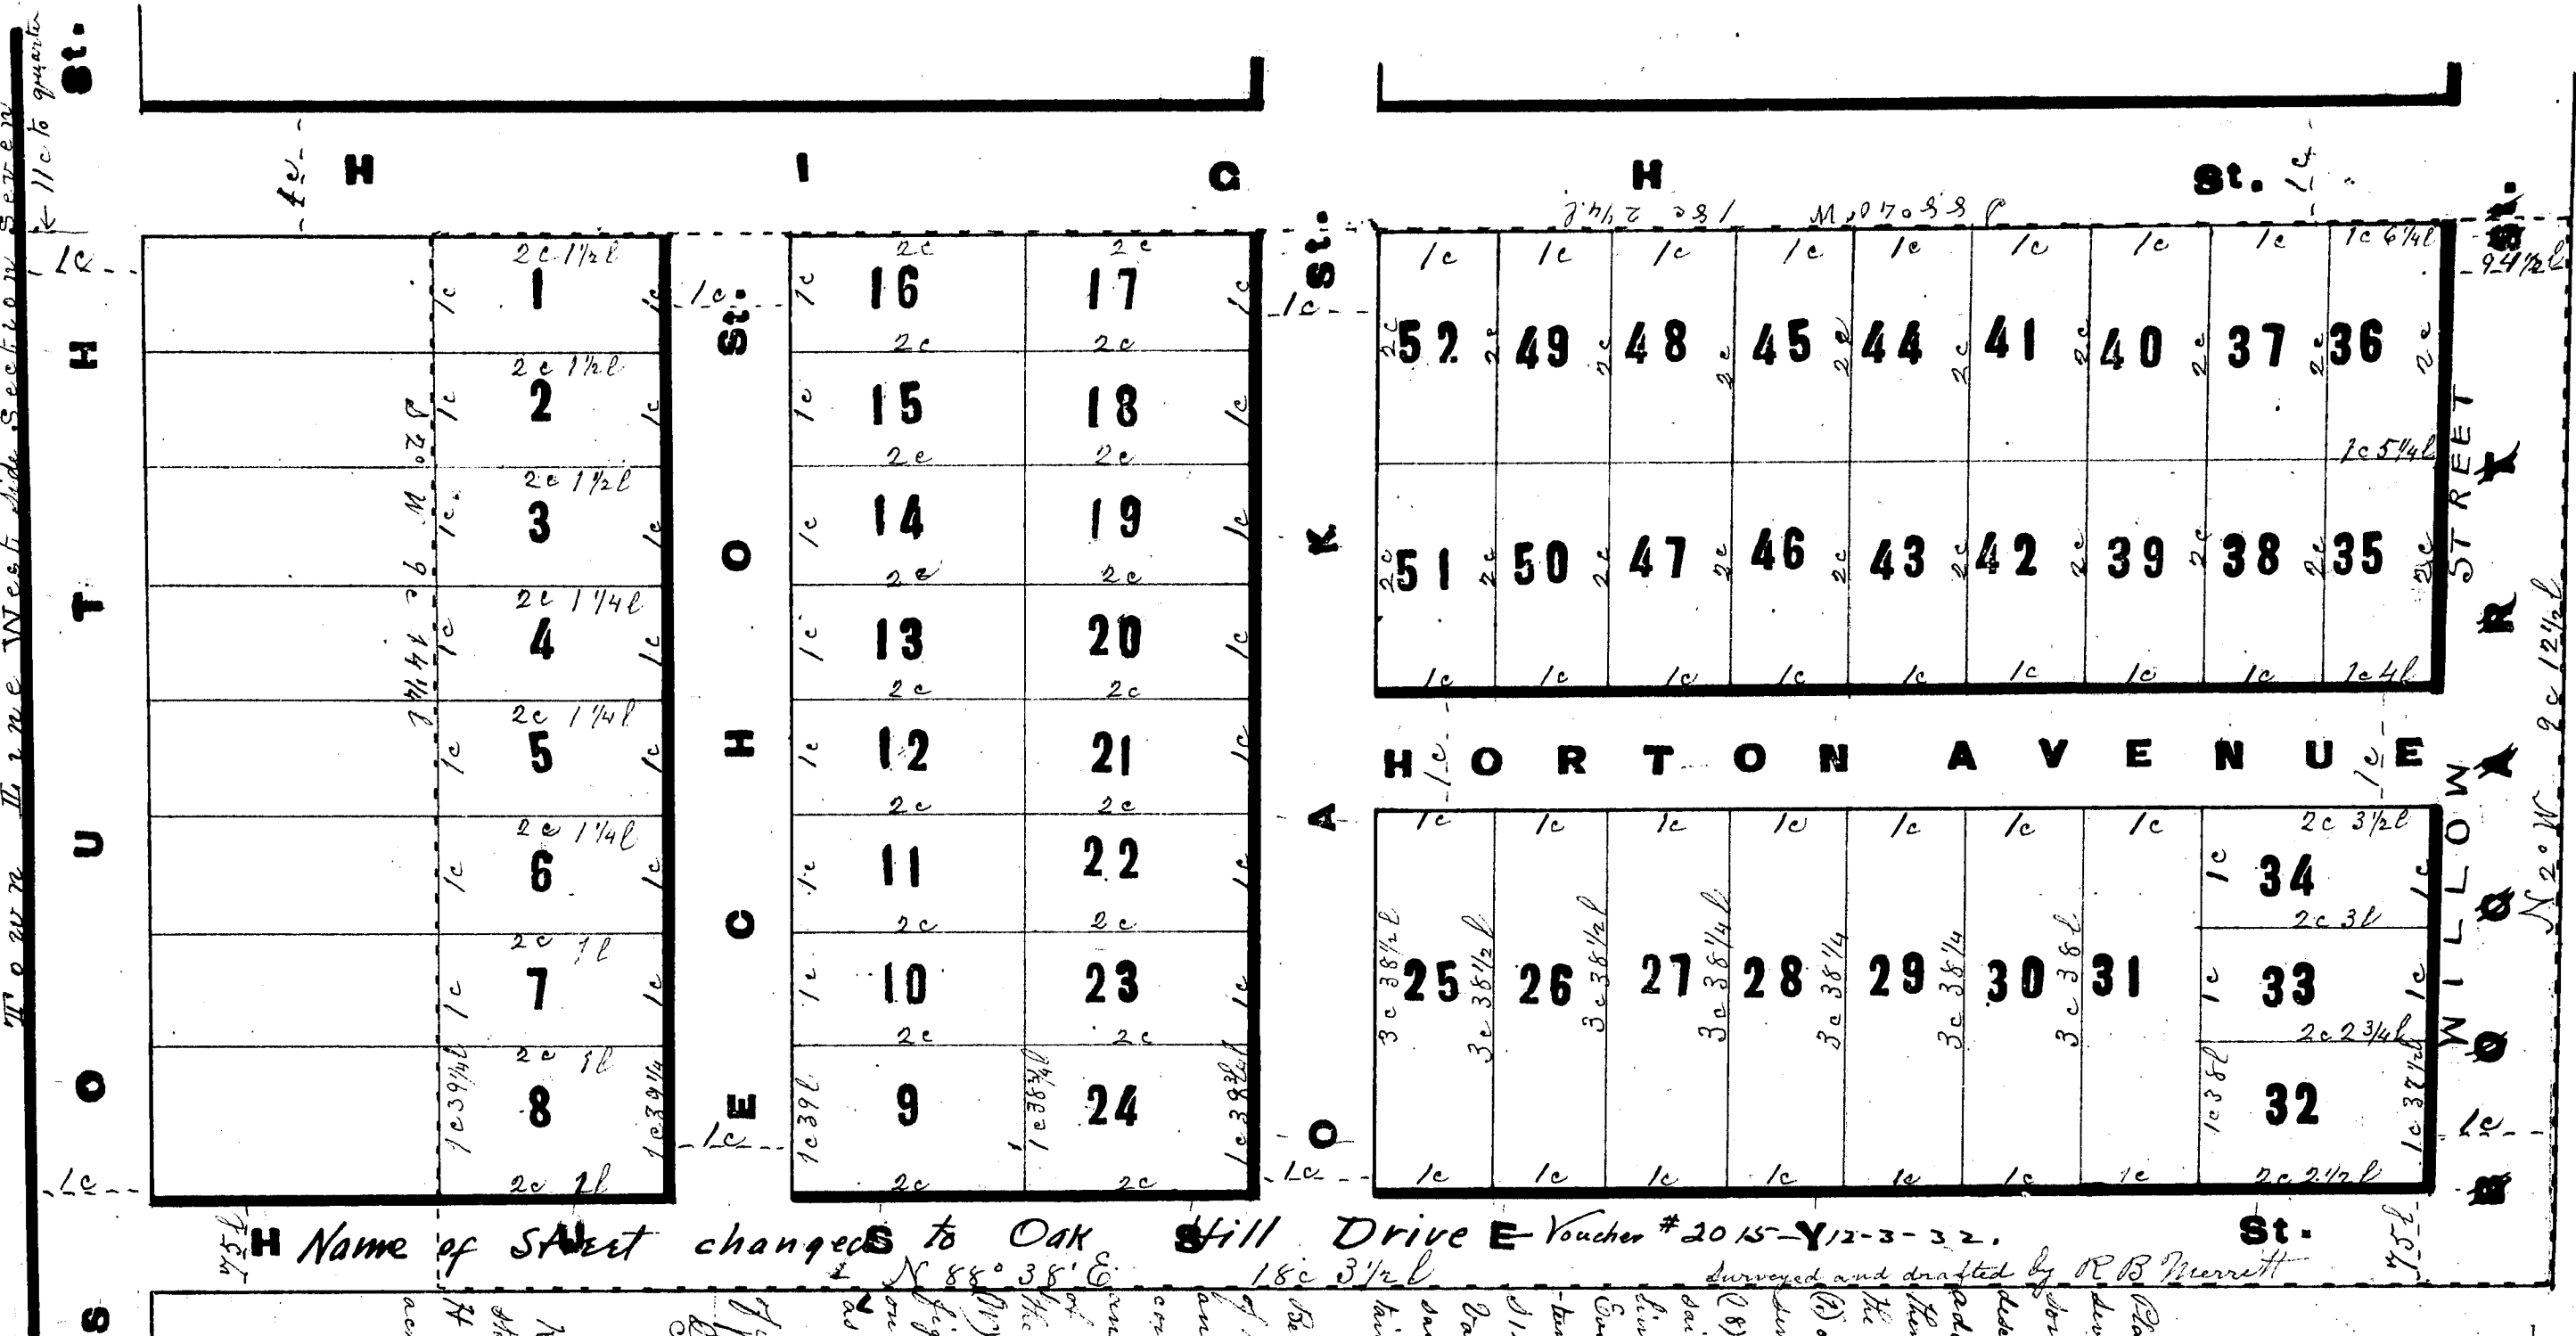

Minutes of the Survey and delivision of a part of the second
"Motto second addition to Battle Creek" Comprising lots number (24)
during town to (1) 1/2 the one inclusive being situated on section seven in Town One
South of Range seven West in the County of Calhoun and State of Michigan was particularly
therein as follows Beginning at the southeast corner of said second lot of "Motto second
addition to Battle Creek" and at the Northeast corner of the Oak Hill Cemetery land measuring
thence N 20° W along the East line of said Plot (3) nine chains and (2/3) poles and a half lies to
the top the line of High Street thence the southeast corner of John Worthington Davis thence S 79° 28' E
(8) one chain and (1/2) seven ten links thence the Northwest corner of Mrs Worthington Davis S 30° 0' E (24)
acres from and thence greater link thence S 88° 40' W along the draft line of said High Street
(8) eight chain and (2/3) feet and a half links to the Northeast corner of Lot number (9) nine one
link thence the southeast corner of Jacob Quinner thence N 60° W (2) two chains and (2) seven
link thence S 1/4 N 1/4 (2) two chains and (6) thirty links thence S 20° E along the
East line of the number (9) nine to (8) sixteen inclusive in said Plot (3) nine chains and (1/4) pole
thence a half links to the North line of said Cemetery land thence thence North line 18 inches
S 14° E (1) one chain and (3) three links thence the Southwest corner of the Military Cemetery of the then
County in said Cemetery S 24° 15' W (1) one chain and (1) eight links thence N 68° 38' E along
said North line (8) eight chain and (3/4) three and a half links to the place of beginning con-
tinuing (1) 6 1/2 chains and forty seven one hundredths acres of land more or less

But know that the undesignated "May" is "Bumkane of the City of Nalawag-e-Lank" of Nalawag-e-nid state of Mideiran, "captivity of the aborigines" of said kingdom again, and subordinate the same into left and right of the big "educational and with foundation" covered and extend and understood and named as left forth on the adjoining "Map" and that and which "Map" and that and the certain figures and signs on that page of "Mapping" for your study, observation and denote the same - You will recall first understanding the entire circumstances of the same and the letters (A) standing for North (B) for South (C) for East (D) for West - (E) for chain (F) for links (G) for object (H) for degree (I) for minutes and the figures printed near the center being the number of each set and the size being smaller on the lines of each and it is further being provided that this that shall be known as "Geometrical subdivisions" and "Geometrical subdivisions".

On arrival mine of I have been told that my hand^{out} that this third day
 of June 23^d 1884
 to John H. Hill.
 E. C. J. Robinson, } his house of James H. Robinson and
 H. S.

Wilmamoye Cemetery) 38 One Feb 3rd day of March A.D. 1884 before me a Notary Public in and for said County personally appeared Henry H. Burdick known to me to be the person, who executed the above instrument and acknowledged to me that she executed the same for the purposes herein stated.

Robert H. Hall

Friday 19/02

This plot is now a part of
the City of Battle Creek
Sept. 38 95 9/10

Spencer Perceval
and R. B. Maule
John Placido

the mineral soil of the flat top, Caumont and Shadler were with
 the original and they found the same to be an upper limestone
 layer and of the whole of such a large flat.

Mr. Paul D. Snyder, Esq.
P O Messitt & Co

State of Michigan) Received for record at 9 AM June 5,
1894 and recorded with it 10:17
County of Calhoun Plate on page 29.

Druck B. J. Gundersen Regier

State of Michigan) J. C. Smith, Register of
County of Calhoun vs Under and A. B. Myette
Civil Engineer No. 7066 by orally
that we have carefully compared the original copy
of "Standard and Division" with the registered copy
and find the copy in our file with the D. T. and find the
same to be an exact transcript from of and of the
records of such Parish Plat.
Dated 13 January 1891 Regr

*Drucke H. J. Snyder hely Regn
Pittmanville 60*

Dep. Aud. Genl.

13326

[illegible]

	H	I		I	H
1	2c 1 1/2 l	1c	1c	16	2c
2	2c 1 1/2 l	1c	1c	15	2c
3	2c 1 1/2 l	1c	1c	14	2c
4	2c 1 1/4 l	1c	1c	13	2c
5	2c 1 1/4 l	1c	1c	12	2c
6	2c 1 1/4 l	1c	1c	11	2c
7	2c 1 l	1c	1c	10	2c
8	2c 1 l	1c	1c	9	2c
	2c 1 l	1c	1c		2c

H Name of Street changed to Oak Still Drive E Voucher # 20 15-Y 12-3-32.
N 88° 38' E 18c. 3 1/2 ft. Surveyed and drafted

Minutes of the survey and subdivisions of a part of the Grand
"North Second Addition to Battle Creek" comprising lots number (24)
during town to (31) poles, one inclusive being situated on section seven in Town One
south of Range seven West in the County of Calhoun and State of Michigan, was positively
determined as follows:

Beginning at the northeast corner of said second part of "North Second
Addition to Battle Creek" and at the Northeast corner of the Oak Hill Cemetery lands adjoining
thereon N 20° W along the East line of said first (3) main claim and (234) poles and a half lands to
the top the line of High Street We have the southwest corner of Van Hookfield Grove thence S 34° 0' E 79° 50' E
(1) one chain and (17) seven ten links thence also the Southwest corner of Van Hookfield Grove thence S 34° 0' E 79° 50' E
across from and then quarter link thence S 88° 40' W along the draft line of said High Street
(2) eight chain and (24) two and a half links to the Northeast corner of lot number (9) mine one
third that between the northeast corner of said claim's thence N 68° 19' (2) two chains and (17) seven
links thence also thence S 18° 15' (1) one chain and (6) six links thence S 2° 0' E along the
East line of lot number (9) mine to (6) sixteen inclusive on said first (3) main claim and (14) 1/2 pole
and a half links to the North line of said Cemetery land thence thence thence 18 inches
(1) 1/2 (1) one chain and (3) three links also the Northwest corner of the Northby Cemetery of the thence
thence North line (3) eight chain and (34) three and a half links to the place of beginning, re-
beginning (1675) thence and going on one hundredth part of said seven and less

It is known that the undersigned Mary H. Brewster of the City of Baltimore - County of Baltimore and State of Maryland Depositor of the above record of said definitely defined and subdivided the same into lots and sheets of the dig-minerals and with boundaries created and extent and numbered and named as set forth on the adjoining Map. said tract and subdivided Map and Plat and the certain figures and signs on this Map of Mapping Paper truly represent and describe the same - You will still find including the entire contents of the same and the letters (A) standing for sheet (C) for draft (C) for east (N) for West - (C) for canvas (N) for linen (S) for sheet (C) for signs (C) for minutes and the figures printed near the outer lining the number of each lot and the dig being written on the lines of each and it is further hereby proclaimed that this list shall be known as "Baltimore subdivisions".

in witness whereof I have hereunto set my hand, that this third day

of May A.D. 1884

John H. Hill.

E. C. Johnson, Esq. Mayor of the City of Baltimore

W.S.

Wilmington County N.C. One third $3\frac{1}{4}$ day of June of 1884 before me a Notary Public in and for said County personally appeared Henry W. Curran known to me to be the person who executed the above instrument and acknowledged to me that she executed the same for the purposes herein stated.

Robert H. Bell.
Notary Public,
Madame de la Mich

State of Michigan) We the undersigned State Society of
 Free Aged, Poor, Blind, Deaf, Dumb and Orphan
 Children Society (Aged, Blind, Deaf, Dumb and Orphan
 Children Society) do hereby certify that we have received
 the proceeds of the State of Michigan and State Society of
 Free Aged, Poor, Blind, Deaf, Dumb and Orphan
 Children Society and have found the same to be as
 the same and of the whole of such and of the State.


Wm. B. & Mary Help Regn
R B Merrill & Co

State of Michigan) Received for record at 9 A.M. June 5.
County of Calhoun No. 1874 and recorded on Court April 17.
Date on page 29.

Frank B. Snyder, Esq.

State of Ohio and) of East Smith Descriptive of
County of Hamilton (see index and A. B. Wright
and examine the accompanying
that we have carefully compared the manuscript copy
of "General and Miscellaneous" with the original and also
with the copy in my file and true. Of the good and true the
same to the copy of the manuscript found and of the
interest of each State in Ohio.

Dr. Wm. B. Angell
Dr. Wm. B. Angell
Dr. Wm. B. Angell

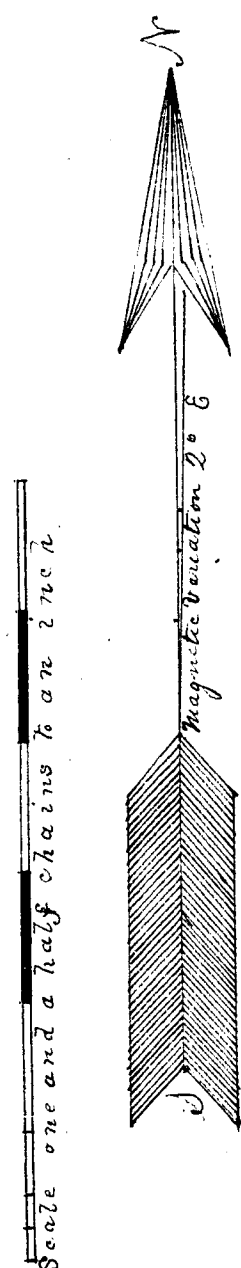

Town Line West side Section Seven

Dep. Aud. Genl.

13326

•

H Name of Street changed to Oak Hill Drive E Voucher # 2015-Y12-3-32.

dividing $(1/\sqrt{2\pi})$ by the area of a unit circle

2 "Innocent's confidence"

1111461

acknowledged to me that she was called for dinner for five persons and this was all that

Ed. Mink-

the use of local units

10

[illegible]

JE J3 Meredith Co

Plato's 'Meno' 29.

—

Alvarez to J. J. Snyder, Deputy Regr.

RG Merwin 00