


L. J. CALDWELL'S

ADDITION

TO BATTLE CREEK.

Received and Filed  
In Auditor General's Office  
July 31 1888  
Wm. J. Caldwell  
Dep. Ass. Genl.

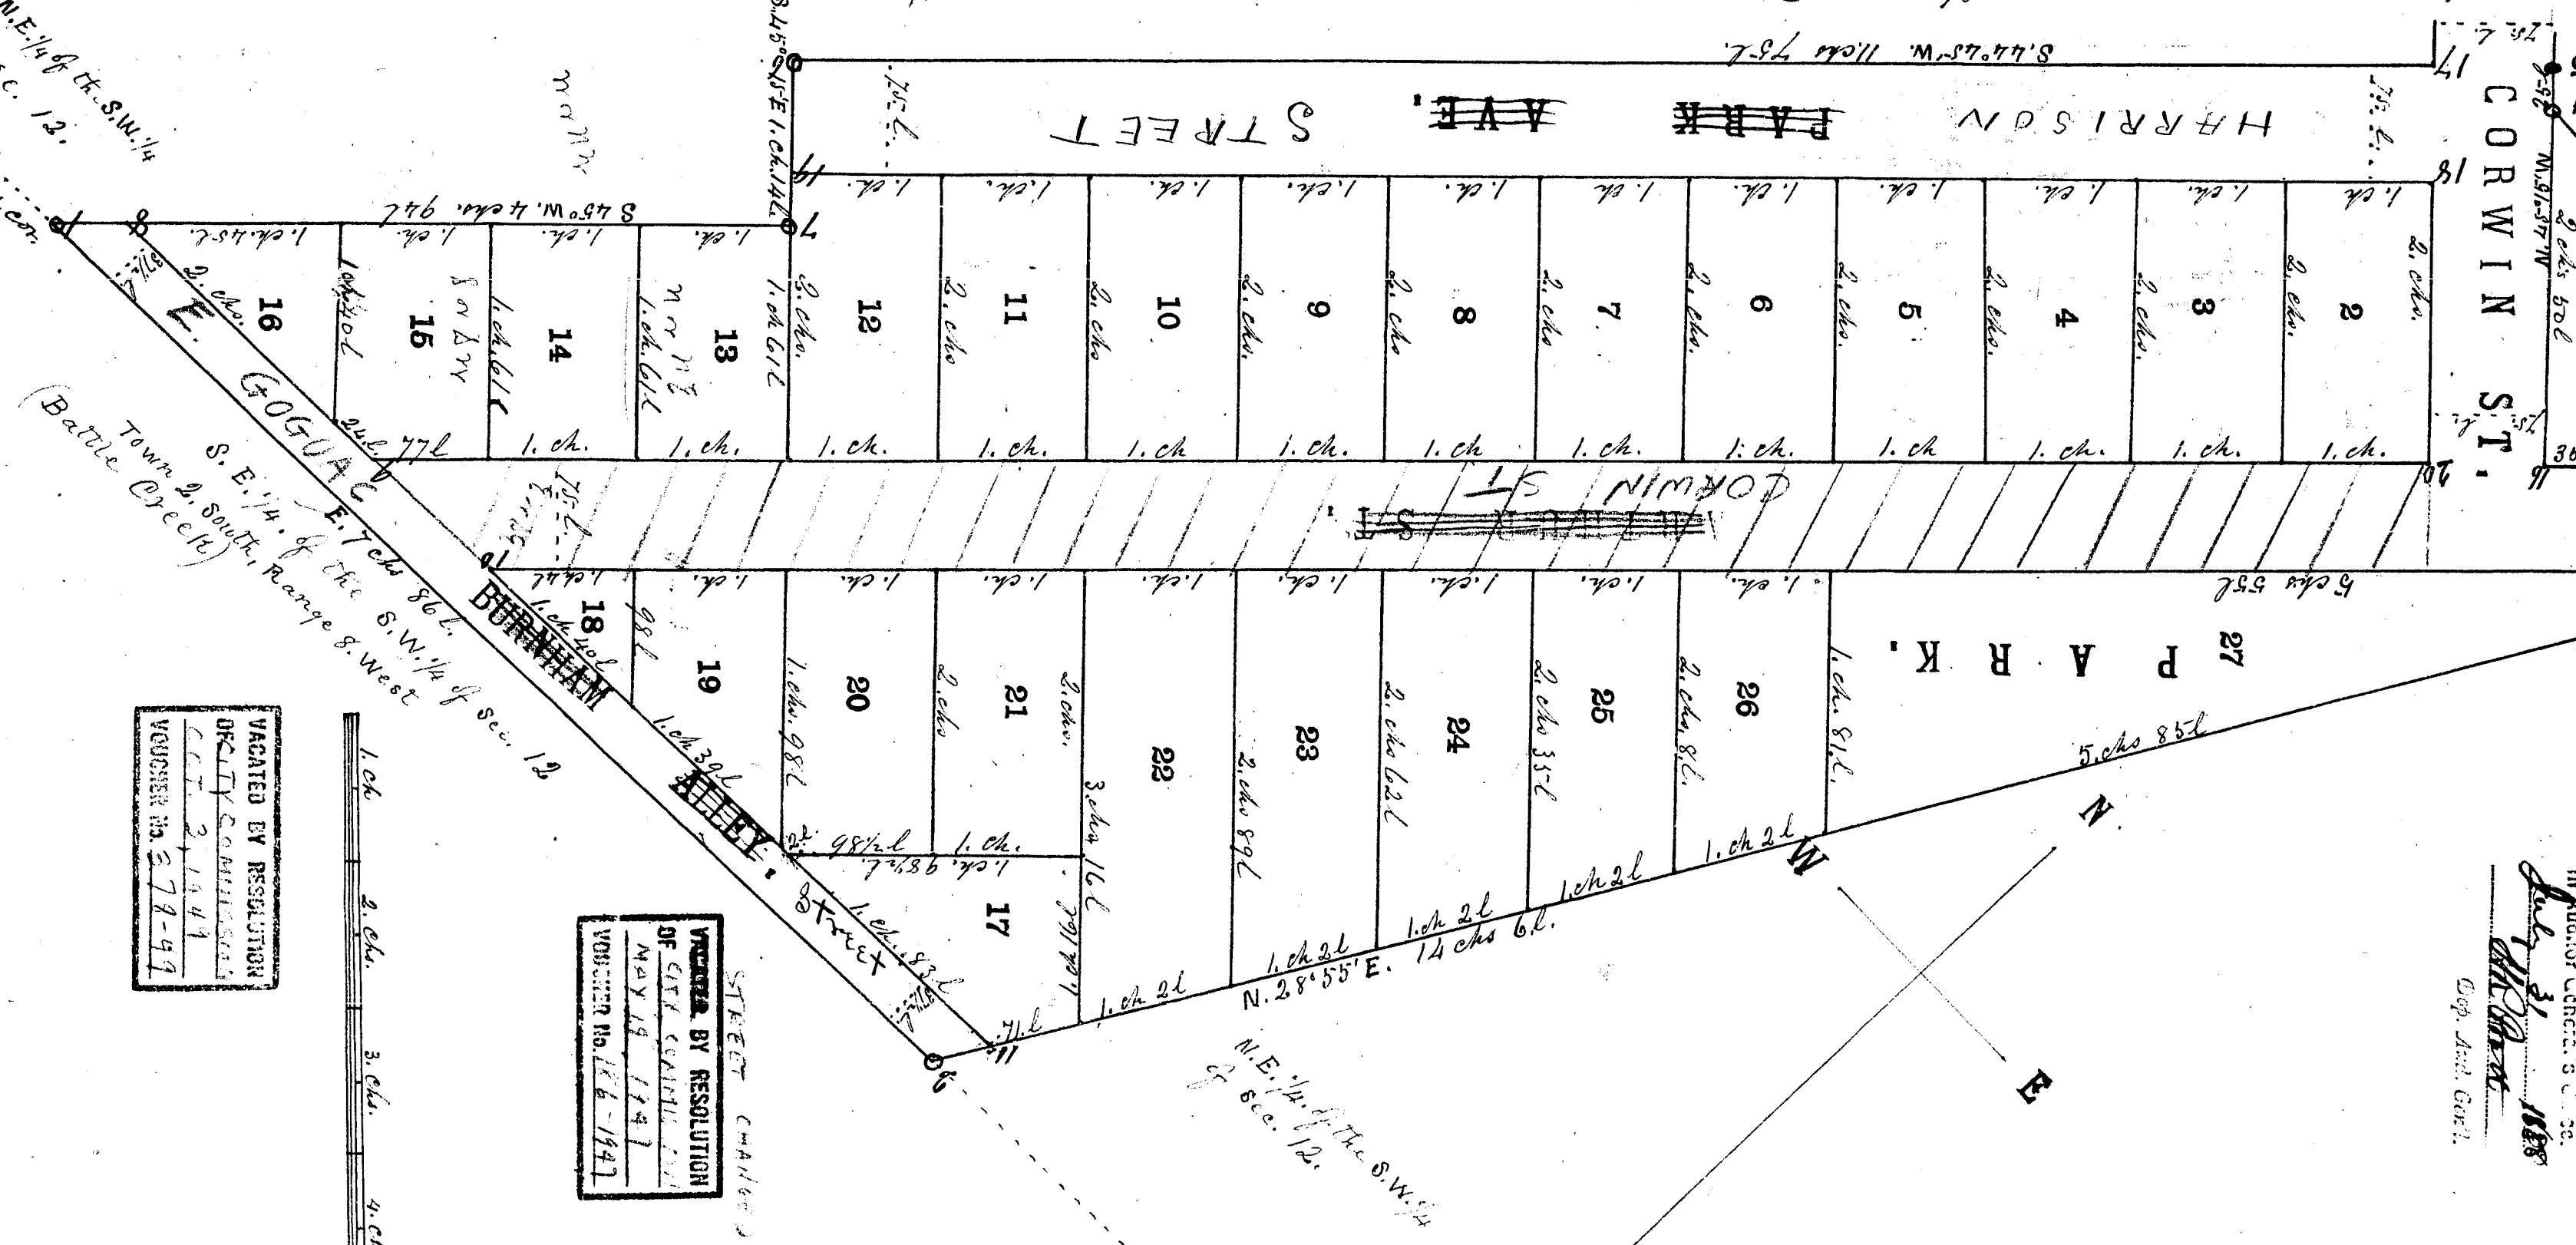

VACATED BY RESOLUTION  
OF CITY COMMISSIONERS  
JULY 2 1888  
NUMBER 12 278-99

RESOLVED BY RESOLUTION  
OF CITY COMMISSIONERS  
MAY 19 1888  
NUMBER 12 114-1

On this 28th day of May, 1888, before me, the undersigned, a Notary Public in and for the County of Calhoun, State of Michigan, appeared the persons whose names are subscribed to the foregoing plat, and acknowledged to me that the same is correct in all its particulars, and that they have executed the same for the purposes therein expressed, and that the instruments described in said plat have been printed as therein mentioned.

Witness my hand and the seal of my office this 28th day of May, 1888.

L.S.  
L.S.

State of Michigan  
County of Calhoun  
ss. Frank B. Snyder, Register of Deeds, and  
A.W. Austin, Surveyor, hereby certify that we have each carefully compared the original plat of 1/2 of Calhoun's addition to Battle Creek, and that it is an exact copy thereof, and of the whole of such original map or plat.

And with this I, Surveyor, hereby certify that we have each carefully compared the original plat of 1/2 of Calhoun's addition to Battle Creek, and that it is an exact copy thereof, and of the whole of such original map or plat.

Witness my hand and the seal of my office this 28th day of May, 1888.

L.S.  
L.S.

State of Michigan  
County of Calhoun  
ss. Frank B. Snyder, Register of Deeds, and  
A.W. Austin, Surveyor, hereby certify that we have each carefully compared the original plat of 1/2 of Calhoun's addition to Battle Creek, and that it is an exact copy thereof, and of the whole of such original map or plat.


And with this I, Surveyor, hereby certify that we have each carefully compared the original plat of 1/2 of Calhoun's addition to Battle Creek, and that it is an exact copy thereof, and of the whole of such original map or plat.

Witness my hand and the seal of my office this 28th day of May, 1888.

L.S.  
L.S.

# ADDITION

Received of \_\_\_\_\_  
 the sum of \_\_\_\_\_  
 for \_\_\_\_\_  
 July 31 1888  
 Wm. A. R. R.

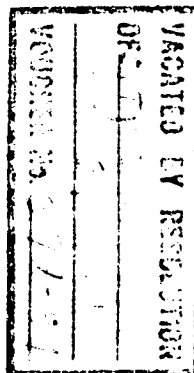

|        |        |        |        |
|--------|--------|--------|--------|
| 1. ch. | 2. ch. | 3. ch. | 4. ch. |
|--------|--------|--------|--------|

'S'T

'S'T

