


IN AUDITOR GENERAL'S OFFICE
November 12, 1888
H. R. Pratt
Deputy Auditor General

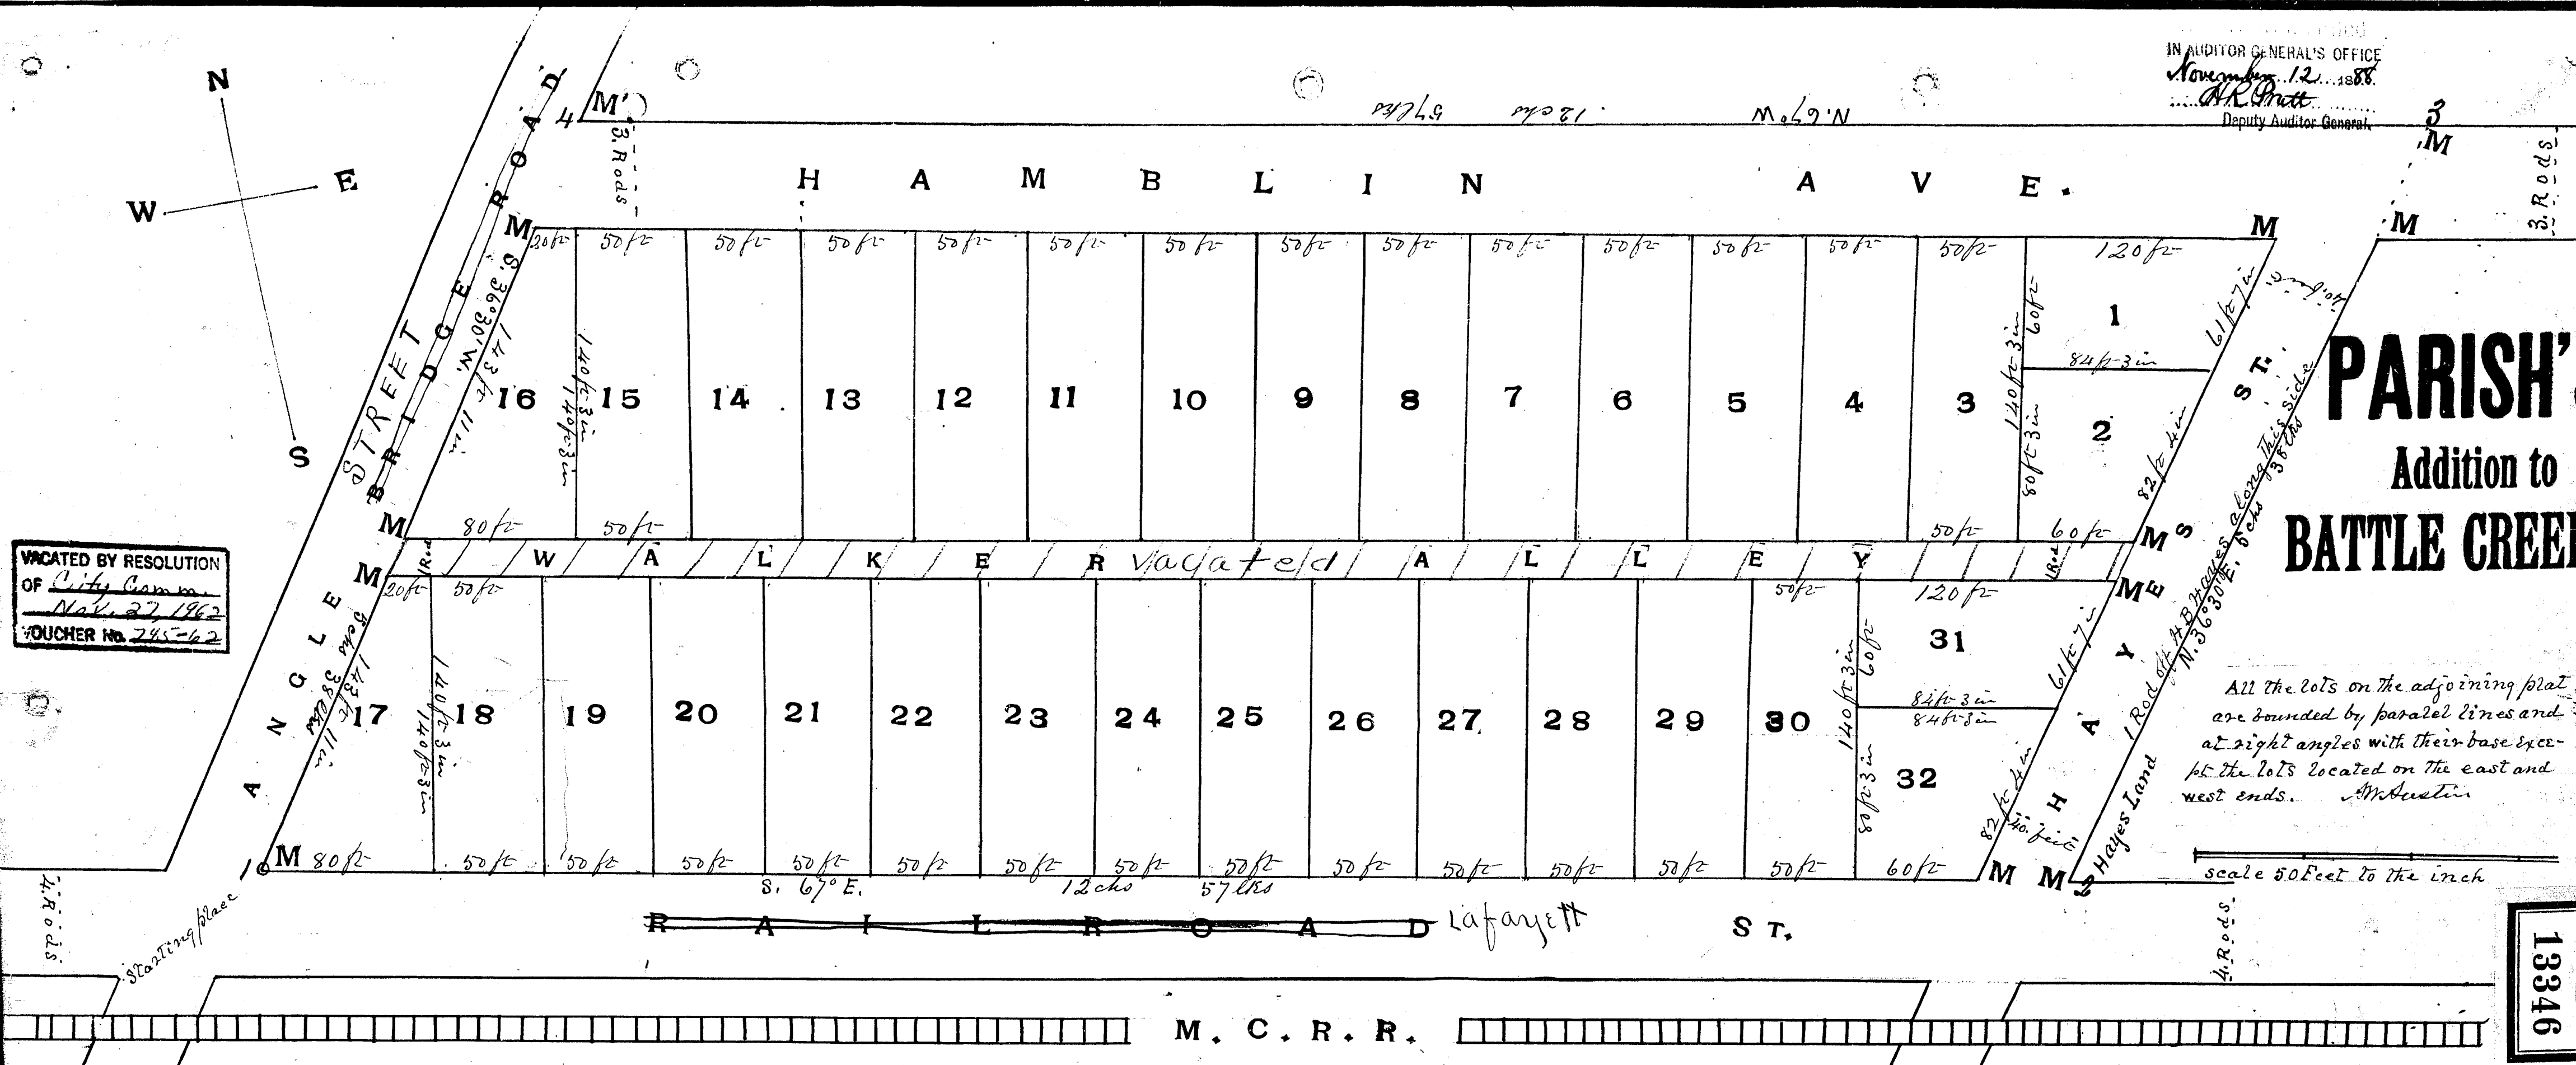

The adjoining plat is situated on the south East quarter of sec. 2, in Township 2, South, Range 8, West and bounded as follows:
Beginning on the East line of the high-way known as the Angle Bridge Road (running Northerly and Southerly) at a point of intersection by a line on the North Side of the high-way running Eastward and Westward along the North side of the Michigan Central R.R. (running Eastward and Westward through said sec.) Said high-way is known as Rail Road St. Said point of beginning is designated by a monument and two witness trees, viz. Elm 22 ins. S. 74 E. 1.57 chs. Elm 13 3/4 ins. E. 62 chs. Running thence along the North Side of said highway (Rail Road St.) South 67° East 12 chs. 57 lks. to a monument (to 2 on the plat)
Thence North 36° 30' E. 5 chs. 38 lks. to a monument (to 3 on the plat)
Thence North 67° West 12 chs. 57 lks. to a monument
On said East line of said Angle Bridge Road (to 4 on the plat) Elm 10 ins. N. 44 1/2° E. 17 chs. Bass Wood 12 ins. S. 30° W. 12 chs.
Thence South 36° 30' West along the East side of said Angle Road 5 chs. 38 lks. to place of beginning (to 1 on the plat)
Each monument consists of a Cedar stake, two feet long (about) and three to four inches through, planted full depth in the ground and each witnessed by three stones put down in and even with the surface of the ground, said stones ranging from five to seven inches through
A. W. Austin Surveyor

I hereby certify that I have made the survey, drafted the adjoining plat and the same is correct to the best of my knowledge and belief and that the monuments described in said plat have been planted as therein described
A. W. Austin Surveyor

Examined and Approved
November 1, 1888.
H. R. Pratt
Deputy Auditor General

State of Michigan }
County of Calhoun } ss. Frank B. Snyder
I, Frank B. Snyder, Register of Deeds and
County of Calhoun } ss. A. W. Austin Surveyor
certify that we have each carefully compared
this copy with the original plat of Parish's Addition to
Battle Creek and that it is an exact copy thereof and of
the whole of such original map or plat
Frank B. Snyder Register of Deeds
A. W. Austin Surveyor

State of Michigan }
County of Calhoun } ss. Frank B. Snyder
I, Frank B. Snyder, Register of Deeds and
County of Calhoun } ss. A. W. Austin Surveyor
certify that we have each carefully compared
the annexed copy with the plat of Parish's Addition to
Battle Creek now of record in the office of said Register of
Deeds and that it is a true transcript thereof and of the whole of such record
Frank B. Snyder Register of Deeds
A. W. Austin Surveyor

¶ 2. The undersigned, Horace B. Hayes of the City of Battle Creek County of Calhoun State of Michigan and Eliphalet H. Parish of the township of Battle Creek County and State aforesaid; proprietors of the above described piece of land, do hereby lay out the same, into lots, streets and alley, of the size, dimensions and with boundaries, corners, and extent, and numbered, and named, as set forth on the adjoining plat on this page of mapping paper, and the certain figures and signs, truly represent and describe the same; N. standing for North, E. for East, S. for South, W. for West, chs. for chains, lks. for links, ° for degrees, ' for minutes, ft. for feet, in. for inches, St. for Street, M. for monument, and the figures near the center of each lot being the number thereof, and the size being written on the lines of each, And that portion marked for street or alley on said plat, is hereby released to said County of Calhoun, as provided by statute, in trust for the use of the public as a street or alley, And it is mutually agreed that this plat, shall be known as Parish's addition to Battle Creek.
In witness whereof we have hereunto set our hands and seals this 31st day of October 1887.


In Presence of
E. E. Hough Eliphalet H. Parish
E. S. Walker Ella S. Parish
Horace B. Hayes
State of Michigan }
County of Calhoun } ss. On this the 31st day of October 1887 before me, the undersigned, a Notary Public in and for said County, personally came Horace B. Hayes, Eliphalet H. Parish and his wife Ella S. Parish, known to me to be the proprietors named in the above addition to Battle Creek, and each of them acknowledged that they made and executed the same as their free act and deed and for the purpose therein set forth; Also, A. W. Austin the person who made the survey and drafted the adjoining plat, appeared before me, and testified that the same is correct to the best of his knowledge and belief and that the monuments described in said plat, have been planted as therein described
Eli S. Walker Notary Public in and for Calhoun County Michigan

2594

State of Michigan }
County of Calhoun } Received for record November 9th 1888 at 1:30 o'clock P.M. and Recorded in Book 1 of Plats on page 47.
Frank B. Snyder
Register of Deeds.

A. W. Austin Surveyor hereby certify that we have each carefully compared the annexed copy with the plat of Parish's Addition to Battle Creek now of record in the office of said Register of Deeds and that it is a true transcript thereof and of the whole of such record
Frank B. Snyder Register of Deeds
A. W. Austin Surveyor

November 12 88
H. R. Pratt
Deputy Auditor General

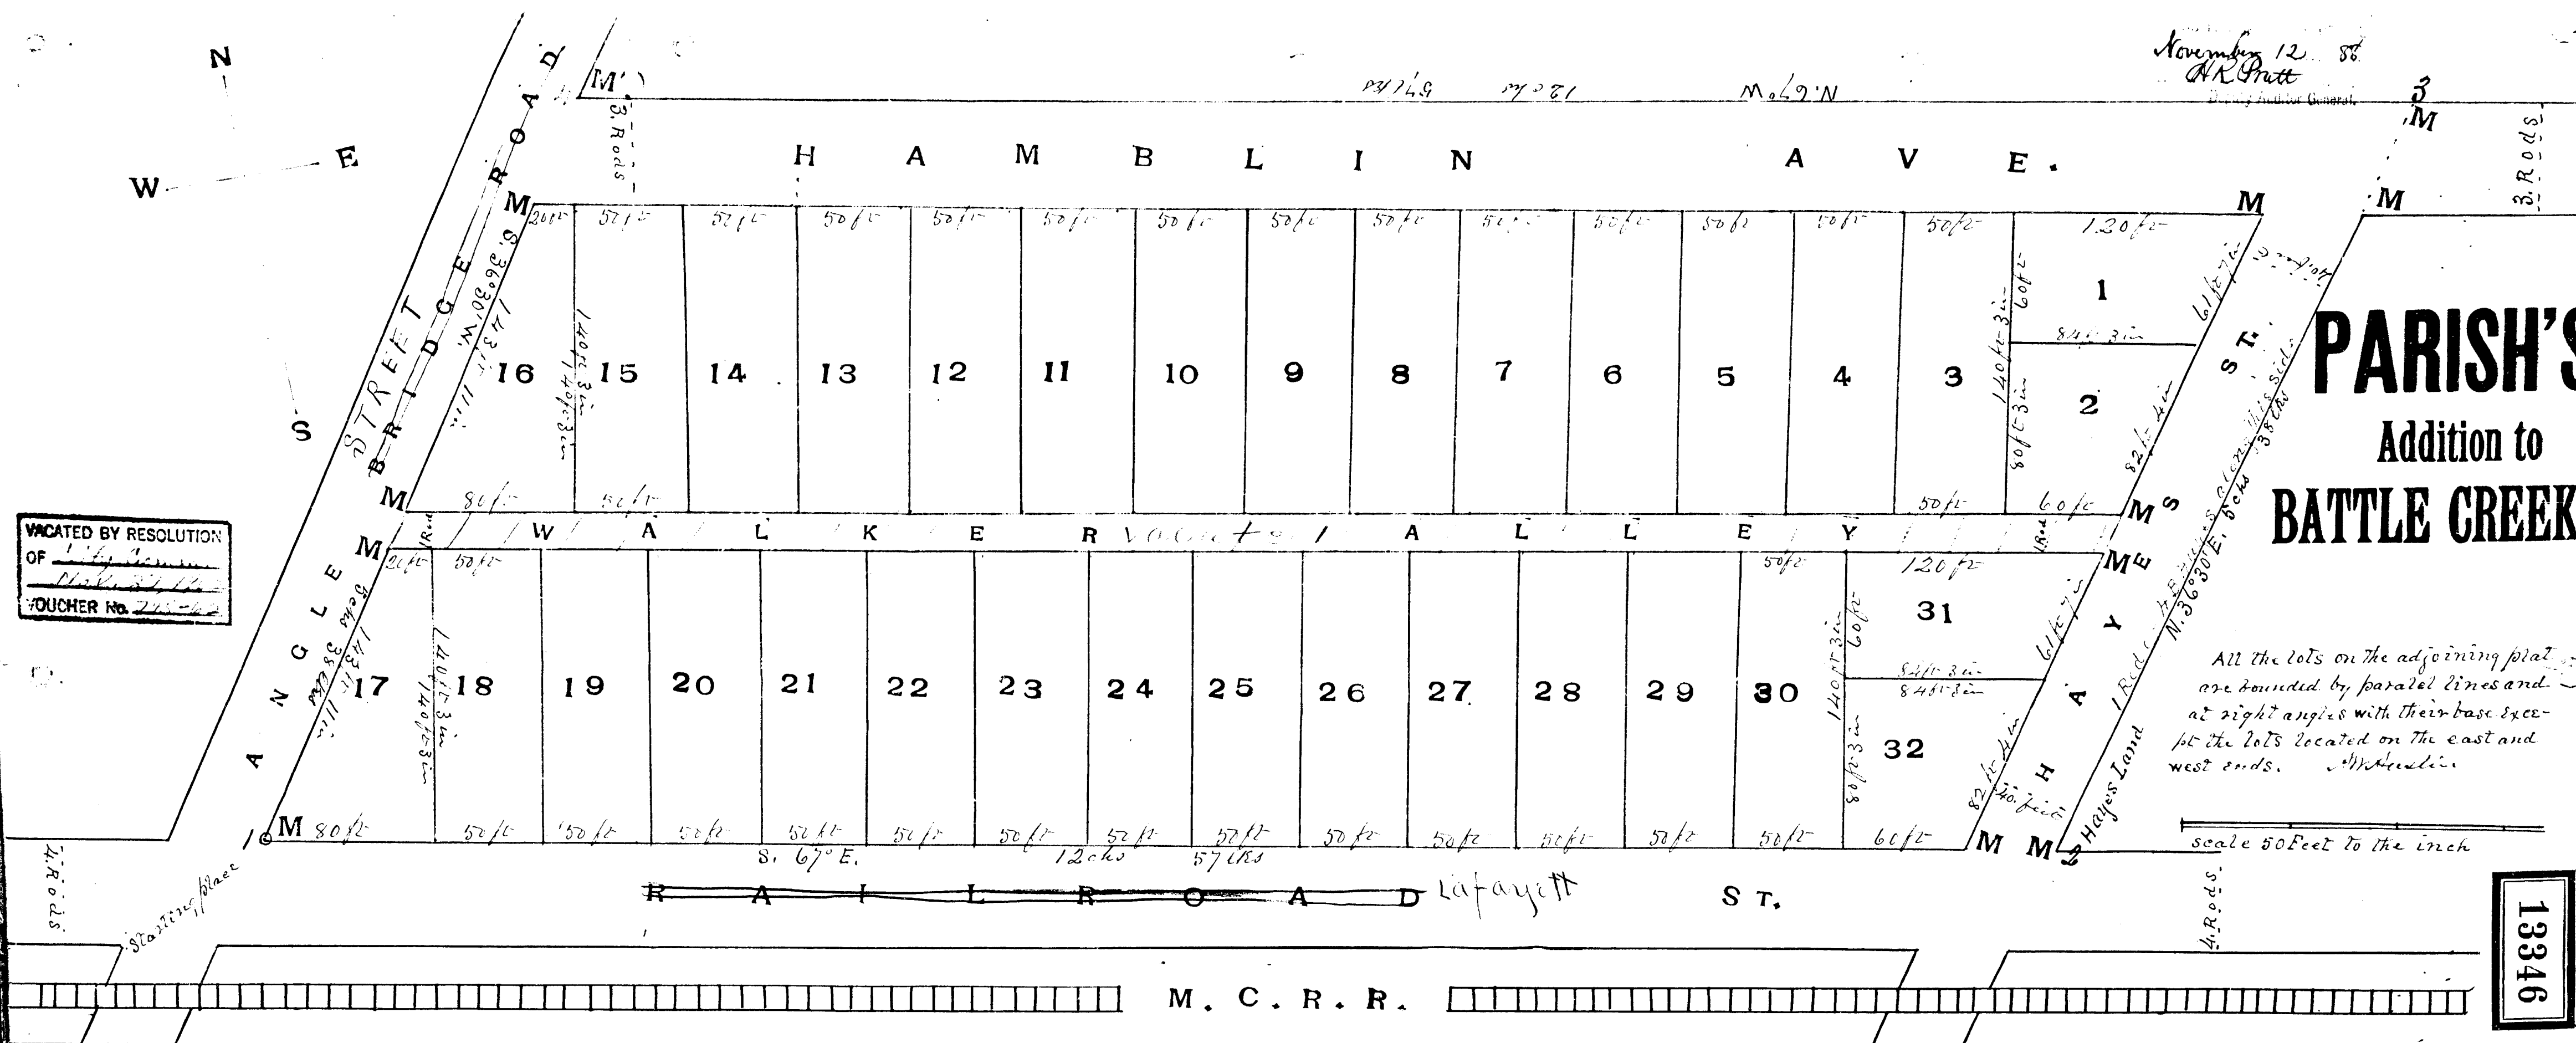

The adjoining plat is situated on the south East quarter of sec. 2, in Township 2, South, Range 8, West and bounded as follows.
Beginning on the East line of the high-way known as the Angle Bridge Road (running Northernly and Southernly) at a point of intersection by a line on the North side of the nick-way running Eastward and Westward along the North side of the Michigan Central R.R. (running Eastward and Westward through said sec.) Said high-way is known as Rail Road St. Said point of beginning is designated by a monument and two witness trees viz. E. 22 ins. 57 chs. 10 in. N. 44 1/2° E. 17 chs. 38 lks. 22 ins. 57 chs. 10 in. N. 39° E. 62 chs. Running thence along the North side of said nick-way (Rail Road St.) South 67° East 12 chs. 57 lks. to a monument (to 2 on the plat).
Thence North 36° 30' E. 5 chs. 38 lks. to a monument (to 3 on the plat).
Thence North 67° West 12 chs. 57 lks. to a monument on said East line of said Angle Bridge Road (to 4 on the plat).
Thence South 36° 30' West along the East side of said Angle Bridge Road 5 chs. 38 lks. to place of beginning (to 1 on the plat).
Each monument consists of a cedar stake, two feet long (about) and three to four inches through, planted full depth in the ground and each witnessed by three stones put down in and even with the surface of the ground, said stones ranging from five to seven inches through.

I hereby certify that I have made the survey, drafted the adjoining plat and the same is correct to the best of my knowledge and belief and that the monuments described in said plat have been planted as therein described.
Wm. F. Snyder
Surveyor

Examined and Approved
November 1, 1888.
H. R. Pratt
Deputy Auditor General

State of Michigan }
County of Calhoun } ss. Frank B. Snyder
Register of Deeds and
Surveyor
I hereby certify that we have each carefully compared this copy with the original plat of Parish's Addition to Battle Creek and that it is a true and correct copy thereof and of the whole of such original map or plat.
Frank B. Snyder
Register of Deeds
Wm. F. Snyder
Surveyor

State of Michigan }
County of Calhoun } ss. Frank B. Snyder
Register of Deeds and
Surveyor
I hereby certify that we have each carefully compared the annexed copy with the plat of Parish's Addition to Battle Creek now on record in the office of said Register of Deeds and that it is a true and correct copy thereof and of the whole of such original map or plat.
Frank B. Snyder
Register of Deeds
Wm. F. Snyder
Surveyor

I, the undersigned, Horace B. Hayes of the City of Battle Creek County of Calhoun State of Michigan and Eliphalet H. Parish and his wife Ella S. Parish, of the Township of Battle Creek County and State aforesaid, proprietors of the above described piece of land, do hereby lay out the same into lots, streets and alley, of the size, dimensions and with boundaries, corners, and extent, and numbered, and named, as set forth on the adjoining plat on this page of mapping paper, and the certain figures and signs, truly represent and describe the same; N. standing for North, E. for East, S. for South, W. for West, Chs. for chains, lks. for links, ° for degrees, ' for minutes, ft. for feet, in. for inches, St. for street, M. for monument, and the figures near the center of each lot being the number thereof, and the size being written on the lines of each, and that portion marked for street or alley on said plat, is hereby released to said County of Calhoun, as provided by Statute, in trust for the use of the public as a street or alley, and it is mutually agreed that this plat, shall be known as Parish's Addition to Battle Creek.

In witness whereof we have hereunto set our hands and seals this 31st day of October 1887.

In Presence of
E. E. Hough
E. S. Walker
Ella S. Parish
Horace B. Hayes
State of Michigan }
County of Calhoun } ss. On this the 31st day of October 1887 before me, the undersigned, a Notary Public in and for said County, personally came Horace B. Hayes, Eliphalet H. Parish and his wife Ella S. Parish, known to me to be the proprietors named in the above addition to Battle Creek, and each of them acknowledged that they made and executed the same as their free act and deed and for the purpose therein set forth; Also, A. W. Austin the person who made the survey and drafted the adjoining plat, appeared before me and testified that the same is correct to the best of his knowledge and belief, and that the monuments described in said plat, have been planted as therein described.
Eli S. Walker
Notary Public in and for
Calhoun County, Michigan

2594