

AMENDED PLAT OF C. H. MILLS' ADDITION TO BATTLE CREEK.

Received and Filed
IN AUDITOR GENERAL'S OFFICE
November 20, 1889.
A. R. Pratt
Deputy Auditor General.

Dedication
Know all Men by these Presents, That I Mrs. Eunice C. Mills as proprietor
have caused the land embraced in the annexed amended plat to be surveyed, laid
out and platted to be known as the Amended Plat of C. H. Mills' Addition to Battle Creek and
that the streets and alleys as shown on said plat are hereby dedicated to the use of the public.
Signed and sealed in presence of
Steven S. Hulbert
W. R. Hardkins
Mrs. Eunice C. Mills


State of Michigan
County of Calhoun
On this twenty-ninth day of October 1889 before me a
Notary Public in and for said County, personally came the
above named Mrs. Eunice C. Mills known to me to be the per-
son who executed the above dedication, and acknowledged the
same to be her free act and deed.
Steven S. Hulbert Notary Public
Calhoun Co. Mich.

State of Michigan
County of Calhoun
ss. We Albert H. Geddes, Register of Deeds
and A. W. Austin Surveyor hereby certify
that we have each carefully compared this copy with the original
amended plat of C. H. Mills' addition to Battle Creek and that it is
an exact copy thereof and of the whole of such original map or plat.
Albert H. Geddes Register of Deeds
A. W. Austin Surveyor

State of Michigan
County of Calhoun
ss. We Albert H. Geddes Register of Deeds and
A. W. Austin Surveyor hereby certify that we
have each carefully compared the annexed copy with the amended plat
of C. H. Mills' addition to Battle Creek, now of record in the office of
said Register of Deeds and that is a true transcript therefrom and of
the whole of such record.
Albert H. Geddes Register of Deeds
A. W. Austin Surveyor

Register's Office
Calhoun County
ss. Received for record this 16 day of November
1889 at 9 A.M. and placed on file in
Book of Plats No 2. Page 8
Albert H. Geddes, Register


Examined and Approved
November 5th 1889.
A. R. Pratt
Deputy Auditor General

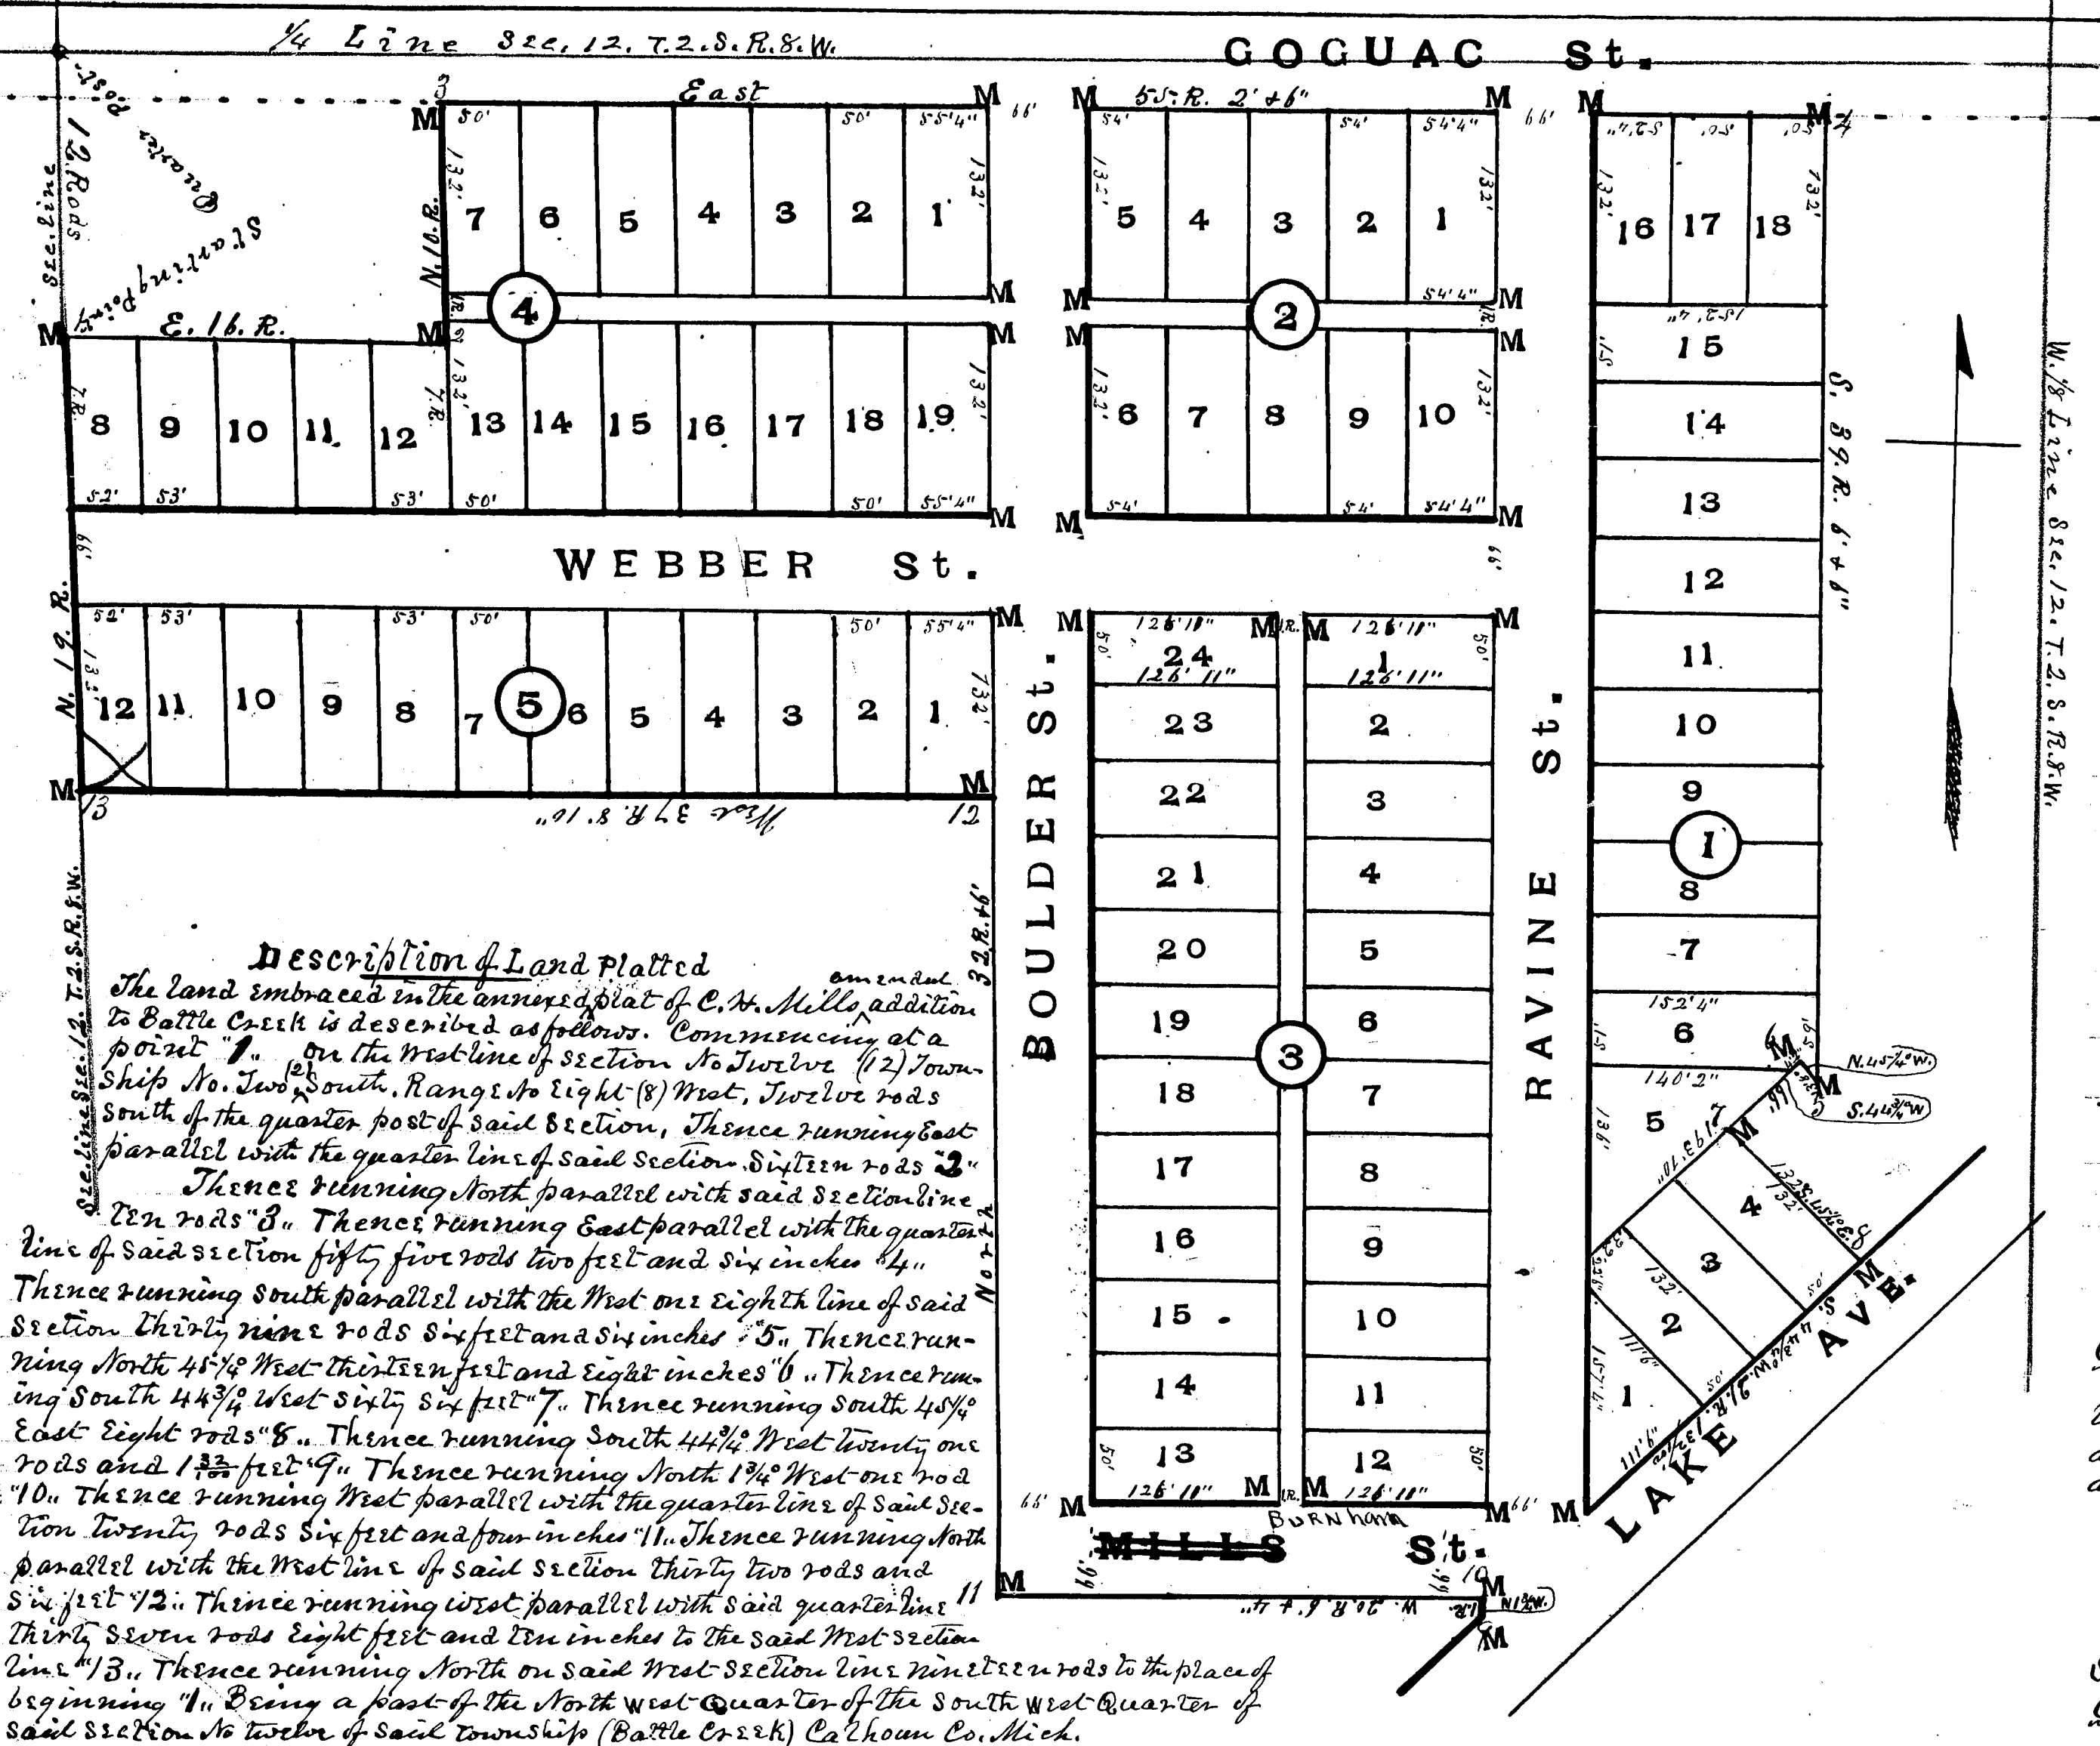

Description of Land Platted
The land embraced in the annexed plat of C. H. Mills' addition
to Battle Creek is described as follows. Commencing at a
point "1" on the west line of section No. Twelve (12) town-
ship No. Two South, Range No. Eight (8) West, Twelve rods
South of the quarter post of said section, Thence running East
parallel with the quarter line of said section sixteen rods "2"
Thence running North parallel with said section line
Ten rods "3". Thence running East parallel with the quarter
line of said section fifty five rods two feet and six inches "4".
Thence running South parallel with the West one eighth line of said
section thirty nine rods six feet and six inches "5". Thence run-
ning North 44 3/4 West thirteen feet and eight inches "6". Thence run-
ning South 44 3/4 West sixty six feet "7". Thence running South 44 3/4
East eight rods "8". Thence running South 44 3/4 West twenty one
rods and 1 1/2 feet "9". Thence running North 1 1/4 West one rod
"10". Thence running West parallel with the quarter line of said sec-
tion twenty rods six feet and four inches "11". Thence running North
parallel with the West line of said section thirty two rods and
six feet "12". Thence running West parallel with said quarter line
thirty seven rods eight feet and ten inches to the said West section
line "13". Thence running North on said West section line nineteen rods to the place of
beginning "1". Being a part of the North West Quarter of the South West Quarter of
said section No. twelve of said township (Battle Creek) Calhoun Co. Mich.


Surveyors Certificate
I hereby certify that the plat hereon delineated is a correct one and that permanent
monuments consisting of Cedar stakes sawed three inches square and eighteen inches
long (about) have been planted full depth in the ground and each witnessed by three
stones ranging from six to seven inches also planted placed down in the ground
and even with the surface closely around each stake at points marked by the letter "M". These
are shown at all angles shown in the boundaries of the land platted and at all intersections
of streets or streets and alleys
A. W. Austin, Surveyor

This amended plat is for the correction of an error in the dedication
of the original plat known as C. H. Mills' addition to Battle Creek
A. W. Austin, Surveyor

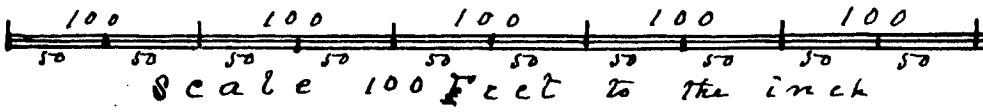

13358

2908

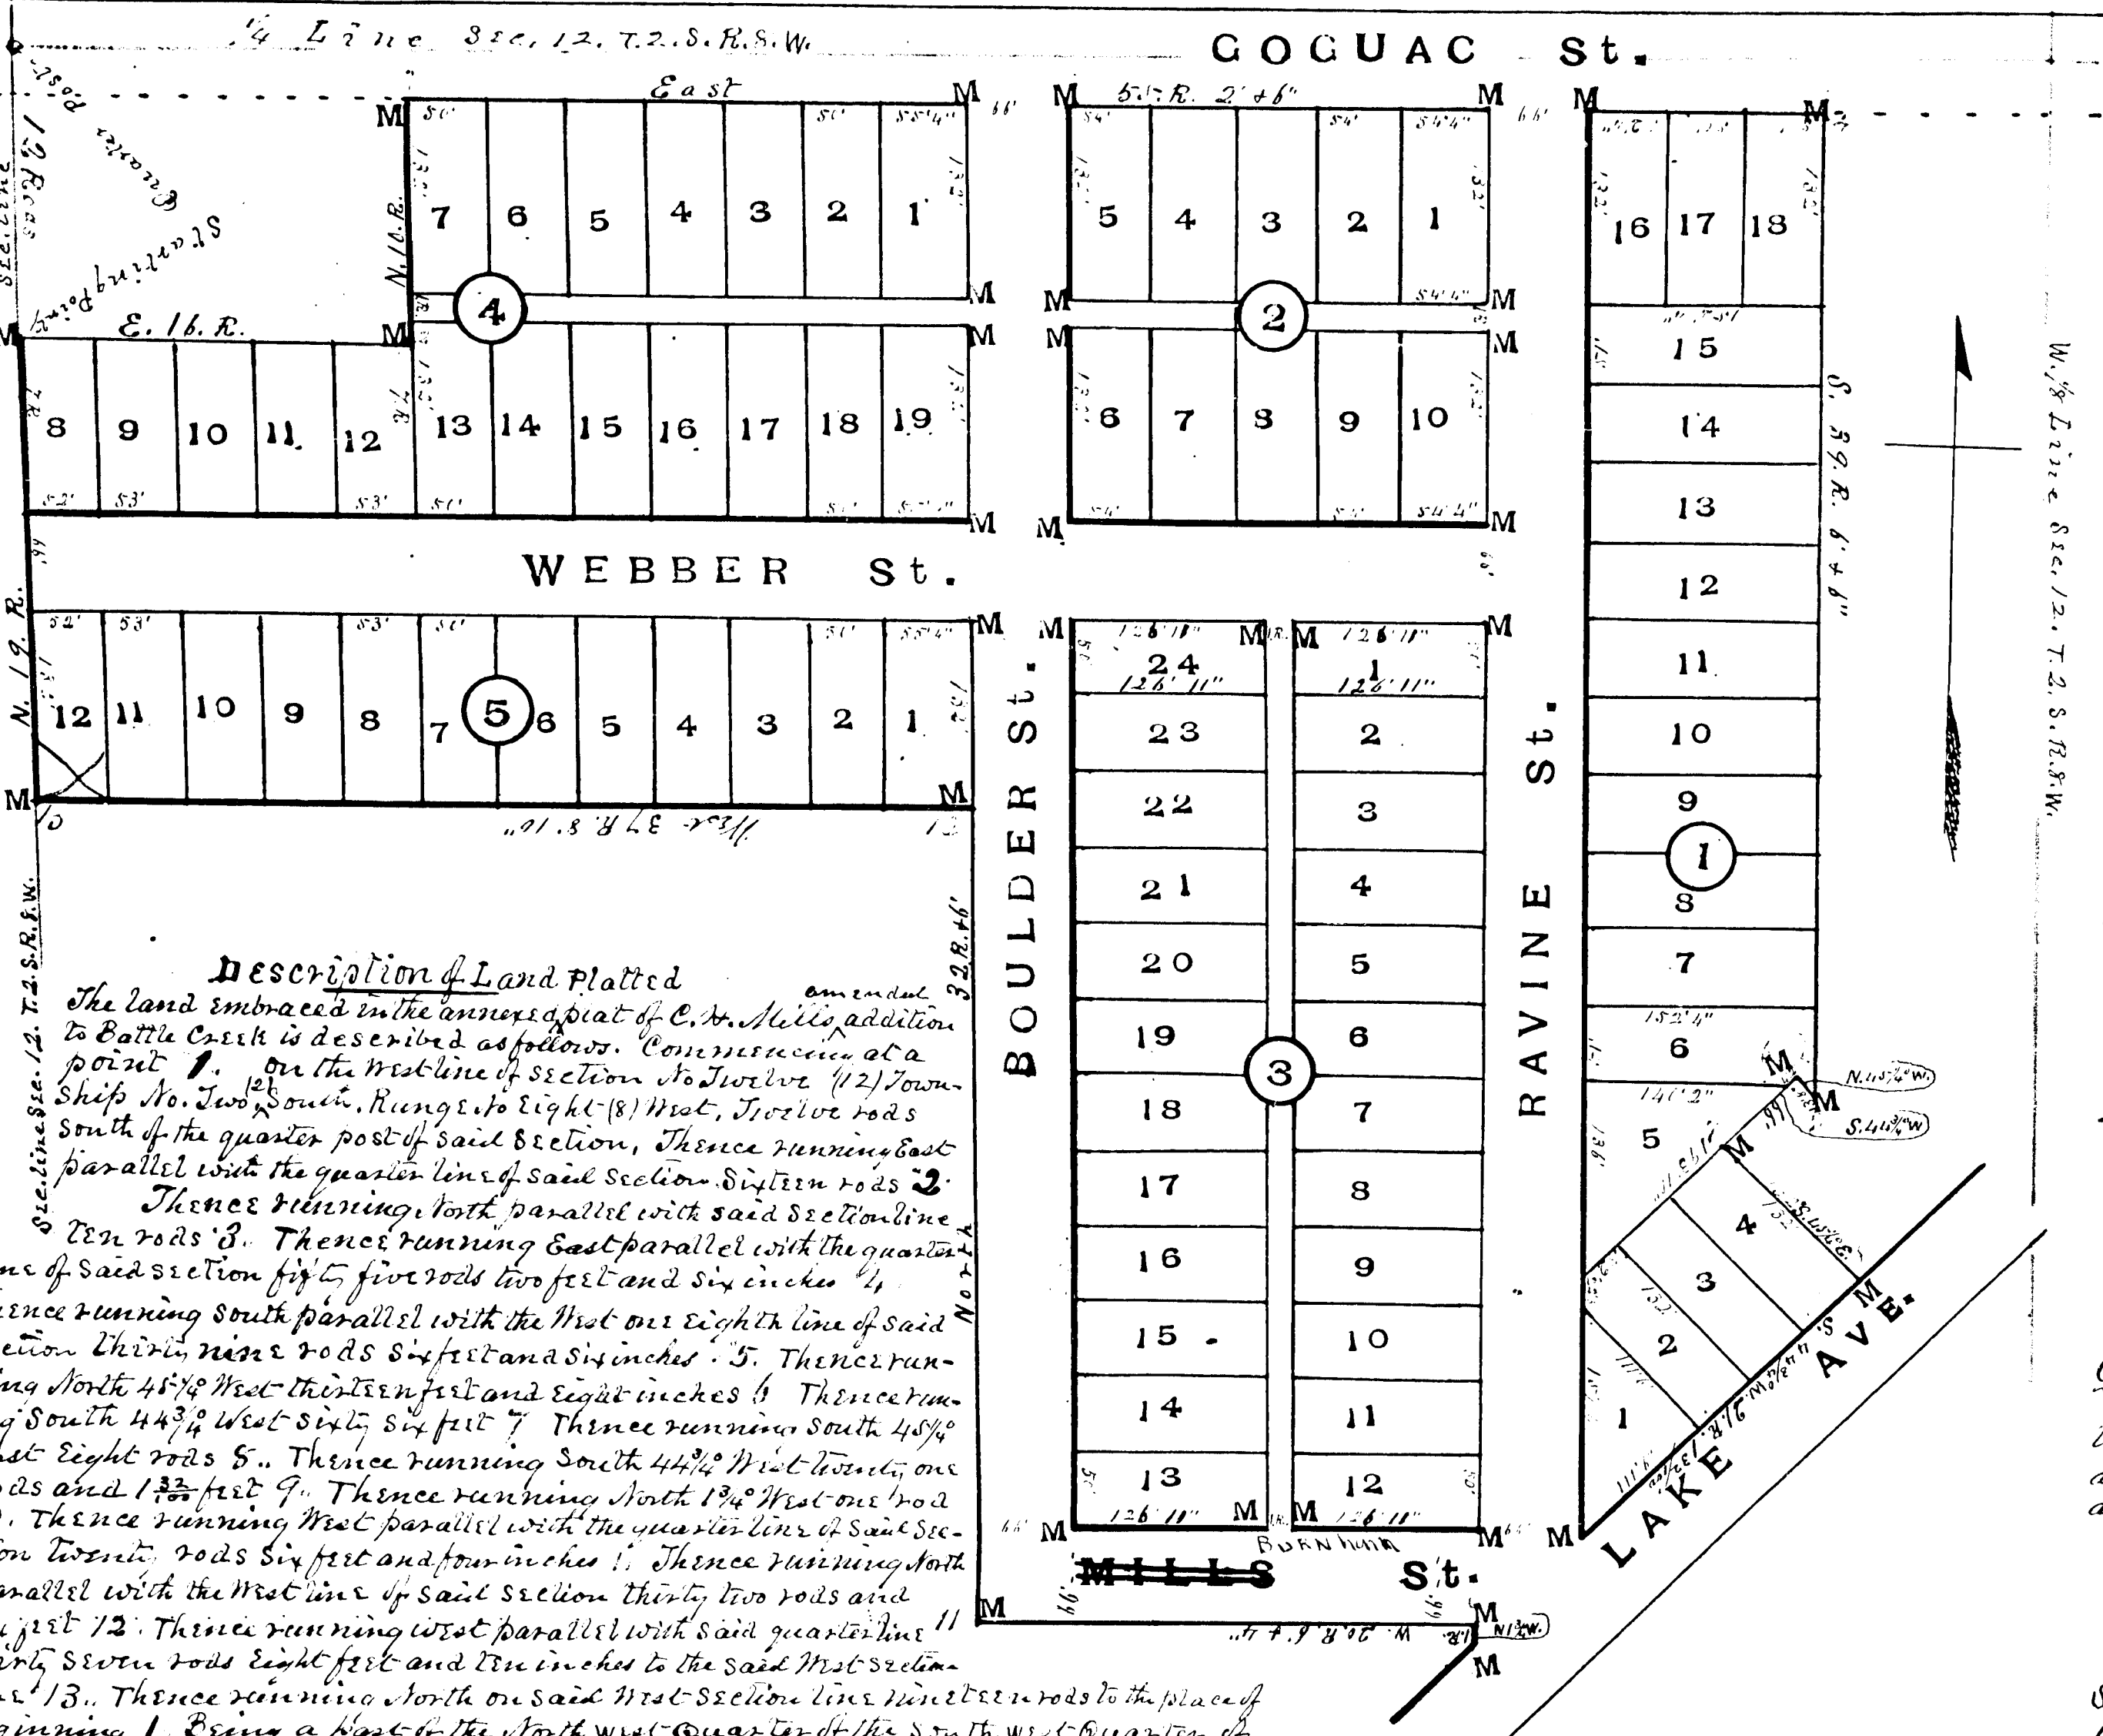

AMENDED PLAT OF C. H. MILLS' ADDITION TO BATTLE CREEK.

Received and Filed
IN AUDITOR GENERAL'S OFFICE
November 10, 1889.
H. J. W. T.
Deputy Auditor General.

Dedication
Know all Men by these Presents, That Mrs. Eunice E. Mills as proprietor
have caused the land embraced in the annexed amended plat to be surveyed, laid
out and platted to be known as the Amended Plat of C. H. Mills' Addition to Battle Creek and
that the streets and alleys as shown on said plat are hereby dedicated to the use of the public.
Signed and sealed in presence of
Steven S. Hulbert
H. R. Hawkins
Mrs. Eunice E. Mills

State of Michigan }
County of Calhoun } ss. On this twenty-ninth day of October 1889 before me a
Notary Public in and for said County, personally came the
above named Mrs. Eunice E. Mills known to me to be the per-
son who executed the above dedication, and acknowledged the
same to be her free act and deed
Steven S. Hulbert } Notary Public
Calhoun Co. Mich.

State of Michigan }
County of Calhoun } ss. We Albert H. Geddes, Register of Deeds
and A. H. Austin Surveyor hereby certify
that we have each carefully compared this copy with the original
amended plat of C. H. Mills' addition to Battle Creek and that it is
an exact copy thereof and of the whole of such original map or plat.
Albert H. Geddes } Register of Deeds
A. H. Austin } Surveyor

State of Michigan }
County of Calhoun } ss. We Albert H. Geddes Register of Deeds and
A. H. Austin Surveyor hereby certify that we
have each carefully compared the annexed copy with the amended plat
of C. H. Mills' addition to Battle Creek, now of record in the office of
said Register of Deeds and that it is a true transcript therefrom and of
the whole of such record.
Albert H. Geddes } Register of Deeds
A. H. Austin } Surveyor

Registers Office }
Calhoun County } ss. Received for record this 16 day of November
1889 at 9 A.M. and placed on file in
Book of Plats No. 2. Page 8
Albert H. Geddes, Register

Examined and Approved
November 5th 1889.
A. R. Pratt
Deputy Auditor General

Surveyors Certificate
I hereby certify that the platter on delineated is a correct one and that permanent
monuments consisting of cedar stakes saved three inches square and eighteen inches
long (about) have been planted full depth in the ground and each witnessed by three
stones ranging from six to eight inches thick also planted placed down in the ground
and reset with the surface close around each stake at points marked by the letter M, the
same shown at all angles shown in the boundaries of the land platted and at all intersections
of streets or streets and alleys
A. H. Austin, Surveyor

This amended plat is for the correction of an error in the dedication
of the original plat known as C. H. Mills' addition to Battle Creek
A. H. Austin, Surveyor