

13367

know all Men by these Presents, That I, SARAH A. DAVIDSON, as proprietor,
have caused the land embraced in the annexed plat to be surveyed, laid out and platted,
to be known as "Davidson's Addition to Battle Creek;" and that the streets as shown
on said plat are hereby dedicated to the use of the public.

Signed and sealed in presence of,

J. C. Addams Clara Davidson [J.S.]
William C. Howe

St. C. Adair
William C. Adair
Clara Davidson [s.]

STATE OF MICHIGAN,
COUNTY OF CALHOUN.
ss
On this 24th day of August, 1880, before me, a Notary Public, in and for said county, personally came the above named Sara A. Davidson, known to me to be the person who executed the above dedication, and acknowledged the same to be her free act and deed.

William C. Hoar
Notary Public, Calhoun Co., Mich.

The land embraced in the annexed plat of Davidson's Addition to Battle Creek, is situate on the N. W. fractional $\frac{1}{4}$ of the N. E. fractional $\frac{1}{4}$ of Sec. 6, 7p. 2 S., R. 7 W., Calhoun county, and described as follows: Beginning at the S. W. Cor. of the N. N. W. fractional $\frac{1}{4}$ of the N. E. fractional $\frac{1}{4}$ of said Sec. 6, and running North on the $\frac{1}{2}$ line of said Sec. 6, 7.50 chains; thence East parallel with the $\frac{1}{2}$ line 13.41 chains; thence South parallel with the $\frac{1}{2}$ line 7.50 chains; to the $\frac{1}{2}$ line; thence West on the $\frac{1}{2}$ line 13.41 chains to place of beginning.

1 MEANSBY CERTIFY That the plat hereon delineated is a correct one, and that permanent monuments, each consisting of a Cedar stake four to five inches through and twenty inches long, planted full depth in the ground, surrounded with three stones, each six to eight inches across, bedded even with the surface of the ground, at points marked thus, "X", as thereon shown at all angles in the boundaries of the land platted, and at all intersections of streets,

ST. PETERSBURG

At 1 Hickory 19 in.	S. 38° W.,	dist. 1.431 chains
2 W. O.	T. 6° N. 14° E.,	22 "
3 Hick.	T. 6° S. 15° W.,	1.331 "
4 "	S. 73° "	22½ "

Examined and approved August 8 1890. A. R. Pratt

Received for record this 17th day of August A. D. 1890, at
9 o'clock A. M., and recorded in Liber 2 of Plats on page 17

Albert H. Gledits

REGISTER OF DEEDS

STATE OF MICHIGAN.) ss. **WE, Albert H. Credde,** Register of Deeds, and **A. W. COURTNEY OF CALHOUN,** }
Austin, Surveyor, hereby certify that we have each carefully compared this copy with the original plat of Davidson's Addition to Battle Creek, and that it is an exact copy thereof, and of the whole of such original map or plat.

Albert H. Stedler

REGISTER OF DEEDS.


Wm. Rudin

SURVEILLANCE.

State of Michigan }
County of Calhoun } SS. We Albert C. Stebbins, Register
of Deeds and Affidavits Surveyor, hereby certify that
we have each carefully compared the aforesaid copy
with the plat of said John's Addition to Battle Creek,
now of record in the Office of said Register of Deeds
and that it is a true transcript therefrom and of the
whole of such record

Register of Birds
seen on

Received and filed
IN AUDITOR GENERAL'S OFFICE.
August-1/91 10.30
Edward R. H. Price
Deputy Auditor General.
Chicago, Ill.

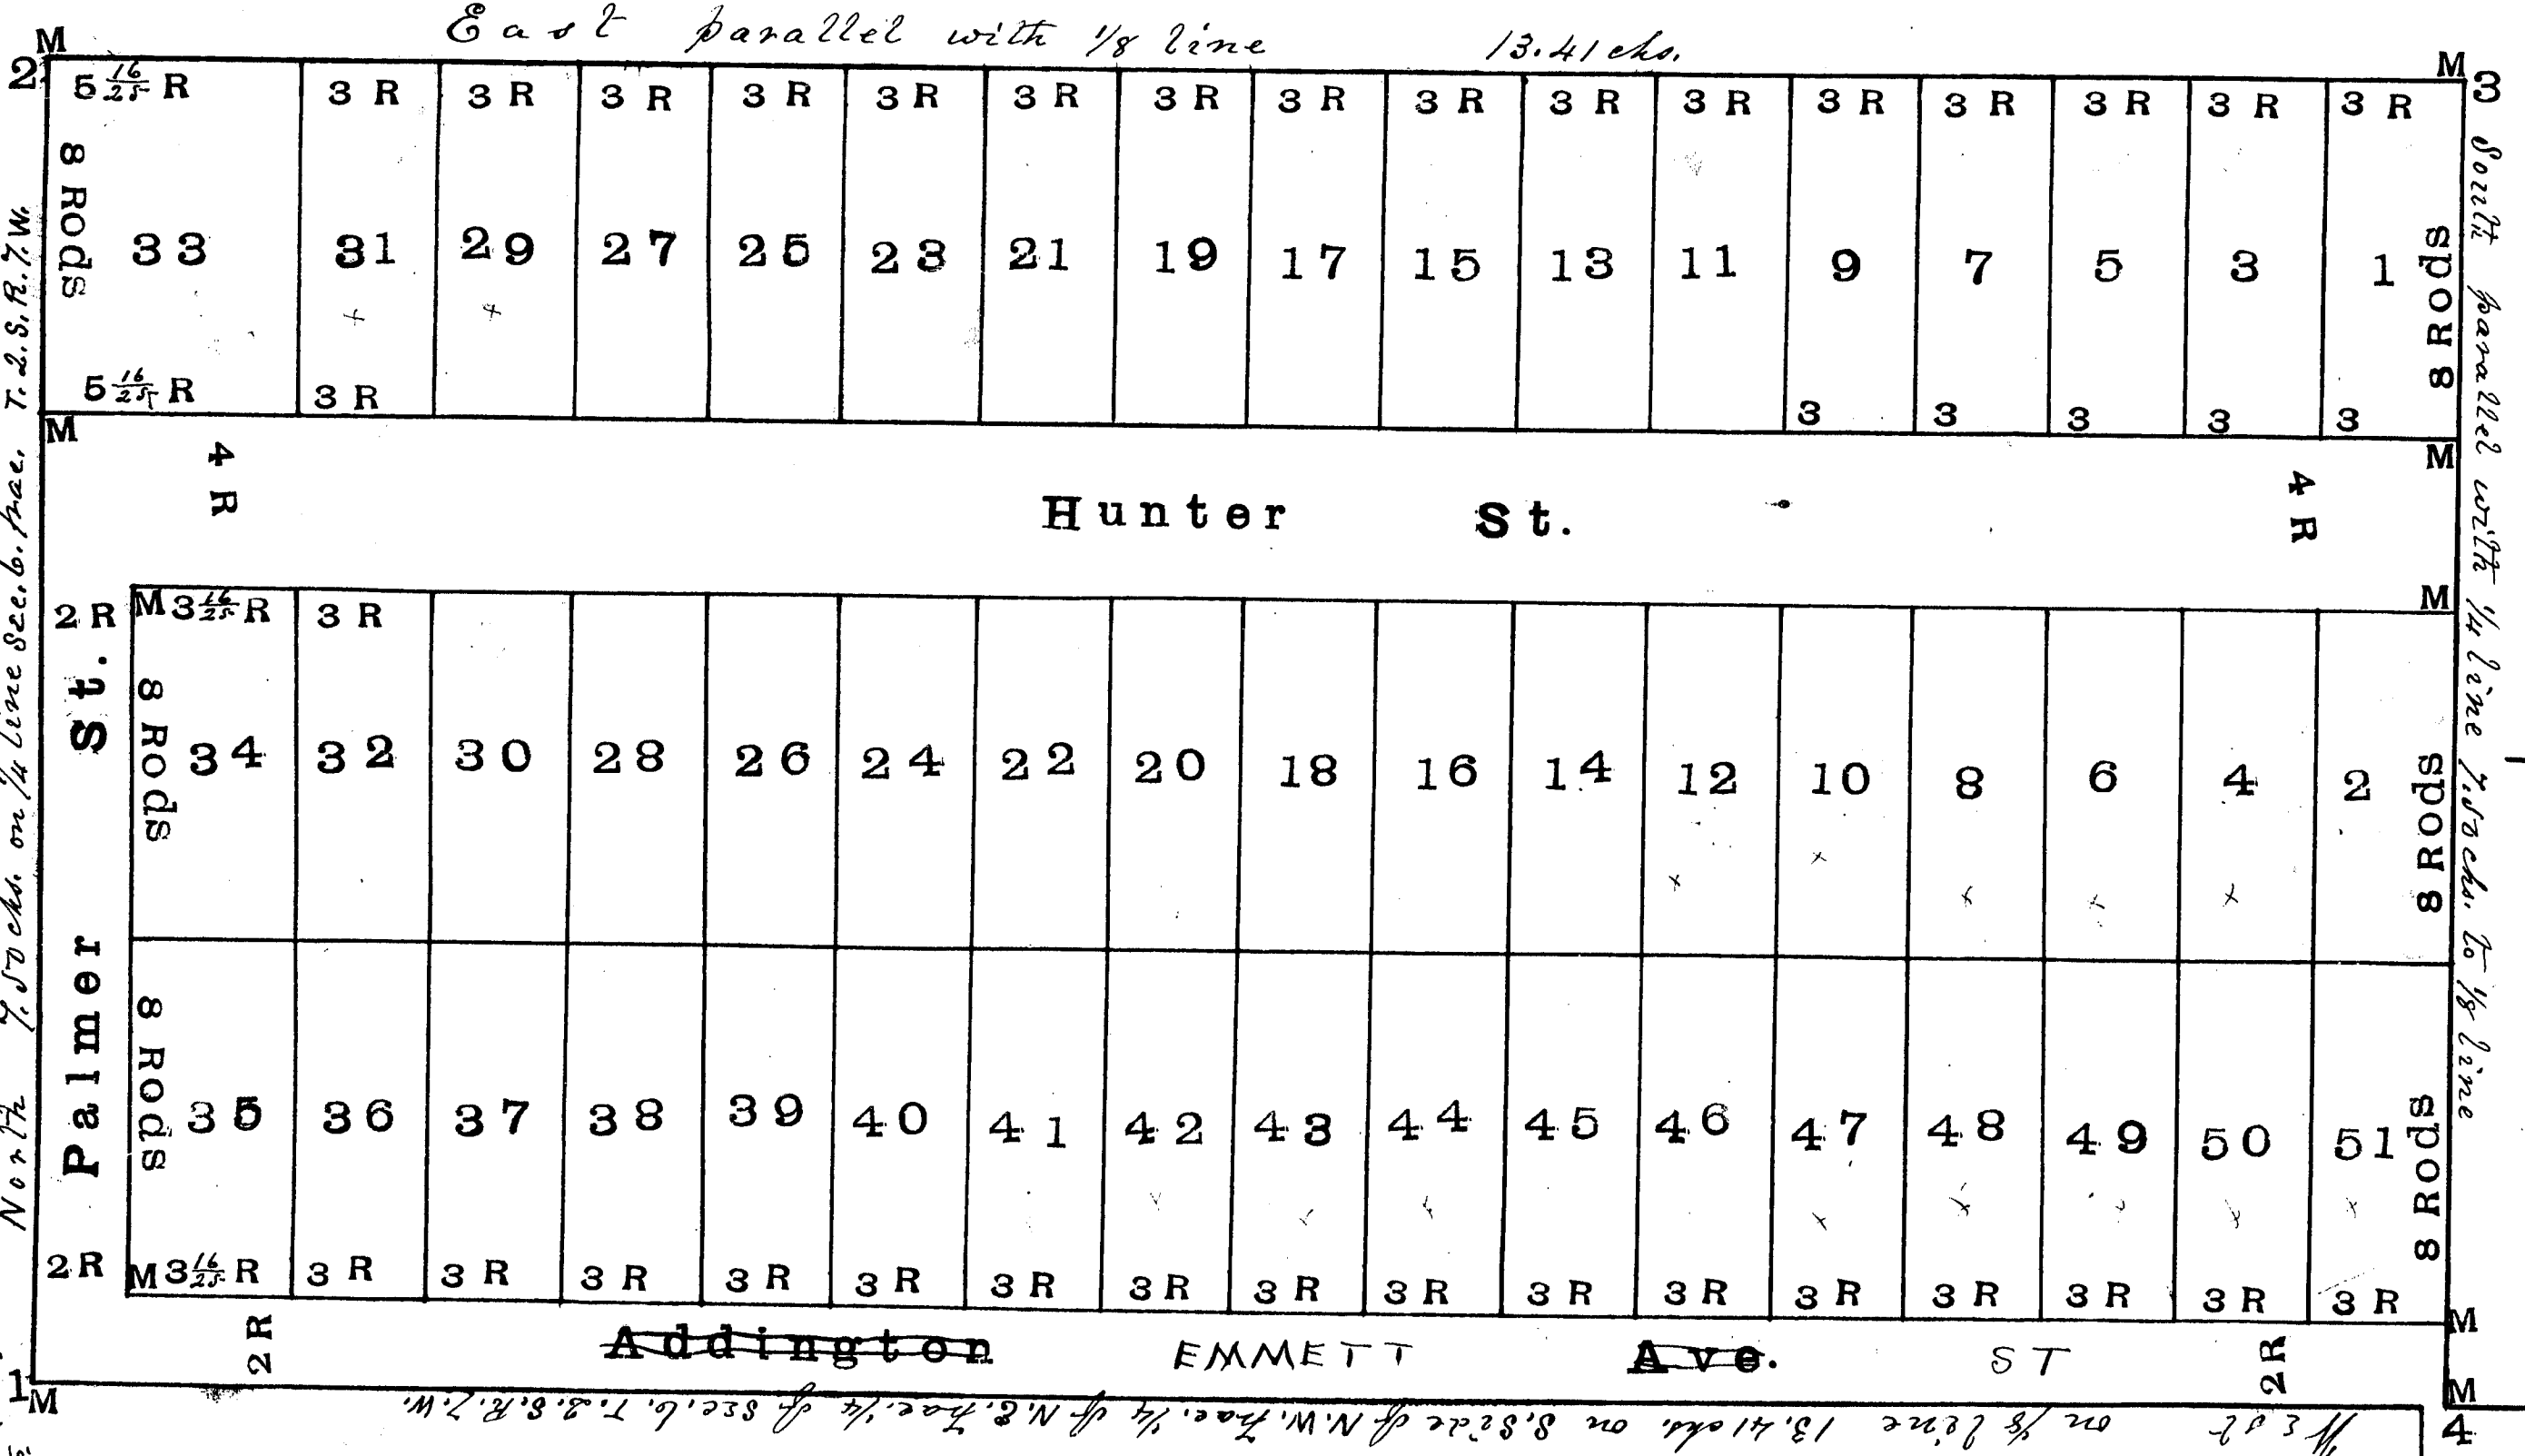

Friseurs
3^{te} Ad.

Beginning at the S.W.
corner of the N.W. $\frac{3}{4}$ of
the N.E. $\frac{3}{4}$ of Sec. 6,
T. 2. S. R. 7. W.

DAVIDSON'S ADDITION TO BATTLE CREEK.

DEDICATION

Know all Men by these Presents, That I, SARA A. DAVIDSON, as proprietor, have caused the land embraced in the annexed plat to be surveyed, laid out and platted, to be known as "Davidson's Addition to Battle Creek," and that the streets as shown on said plat are hereby dedicated to the use of the public.

Signed and sealed in presence of:
S. E. Addington, Charles Davidson, J. S. Addington, C. H. Hoag.

STATE OF MICHIGAN,
COUNTY OF CALHOUN.
On this 17th day of August, 1890, before me, a Notary Public, in and for said county, personally came the above named Sara A. Davidson, known to me to be the person who executed the above dedication, and acknowledged the same to be her free act and deed.
William C. Hoag, Notary Public, Calhoun Co., Mich.

DESCRIPTION OF LAND PLATTED.

THE land embraced in the annexed plat of Davidson's Addition to Battle Creek, is situate on the N. W. fractional 1 of the N. E. fractional 1 of Sec. 6, T. 2 S., R. 7 W., Calhoun county, and described as follows: Beginning at the S. W. Cor. of the N. W. fractional 1 of the N. E. fractional 1 of said Sec. 6, and running North on the 1 line of said Sec. 6, 7.50 chains; thence East parallel with the 1 line 13.41 chains; thence South parallel with the 1 line 7.50 chains, to the 1 line; thence West on the 1 line 13.41 chains to place of beginning.

SURVEYORS CERTIFICATE.

I HEREBY CERTIFY That the plat hereon delineated is a correct one, and that permanent monuments, each consisting of a Cedar stake four to five inches through and twenty inches long, planted full depth in the ground, surrounded with three stones, each six to eight inches across, bedded even with the surface of the ground, at points marked thus, "M", as thereon shown at all angles in the boundaries of the land platted, and at all intersections of streets.

Wm. Addington, Surveyor

WITNESS TREES TO CORNERS:

At 1 Hickory 19 in. N. 88° W., dist. 1.13 chains
2 W. O. 7" N. 11° E., " 22 "
3 Hick. 7" S. 15° W., " 1.33 "
4 " 22" S. 73" " 2.14 "

Examined and approved, August 8, 1890, W. C. Hoag, Deputy Notary General.

Received for record this 17th day of August, A. D. 1890, at 9 o'clock, A. M., and recorded in Liber 22 of Plats on page 17.


Albert H. Addington, Register of Deeds

STATE OF MICHIGAN,
COUNTY OF CALHOUN.
WE, Albert H. Addington, Register of Deeds, and A. W. Austin, Surveyor, hereby certify that we have each carefully compared this copy with the original plat of Davidson's Addition to Battle Creek, and that it is an exact copy thereof, and of the whole of such original map or plat.

Albert H. Addington, Register of Deeds
A. W. Austin, Surveyor

State of Michigan,
County of Calhoun, ss. We, Albert H. Addington, Register of Deeds, and A. W. Austin, Surveyor, hereby certify that we have each carefully compared this copy with the original plat of Davidson's Addition to Battle Creek, and that it is an exact copy thereof, and of the whole of such original map or plat.

Albert H. Addington, Register of Deeds
A. W. Austin, Surveyor

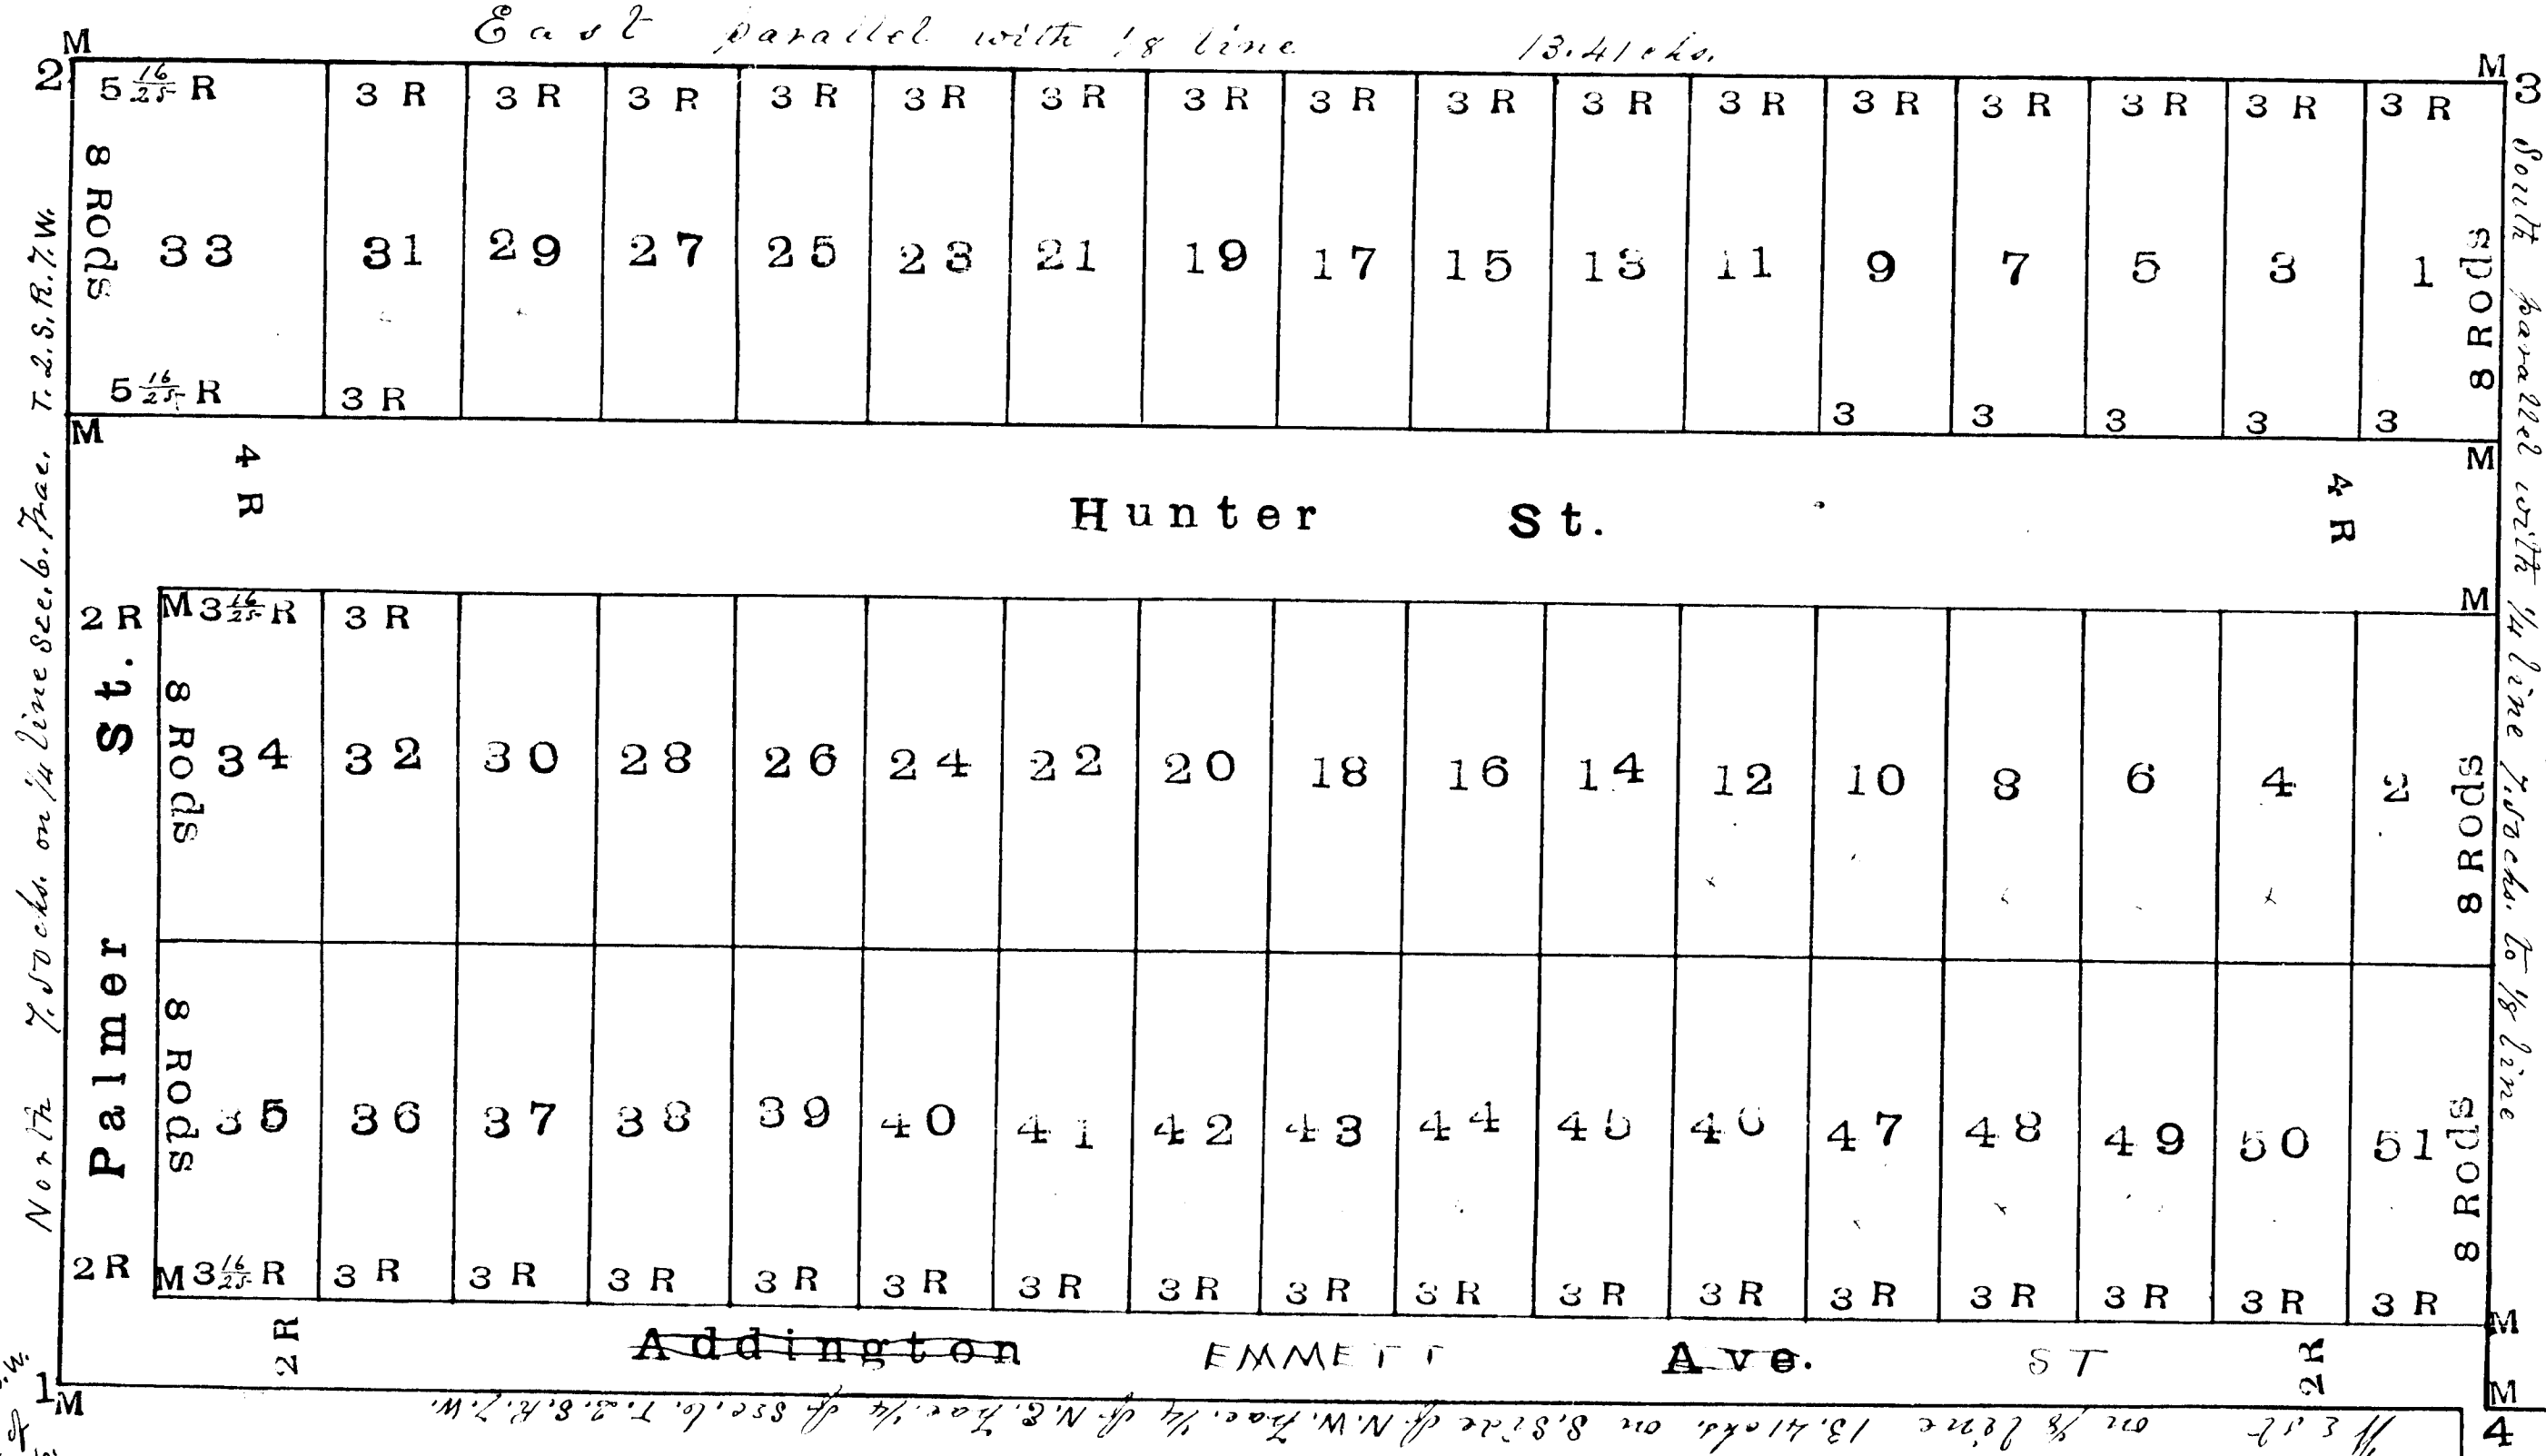

RECEIVED
NOTARY PUBLIC
WILLIAM C. HOAG
AUGUST 17, 1890

Frisbers
32nd Ad.

Beginning at the S.W. cor. of the N.W. 1/4 of Sec. 6, T. 2 S., R. 7 W.