

Welch's
3rd Add.

N.E. Cor. of
Welch's 3rd Add.

Received and filed
in Auditor's Office
December 3, 1890
H. R. Pratt
County Auditor General

WELCH'S FOURTH ADDITION TO BATTLE CREEK.

DEDICATION.

Know all Men by these Presents, That we, Mrs. Frances A. Jordan, Alonzo W. Fogg, Bertha L. Fogg, his wife, Marion Mead, and Electa R. Mead, his wife, as proprietors, have caused the land embraced in the annexed plat to be surveyed, laid out and platted, to be known as "Welch's Fourth Addition to Battle Creek," and that the streets as shown on said plat are hereby dedicated to the use of the public.

Signed and sealed in presence of
Frances A. Jordan [L.S.]
Alonzo W. Fogg [L.S.]
Bertha L. Fogg [L.S.]
Marion Mead [L.S.]
Electa R. Mead [L.S.]

STATE OF MICHIGAN, } ss
COUNTY OF CALHOUN, } ss
On this twenty-first day of October, 1890, before me, a Notary Public, in and for said county, personally came the above named Mrs. Frances A. Jordan, Alonzo W. Fogg, Bertha L. Fogg, his wife, Marion Mead, and Electa R. Mead, his wife, known to me to be the persons who executed the above dedication, and acknowledged the same to be their free act and deed.

Benjamin H. Welch
Notary Public, Calhoun County, Michigan.

DESCRIPTION OF LAND PLATTED.

The land embraced in the annexed plat of Welch's 4th Addition to Battle Creek is located on the N. E. 1/4 of Sec. 2, Tp. 2 S. R. 8 W., Calhoun county, and bounded as follows:

Beginning on the north side of West Main street (in the city of Battle Creek) and at the south-west corner of the plat of Jordan's Addition, and at the monument as therein mentioned and witnessed, and running thence north 19° east along the west side of said addition 4.77 1/2 chains; thence N. 34° east along the west side of same addition 4.78 chains; thence N. 56 1/2° west along the south side of Welch's Third Addition 5.68 chains; thence S. 32 1/2° west along the east side of Welch's Fifth Addition 8.87 1/2 chains to the north side of said West Main street; thence S. 56 1/2° east on north side of said street 9.20 1/2 chains to place of beginning.

SURVEYOR'S CERTIFICATE.

I HEREBY CERTIFY, That the plat hereon delineated is a correct one, and that permanent monuments, each consisting of a Cedar stake four to five inches through and twenty inches long, planted full depth in the ground, surrounded with three stones, each six to eight inches across, bedded even with the surface of the ground, at points marked thus, "M", as thereon shown at all angles in the boundaries of the land platted, and at all intersections of streets and alley.


A. W. Austin
SURVEYOR.

Examined and approved October 28 1890. H. R. Pratt
Deputy Auditor General.

STATE OF MICHIGAN, } ss
COUNTY OF CALHOUN, } ss
We, Albert H. Geddes, Register of Deeds, and A. W. Austin, Surveyor, hereby certify that we have each carefully compared this copy with the original plat of Welch's Fourth Addition to Battle Creek, and that it is an exact copy of the whole of such original map or plat.

Albert H. Geddes
Register of Deeds.

Received for record this 31st day of October A.D. 1890, at 1 o'clock P.M., and recorded in Liber 2 of Plats on page 21
Albert H. Geddes
Register of Deeds.

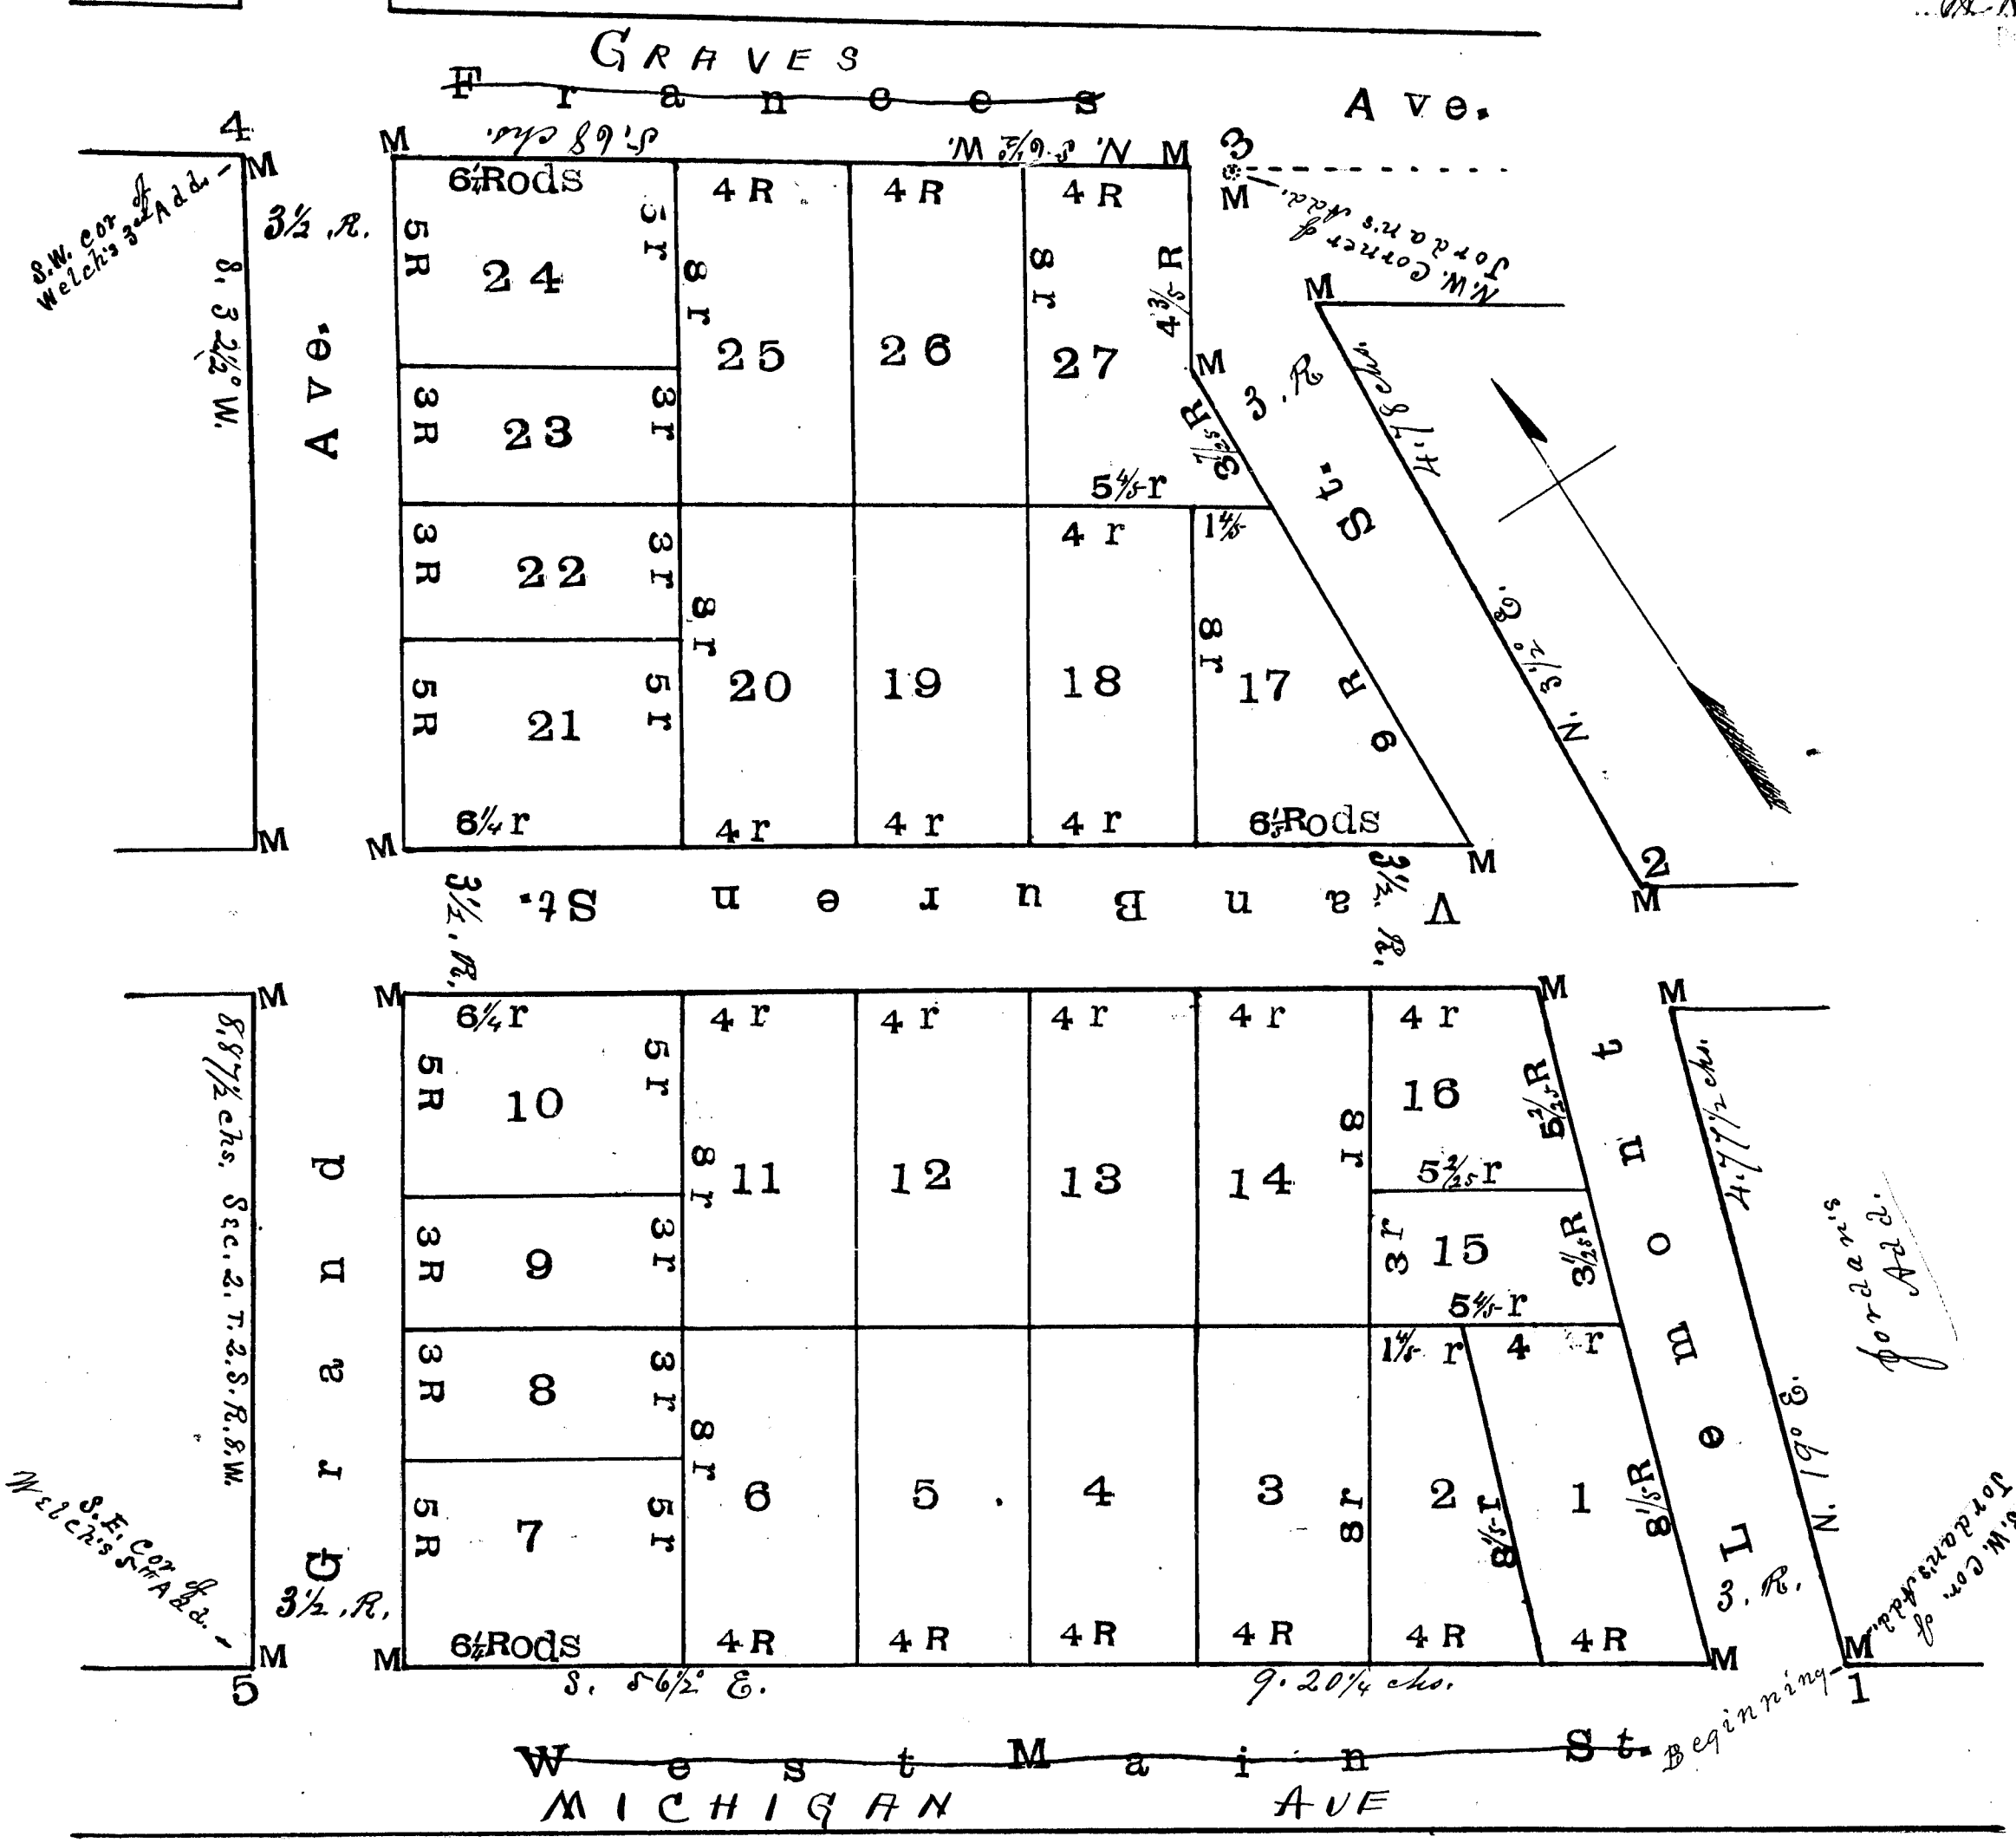

1.00 1.00 1.00
Scale of one chain to the inch

Witness trees to Monuments
At 1. Hick. 10. in N. 54° W. dis. 47 1/2 ch.
" 2. " 20. " N. 89° E. " 58 ch.

Lots no. 17 to 27 inclusive
Belong to Mead & Wife

State of Michigan, We Albert H. Geddes, Register of Deeds, and A. W. Austin, Surveyor, hereby certify that we have each carefully compared the annexed copy with the plat of Welch's Fourth Addition to Battle Creek, now of record in the office of said Register of Deeds, and that it is a true transcript therefrom and of the whole of such record.
Albert H. Geddes Register of Deeds
A. W. Austin Surveyor

