

3925

Trisbie's South Side Addition
Calhoun County, Michigan
See 3263 Vol. 52.

3925
13375

PLAT OF FRISBIE'S SOUTH SIDE ADDITION TO THE CITY OF BATTLE CREEK, CALHOUN COUNTY, MICHIGAN.

CONSISTING of a strip of land 50 links wide off from the South side of the Southwest quarter of Section 12, also a strip of land 50 links wide off from the North end of the West half of the Northwest quarter of Section 13, and a piece of land 12.50 chains wide off from the East side of the remaining part of the Southeast quarter of the Southwest quarter of Section 12, all in Township 2, South Range 8 West.
NOVEMBER 5, 1890.
HARRY HODGMAN, SURVEYOR.

I DO HEREBY CERTIFY, that this is a correct plat of Frisbie's South Side Addition to the City of Battle Creek, as surveyed by me and that permanent monuments have been planted at all the angles in the boundary line of the land platted and at the intersections of all streets, or of streets and alleys, at the points marked with black circles on the plat. These monuments consist of cedar stakes, driven eighteen inches in the ground with three stones planted around each stake, except at the Section Corner and Quarter Post, where solid earthen posts 3 inches in diameter are planted.

Witness to Northeast corner of Plat, Black Oak 10 inches in diameter, N. 24 1/2 degrees W. 44 links.
Witness to South Quarter Post of Section 12, White Oak 22 inches in diameter, N. 61 1/2 degrees E. 66 1/2 links. Apple tree S. 75 degrees E. 74 links.
Witness to Corner of Sections 11, 12, 13 and 14, Burr Oak 14 inches diameter, S. 69 1/2 degrees W. 69 links. Hickory 12 inches diameter, S. 23 1/2 degrees E. 139 links.

We, OREN B. FRISBIE and ESTELLA FRISBIE his wife, and GEORGE R. BURNHAM and MARIETTA A. BURNHAM his wife, owners of the land described in this plat of Frisbie's South Side Addition to the City of Battle Creek, do hereby execute said Plat, and dedicate to the public the land marked thereon as Streets and Avenues for use as public highways, and for no other purpose.

IN TESTIMONY WHEREOF, we have hereunto affixed our signatures this 14th day of November, A. D. 1890.

Executed in Presence of
Oren B. Frisbie, L. S.
Estella Frisbie, L. S.
George R. Burnham, L. S.
Marietta A. Burnham, L. S.

STATE OF MICHIGAN, }
COUNTY OF CALHOUN, } s. s.
On this 14th day of November, A. D. 1890, before me a Notary Public, in and for said County, personally appeared OREN B. FRISBIE and ESTELLA FRISBIE his wife, and GEORGE R. BURNHAM and MARIETTA A. BURNHAM his wife, to me known to be the persons who executed this plat, and who severally acknowledged the same to be their free act and deed.

Examined and approved William H. Mackie 1890
Received for record the 16 day of December A. D. 1890, at 9 o'clock A.M. and recorded in Liber 2 of Plats, on Page 25

STATE OF MICHIGAN, }
COUNTY OF CALHOUN, } s. s.
We William H. Mackie Register of Deeds and HARRY HODGMAN, Surveyor, hereby certify that we have each carefully compared this copy with the plat of Frisbie's South Side Addition to the City of Battle Creek and that it is an exact copy thereof, and of the whole of such original plat.


STATE OF MICHIGAN, }
COUNTY OF CALHOUN, } s. s.
We William H. Mackie Register of Deeds and HARRY HODGMAN, Surveyor, hereby certify that we have each carefully compared this copy with the plat of Frisbie's South Side Addition to the City of Battle Creek and that it is an exact copy thereof, and of the whole of such original plat.

STATE OF MICHIGAN, }
COUNTY OF CALHOUN, } s. s.
We William H. Mackie Register of Deeds and HARRY HODGMAN, Surveyor, hereby certify that we have each carefully compared this copy with the plat of Frisbie's South Side Addition to the City of Battle Creek and that it is an exact copy thereof, and of the whole of such original plat.

Register of Deeds and HARRY HODGMAN, Surveyor, do hereby certify that we have each carefully compared this copy with the plat of Frisbie's South Side Addition to the City of Battle Creek, now on record in the office of said Register of Deeds, and that it is a true transcript therefrom, and of the whole of such record.

William H. Mackie REGISTER OF DEEDS.
Harry Hodgman SURVEYOR.

RECEIVED AND FILED
GENERAL'S OFFICE
Nov 29 1890
Deputy Auditor General

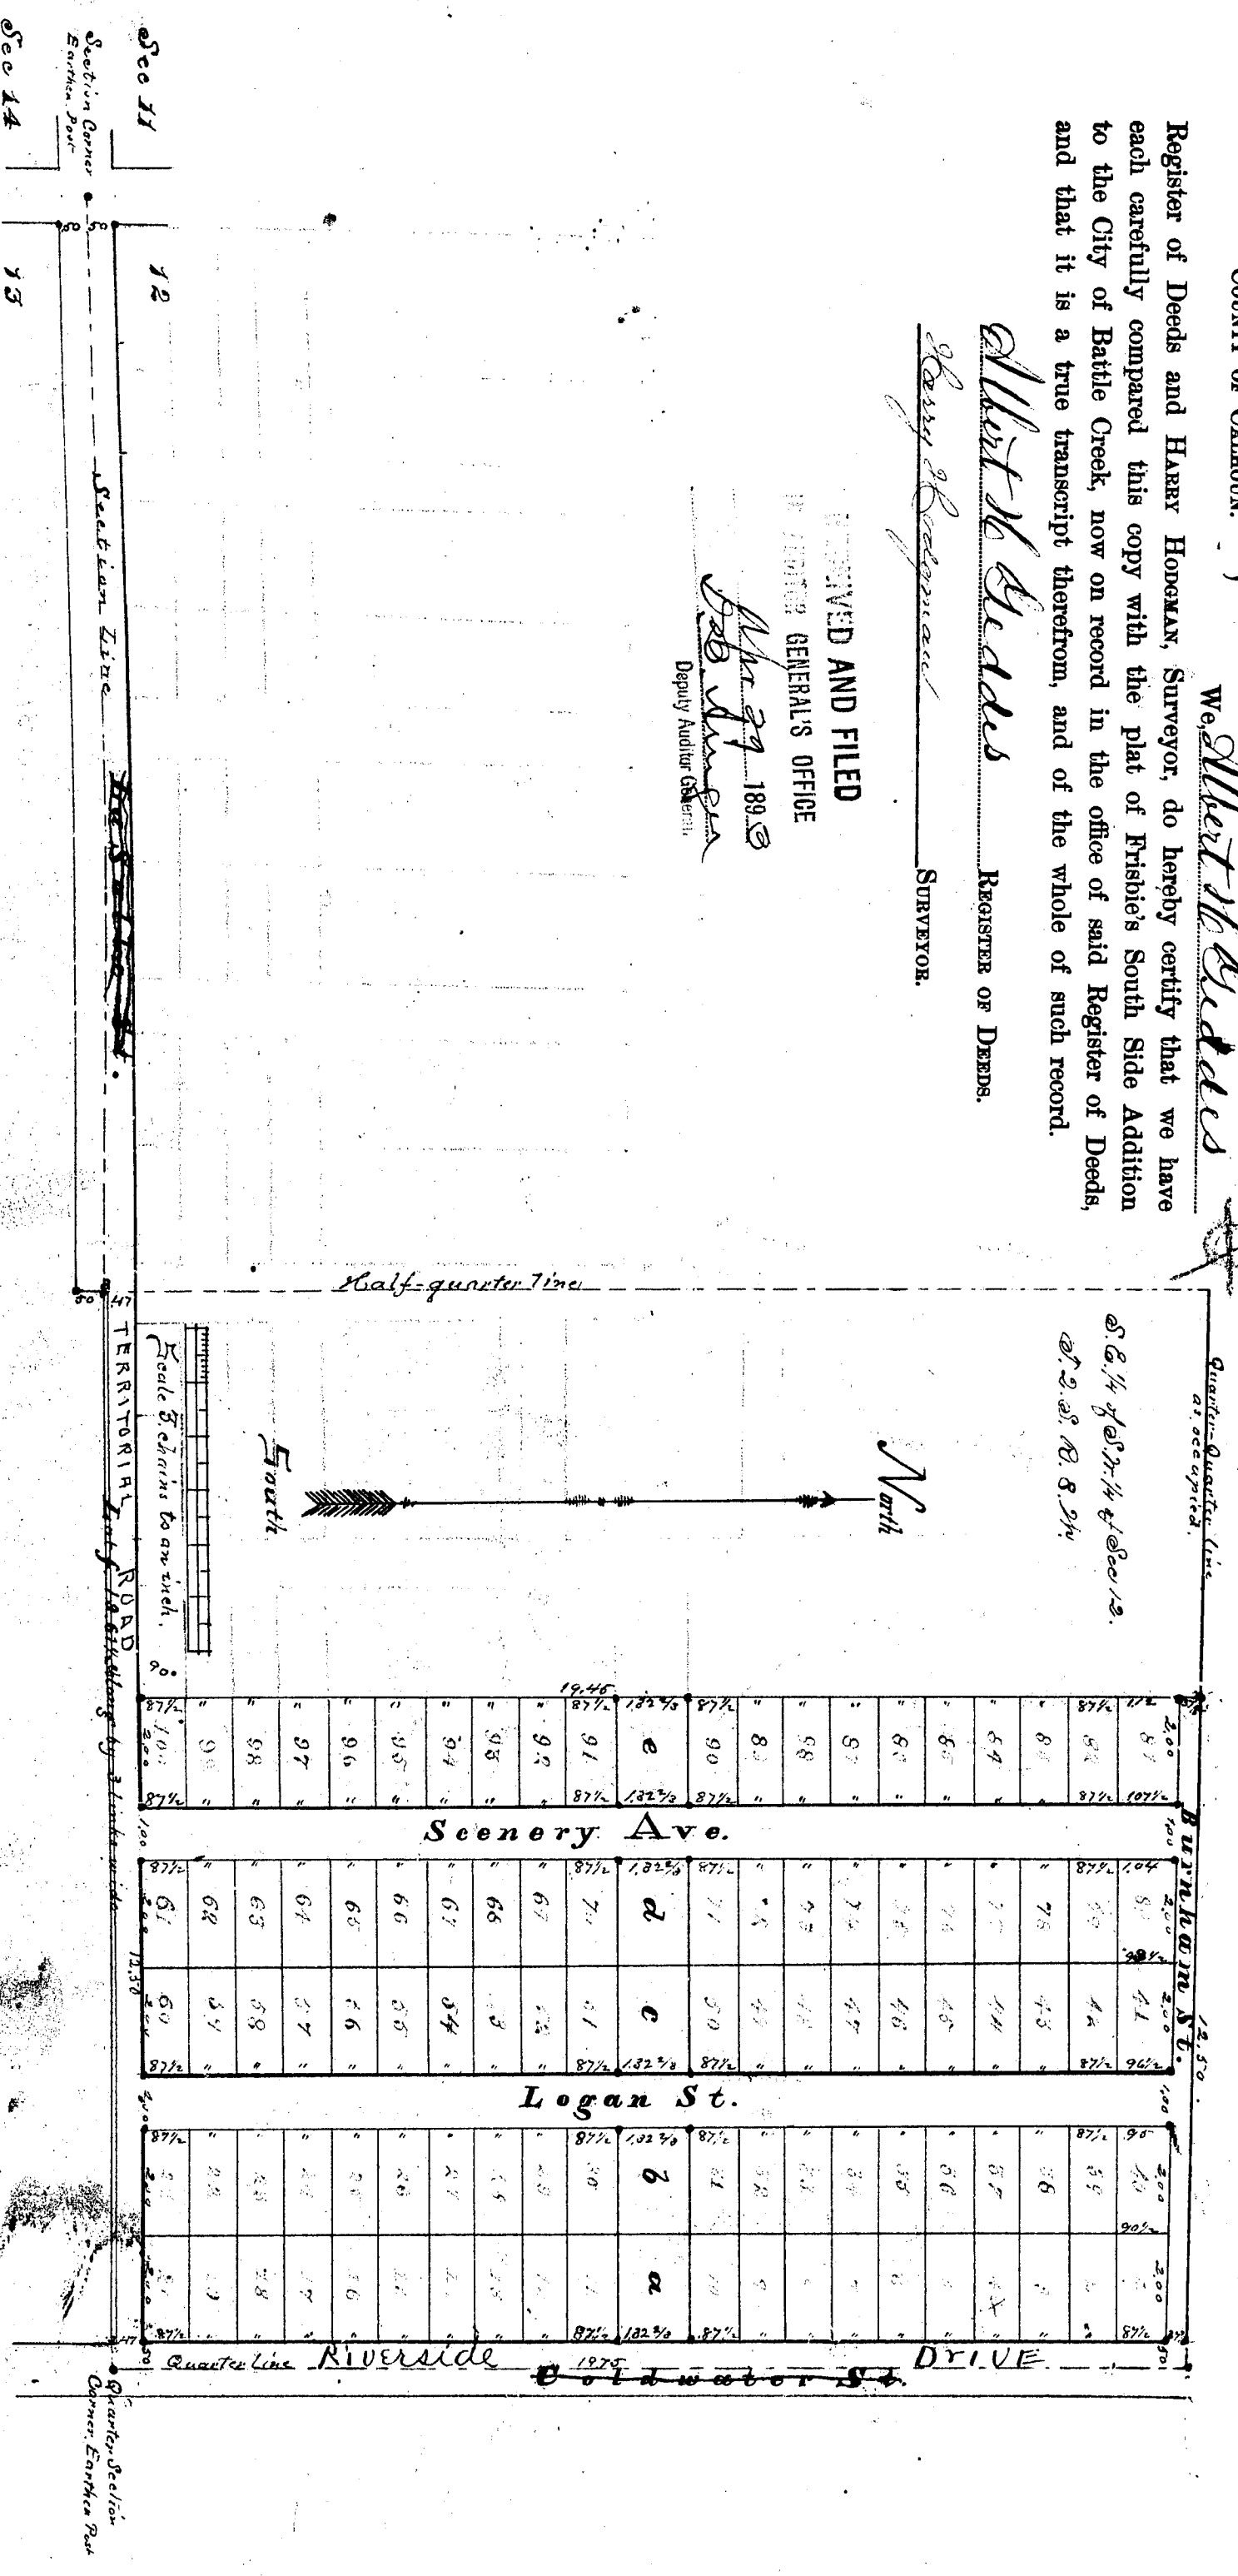

PLAT OF
FRISBIE'S SOUTH SIDE ADDITION
TO THE CITY OF BATTLE CREEK,
CALHOUN COUNTY, MICHIGAN.

CONSISTING of a strip of land 50 links wide off from the South side of the Southwest quarter of Section 12, also a strip of land 50 links wide off from the North end of the West half of the Northwest quarter of Section 13, and a piece of land 12.50 chains wide off from the East side of the remaining part of the Southeast quarter of the Southwest quarter of Section 12, all in Township 2, South Range 8 West.
NOVEMBER 5, 1890.
HARRY HODGMAN, SURVEYOR.

I DO HEREBY CERTIFY, that this is a correct plat of Frisbie's South Side Addition to the City of Battle Creek, as surveyed by me and that permanent monuments have been planted at all the angles in the boundary line of the land platted and at the intersections of all streets, or of streets and alleys, at the points marked with black circles on the plat. These monuments consist of cedar stakes, driven eighteen inches in the ground with three stones planted around each stake, except at the Section Corner and Quarter Post, where solid earthen posts 3 inches in diameter are planted.

Witness to Northeast corner of Plat, Black Oak 10 inches in diameter, N. 24 1/2 degrees W. 44 links.
Witness to South Quarter Post of Section 12, White Oak 22 inches in diameter, N. 61 1/4 degrees E. 66 1/4 links, Apple tree S. 75 degrees E. 74 links.
Witness to Corner of Sections 11, 12, 13 and 14, Burr Oak 14 inches diameter, S. 69 1/2 degrees W. 69 links, Hickory 12 inches diameter, S. 23 1/2 degrees E. 1.39 links.

We, ORIN B. FRISBIE and ESTELLA FRISBIE his wife, and GEORGE R. BURNHAM and MARIETTA A. BURNHAM his wife, owners of the land described in this plat of Frisbie's South Side Addition to the City of Battle Creek, do hereby execute said Plat, and dedicate to the public the land marked thereon as Streets and Avenues for use as public highways, and for no other purpose.

IN TESTIMONY WHEREOF, we have hereunto affixed our signatures this 14th day of November, A. D. 1890.

Examined and approved Oliver H. Melker DEPUTY AUDITOR GENERAL.
Received for record the 16 day of December, A. D. 1890, at 11 o'clock A. M. and recorded in Liber 2 of Plats on Page 35.
STATE OF MICHIGAN, } s. s.
COUNTY OF CALHOUN, }
Oliver H. Melker NOTARY PUBLIC.
STATE OF MICHIGAN, } s. s.
COUNTY OF CALHOUN, }
George R. Burnham L. S.
Marietta A. Burnham L. S.

On this 14th day of November, A. D. 1890, before me a Notary Public, in and for said County, personally appeared ORIN B. FRISBIE and ESTELLA FRISBIE his wife, and GEORGE R. BURNHAM and MARIETTA A. BURNHAM his wife, to me known to be the persons who executed this plat, and who severally acknowledged the same to be their free act and deed.

Examined and approved Alfred H. Giddles REGISTER OF DEEDS FOR CALHOUN COUNTY.
Received for record the 16 day of December, A. D. 1890, at 11 o'clock A. M. and recorded in Liber 2 of Plats on Page 35.
STATE OF MICHIGAN, } s. s.
COUNTY OF CALHOUN, }
Alfred H. Giddles REGISTER OF DEEDS.
fully compared this copy with the original plat of Frisbie's South Side Addition to the City of Battle Creek, and that it is an exact copy thereof, and of the whole of such original plat.

STATE OF MICHIGAN, } s. s.
COUNTY OF CALHOUN, }
Alfred H. Giddles REGISTER OF DEEDS.
Register of Deeds and Harry Hodgman, Surveyor, do hereby certify that we have each carefully compared this copy with the plat of Frisbie's South Side Addition to the City of Battle Creek, now on record in the office of said Register of Deeds, and that it is a true transcript therefrom, and of the whole of such record.

D AND FILED
GENERAL'S OFFICE
Nov 29 1890
Harry Hodgman

