

PLAT OF FRISHIE'S ANNEX

TO THE
City of Battle Creek, Calhoun County, Michigan.

Consisting of that part of Section 6 Township 2 South Range 7 West commencing at the centre of the North-East fractional quarter of said Section and running thence West along the half-quarter line 6.70 chains thence North at right angles with said line 7.50 chains; thence East 9.86 1/2 chains; thence South 8.75 chains; thence West 2.66 1/2 chains; thence South 3.75 chains to the place of beginning.

I DO HEREBY CERTIFY, that this is a correct plat of Frishie's Annex to the City of Battle Creek as surveyed by me and that permanent monuments of iron pipe have been planted at all the angles in the boundary line of the land platted and at the intersection of all streets or of streets and avenues at the points marked by black circles in the plat.

HARRY HODGMAN, Surveyor. February 11th, 1891.

We, Olex B. Frishie and Bertrilla Frishie his wife, owners of the land described in this plat of Frishie's Annex to the City of Battle Creek do hereby execute said plat and dedicate to the public the land marked thereon as streets and avenues for use as public highways.

IN TESTIMONY WHEREOF, we have hereunto affixed our signatures this 13th day of February, A. D., 1891.

EXECUTED IN PRESENCE OF

Wm. B. Frishie
Bertrilla Frishie
STATE OF MICHIGAN,
COUNTY OF CALHOUN,

Wm. B. Frishie
Bertrilla Frishie
L. S. Owner.
L. S. "

On this 13th day of February, A. D., 1891, before me a Notary Public, in and for said County, personally appeared Olex B. Frishie and Bertrilla Frishie his wife, to me known to be the persons who executed this plat, and who acknowledged the same to be their free act and deed.

Examined and approved *February 19* A. D., 1891. *Wm. B. Frishie* NOTARY PUBLIC,
Received for record the *26* day of *Feb* 1891, at *9* o'clock, *9* AM and recorded in Liber *8* of Plats, on Page *25*

STATE OF MICHIGAN,
COUNTY OF CALHOUN,

Albert H. Gledits REGISTRAR OF DEEDS FOR CALHOUN COUNTY.

We, *Albert H. Gledits* Registrar of Deeds and Harry Hodgman, Surveyor, hereby certify that we have each carefully compared this copy with the original plat of Frishie's Annex to the City of Battle Creek, and that it is an exact copy thereof and of the whole of said plat.

Albert H. Gledits REGISTRAR OF DEEDS.
Harry Hodgman SURVEYOR.

STATE OF MICHIGAN,
COUNTY OF CALHOUN,

We, *Albert H. Gledits* Registrar of Deeds and Harry Hodgman, Surveyor, hereby certify that we have each carefully compared this copy with the plat of Frishie's Annex to the City of Battle Creek, now on record in the office of said Registrar of Deeds, and that it is a true transcript thereof and of the whole of such record.


Albert H. Gledits REGISTRAR OF DEEDS.
Harry Hodgman SURVEYOR.

RECORDED AND FILED

NOTARY GENERAL'S OFFICE

Wm. B. Frishie 1891

Bertrilla Frishie 1891

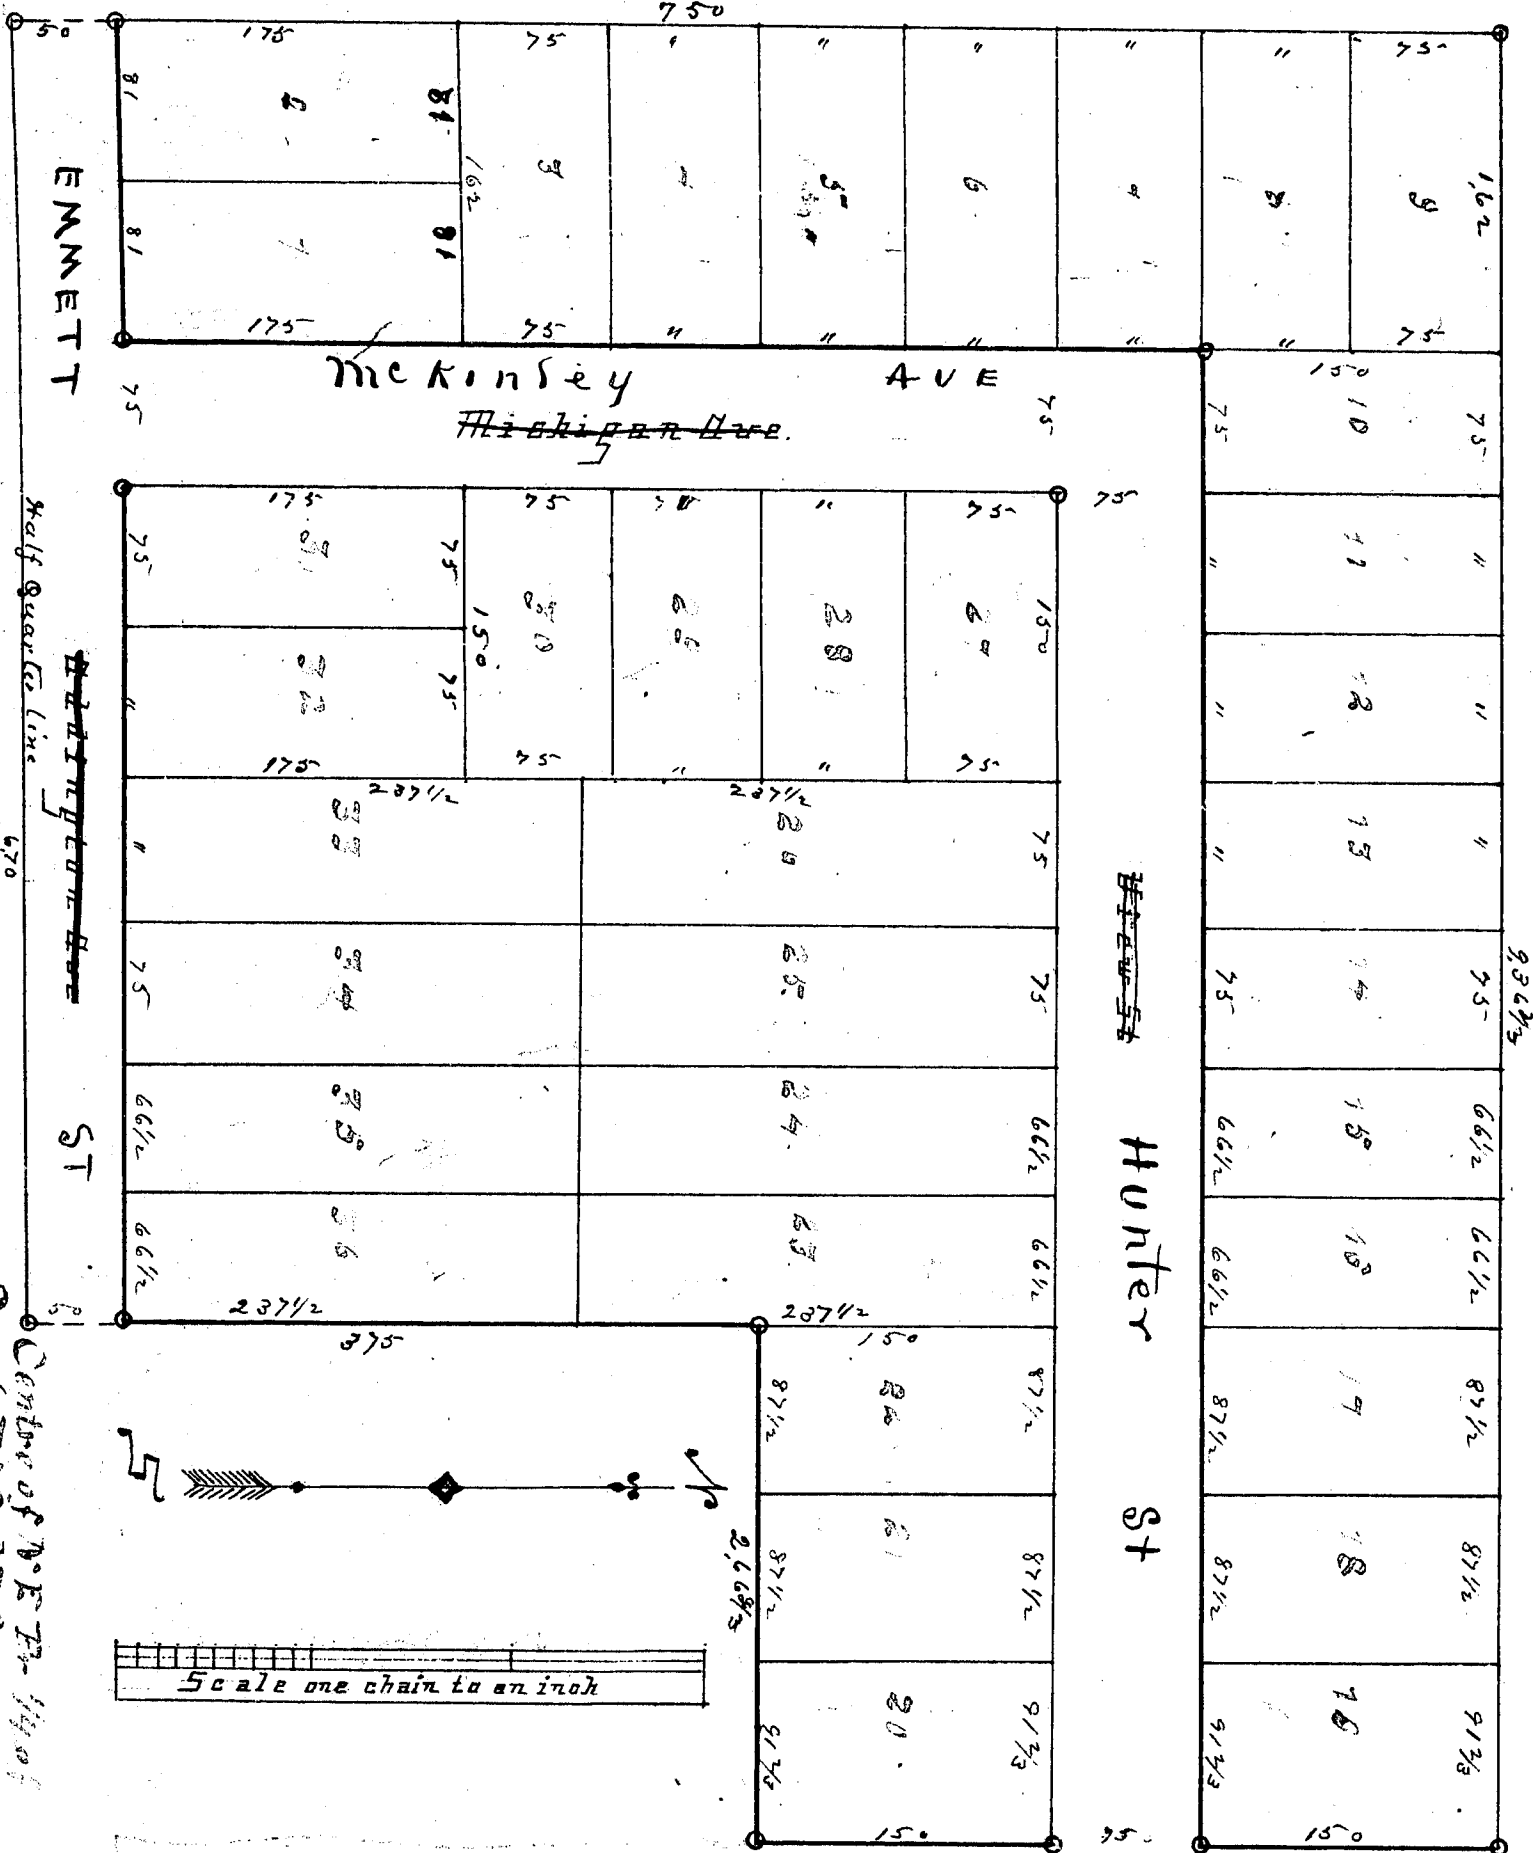

Frishie, Harry B. & Estrella
Auditor General

13378

PLAT OF FRISHIE'S ANNEX

TO THE City of Battle Creek, Calhoun County, Michigan.

Consisting of that part of Section 6 Township 2 South Range 7 West commencing at the centre of the North-East fractional quarter of said Section and running thence West along the half-quarter line 6.70 chains; thence North at right angles with said line 7.50 chains; thence East 0.30 $\frac{1}{2}$ chains; thence South 8.75 chains; thence West 2.06 $\frac{1}{2}$ chains; thence South 8.75 chains to the place of beginning.

HARRY HODGMAN, Surveyor February 11th, 1891.

I DO HEREBY CERTIFY, that this is a correct plat of Frishie's Annex to the City of Battle Creek as surveyed by me and that permanent monuments of iron pipe have been planted at all the angles in the boundary line of the land platted and at the intersection of all streets or of streets and avenues at the points marked by black circles in the plat, Surveyor.

We, ORIN B. FRISHIE and ESTRELLA FRISHIE his wife, owners of the land described in this plat of Frishie's Annex to the City of Battle Creek do hereby execute said plat and dedicate to the public the land marked thereon as streets and avenues for use as public highways.

IN TESTIMONY WHEREOF, we have hereunto affixed our signatures this 11th day of February, A. D., 1891.

EXECUTED IN PRESENCE OF

STATE OF MICHIGAN,
COUNTY OF CALHOUN,

Wm B Frishie
L. S. Owner.
Estrella Frishie
L. S. "

On this 11th day of February, A. D., 1891, before me a Notary Public, in and for said County, personally appeared ORIN B. FRISHIE and ESTRELLA FRISHIE his wife, to me known to be the persons who executed this plat, and who acknowledged the same to be their free act and deed.

Examined and approved February 11th A. D., 1891. Notary Public,
Received for record the 16th day of Feb 1891, at 9 o'clock, A. M. and recorded in Liber 8 of Plats, on Page 25 Deputy Auditor General.

STATE OF MICHIGAN,
COUNTY OF CALHOUN,

Wm B Frishie
Register of Deeds

carefully compared this copy with the original plat of Frishie's Annex to the City of Battle Creek, and that it is an exact copy thereof and of the whole of said plat.

Wm B Frishie
Register of Deeds

STATE OF MICHIGAN,
COUNTY OF CALHOUN,

Wm B Frishie
Register of Deeds

fully compared this copy with the plat of Frishie's Annex to the City of Battle Creek, now on record in the office of said Register of Deeds, and that it is a true transcript therefrom and of the whole of such record.

Wm B Frishie
Register of Deeds

Register of Deeds

AND FILED

1891

Wm B Frishie
Auditor

