


3466

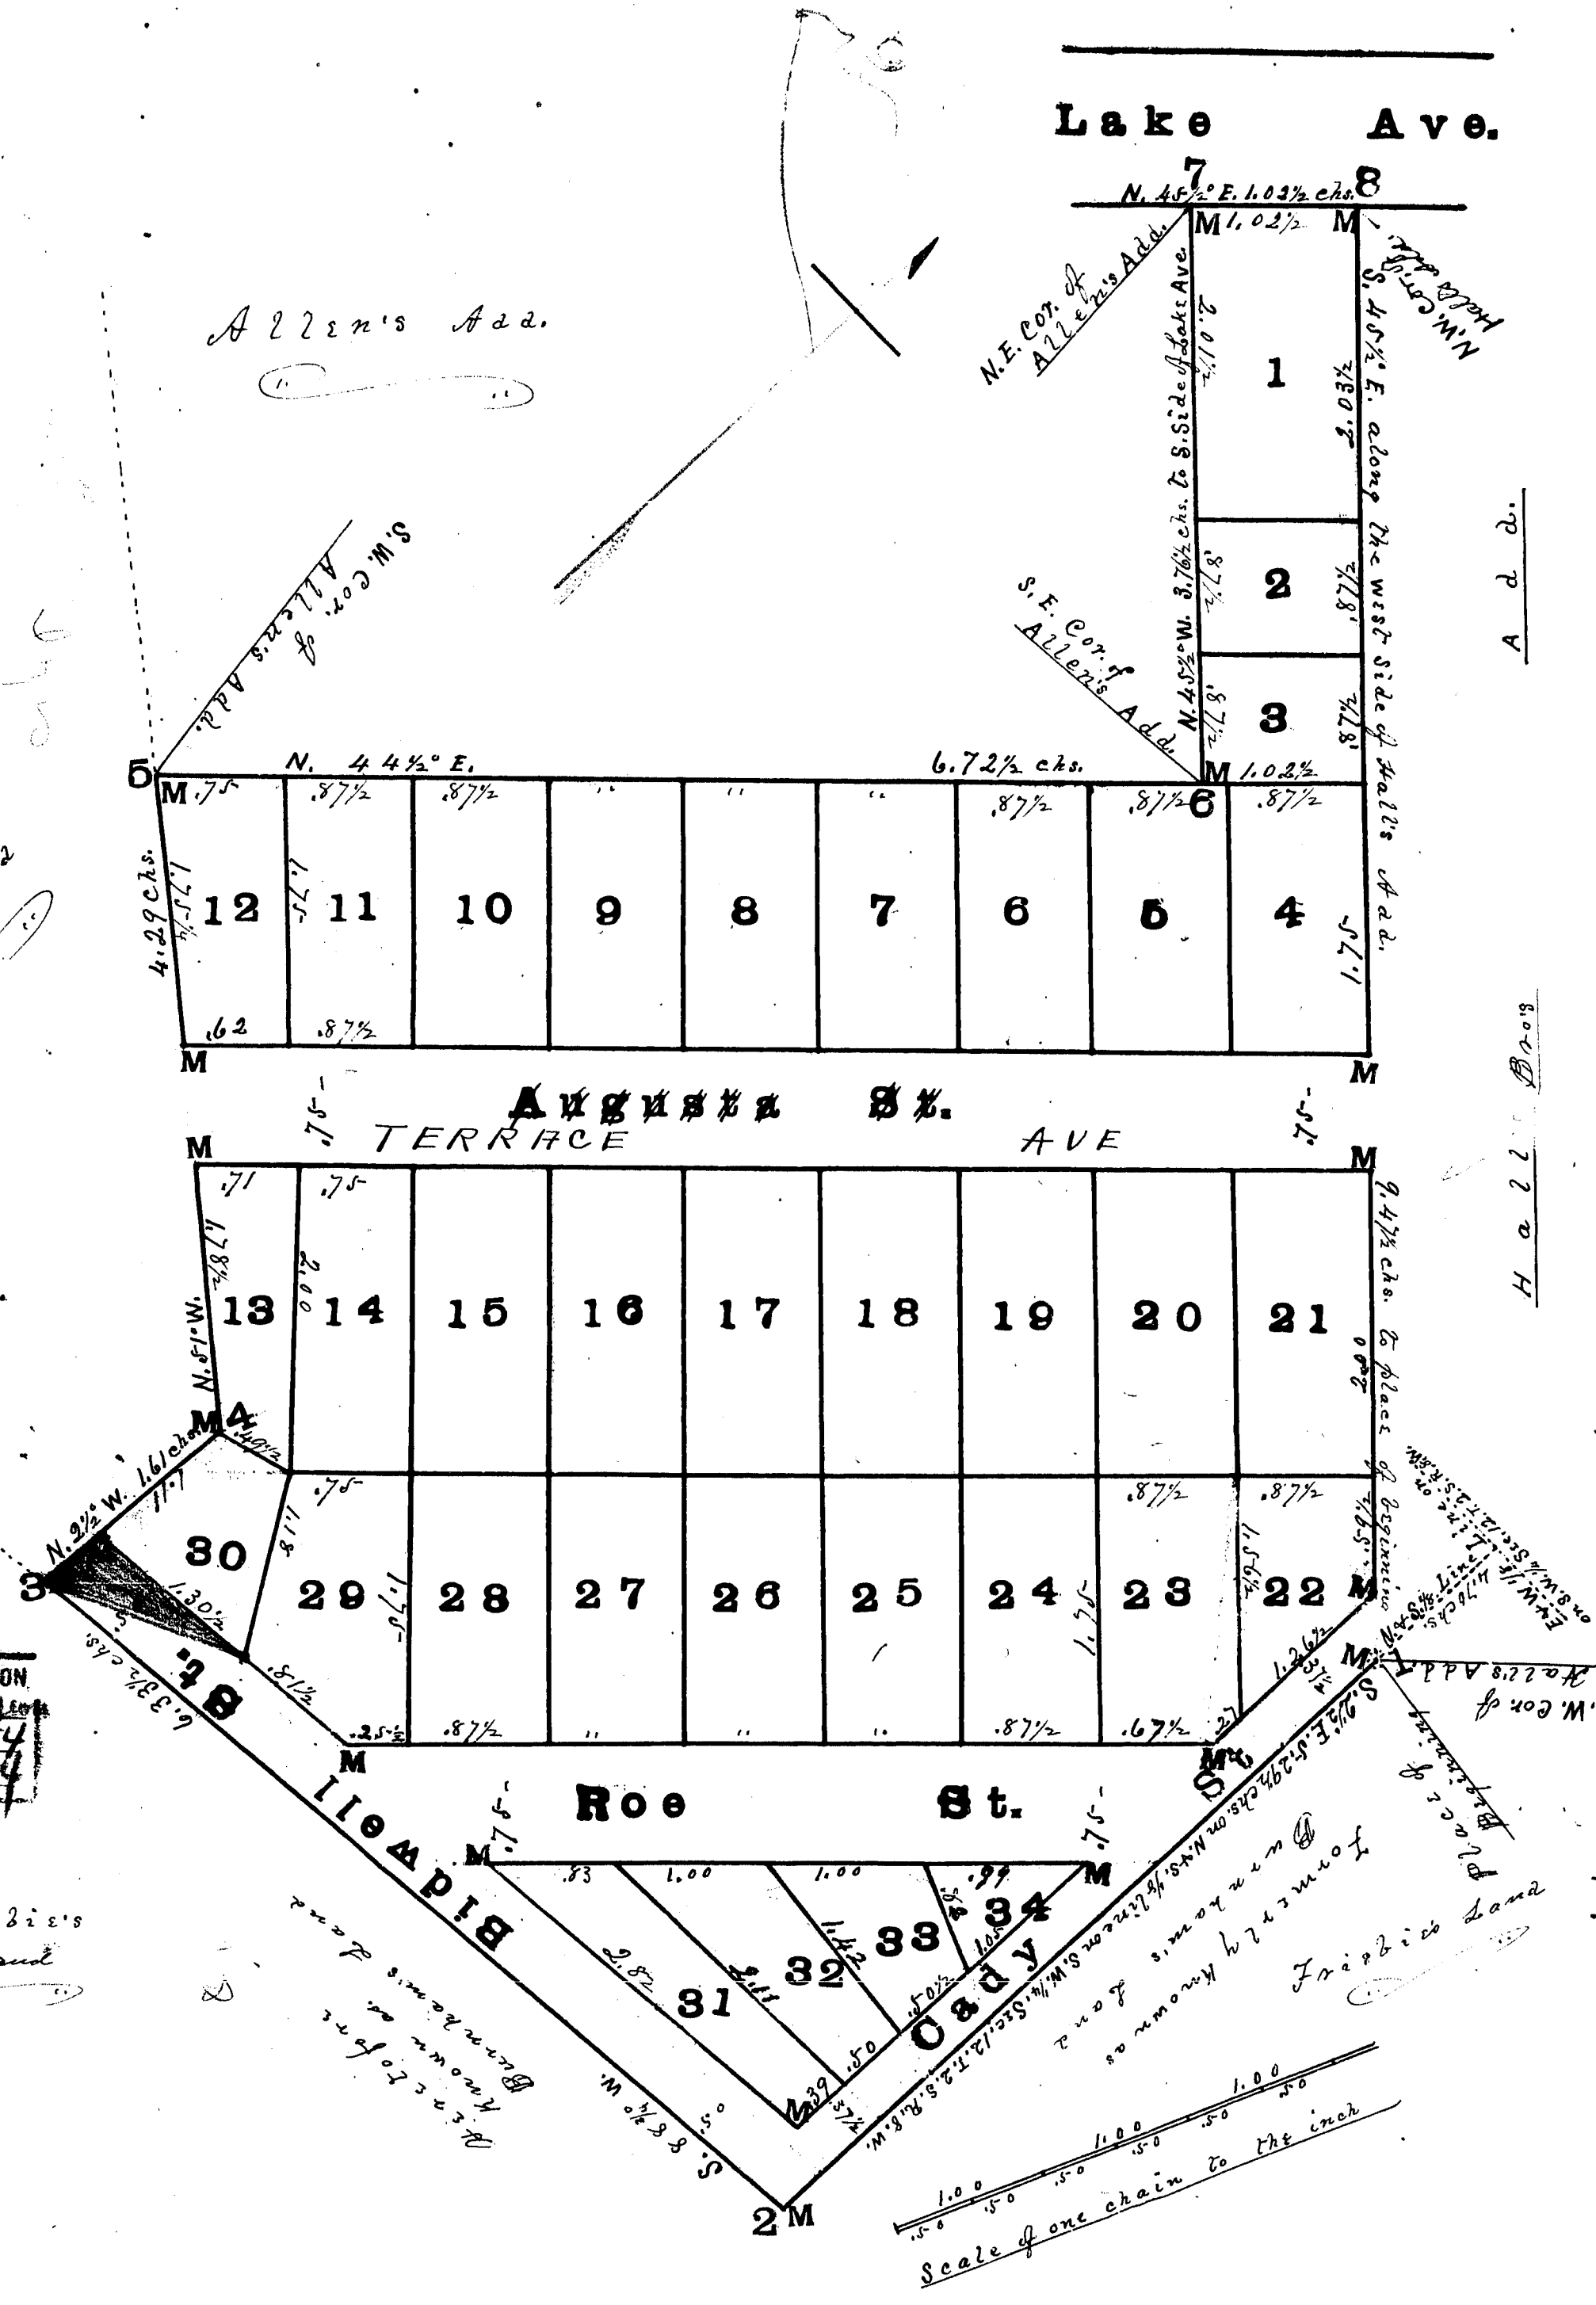

GRAY'S ADDITION TO BATTLE CREEK.

DEDICATION.

Know all Men by these Presents, That I, the undersigned, Mrs. Augusta S. Gray, as proprietor, have caused the land embraced in the annexed plat to be surveyed, laid out and platted, to be known as Gray's Addition to Battle Creek, and that the streets as shown on said plat are hereby dedicated to the use of the public.

Signed and sealed in presence of
Joel C. Hopkins } Augusta S. Gray [L.S.]
Frederick H. Gray }
WITNESSES

STATE OF MICHIGAN,
COUNTY OF CALHOUN,

On this 25th day of August A. D. 1891, before me, a Notary Public, in and for said county, personally appeared the above named Mrs. Augusta S. Gray, known to me to be the person who executed the above dedication, and acknowledged the same to be her free act and deed.

Joel C. Hopkins
Notary Public, Calhoun Co., Mich.

DESCRIPTION OF LAND PLATTED.

The land embraced in the annexed plat of Gray's Addition to Battle Creek is situate on the S. W. 1/4 of the S. W. 1/4 of sec. 12 Tp. 2 S., R. 8 W., Calhoun county, Michigan, and bounded as follows: Beginning on the N. and S. 1/4 line 4.70 chs. south of the 1/4 Quarter post and running thence on said 1/4 line S. 2 1/4° E. 5.29 1/2 chs. to land heretofore known as Burnham's land; thence S. 88 1/2° W. along north side of said Burnham's land 6.33 1/2 chs. to the S. W. corner of Bidwell's land; thence N. 2 1/4° W. along said Bidwell's land 1.61 chs; thence N. 51° W. along said Bidwell's land 4.29 chs. to the S. W. corner of Allen's Addition to Battle Creek; thence N. 44 1/2° E. along the south side of Allen's Addition 6.72 1/2 chs. to the S. E. corner of said Addition; thence N. 45 1/2° W. along the east side of said Allen's Addition, 3.76 1/2 chs. to the south side of Lake Ave; thence N. 45 1/2° E. along the south side of Lake Ave. 1.02 1/2 chs; thence S. 45 1/2° E. along the west side of Hall's Addition 9.47 1/2 chs. to the place of beginning.

SURVEYOR'S CERTIFICATE.

I HEREBY CERTIFY, That the plat hereon delineated is a correct one, and that permanent monuments, each consisting of a Cedar Stake four to five inches through and twenty inches long, have been planted full depth in the ground, surrounded with three stones, each six to eight inches across, bedded even with the surface, at points marked thus "M", as thereon shown at all angles in the boundaries of land platted, and at all intersections of streets, or streets and alleys.

W. Austin
SURVEYOR.

STATE OF MICHIGAN,
COUNTY OF CALHOUN,

We, Albert H. Geddes, Register of Deeds, and A. W. Austin, Surveyor, hereby certify that we have each carefully compared this copy with the original plat of Gray's Addition to Battle Creek, and that it is an exact copy thereof and of the whole of such original map or plat.

W. Austin } Albert H. Geddes
Surveyor. Register of Deeds.

I hereby Certify, That this plat was approved by the Common Council of the city of Battle Creek, on the 17th day of August A. D. 1891.


C. R. Prall
Recorder of the City of Battle Creek.

Examined and approved September 2nd 1891. A. W. Austin
Deputy Auditor General.

Received for record this 4th day of September A.D. 1891, at 2 o'clock P.M., and recorded in Liber 2 of Plats on page 34.

Albert H. Geddes
Register of Deeds.

13384

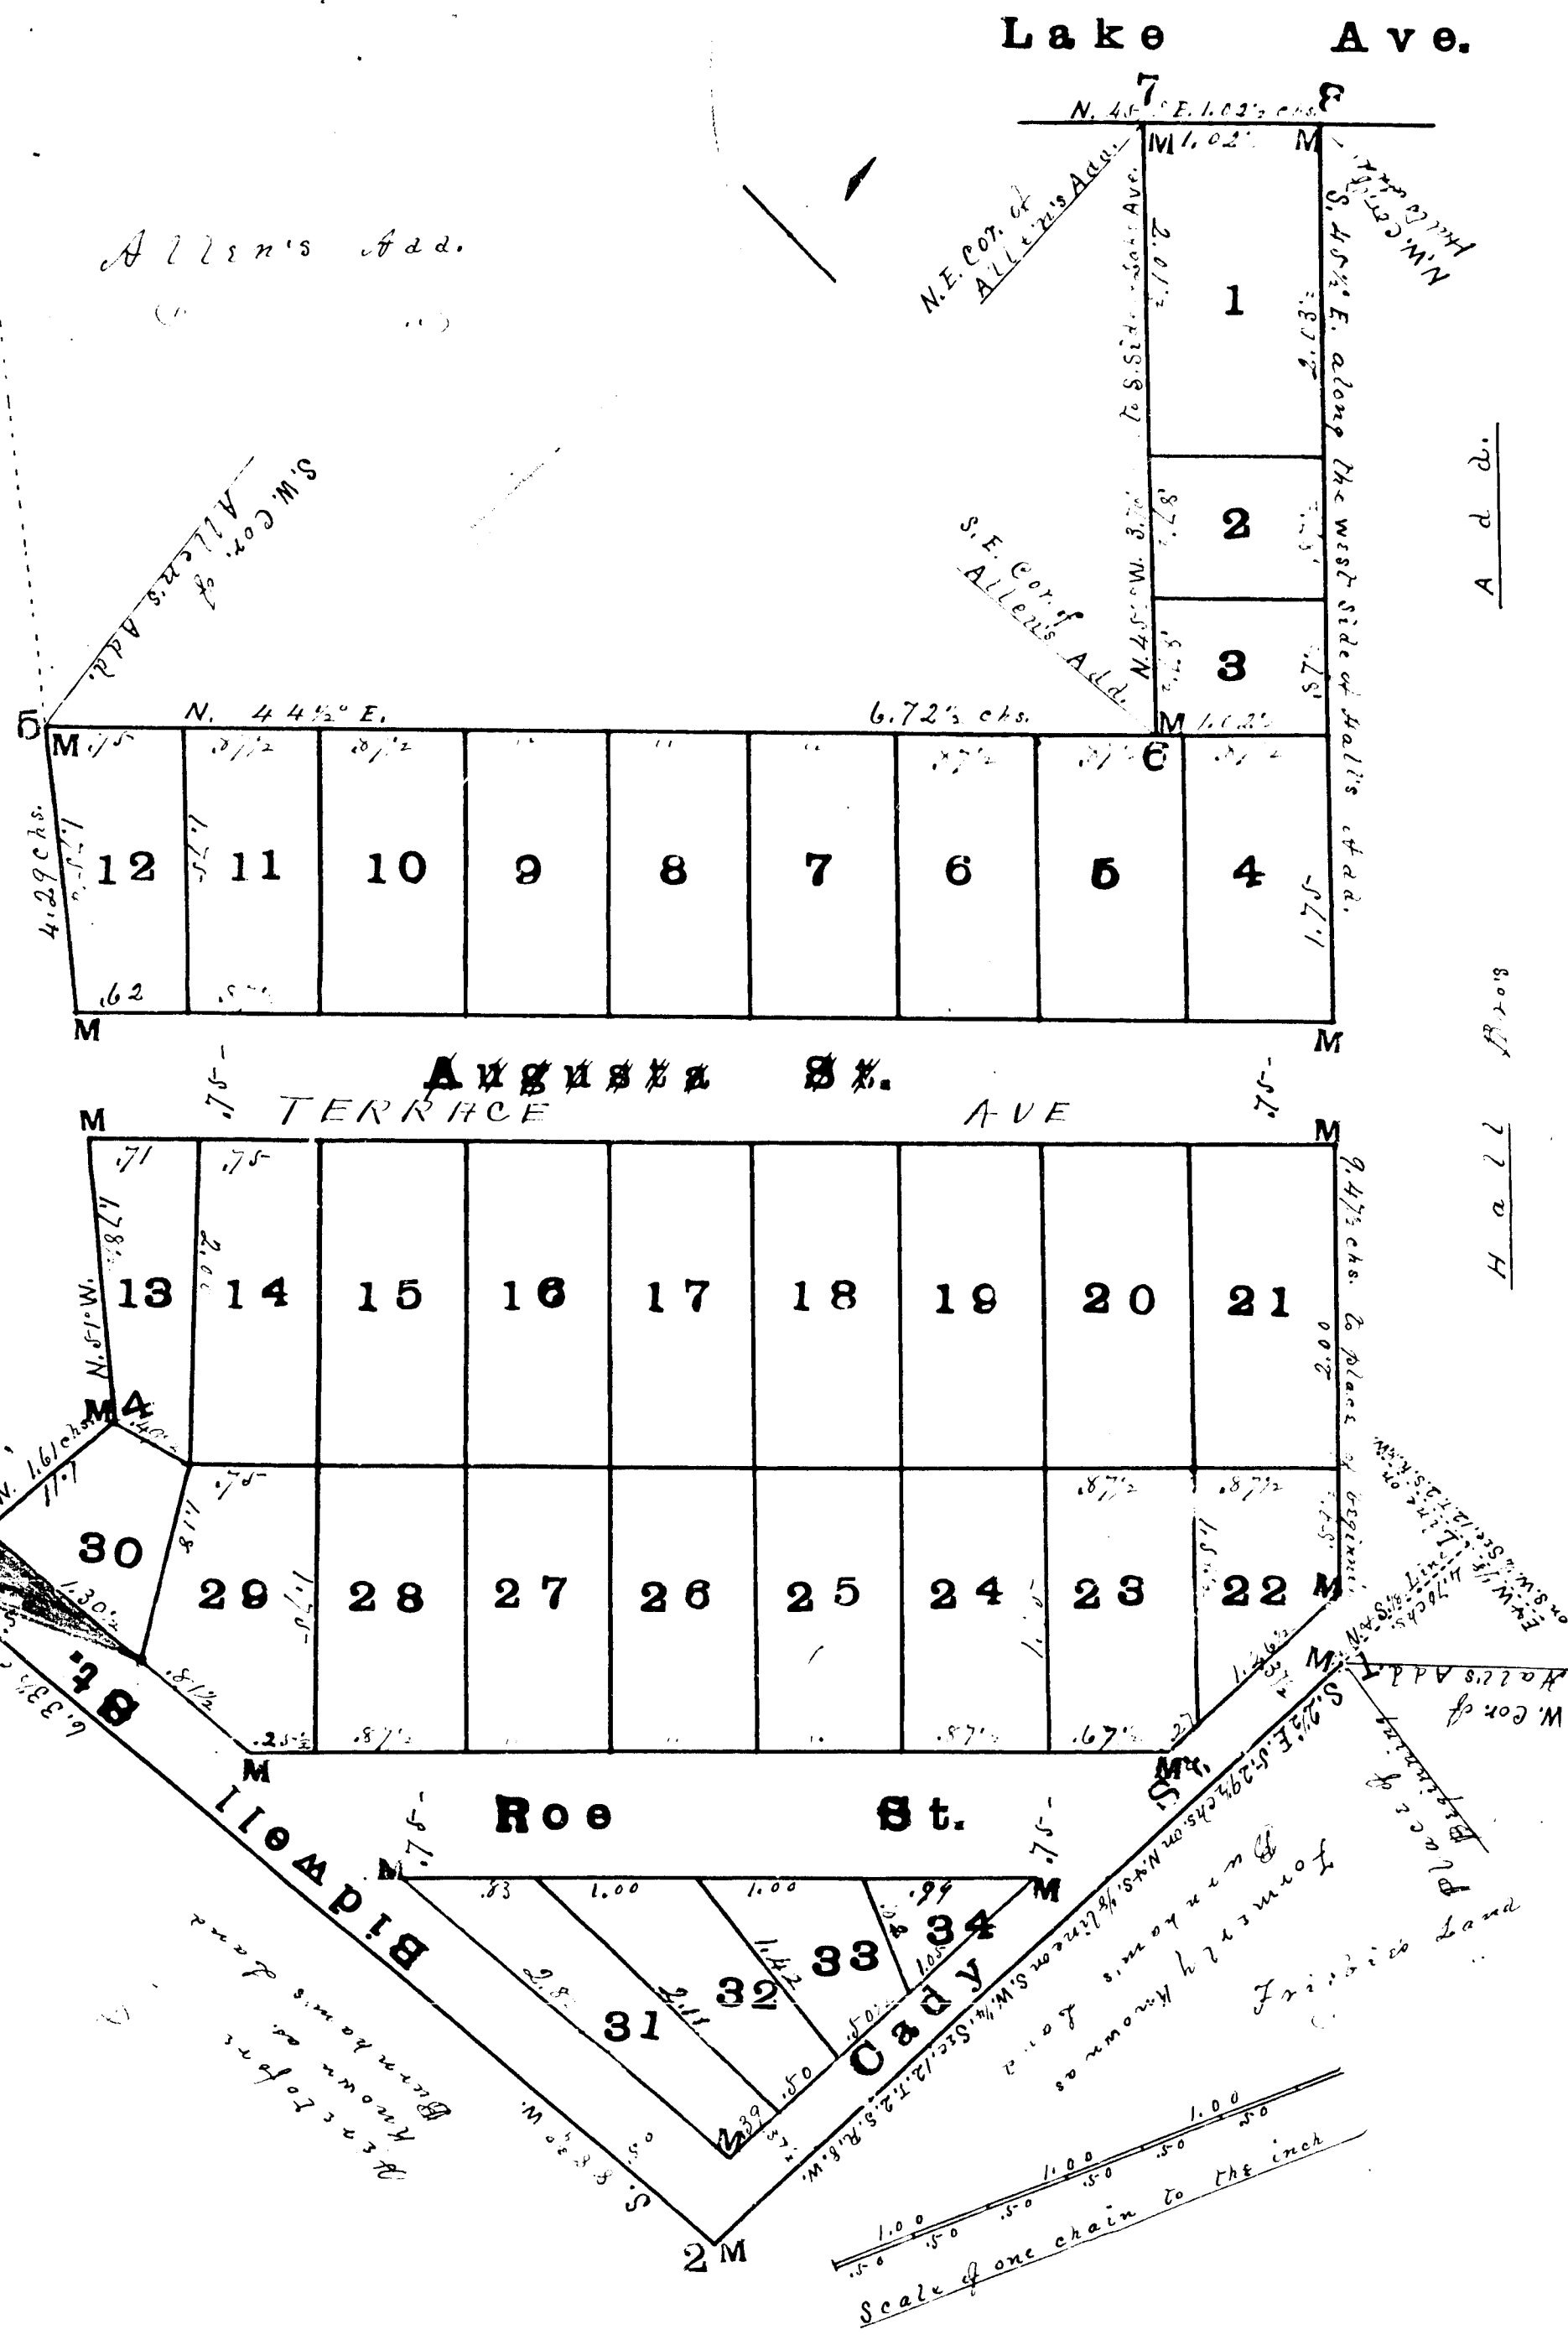

VACATED BY RESOLUTION
OF City Commission
1-26-54
VOUCHER NO 242-54

RECEIVED AND FILED
IN AUDITOR GENERAL'S OFFICE
September 10 1891
Albert H. Geddes
Deputy Auditor General.

GRAY'S ADDITION TO BATTLE CREEK. DEDICATION.

Know all Men by these Presents, That I, the undersigned, Mrs. Augusta S. Gray, as proprietor, have caused the land embraced in the annexed plat to be surveyed, laid out and platted, to be known as Gray's Addition to Battle Creek, and that the streets as shown on said plat are hereby dedicated to the use of the public.
Signed and sealed in presence of

John C. Hopkine } *Augusta S. Gray* [L.S.]
Isidore's Land }
WITNESSES

STATE OF MICHIGAN,
COUNTY OF CALHOUN,
On this 25th day of August A. D. 1891, before me, a Notary Public, in and for said county, personally appeared the above named Mrs. Augusta S. Gray, known to me to be the person who executed the above dedication, and acknowledged the same to be her free act and deed.
John C. Hopkine
Notary Public, Calhoun Co., Mich.

DESCRIPTION OF LAND PLATTED.
The land embraced in the annexed plat of Gray's Addition to Battle Creek is situate on the S. W. 1/4 of the S. W. 1/4 of sec. 12 Tp. 2 S., R. 8 W., Calhoun county, Michigan, and bounded as follows: Beginning on the N. and S. 1/4 line 4.70 chs. south of the 1/4 Quarter post and running thence on said 1/4 line S. 24° E. 5.29 1/2 chs. to land heretofore known as Burnham's land; thence S. 88 1/2° W. along north side of said Burnham's land 6.33 1/2 chs. to the S. W. corner of Bidwell's land; thence N. 24° W. along said Bidwell's land 1.61 chs; thence N. 51° W. along said Bidwell's land 4.29 chs. to the S. W. corner of Allen's Addition to Battle Creek; thence N. 44 1/2° E. along the south side of Allen's Addition 6.72 1/2 chs. to the S. E. corner of said Addition; thence N. 45 1/2° W. along the east side of said Allen's Addition, 3.76 1/2 chs. to the south side of Lake Ave; thence N. 45 1/2° E. along the south side of Lake Ave. 1.02 1/2 chs; thence S. 45 1/2° E. along the west side of Hall's Addition 9.47 1/2 chs. to the place of beginning.

SURVEYOR'S CERTIFICATE.
I HEREBY CERTIFY, That the plat hereon delineated is a correct one, and that permanent monuments, each consisting of a Cedar Stake four to five inches through and twenty inches long, have been planted full depth in the ground, surrounded with three stones, each six to eight inches across, bedded even with the surface, at points marked thus "M", as thereon shown at all angles in the boundaries of the land platted, and at all intersections of streets, or streets and alleys.
A. W. Austin
SURVEYOR.

STATE OF MICHIGAN,
COUNTY OF CALHOUN,
We, Albert H. Geddes, Register of Deeds, and A. W. Austin, Surveyor, hereby certify that we have each carefully compared this copy with the original plat of Gray's Addition to Battle Creek, and that it is an exact copy thereof and of the whole of such original map or plat.
A. W. Austin }
Albert H. Geddes }
Register of Deeds.

I Herby Certify, That this plat was approved by the Common Council of the city of Battle Creek, on the 17th day of August A. D. 1891.
C. R. Thompson
Recorder of the City of Battle Creek.

Examined and approved September 2nd 1891. *A. W. Austin*
Deputy Auditor General.

Received for record this 4th day of September A.D. 1891, at 2 o'clock P.M., and recorded in Liber 77 of Plats on page 34.
Albert H. Geddes
Register of Deeds.