


Scale 1 inch = 100 feet
 All distances are in feet & inches.
 Variation 70° 50' E.

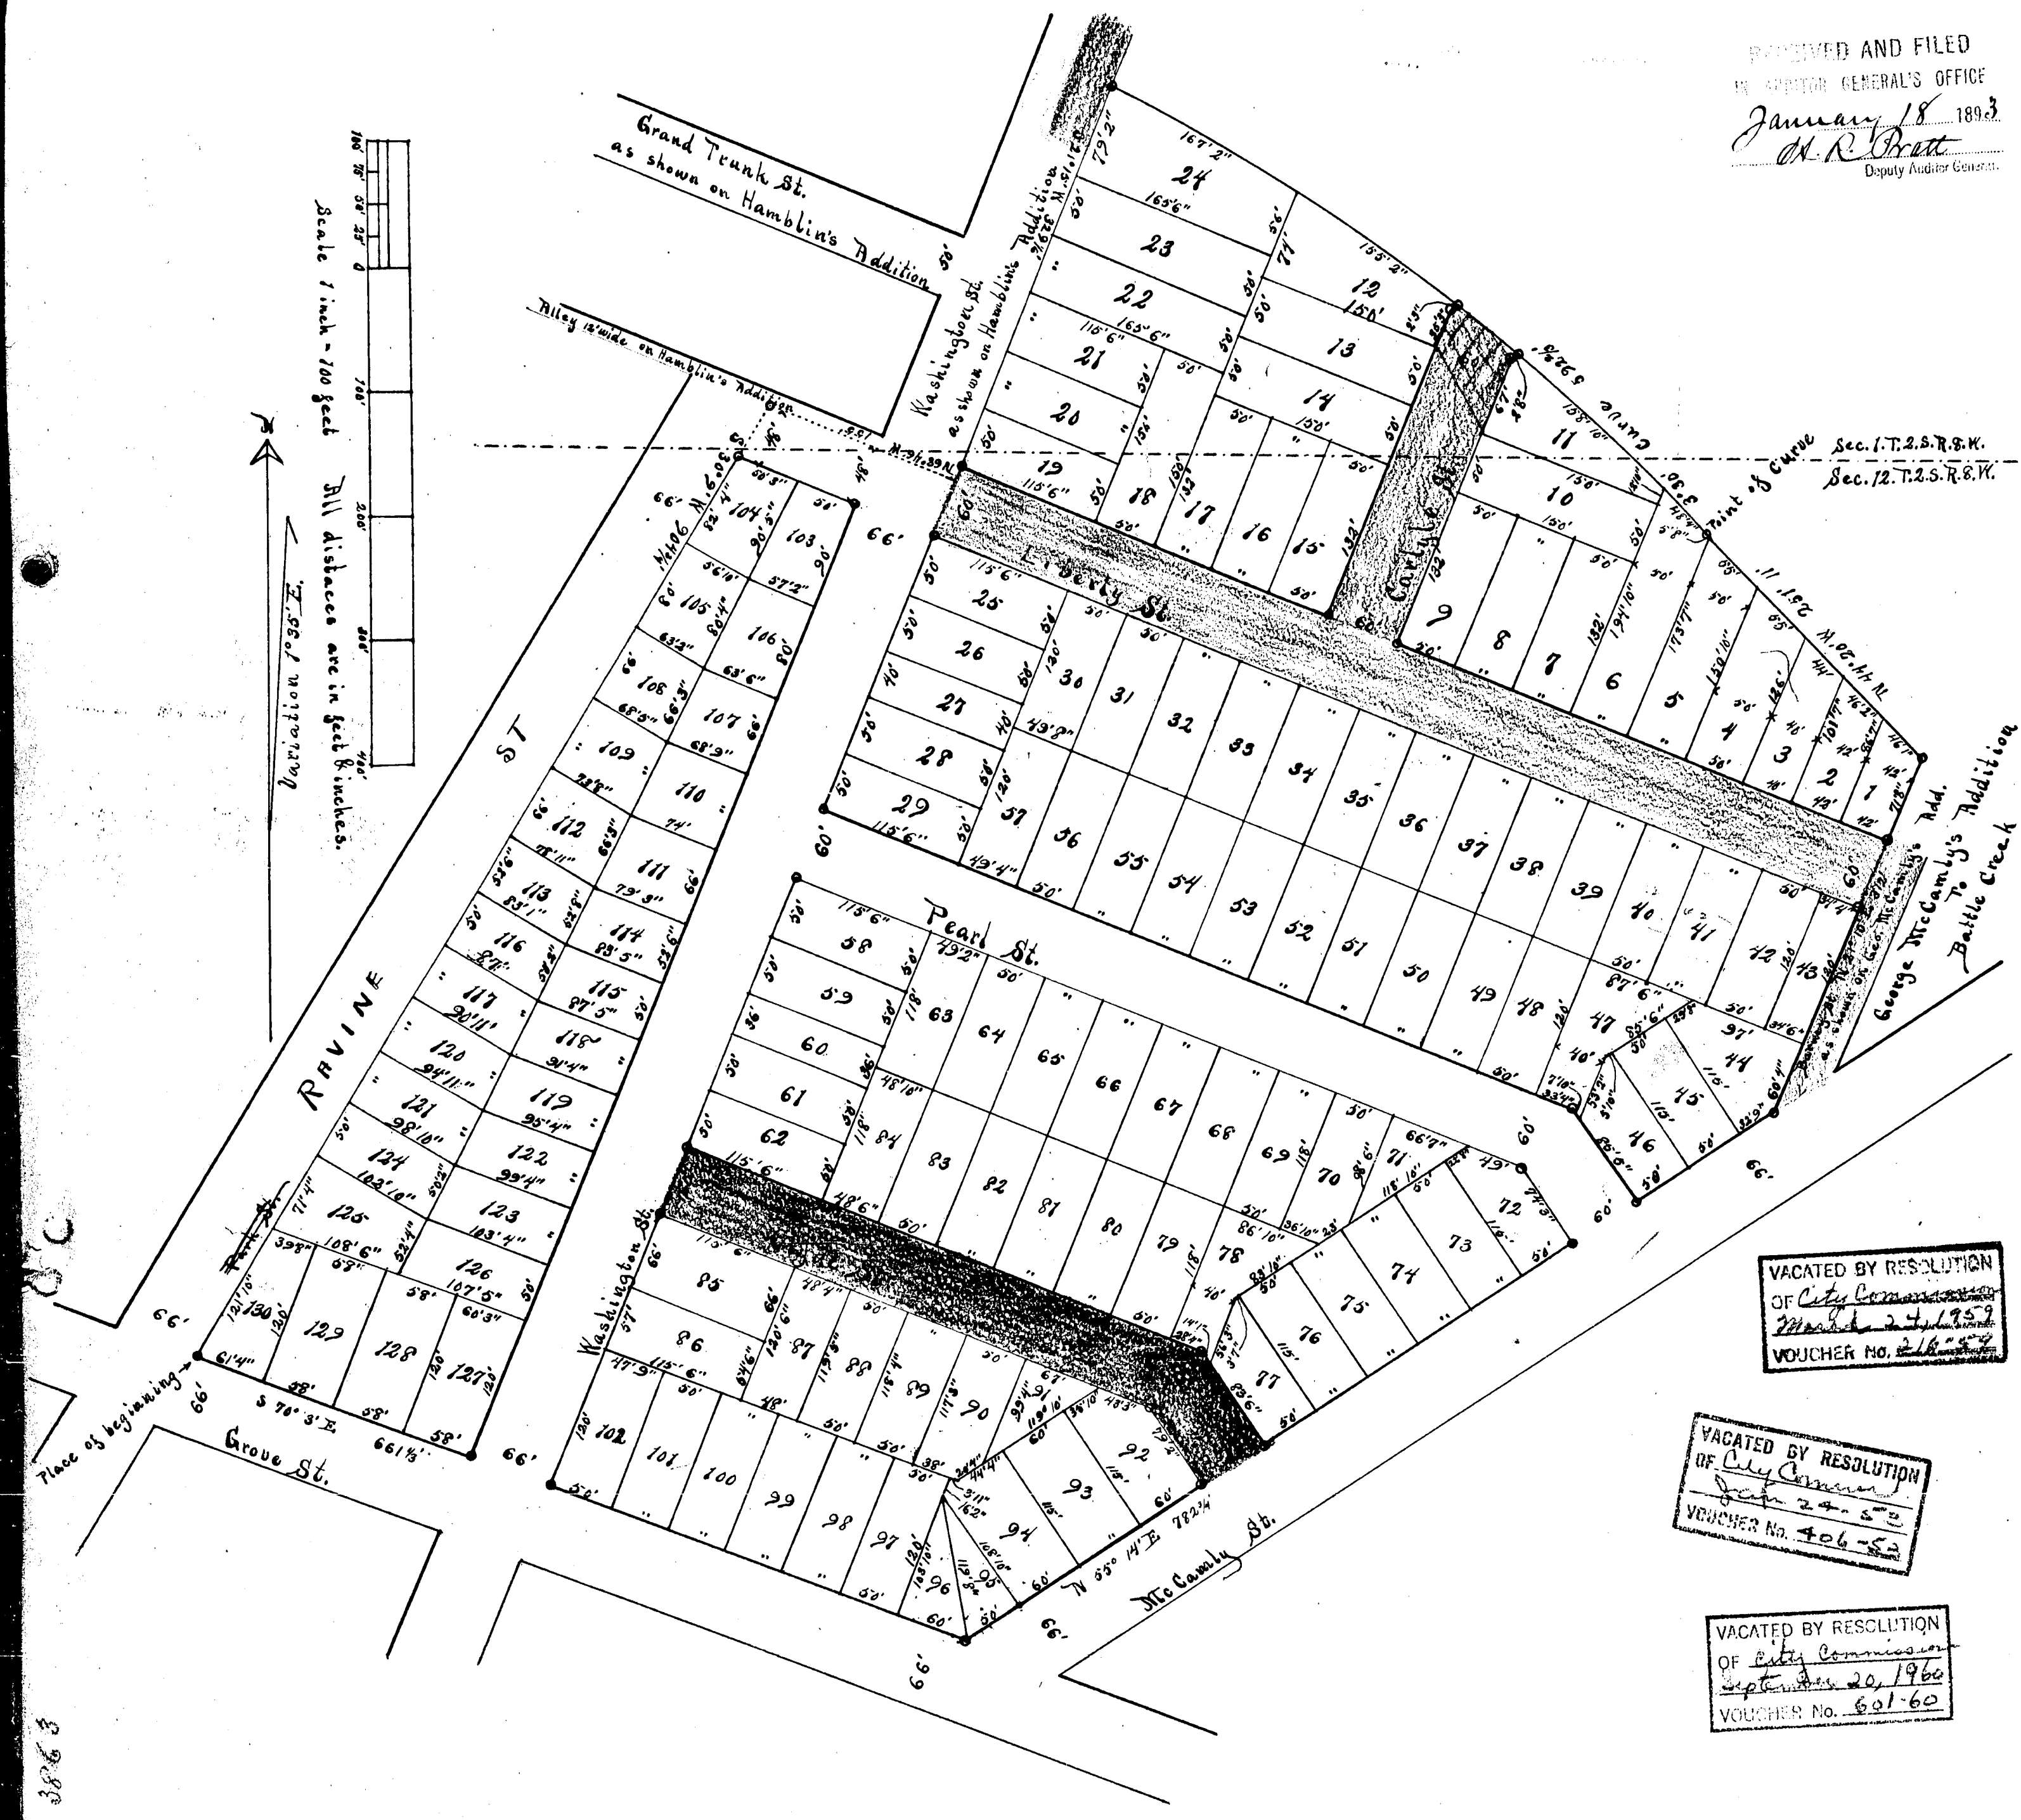

RECEIVED AND FILED
 IN ADDITION GENERAL'S OFFICE
 January 18 1893
 M. R. Pratt
 Deputy Auditor General

PARK + ADDITION TO BATTLE CREEK.

DEDICATION.

Know all Men by these Presents, That we, Archibald R. Henry, as proprietor, and Elizabeth E., his wife, have caused the land embraced in the annexed plat to be surveyed, laid out and platted, to be known as "Park Addition to Battle Creek," and that the streets as shown on said plat are hereby dedicated to the use of the public for highways.

Signed and sealed in presence of—
 H. Lindsay
 J. Marshall
 Archibald R. Henry [L. S.]
 Elizabeth E. Henry [L. S.]

STATE OF MICHIGAN,
 COUNTY OF CALHOUN,
 On this 18th day of January, A. D. 1893, before me, a Notary Public in and for said county, personally appeared the above named Archibald R. Henry and Elizabeth E., his wife, known to me to be the persons who executed the above dedication, and acknowledged the same to be their free act and deed.
 Harmon Lindsay
 Notary Public, Calhoun County, Michigan

DESCRIPTION OF LAND PLATTED.

THE land embraced in the annexed plat of Park Addition to Battle Creek is described as follows: Being all that part of the south-west quarter of section 1, and the northwest quarter of section 12, town 2 south, range 8 west, Michigan: Beginning at the intersection of the easterly line of Park Street and the northerly line of Grove Street in the City of Battle Creek, having witness Maple 3 inches in diameter, north 69° 55' west 40 1/2 feet, also Maple 3 inches in diameter, north 25° 30' west 73 1/2 feet, running thence south 70° 3' east 66 1/2 feet to McCamly Street; thence north 55° 14' east 78 1/2 feet along the northwesterly line of said McCamly Street to the westerly line of George McCamly's Addition to Battle Creek, having witness Maple 5 inches in diameter, south 20° west 102 feet, 11 inches, also Maple 2 inches in diameter, south 36° 30' east 57 feet, 5 inches; thence north 21° 10' east 312 feet along the westerly line of said George McCamly's Addition; thence north 44° 20' west 251 feet, 11 inches; thence northwesterly on a 30° 30' curve to the left 582 1/2 feet to Washington Street and the previous course being tangent to said curve at the beginning of the curve; thence south 21° 15' west 329 1-6 feet along the easterly line of Washington Street; thence north 68° 46' west 155 feet to the easterly line of Park Street, having witness Maple 3 inches in diameter, south 58° 10' west 132 feet, 10 inches, also Elm 12 inches in diameter, north 51° 10' east 139 1/2 feet; thence south 30° 9' west 504 1/2 feet along the easterly line of Park Street to the place of beginning.

SURVEYOR'S CERTIFICATE.

I HEREBY CERTIFY, That the Plat hereon delineated is a correct one, and that permanent monuments, consisting of Gas Pipe, have been planted at points marked thus, . . . as thereon shown at all angles in the boundaries of the land platted, and at all intersections of streets.
 Alfred L. Marshall
 SURVEYOR

I hereby Certify, That this Plat was approved by the Common Council of the City of Battle Creek, on the nineteenth day of December, A. D. 1892.
 C. R. Thompson
 Secretary of the City of Battle Creek

Examined and approved January 13 1893. M. R. Pratt
 Deputy Auditor General

Received for record this seventeenth day of January, A. D. 1893, at 11 o'clock A. M., and recorded in Liber B of Plats on page 4
 H. R. Kelley
 Register of Deeds

STATE OF MICHIGAN,
 COUNTY OF CALHOUN,
 We, Harwell J. Kelley Register of Deeds, and Alfred L. Marshall Surveyor, hereby certify that we have each carefully compared this copy with the original plat of "Park Addition to Battle Creek," and that it is an exact copy thereof and of the whole of such original map or plat.

Alfred L. Marshall
 State of Michigan,
 County of Calhoun,
 We, Harwell J. Kelley Register of Deeds, and Alfred L. Marshall Surveyor, hereby certify that we have each carefully compared the annexed copy with the plat of "Park Addition to Battle Creek" now of record in the office of said Register of Deeds, and that it is a true transcript therefrom and of the whole of such original map or plat.
Harwell J. Kelley
 Register of Deeds
Alfred L. Marshall
 Surveyor

VACATED BY RESOLUTION
 OF City Commission
 March 24, 1959
 VOUCHER NO. 216-52

VACATED BY RESOLUTION
 OF City Commission
 Jan 24, 1952
 VOUCHER NO. 406-52


VACATED BY RESOLUTION
 OF City Commission
 Sept 20, 1960
 VOUCHER NO. 601-60

13395

3863

3563

3563

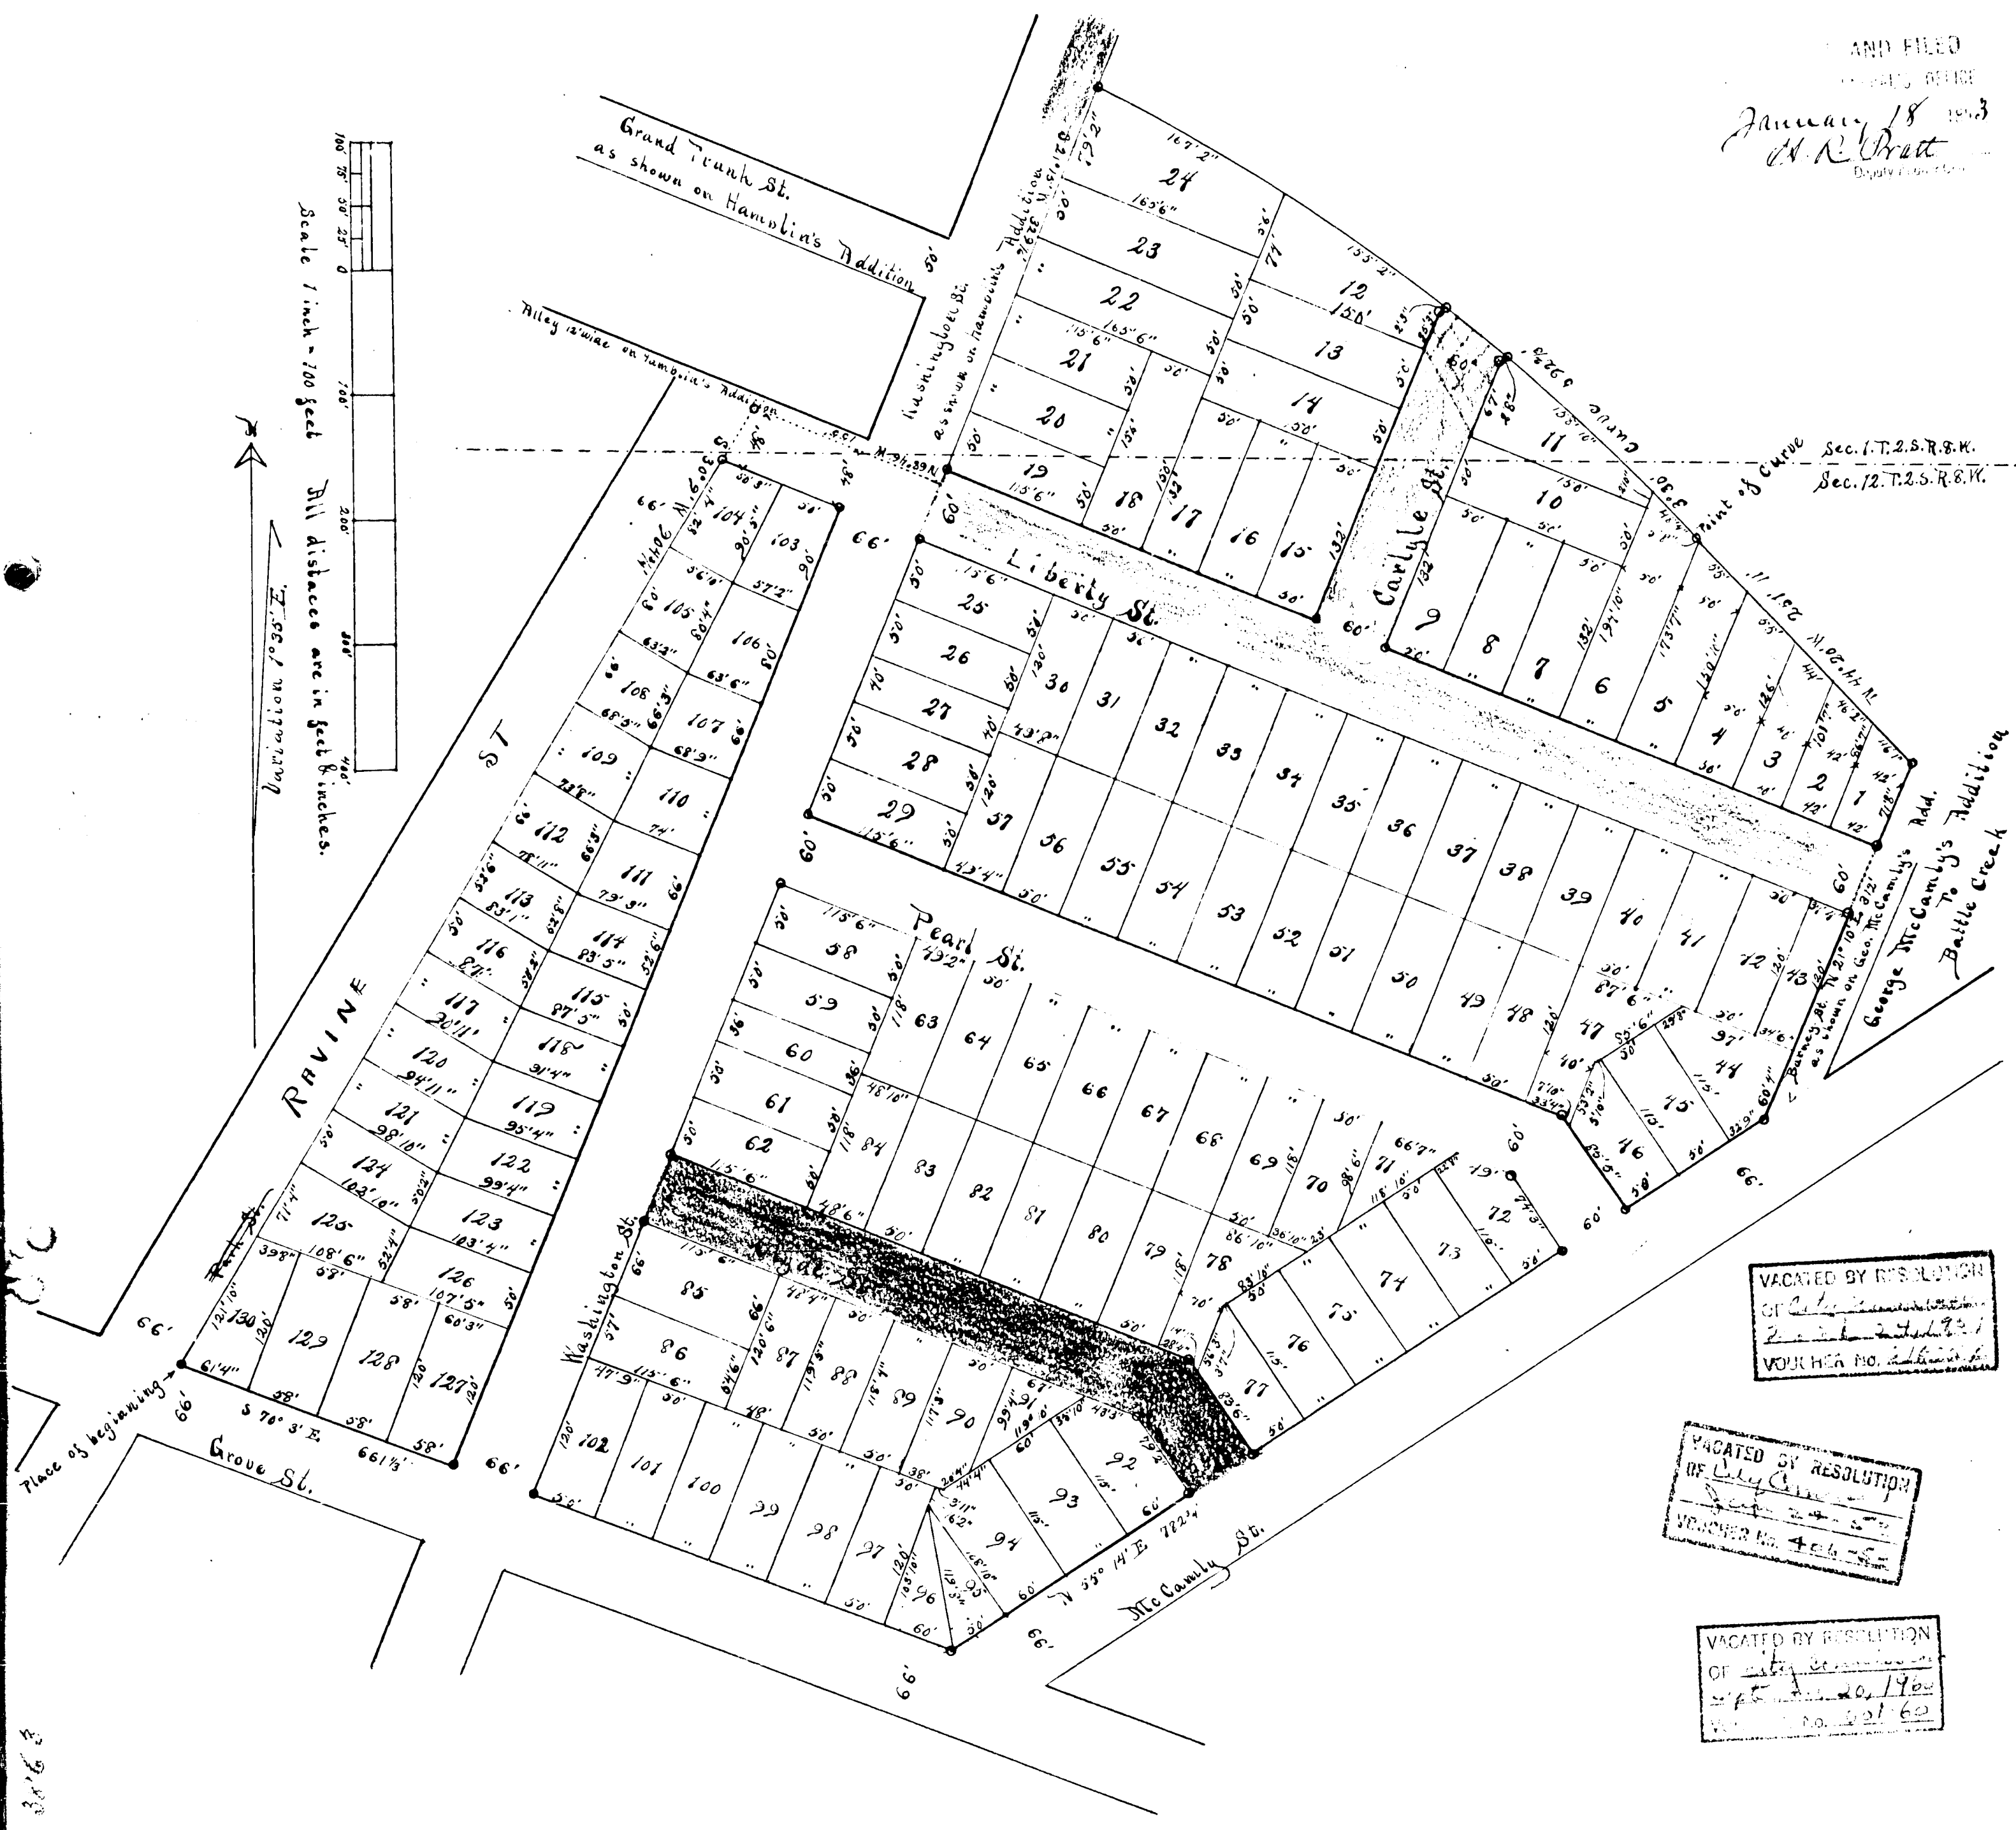

AND FILED
January 18 1893
H. R. Pratt
Deputy Auditor General

PARK + ADDITION TO BATTLE CREEK.

DEDICATION.

Know all Men by these Presents, That we, Archibald R. Henry, as proprietor, and Elizabeth E., his wife, have caused the land embraced in the annexed plat to be surveyed, laid out and platted, to be known as "Park Addition to Battle Creek," and that the streets as shown on said plat are hereby dedicated to the use of the public for highways.

Signed and sealed in presence of—
H. Lindsay, Archibald R. Henry [L. S.]
Alfred L. Marhoff, Elizabeth E. Henry [L. S.]

STATE OF MICHIGAN,
COUNTY OF CALHOUN.
On this 18th day of January, A. D. 1893, before me, a Notary Public in and for said county, personally appeared the above named Archibald R. Henry and Elizabeth E., his wife, known to me to be the persons who executed the above dedication, and acknowledged the same to be their free act and deed.
Notary Public, Calhoun County, Michigan

DESCRIPTION OF LAND PLATTED.

THE land embraced in the annexed plat of Park Addition to Battle Creek is described as follows: Being all that part of the south-west quarter of section 1, and the northwest quarter of section 12, town 2 south, range 8 west, Michigan: Beginning at the intersection of the easterly line of Park Street and the northerly line of Grove Street in the City of Battle Creek, having witness Maple 3 inches in diameter, north 69° 55' west 404 feet, also Maple 3 inches in diameter, north 25° 30' west 734 feet, running thence south 70° 3' east 601 1/2 feet to McCamly Street; thence north 55° 14' east 782 1/2 feet along the northwesterly line of said McCamly Street to the westerly line of George McCamly's Addition to Battle Creek, having witness Maple 3 inches in diameter, south 20° west 102 feet, 11 inches, also Maple 2 inches in diameter, south 36° 30' east 57 feet, 5 inches; thence north 21° 10' east 312 feet along the westerly line of said George McCamly's Addition; thence north 44° 20' west 251 feet, 11 inches; thence northwesterly on a 3° 30' curve to the left 592 feet to Washington Street and the previous course being tangent to said curve at the beginning of the curve; thence south 21° 15' west 329 1-6 feet along the easterly line of Washington Street; thence north 68° 46' west 155 feet to the easterly line of Park Street, having witness Maple 3 inches in diameter, south 58° 16' west 132 feet, 10 inches, also Elm 12 inches in diameter, north 51° 10' east 139 1/2 feet; thence south 30° 9' west 904 feet along the easterly line of Park Street to the place of beginning.

SURVEYOR'S CERTIFICATE.

I HEREBY CERTIFY, That the Plat hereon delineated is a correct one, and that permanent monuments, consisting of Gas Pipe, have been planted at points marked thus, as thereon shown at all angles in the boundaries of the land platted, and at all intersections of streets.
Alfred L. Marhoff, Surveyor

I Herby Certify, That this Plat was approved by the Common Council of the City of Battle Creek, on the nineteenth day of December, A. D. 1892.
C. R. Thompson, Mayor of the City of Battle Creek

Examined and approved January 13 1893. H. R. Pratt
Deputy Auditor General

Received for record this fourteenth day of January, A. D. 1893, at 11 o'clock A.M., and recorded in Liber B of Plats on page 4
Alfred L. Marhoff, Register of Deeds

STATE OF MICHIGAN,
COUNTY OF CALHOUN.
We, Howell J. Kelsey, Register of Deeds, and Alfred L. Marhoff, Surveyor, hereby certify that we have each carefully compared this copy with the original plat of "Park Addition to Battle Creek," and that it is an exact copy thereof and of the whole of such original map or plat.
Alfred L. Marhoff, Register of Deeds

State of Michigan, ss.
County of Calhoun.
We, Howell J. Kelsey, Register of Deeds, and Alfred L. Marhoff, Surveyor, hereby certify that we have each carefully compared the divided copy with the plat of "Park Addition to Battle Creek," now of record in the office of said Register of Deeds, and that it is a true transcript therefrom and of the whole of such record.
Alfred L. Marhoff, Surveyor

13395

3563