

# DESCRIPTION OF LAND PLATTED

The annexed plat of "PARK ST. MARY" is located on the southwest quarter of section 18 and the northwest quarter of section 19, Township 1 south of Range 7 west, in the County of Calhoun and State of Michigan and described as follows:— Beginning at a point in the west line of said township where the said line intersects the south shore of St. Marys lake (so called), said point being 155 feet south of the northwest corner of said section 19 and running thence south along the west line of said township 607 feet; thence north 89° 08' east, parallel with the north line of said section 19, 768 feet; thence north, parallel with said township line, 265 feet; thence north 89° 08' east, parallel with the north line of said section 19, 450 feet; thence north, parallel with said township line, 497 feet to the north line of said section 19; thence north 89° 08' east, along the north line of said section 19, 1041 feet to the west line of a highway as the same is occupied and to within 343 feet of the quarter post between said sections; thence north 6° 36' east, along said highway, 53.05 feet; thence north 0° 21' west, along said highway, 144.75 feet; thence north 10° 43' west, along said highway, 317.75 feet; thence north 8° 41' west, along said highway, 436.75 feet to the shore of said lake; thence in a southwesterly direction along the shore of said lake to the place of beginning.

## SURVEYOR'S CERTIFICATE.

I HEREBY CERTIFY, that the plat herein delineated is a correct one and that permanent monuments, consisting of iron pipe, have been planted at points marked • as thereon shown at all angles in the boundary of the land platted, and all intersections of streets, avenues and passage ways between lots.

*A. L. Marhoff*, SURVEYOR.

STREET VACATION  
Jan. 25 1937  
Voucher # 1331-37


## PARK ST. MARY

IN  
PENFIELD TOWNSHIP, CALHOUN CO.


STATE OF MICHIGAN.)  
COUNTY OF CALHOUN.)

*Edmund Jaskane* — Register of Deeds,  
and *A. L. Marhoff* surveyor, hereby certify that we have each carefully compared this copy with the original plat of "PARK ST. MARY" and that it is an exact copy thereof and of the whole of such original map or plat.

*Edmund Jaskane* — REGISTER OF DEEDS.  
— *A. L. Marhoff* — SURVEYOR.

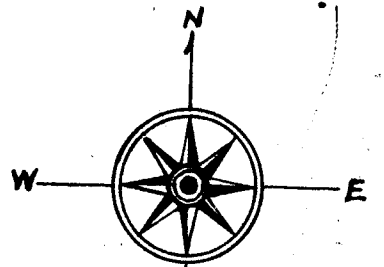

SCALE, 1 INCH = 120 FEET.

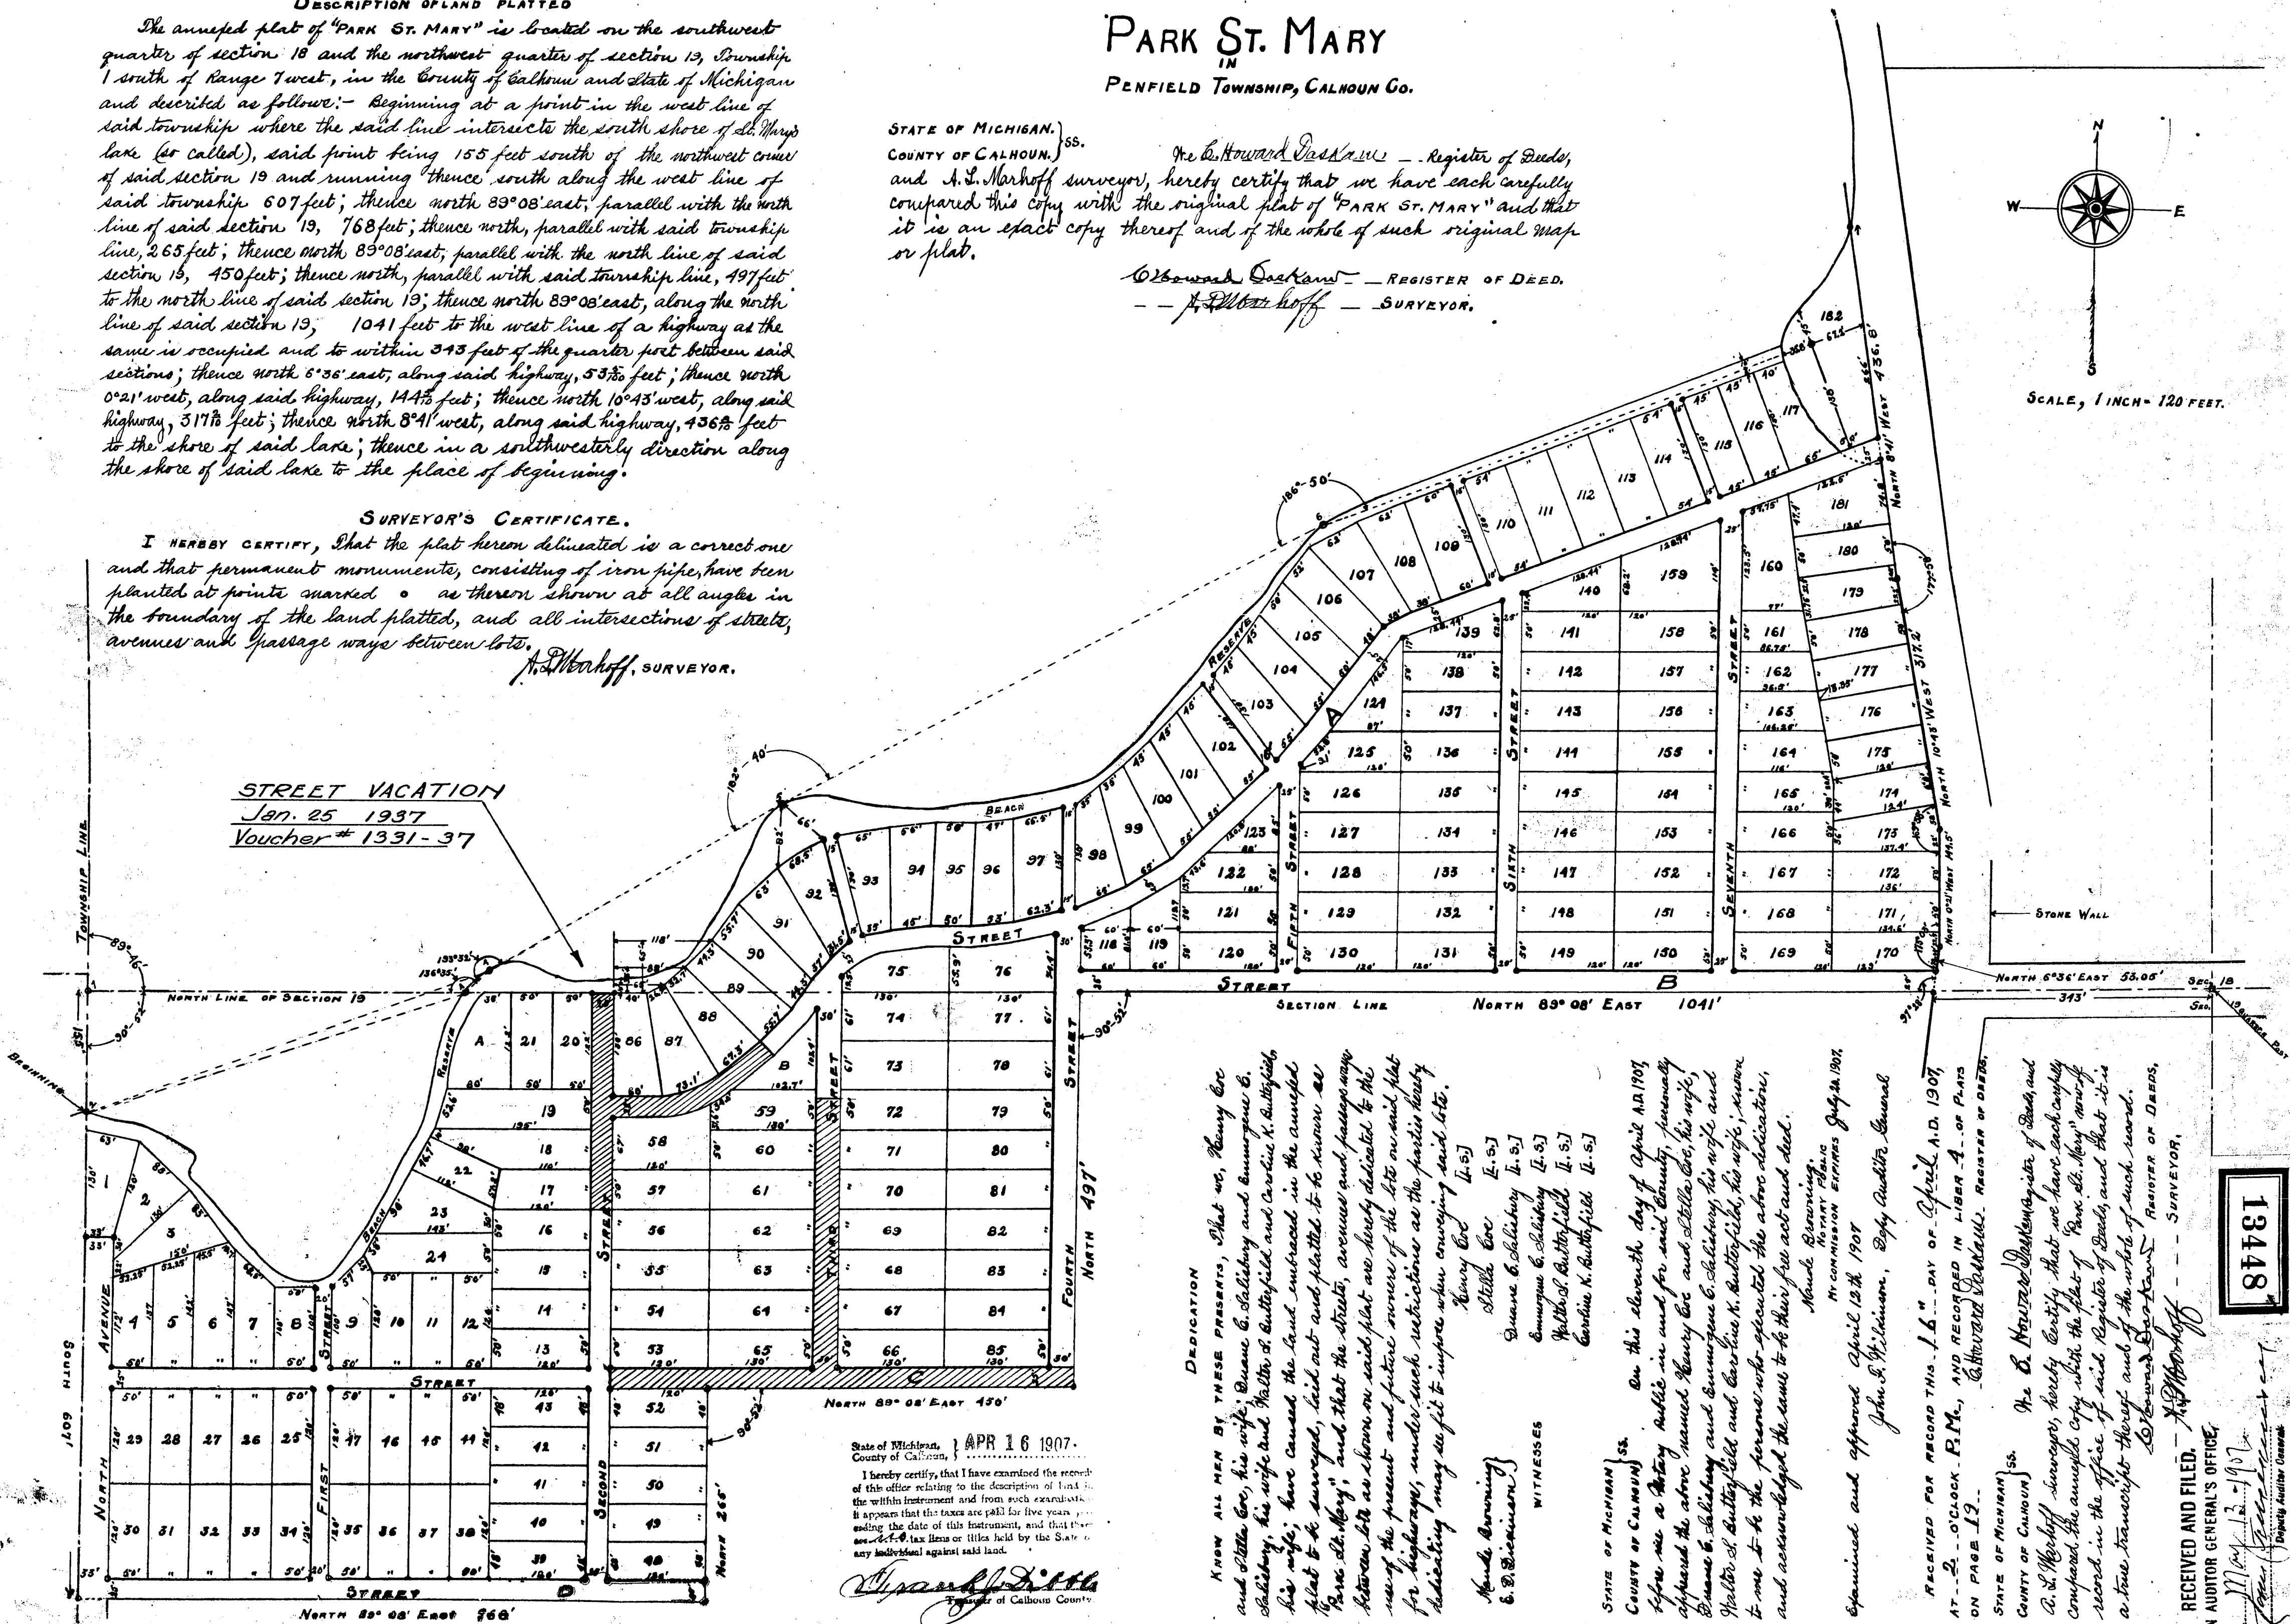

### DEDICATION

KNOW ALL MEN BY THESE PRESENTS, That we, Henry Eric and Stella Eric, his wife; Quane C. Salisbury and Eunorgue C. Salisbury, his wife and Walter St. Butterfield and Caroline K. Butterfield, his wife, have caused the land embraced in the annexed plat to be surveyed, laid out and platted to be known as "PARK ST. MARY", and that the streets, avenues and passage ways between lots as shown on said plat are hereby dedicated to the use of the present and future owners of the lots on said plat for highways, under such restrictions as the parties hereby dedicating may see fit to impose when conveying said lots.

*Henry Eric* [L.S.]  
*Stella Eric* [L.S.]  
*Quane C. Salisbury* [L.S.]  
*Eunorgue C. Salisbury* [L.S.]  
*Walter St. Butterfield* [L.S.]  
*Caroline K. Butterfield* [L.S.]

### WITNESSES

*Maude Browning* [L.S.]  
*Edmund Jaskane* [L.S.]  
*Quane C. Salisbury* [L.S.]  
*Eunorgue C. Salisbury* [L.S.]  
*Walter St. Butterfield* [L.S.]  
*Caroline K. Butterfield* [L.S.]

Examined and approved April 13th 1907  
*John S. McInnis*, Deputy Auditor General

RECEIVED FOR RECORD THIS 16th DAY OF April A.D. 1907  
AT 2 O'CLOCK P.M., AND RECORDED IN LIBER 4 OF PLATS  
ON PAGE 19.

STATE OF MICHIGAN.)  
COUNTY OF CALHOUN.)  
We, *Edmund Jaskane* Register of Deeds, and  
*A. L. Marhoff* Surveyor, hereby certify that we have each carefully compared the annexed copy with the plat of "PARK ST. MARY" now on record in the office of said Register of Deeds, and that it is a true transcript thereof and of the whole of such record.

*Edmund Jaskane* — REGISTER OF DEEDS,  
— *A. L. Marhoff* — SURVEYOR.

RECEIVED AND FILED.  
IN AUDITOR GENERAL'S OFFICE.  
May 13 1907  
*John S. McInnis*  
Deputy Auditor General

13448

The annexed plat of "PARK ST. MARY" is located on the southwest quarter of section 18 and the northwest quarter of section 19, Township 1 south of Range 7 west, in the County of Oakland and State of Michigan and described as follows:- Beginning at a point in the west line of said township where the said line intersects the south shore of said lake (so called); said point being 155 feet south of the northwest corner of said section 19 and running thence south along the west line of said township 607 feet; thence north  $30^{\circ}08'$  east, parallel with the north line of said section 19, 768 feet; thence north, parallel with said township line, 265 feet; thence north  $89^{\circ}08'$  east, parallel with the north line of said section 19, 450 feet; thence north, parallel with said township line, 497 feet to the north line of said section 19; thence north  $89^{\circ}08'$  east, along the north line of said section 19, 1041 feet to the west line of a highway as the same is occupied and to within 343 feet of the quarter post between said sections; thence north  $6^{\circ}36'$  east, along said highway,  $533\frac{1}{2}$  feet; thence north  $0^{\circ}21'$  west, along said highway,  $144\frac{1}{2}$  feet; thence north  $10^{\circ}43'$  west, along said highway,  $317\frac{1}{2}$  feet; thence north  $8^{\circ}41'$  west, along said highway,  $436\frac{1}{2}$  feet to the shore of said lake; thence in a southwesterly direction along the shore of said lake to the place of beginning.

PENFIELD TOWNSHIP, CALHOUN CO.


and A. L. Marhoff, surveyor, hereby certify that we have each carefully compared this copy with the original plat of "PARK ST. MARY" and that it is an exact copy thereof and of the whole of such original map or plat.

Edward Jackson - REGISTER OF DEED,  
- - J. H. H. - SURVEYOR.

I HEREBY CERTIFY, That the plat hereon delineated is a correct one and that permanent monuments, consisting of iron pipes, have been planted at points marked  $\bullet$  as thereon shown at all angles in the boundary of the land platted, and all intersections of streets, avenues and garbage ways between lots. Dill 11

*A. L. Werhoff*, SURVEYOR.

STREET VACATION  
Jan. 25 1937  
Voucher # 1331-37

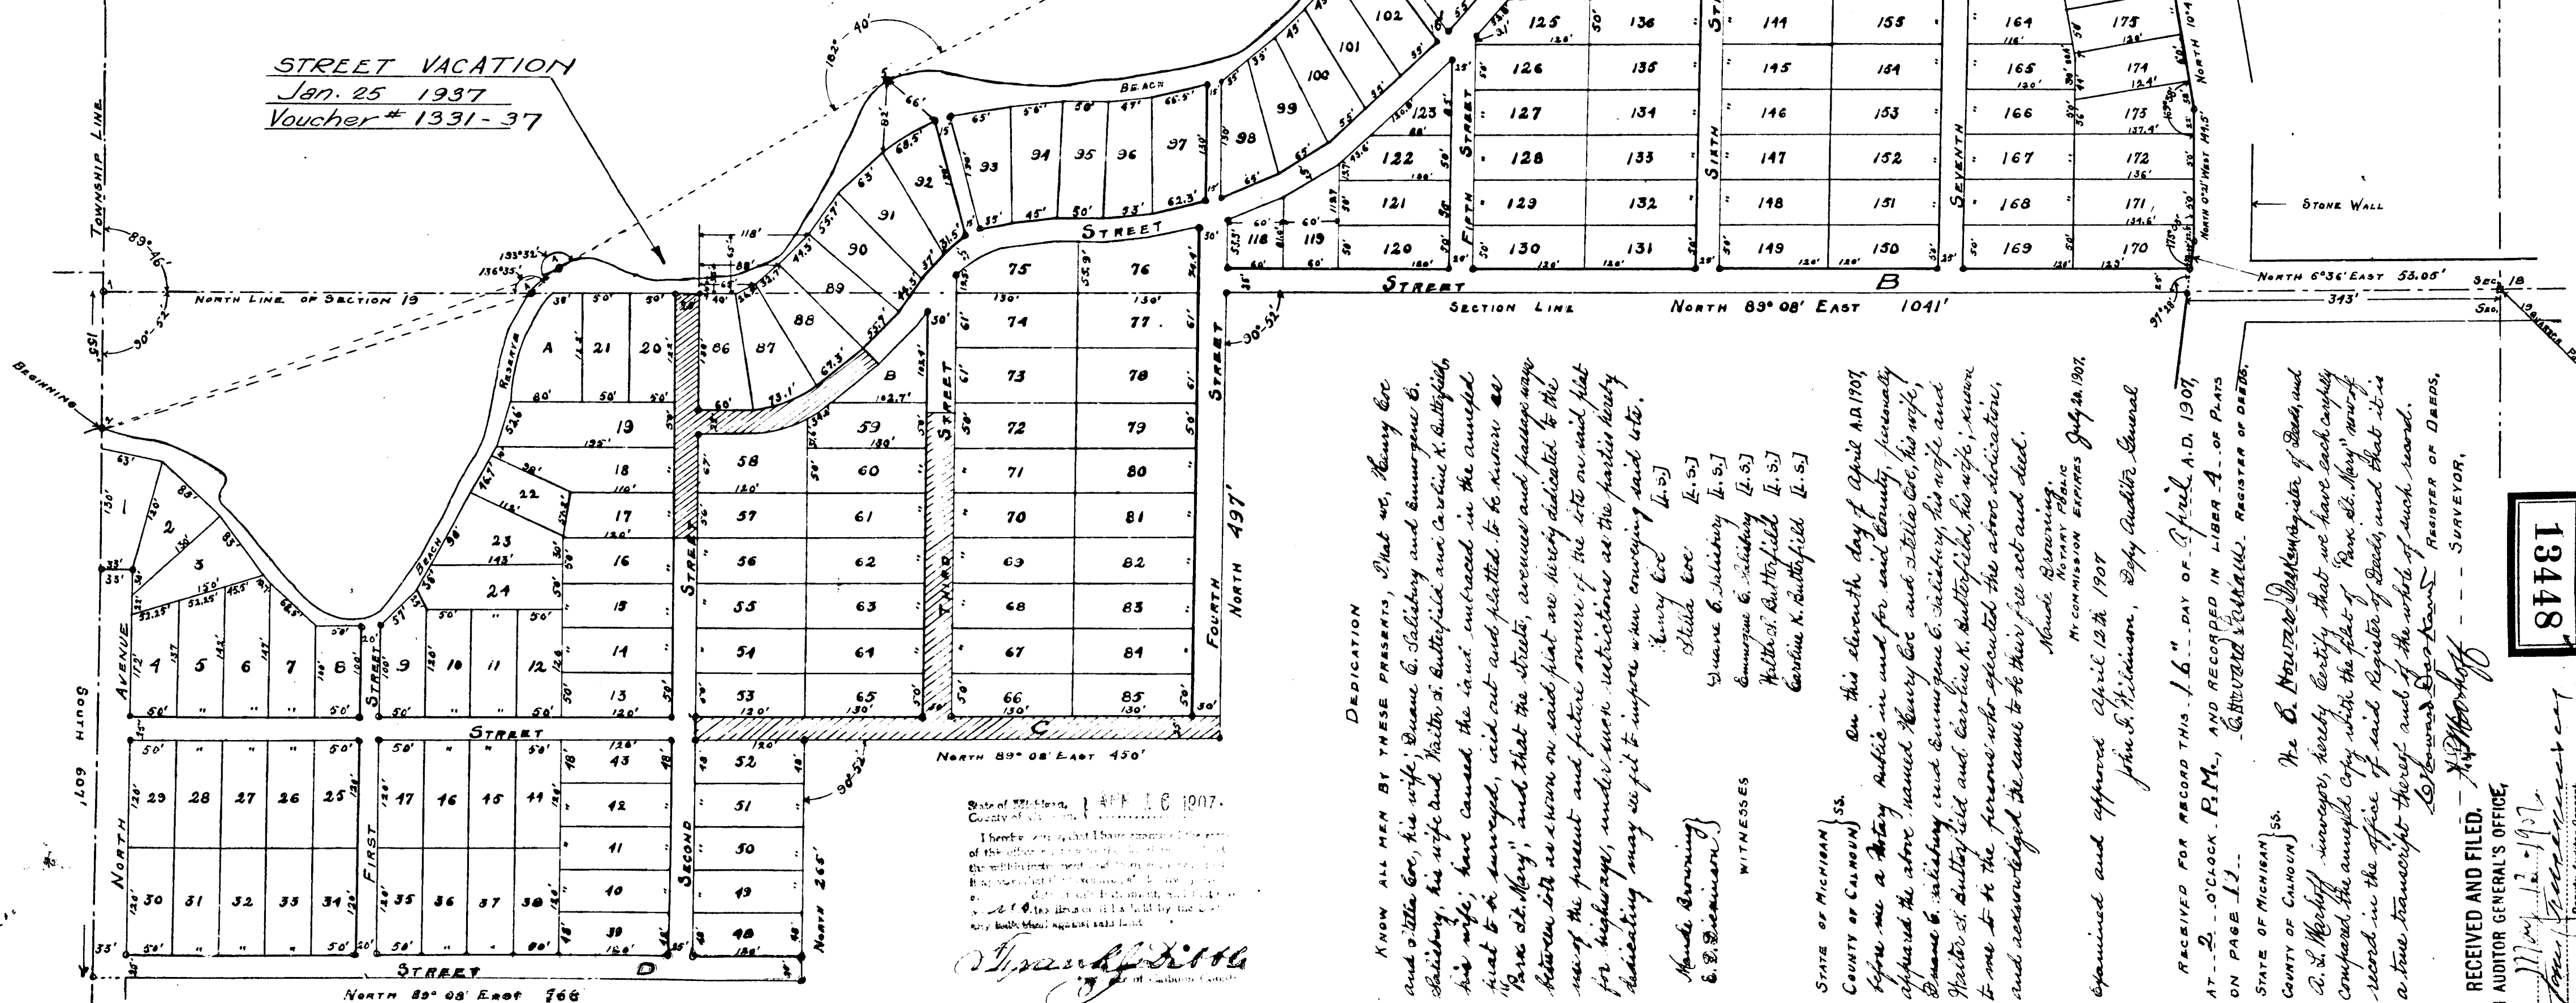

**DEDICATION**

KNOW ALL MEN BY THESE PRESENTS, That we, Henry Cor  
and O'Leary Cor, his wife, Duane C. Salisbury and Emergence C.  
Salisbury, his wife and Walter S. Butterfield and Caroline K. Butterfield,  
his wife; have caused the same to be entered in the amended  
plat to be surveyed, laid out and platted to be known as  
"Park St. Mary", and that the streets, avenues and passages were  
known into as shown on said plat are being dedicated to the  
use of the present and future owners of the lots on said plat  
for highways, under such restrictions as the parties hereby  
dedicating may see fit to impose when conveying said lots.

|                          |        |
|--------------------------|--------|
| Stella Cox               | [L.S.] |
| Suave C. Selinsky        | [L.S.] |
| Emmague C. Selinsky      | [L.S.] |
| Walter W. Butcherfield   | [L.S.] |
| Caroline K. Butcherfield | [L.S.] |

Maudie Browning }  
E. E. Dickinson }

WITNESSES

STATE OF MICHIGAN } SS.  
COUNTY OF CALHOUN )  
On this eleventh day of April A.D. 1908,  
before me a Notary Public in and for said County, personally  
appeared the above named Henry Coo and Stella Coo, his wife,  
Diane C. Sutterly and Emma Jane C. Sutterly, his wife, and  
Hector S. Sutterly and Carl Lee K. Sutterly, his wife, and  
to me to be the persons who executed the above declaration,  
and acknowledged the same to be their free act and deed.

Naude Browning,  
NOTARY PUBLIC  
MY COMMISSION EXPIRES July 28, 1907.

Wood April 12th 1907  
John F. Wilkinson, Deputy Auditor General

RECEIVED FOR RECORD THIS 16<sup>th</sup> DAY OF April A.D. 1901,  
AT 2 O'CLOCK P.M., AND RECORDED IN LIBER 4 OF PLATS  
ON PAGE 13. <sup>CONTAINED THEREIN.</sup> REGISTER OF DEEDS.

STATE OF MICHIGAN } SS.  
COUNTY OF CUMING }  
We C. S. Morsell & Deshaun Morsell of Deeds, and  
C. S. Morsell, surveyors, hereby certify that we have each copy  
compared the annexed copy with the plat of "Park St. Mary" now  
recorded in the office of said Register of Deeds, and that it is  
a true transcript thereof and of the whole of such record.

RECEIVED AND FILED  
-- *X. D. Marshall* -- REGISTER OF SURVEYOR,  
*Edward Hartman*

RECEIVED AND FILED.  
AUDITOR GENERAL'S OFFICE

*[Signature]*