

The Jennings Land Company's

First Addition To Battle Creek,

In Bedford Township, Calhoun County, Michigan.

HARLAN K. WHITNEY, Civil Engineer

DEDICATION


KNOW ALL MEN BY THESE PRESENTS, That THE JENNINGS LAND COMPANY, a Corporation organized and existing under the laws of the State of Michigan, with principal office in Battle Creek, Michigan, as proprietor, and EDWIN B. JENNINGS, now the holder of the title in fee of the premises by deed in the nature of a mortgage, have caused the land embraced in the annexed plat to be surveyed, laid out and platted, to be known as "THE JENNINGS LAND COMPANY'S FIRST ADDITION TO BATTLE CREEK," and that the Street and Alley as shown on said plat, are hereby dedicated to the use of the public.

IN WITNESS WHEREOF, The said The Jennings Land Company, has caused these Presents to be executed for it and in its name by its President, attested by its Secretary, and has caused its corporate seal to be hereunto affixed, and said Edwin B. Jennings has hereunto set his hand and seal this 30th day of December, A. D. 1911.

THE JENNINGS LAND COMPANY.

ATTEST:

.....*Martin P. Hingak*.....
Secretary
Signed, sealed and delivered in presence of
.....*William P. Jennings*.....
.....*Harlan K. Whitney*.....

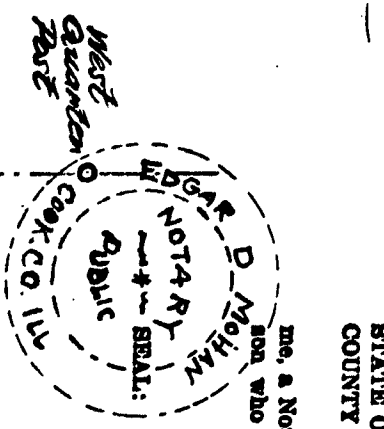

STATE OF ILLINOIS, }
COUNTY OF COOK, } ss.
On this 30th day of December, A. D. 1911, before me, a Notary Public in and for said County, personally appeared EDWIN B. JENNINGS, to me known to be the person who joined in the execution of the above dedication, and acknowledged the same to be his free act and deed.

.....*Edwin B. Jennings*.....
Notary Public, Cook County, Illinois
My commission expires, Jan. 12, 1913.

Examined and Approved

JAN 24 1912

.....*Harlan K. Whitney*.....
Deputy Auditor General.

STATE OF ILLINOIS,
COUNTY OF COOK,
I, *Harlan K. Whitney*, a Notary Public in and for said County, in the State aforesaid, do hereby certify that *Edwin B. Jennings*, the President, and *Martin P. Hingak*, the Secretary of The Jennings Land Company (a Michigan corporation) both known to me to be the genuine persons who have subscribed their names to the foregoing instrument, as such President and Secretary, respectively, appeared before me this day in person and set the name of said Company as their free and voluntary act and deed, and the free and voluntary act of said The Jennings Land Company.

.....*Edwin B. Jennings*.....
.....*Martin P. Hingak*.....
Notary Public, Cook County, Illinois
My commission expires, Jan. 12, 1913.

DESCRIPTION OF LAND PLATTED

The land embraced in the annexed plat of "The Jennings Land Company's First Addition to Battle Creek," is all of that part of the Southwest Quarter of Section 35 of Bedford Township (T. 1 S. R. 8 W.) Calhoun County, Michigan, described as follows, to-wit:

Beginning on the center line of the Battle Creek and Augusta Highway (known as Main Street West, and hereinafter known as "The Battle Creek and Hastings Plank Road"), at a point "A", distant 132 feet S. 51° 11' E. from the point of intersection of said center line with the West line of said Section, 157 1/2 feet South of the West Quarter Post thereof, the angle of said intersection being 50° 11';

Running thence along center line of said Highway S. 51° 11' E. 313.4 feet to angle at "B";

Thence along the center line of said Highway S. 35° 08' E. 314.9 feet to a point, "C", distant 106.3 feet N. 36° 08' W. along center line of said Highway from an iron stake at the intersection of same with the "Decker-Cory Line" (so-called);

Thence at right angles, S. 53° 51' W., 154 feet to "D";

Thence N. 51° 11' W., 106.6 feet to "E", 60 feet distant easterly from said west line of said Section;

Thence N. 1° W., parallel with said Section Line 106.25 feet to "F";

Thence N. 17° 37' E., 162.5 feet to the Place of Beginning.

All Bearings Magnetic, April, 1907. Probable Magnetic Variation, N. 40' E.

WITNESSES TO MONUMENTS

"A"—The Southerly corner of Cobblestone Plaza, 4 feet square at base (Southeasterly part of Pergola), N. 21° E., 34.25 feet distant;

also the Southerly corner of a similar Stone Pillar (Northwesterly part of Pergola), N. 25° W., 71.7 feet;

"B"—Gage of Southerly Rail of Interurban Railway Track, Northeasterly 10 feet; also 20-inch Elm, N. 25° W., 71.7 feet;

Northwesterly 371.7 feet; also 8-inch Red Cedar, Easterly 120.3 feet;

"C"—6-inch Dwarf Cedar, S. 13° 11' W., 53.2 feet distant; 12-inch Elm, S. 44° E., 133.5 feet; also gage of South Rail of Interurban Railway Track, Northeasterly, 13.4 feet;

"D"—24-inch Apple tree, N. 59° 50' E., 72 feet; also 12-inch Maple, S. 73° 48' E., 74.3 feet;

"E"—13-inch Cherry, S. 51° W., 61.4 feet; also 13-inch Box Elder, S. 39° 40' W., 71.7 feet;

"F"—20-inch Willow, N. 40° W., 74 feet; also 6-inch Maple, S. 65° W., 54.3 feet.

SURVEYORS' CERTIFICATE

WE HEREBY CERTIFY, That the Plat herein delineated, is a correct one, and that permanent monuments have been placed as thereon shown, at all angles in the boundaries of the land platted, and at all intersections of streets and alleys; the same consisting of iron pipe stakes about 3 feet long and one inch in diameter, at all points marked thereon.

.....*William P. Jennings*.....
Surveyor
.....*Harlan K. Whitney*.....
Civil Engineer

TOWNSHIP CLERK'S CERTIFICATE

I HEREBY CERTIFY, That this Plat was approved by the Township Board of Bedford Township, on the first day of December, 1911.

.....*Harlan K. Whitney*.....
Township Clerk of Bedford Township,
Calhoun County, Michigan

COUNTY TREASURER'S TAX CERTIFICATE

STATE OF MICHIGAN,
COUNTY OF CALHOUN,
On this 11th day of January, A. D. 1912, I hereby certify that there are NO tax liens or titles held by the State on the lands described in the within instrument, and that there are no tax liens or titles held by individuals on said lands for the five years preceding the date of said instrument, and that the taxes for the said period of five years are paid as shown by the records of this office.

.....*Harlan K. Whitney*.....
Treasurer of Calhoun County.

RECORDING OFFICE,
COUNTY OF CALHOUN,
FILED BY
.....*William P. Jennings*.....
JAN 24 1912
ON PLAT OF
.....*Harlan K. Whitney*.....
JAN 24 1912
ORIGINAL ON FILE



Filed in Auditor General's Dep't
JAN 26 1912

.....*Harlan K. Whitney*.....
Deputy Auditor General.

I hereby certify that this copy is a true copy of the MAP or PLAT forwarded to the Register of Deeds for recording.

JAN 24 1912
.....*Harlan K. Whitney*.....
Deputy Auditor General.

VACATED BY RESOLUTION
OF CL. D. Commission
FEBRUARY 18-1912
VOUCHER NO. 178-58

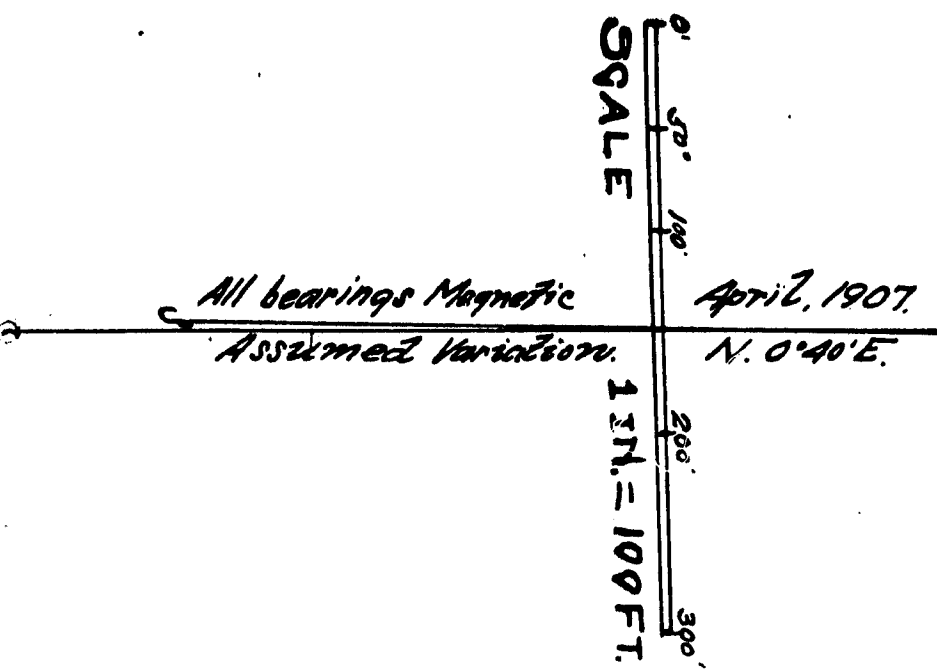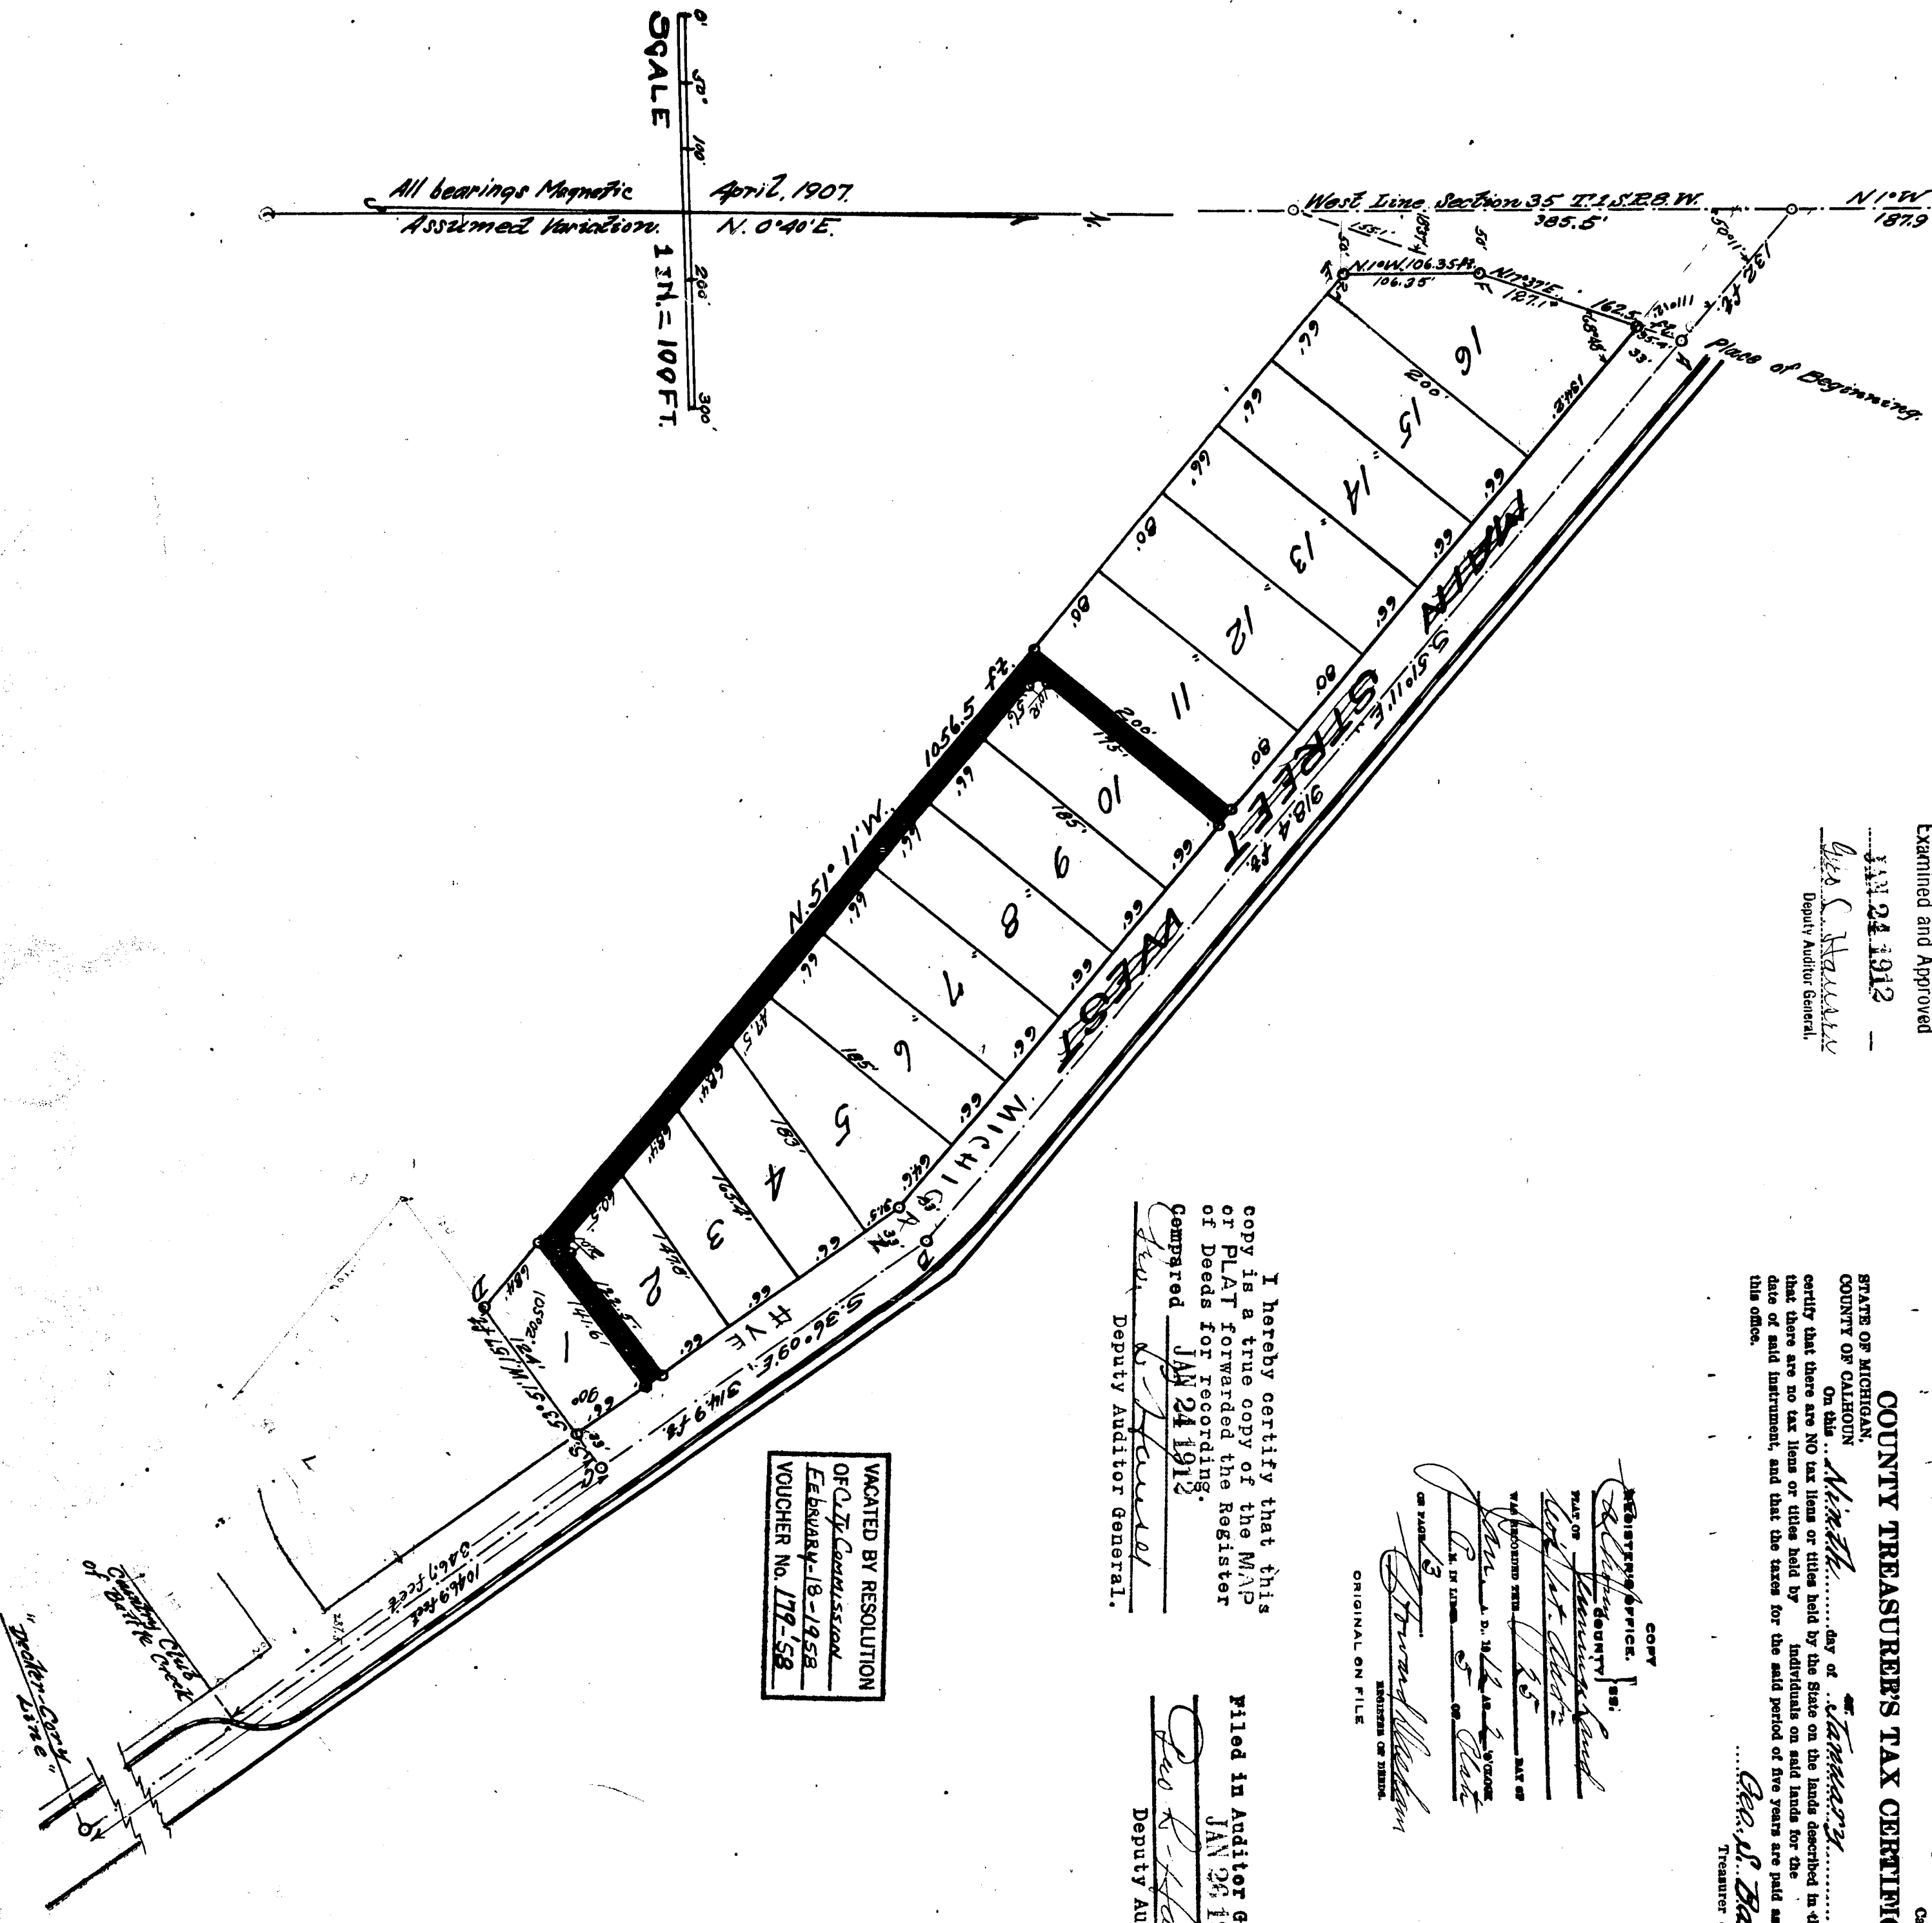

The Jennings Land Company's

First Addition To Battle Creek,

In Bedford Township, Calhoun County, Michigan.

HARLAN K. WHITNEY, Civil Engineer

DEDICATION

KNOW ALL MEN BY THESE PRESENTS, That THE JENNINGS LAND COMPANY, a Corporation organized and existing under the laws of the State of Michigan, with principal office in Battle Creek, Michigan, as proprietor, and EDWIN B. JENNINGS, now the holder of the title in fee of the premises by deed in the nature of a mortgage, have caused the land embraced in the annexed plat to be surveyed, laid out and platted, to be known as "THE JENNINGS LAND COMPANY'S FIRST ADDITION TO BATTLE CREEK" and that the Street and Alleys as shown on said plat, are hereby dedicated to the use of the public.

IT IS WITNESSED WHEREOF, The said The Jennings Land Company, has caused these Presents to be executed for it and in its name by its President, attested by its Secretary, and has caused its corporate seal to be hereunto attached, and said Edwin B. Jennings has hereunto set his hand and seal this 4th day of April, A. D. 1911.

THE JENNINGS LAND COMPANY.

ATTEST:

Marion P. Haggate
Secretary

Edwin B. Jennings
President

STATE OF ILLINOIS,
COUNTY OF COOK.

On this 30th day of December, A. D. 1911, before me, a Notary Public in and for said County, personally appeared EDWIN B. JENNINGS, to me known to be the person who joined in the execution of the above dedication, and acknowledged the same to be his free act and deed.

Edwin B. Jennings
Notary Public, Cook County, Illinois
My commission expires Jan. 12, 1913.

Examined and Approved
Jan 21 1912
Luc C. H. T. T. T.
Deputy Auditor General.

STATE OF ILLINOIS,
COUNTY OF COOK.

W. B. B. B. B.
Notary Public in and for said County, in the State of Illinois, do hereby certify that Edwin B. Jennings, the President, and Marion P. Haggate, the Secretary of The Jennings Land Company (a Michigan corporation) both known to me to be the same persons who have subscribed their names to the foregoing instrument, as such President and Secretary, respectively, appeared before me this day, in person and severally acknowledged the said instrument, as President and Secretary, as aforesaid, for and in the name of said Company, as their free and voluntary act and the free and voluntary act of said The Jennings Land Company.

Given under my hand and notarial seal, this 30th day of December, A. D. 1911.
W. B. B. B. B.
Notary Public, Cook County, Illinois
My commission expires Dec 30, 1913

DESCRIPTION OF LAND PLATED

The land embraced in the annexed plat of "The Jennings Land Company's First Addition to Battle Creek" is all of that part of the Southwest Quarter of Section 35 of Bedford Township (T. 1. S. R. 8 W.) Calhoun County, Michigan, described as follows, to-wit:

Beginning on the center line of the Battle Creek and Augusta Highway (known as Main Street West, and hereinafter known as "The Battle Creek and Hastings Plank Road"), at a point "A", distant 132 feet S. 61° 11' E. from the point of intersection of said center line with the West line of said Section, 187.9 feet South of the West Quarter Post thereof, the angle of said intersection being 60° 11';

Running thence along center line of said Highway S. 61° 11' E. 318.4 feet to angle at "B";

Thence along the center line of said Highway from an iron stake at the intersection of same with the "Decker-Covey Line" (so-called);

Thence at right angles, S. 63° 51' W., 157 feet to "C";

Thence N. 1° W., 106.55 feet to "D", 59 feet distant Easterly from said west line of said Section;

Thence N. 1° W., parallel with said Section Line, 106.35 feet to "E";

Thence N. 17° 37' E., 162.5 feet to the Place of Beginning.

All Bearings Magnetic, April, 1907. Probable Magnetic Variation, N. 40'E.

WITNESSES TO MONUMENTS

"A"—The Southern corner of Cobblestone Pile, 4 feet square at base (Southeasterly part of Pergola), N. 21° E., 34.25 feet distant;

also 8-inch Red Cedar, 13° 11' W., 59.2 feet distant;

"B"—Gauge of Southerly Rail of Interurban Railway Track, Northeasterly 10 feet; also 20-inch Elm, Northeasterly 317 feet;

also 8-inch Red Cedar, S. 13° 11' W., 59.2 feet distant;

"C"—Gauge of South Rail of Interurban Railway Track, Northeasterly 124 feet;

also 12-inch Maple, S. 73° 45' E., 74.5 feet;

"D"—14-inch Apple tree, N. 69° 50' E., 72 feet; also 13-inch Box Elder, S. 39° 40' W., 71.7 feet;

"E"—12-inch Cherry, S. 51° W., 61.4 feet; also 6-inch Maple, S. 65° W., 54.2 feet;

"F"—20-inch Willow, N. 40° W., 74 feet;

SURVEYORS' CERTIFICATE

WE HEREBY CERTIFY, That the Plat hereon delineated, is a correct one, and that permanent monuments have been planted as thereon shown, at all angles in the boundaries of the land platted, and at all intersections of streets and alleys, the same consisting of Iron Pipe stakes about 2 feet long and one inch in diameter, at all points marked them on the plat.

William H. Chace
Surveyor

William H. Chace
Civil Engineer

TOWNSHIP CLERK'S CERTIFICATE

I HEREBY CERTIFY, That this Plat was approved by the Township Board of Bedford Township, on the first day of December, 1911.

J. E. Stedley
Township Clerk of Bedford Township,
Calhoun County, Michigan

COUNTY TREASURER'S TAX CERTIFICATE

STATE OF MICHIGAN,
COUNTY OF CALHOUN.
On this Ninth day of January, A. D. 1912, I hereby certify that there are NO tax liens or titles held by the State on the lands described in the within instrument, and that there are no tax liens or titles held by individuals on said lands for the five years preceding the date of said instrument, and that the taxes for the said period of five years are paid as shown by the records of this office.

Geo. S. Barnes
Treasurer of Calhoun County.

COPIES
RECORDED OFFICE.
FILED BY
W. B. B. B. B.
RECORDED
ON FILE
ORIGINAL ON FILE

I hereby certify that this copy is a true copy of the map or PLAT forwarded the Register of Deeds for recording.
Jan 21 1912
Compared
Jan 21 1912
Deputy Auditor General.

Filed in Auditor General's Dept.
Jan 21 1912
Geo. S. Barnes
Deputy Auditor General.

VACATED BY RESOLUTION
OF CO. CL. COMMISSION
FEBRUARY 15-1912
VOUCHER No. 172-58

