


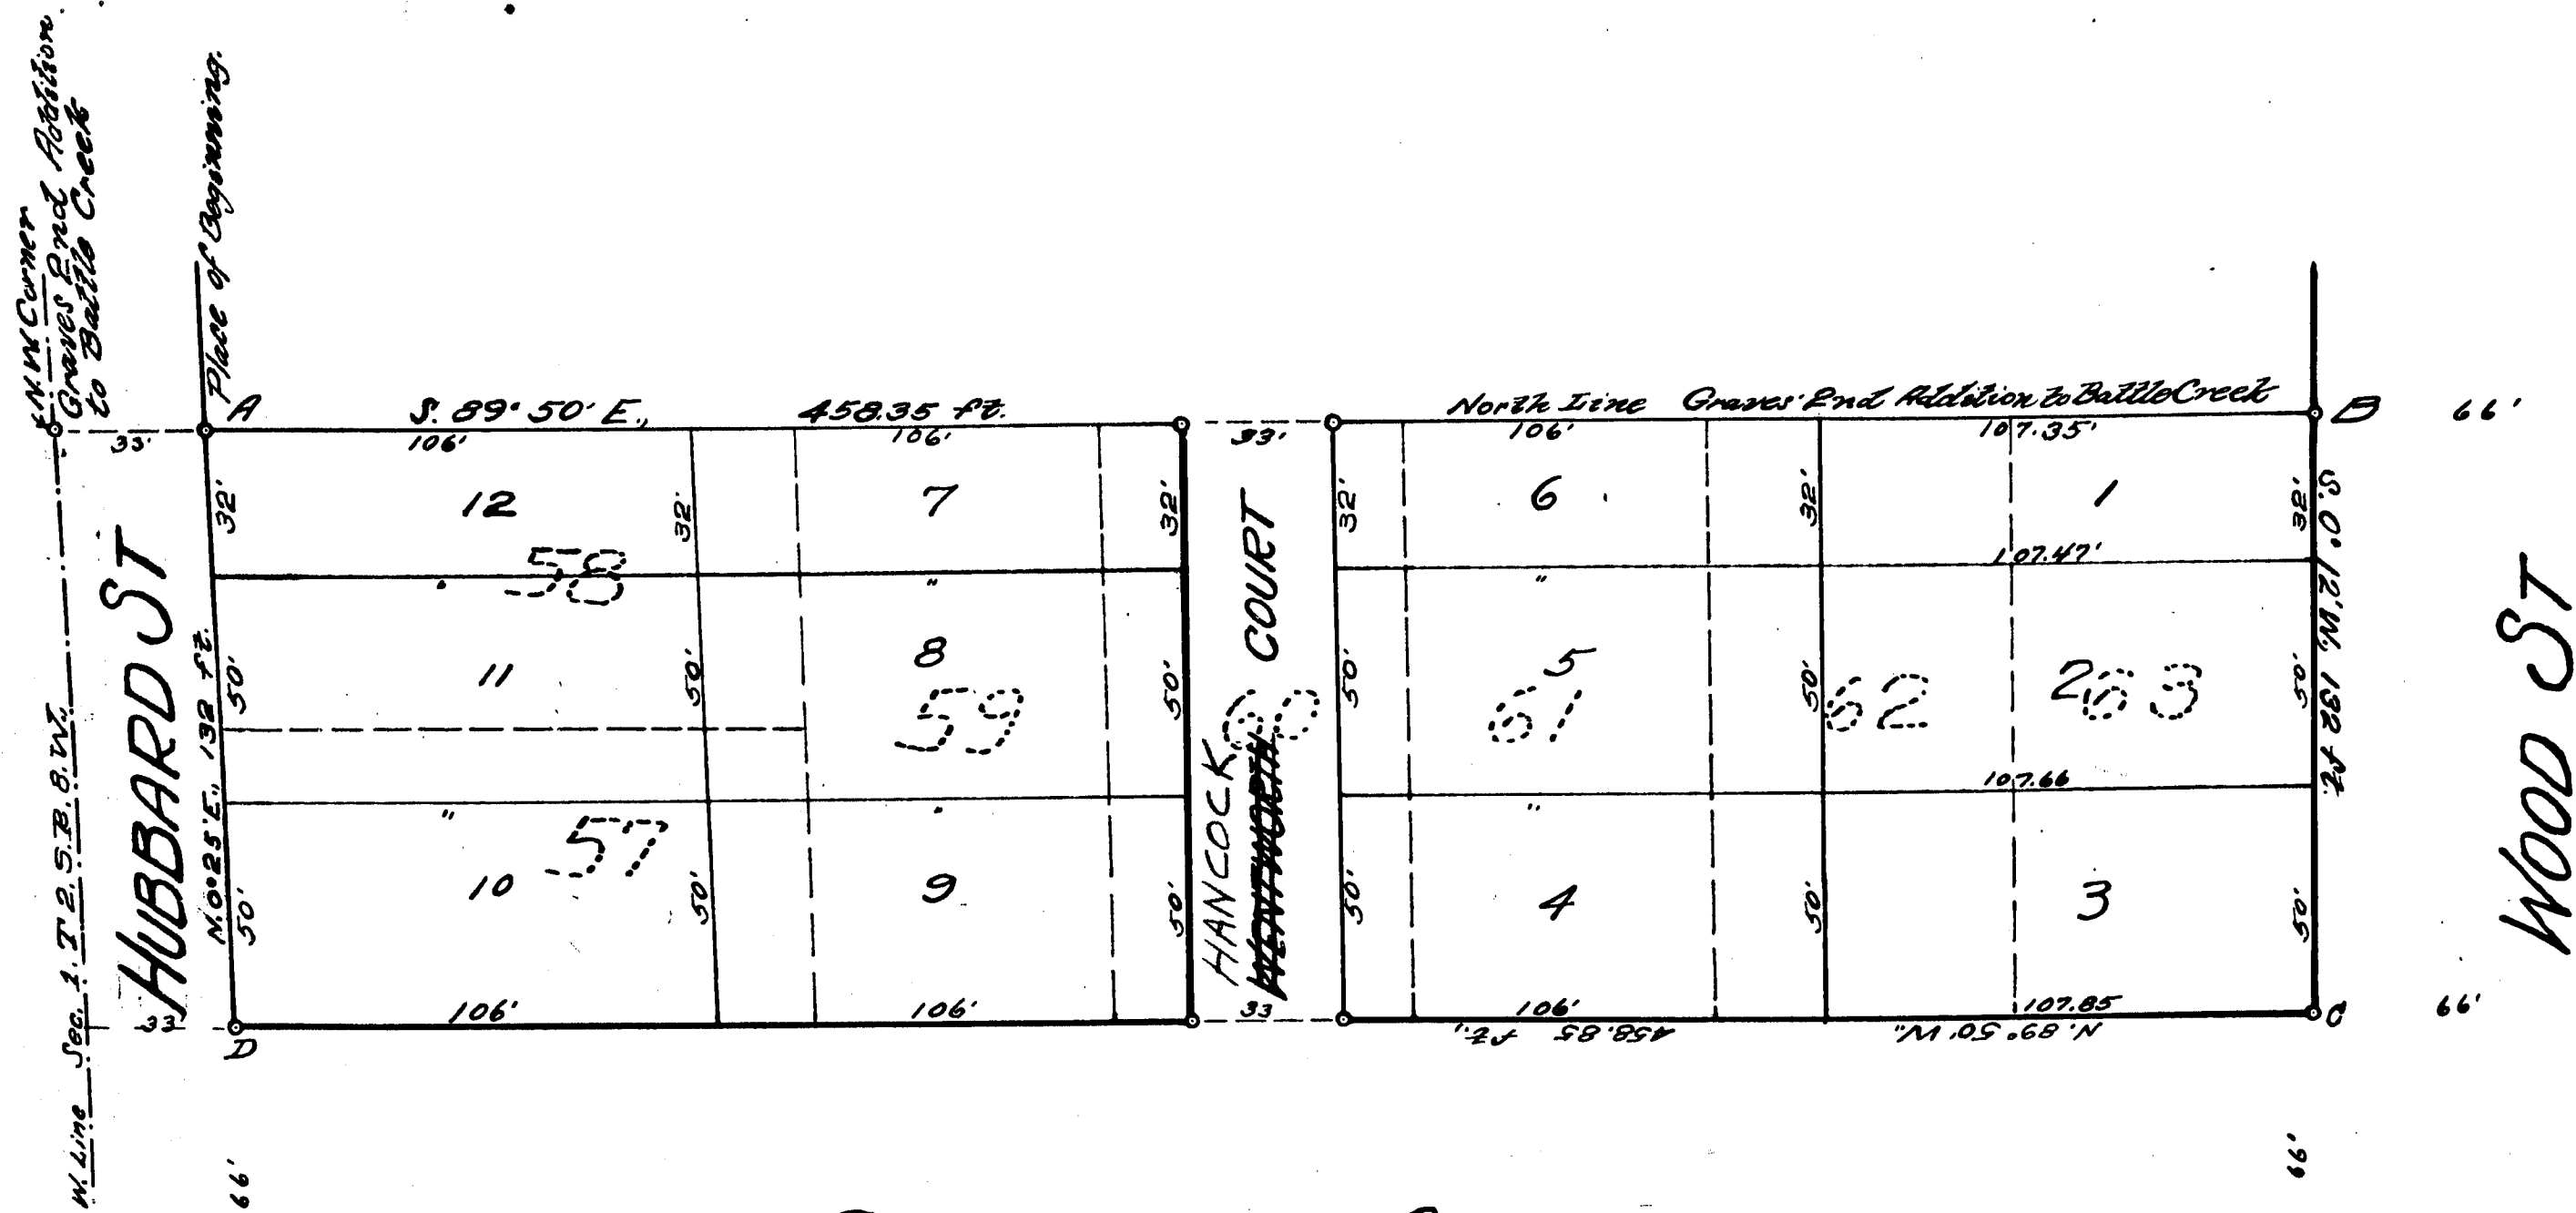

The Homeland Company's Sub-division of a Part of Graves' 2nd Addition to Battle Creek

In the City of Battle Creek, Calhoun County, Michigan

HARLAN K. WHITNEY, Civil Engineer

DEDICATION

KNOW ALL MEN BY THESE PRESENTS, That Benton N. Colver and Agnes K. Colver, his wife, as proprietors, of the City of Battle Creek, Calhoun County, Michigan, have caused the land embraced in the annexed plat, to be surveyed, laid out and platted, to be known as "THE HOMELAND COMPANY'S SUBDIVISION OF A PART OF GRAVES' 2nd ADDITION TO BATTLE CREEK", and that the Court as shown on said plat is hereby dedicated to the use of the public.

Signed and sealed in presence of:

D.C. Kirkland Benton N. Colver [L.S.]
Grace Risher Agnes K. Colver [L.S.]

STATE OF MICHIGAN,
COUNTY OF CALHOUN

On this 12th day of April, A. D. 1912, before me, a Notary Public in and for said County, personally appeared the above named Benton N. Colver and Agnes K. Colver, his wife, known to me to be the persons who executed the above dedication, and severally acknowledged the same to be their free act and deed.

Ingram W. Shram
Notary Public, Calhoun County, Michigan
My Commission expires April 1912

DESCRIPTION OF LAND PLATTED

The land embraced in the annexed plat of "The Homeland Company's Subdivision of a part of Graves' 2nd Addition to Battle Creek," is all that part of the northwest quarter of section 1, T. 2 S., R. 3 W., Calhoun County, Michigan, described as follows, to-wit:
Lots 57-58-59-60-61-62 and 63 of the recorded plat of "Graves' 2nd Addition to Battle Creek", more particularly described as follows:
Beginning at the northwest corner of lot 58 of said addition ("A") 33 feet east of the west line of said section;
Running thence S. 89° 50' E. along the north line of said addition 458.35 feet to "B", on the west line of Wood Street;
Thence S. 0° 12' W. 132 feet to "C", the northwest corner of Greenwood Avenue and Wood Street;
Thence N. 89° 50' W. along the north line of Greenwood Avenue 458.85 feet to "D", the northeast corner of Hubbard Street and Greenwood Avenue;
Thence N. 0° 25' E., 132 feet to the place of beginning.
All bearings assumed true meridian. Magnetic variation, N. 0° 25' E.

SURVEYORS' CERTIFICATE

WE HEREBY CERTIFY, That the Plat hereon delineated, is a correct one, and that permanent monuments have been planted as thereon shown, at all angles in the boundaries of the land platted, and at all intersections of streets and avenues, the same consisting of Iron Pipe Stakes, about 2 feet long and about one inch in diameter, at all points marked thus, o

RECORDER'S CERTIFICATE

I HEREBY CERTIFY, That this Plat was approved by the Common Council, of the City of Battle Creek, on the 22nd day of April, 1912.

CITY TREASURER'S TAX CERTIFICATE


STATE OF MICHIGAN,
COUNTY OF CALHOUN,
CITY OF BATTLE CREEK
On this 25th day of April, A. D. 1912, I hereby certify that there are NO tax liens or titles held by the city of Battle Creek, or by individuals on the lands described in the within instrument, for the five years preceding the date of said instrument, and that the taxes for the said period of five years are paid, as shown by the records of this office.

COUNTY TREASURER'S TAX CERTIFICATE

STATE OF MICHIGAN,
COUNTY OF CALHOUN,
On this 25th day of April, A. D. 1912, I hereby certify that there are NO tax liens or titles held by the State on the lands described in the within instrument, and that there are NO tax liens or titles held by individuals on said lands for the five years preceding the date of said instrument, and that the taxes for the said period of five years are paid, as shown by the records of this office.

GREENWOOD AVENUE

Scale 40 Ft. = 1 in.

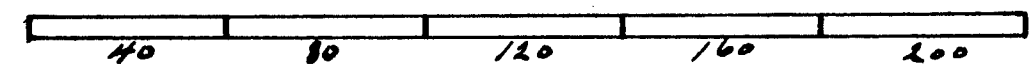

Examined and Approved
MAY 4-1912

Geo. S. Hansen
Deputy Auditor General.


Name change
VOTED BY RESOLUTION
OF CO. RD. Comm
June 29 1912
VOUCHER No. 6462-1

COPY
REGISTER'S OFFICE
Calhoun County, ss.
PLAT OF Homeland Co.
Sub-
WAS RECORDED THIS 7 DAY OF
May A. D. 1912 AT 4 O'CLOCK
P. M. IN LIBRY OF
Plats
RECORDED BY
T. Howard Washburn
ORIGINAL ON FILE

I hereby certify that this copy is a true copy of the MAP or PLAT forwarded the Register of Deeds for recording.
Compared MAY 6-1912
Geo. S. Hansen
Deputy Auditor General.

Filed in Auditor General's Dep't
MAY 10 1912
Geo. S. Hansen
Deputy Auditor General.

13495

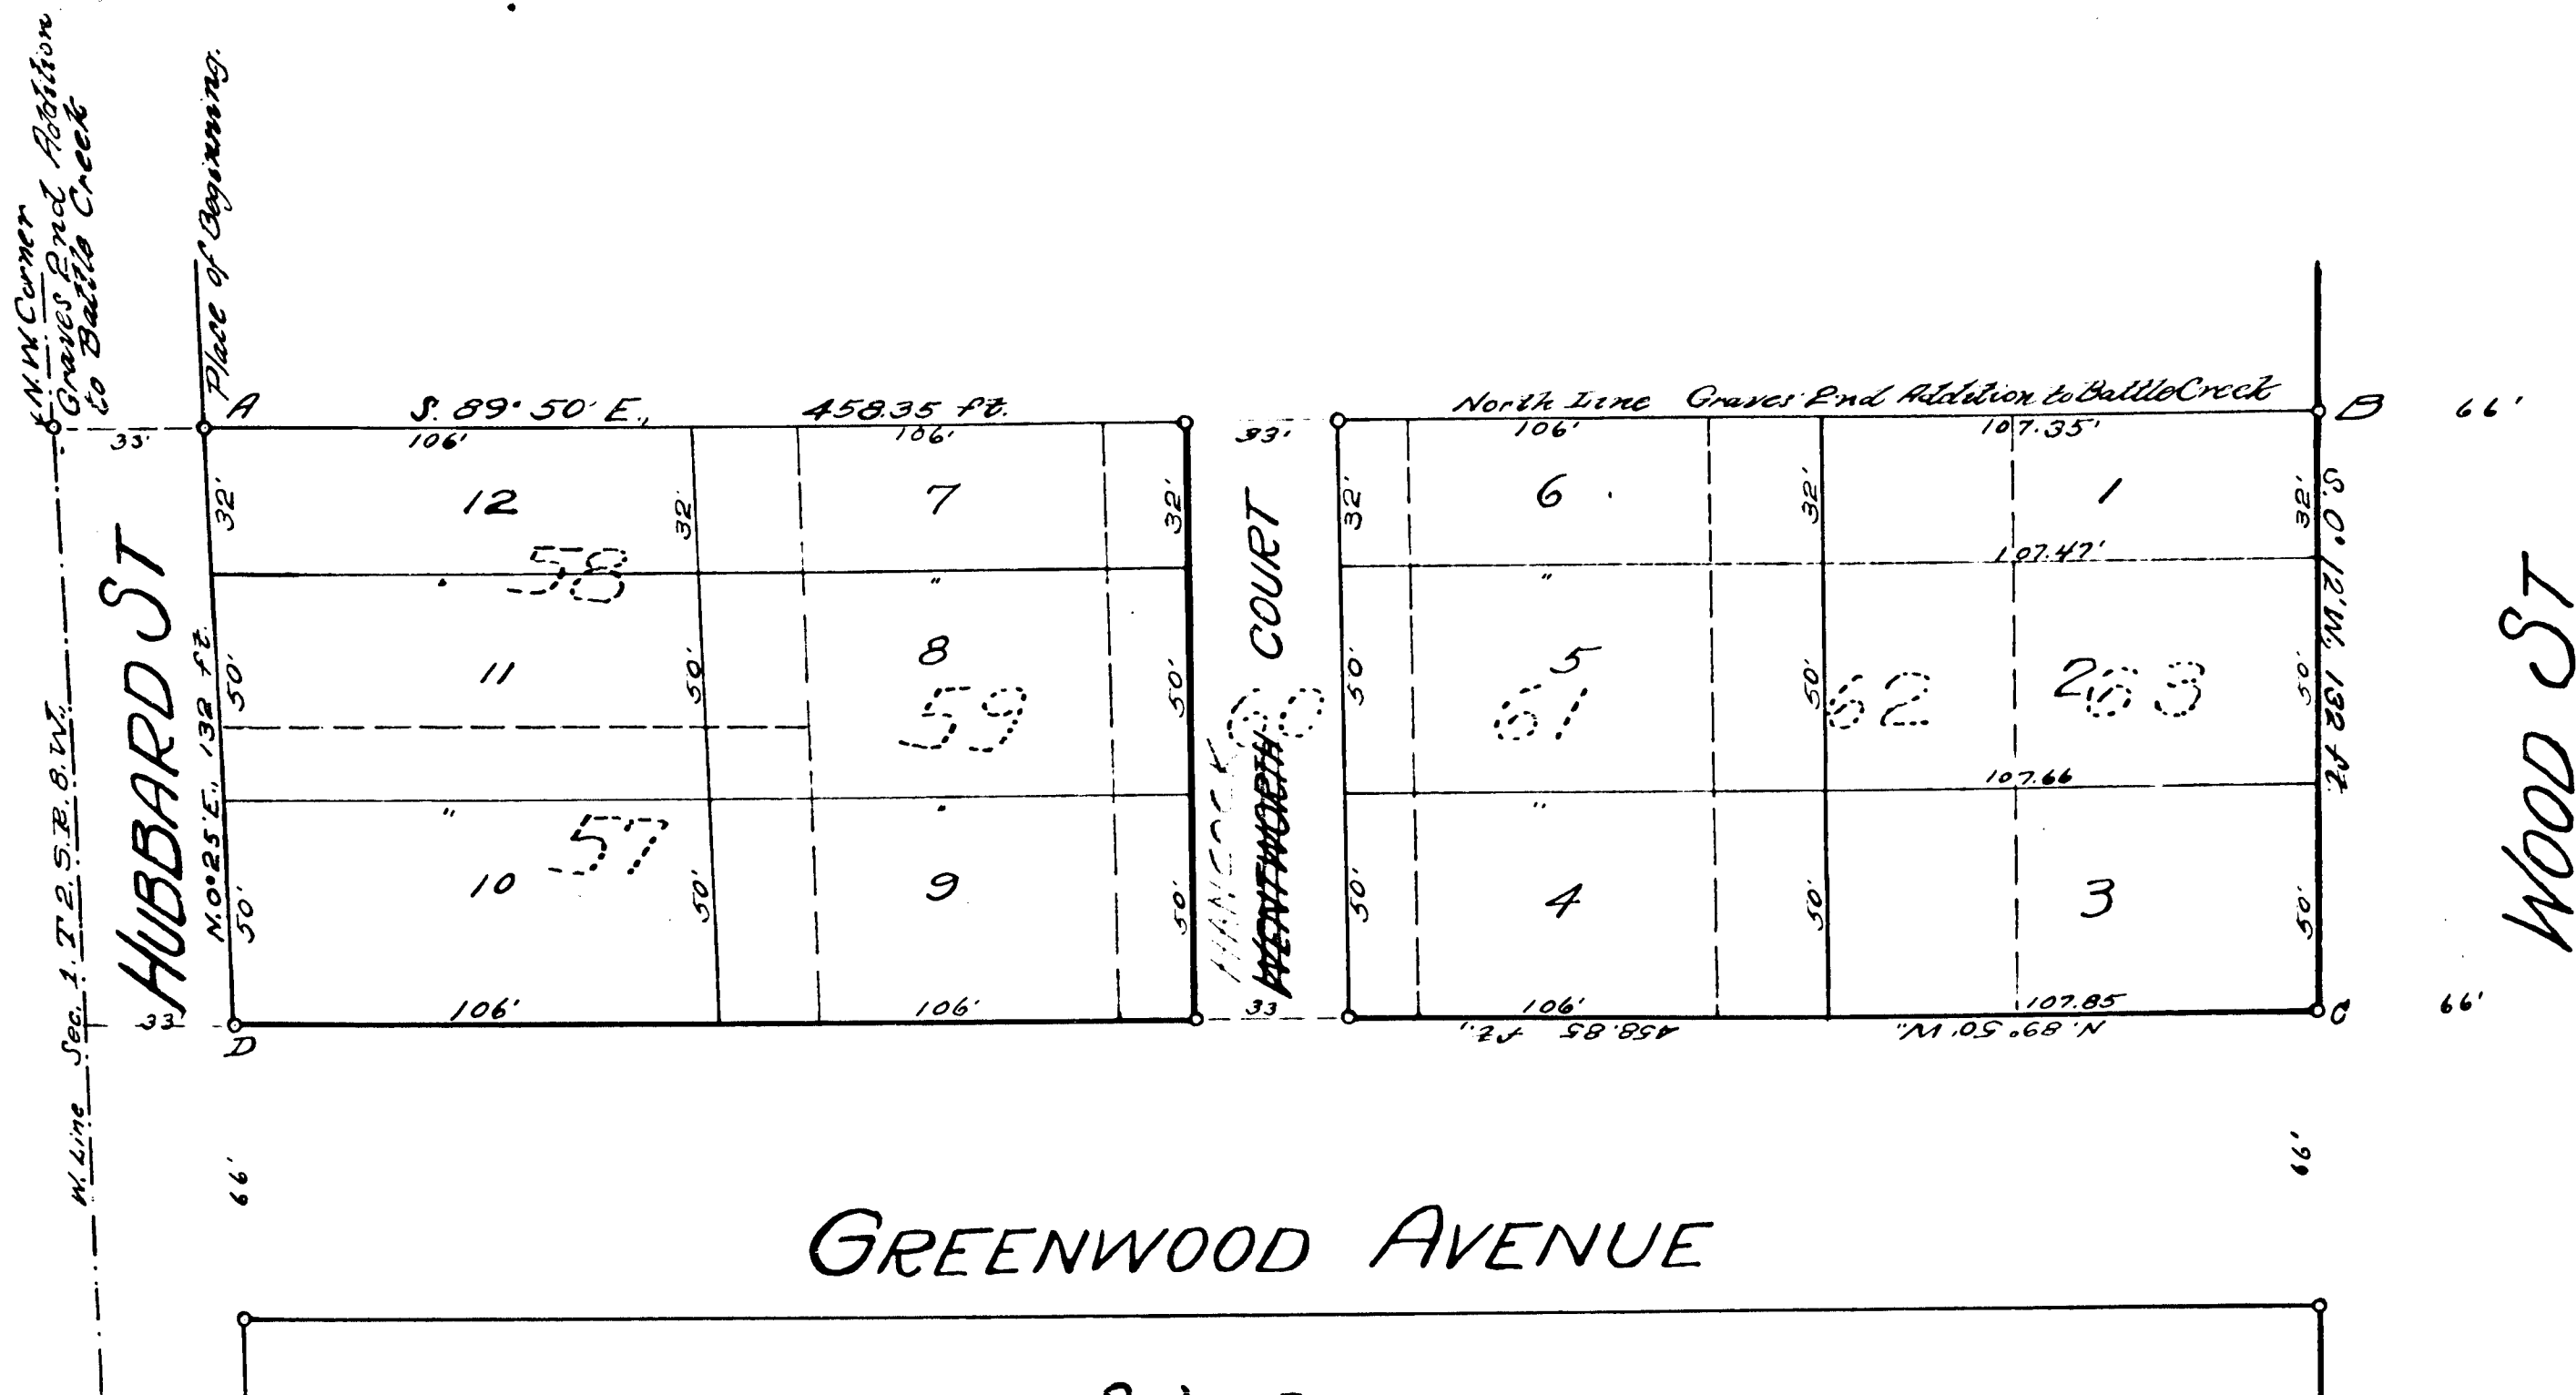

The Homeland Company's Sub-division of a Part of Graves' 2nd Addition to Battle Creek

In the City of Battle Creek, Calhoun County, Michigan

HARLAN K. WHITNEY, Civil Engineer

DEDICATION

KNOW ALL MEN BY THESE PRESENTS, That Benton N. Colver and Agnes K. Colver, his wife, as proprietors, of the City of Battle Creek, Calhoun County, Michigan, have caused the land embraced in the annexed plat, to be surveyed, laid out and platted, to be known as "THE HOMELAND COMPANY'S SUBDIVISION OF A PART OF GRAVES' 2nd ADDITION TO BATTLE CREEK", and that the Court as shown on said plat is hereby dedicated to the use of the public.

Signed and sealed in presence of:
B.C. Kirkland, Benton N. Colver [L.S.]
Grace Risher, Agnes K. Colver [L.S.]

STATE OF MICHIGAN, } ss
COUNTY OF CALHOUN } ss
On this 12th day of April, A. D. 1912, before me, a Notary Public in and for said County, personally appeared the above named Benton N. Colver and Agnes K. Colver, his wife, known to me to be the persons who executed the above dedication, and severally acknowledged the same to be their free act and deed.

Ingram W. Shram, Notary Public, Calhoun County, Michigan. My Commission expires Aug. 1912.

DESCRIPTION OF LAND PLATTED

The land embraced in the annexed plat of "The Homeland Company's Subdivision of a part of Graves' 2nd Addition to Battle Creek" is all that part of the northwest quarter of section 1, T. 2 S., R. 8 W., Calhoun County, Michigan, described as follows, to-wit:
Lots 57-58-59-60-61-62 and 63 of the recorded plat of "Graves' 2nd Addition to Battle Creek", more particularly described as follows:
Beginning at the northwest corner of lot 58 of said addition ("A") 33 feet east of the west line of said section; Running thence S. 89° 50' E. along the north line of said addition 458.35 feet to "B", on the west line of Wood Street; Thence S. 0° 12' W. 132 feet to "C", the northwest corner of Greenwood Avenue and Wood Street; Thence N. 89° 50' W. along the north line of Greenwood Avenue 458.85 feet to "D", the northeast corner of Hubbard Street and Greenwood Avenue; Thence N. 0° 25' E., 132 feet to the place of beginning. All bearings assumed true meridian. Magnetic variation, N. 0° 25' E.

SURVEYORS' CERTIFICATE

WE HEREBY CERTIFY, That the Plat hereon delineated, is a correct one, and that permanent monuments have been planted as thereon shown, at all angles in the boundaries of the land platted, and at all intersections of streets and avenues, the same consisting of Iron Pipe Stakes, about 2 feet long and about one inch in diameter, at all points marked thus, o.
Harlan K. Whitney, Surveyor

RECORDER'S CERTIFICATE

I HEREBY CERTIFY, That this Plat was approved by the Common Council, of the City of Battle Creek, on the 22nd day of April, 1912.
Thos. H. Shram, Recorder of the City of Battle Creek.

CITY TREASURER'S TAX CERTIFICATE

STATE OF MICHIGAN, COUNTY OF CALHOUN, CITY OF BATTLE CREEK
On this 25th day of April, A. D. 1912, I hereby certify that there are NO tax liens or titles held by the city of Battle Creek, or by individuals on the lands described in the within instrument, for the five years preceding the date of said instrument, and that the taxes for the said period of five years are paid, as shown by the records of this office.
Chas. L. Strong, City Treasurer of the City of Battle Creek, Michigan.

COUNTY TREASURER'S TAX CERTIFICATE

STATE OF MICHIGAN, COUNTY OF CALHOUN
On this twenty-sixth day of April, A. D. 1912, I hereby certify that there are NO tax liens or titles held by the State on the lands described in the within instrument, and that there are NO tax liens or titles held by individuals on said lands for the five years preceding the date of said instrument, and that the taxes for the said period of five years are paid, as shown by the records of this office.
G. S. Barnes, Treasurer of Calhoun County

Name change
BY RESOLUTION
OF CO. RD. Comm
June 29, 1901
VOUCHER No. 646-501

Examinated and Approved
MAY 4-1912
Gen. S. Housen
Deputy Auditor General.

COPY
REGISTER'S OFFICE.
Calhoun County
PLAT OF
HARBOR
WAS RECORDED THIS 7th DAY OF
May, A. D. 1912, AT 4 O'CLOCK
P. M. IN LINE 5 OF PLAT
ON PAGE 18
Shram & Shram
RECORDERS OF DEEDS
ORIGINAL ON FILE

I hereby certify that this copy is a true copy of the MAP or PLAT forwarded the Register of Deeds for recording.
Compared MAY 6-1912
Gen. S. Housen
Deputy Auditor General.

Filed in Auditor General's Dep't
MAY 10 1912
Gen. S. Housen
Deputy Auditor General.

12357
13495