

12791
13503

Examined and Approved
JUL 18 1913
Geo. C. Howell
Deputy Auditor General

GREEN ACRE EXTENSION

Emmett Township, Calhoun County, Michigan

HARLAN K. WHITNEY, Civil Engineer

DEDICATION

KNOW ALL MEN BY THESE PRESENTS, That we, Harvey N. Peck and Kittie Clark Peck, his wife, of the Township of Emmett, Calhoun County, Michigan, as proprietors, holding jointly, have caused the land embraced in the annexed plat and located in the Township of Emmett, Calhoun County, Michigan, to be surveyed, laid out and platted, to be known as "GREEN ACRE EXTENSION," and that the streets and avenues as shown on said plat are hereby dedicated to the use of the public.

Signed and sealed in presence of:

Sadie Smith
Harvey N. Peck [L.S.]
Herbert J. Adams
Kittie Clark Peck [L.S.]
Witnesses

STATE OF MICHIGAN, } ss
COUNTY OF CALHOUN, } ss
On this 25th day of June, A. D. 1913, before me, a notary public in and for said county, personally appeared the above named Harvey N. Peck and Kittie Clark Peck, husband and wife, known to me to be the persons who executed the above dedication and severally acknowledged the same to be their free act and deed.

DESCRIPTION OF LAND PLATTED

The land embraced in the annexed plat of "Green Acre Extension" is all that part of the West half of Section Ten (10) Town Two (2) South, Range Seven (7) West (Emmett Township, Calhoun County, Michigan, described as follows, to-wit:-

Beginning at the northwest corner post of said section, at a point "A", running thence N. 89° 57' E. along the north line of said section 1325 feet to point "B", the northwest corner of the recorded Plat of "Green Acre" in said section, thence along the westerly boundary of said "Green Acre" plat S. 0° 20' E. 625 feet to point "C", thence N. 89° 42' W. 35 feet to point "D", thence S. 0° 20' E. 2017 feet to point "E", on the east and west quarter line of said section, thence S. 0° 20' E. along said west boundary of Green Acre plat 135 feet to point "F", then S. 16° 45' W. 673.5 feet to point "G", on the center line of the Battle Creek and Kalamazoo, or highway, (Marshall street, so-called), and the southeast corner of said Green Acre plat, thence N. 75° 00' W. along the center line of said highway 761.5 feet to point "H", then N. 85° 34' W. along said highway center line 402.3 feet to point "I", on the west line of said section and east line of the land embraced in the recorded plat of "Bastards" in said township, thence N. 0° 10' W. along said west section line 651.7 feet to point "J", the west quarter post of said section, distant seven (7) feet south of the northeast corner of said Bastards plat; thence N. 0° 21' W. along said west section line 2460 feet to the place of beginning.

All bearings assumed true meridian. Probable magnetic variation N. 0° 22' E.

SURVEYORS' CERTIFICATE

WE HEREBY CERTIFY, That the Plat herein delineated, is a correct one, and that permanent monuments have been placed as thereon shown, at all angles in the boundaries of the land platted, and at all intersections of streets and avenues, the same consisting of Iron Pipe Stakes, about 2 feet long and about one inch in diameter, at all points marked thus Q, except such solid vitrified the re-survey monuments, one foot long at point marked thus Q.

Arthur H. Chase
Surveyor
Harlan K. Whitney
Civil Engineer

TOWNSHIP CLERK'S CERTIFICATE

I HEREBY CERTIFY that this plat was approved by the Township Board of Emmett Township, on the 11th day of August, A. D. 1913.

John F. Crankhite
Clerk of Emmett Township, Calhoun County, Michigan

COUNTY TREASURER'S TAX CERTIFICATE

STATE OF MICHIGAN, } ss
COUNTY OF CALHOUN, } ss
On this 25th day of June, A. D. 1913, I hereby certify that there are no tax liens or claims held by the State on the lands described in the within instrument, and that there are no tax liens or claims held by individuals on said lands for the five years preceding the date of said instrument, and that the taxes for the said period, as shown by the records of this office.

Emma S. Williams
Deputy Treasurer of Calhoun County, Michigan

CERTIFICATE OF APPROVAL OF PLAT BY BOARD OF SUPERVISORS

I hereby certify that this plat was approved by the Board of Supervisors of Calhoun County at a session thereof held at the City of Marshall on the 24th day of September, A. D. 1913.

Clark E. Wiley
Chairman
Will A. Cary
Clerk of Board of Supervisors

I hereby certify that this copy is a true copy of the M.A.P. or Plat forwarded the Register of Deeds for recording.


Compared JUL 19 1913
Deputy Auditor General

Filed in Auditor General's Dep't

Deputy Auditor General

All bearings Assumed True Meridian
Probable Magnetic Variation N. 0° 22' E.

Scale - 200 feet to an inch

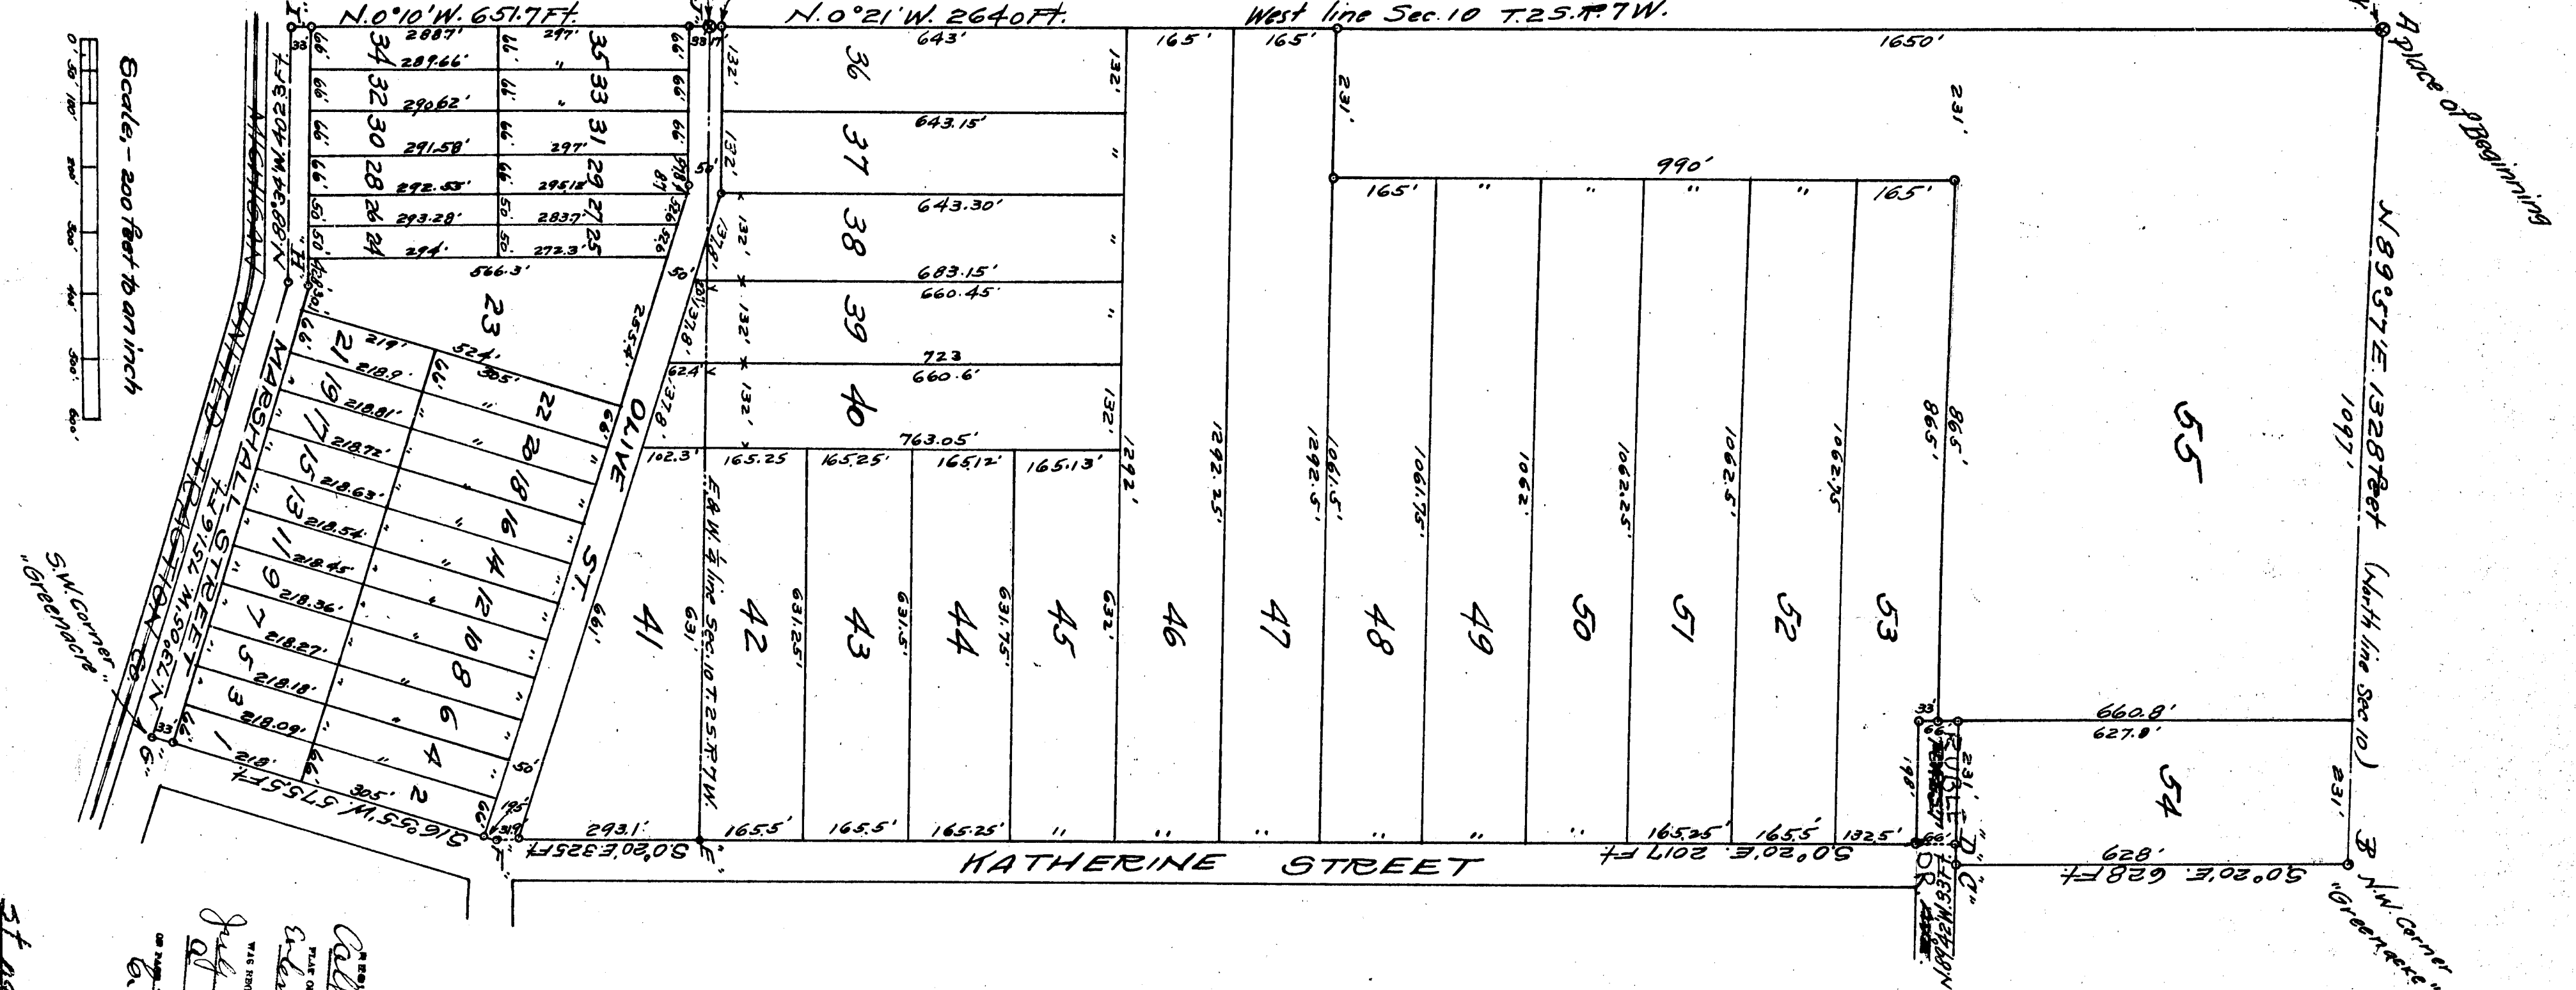

St name changed
VACATED BY ORDER OF
June 3 1921
VOUCHER NO. 577-61

五

Wm. S. Hamer
Deputy Auditor General.

Emmett Township, Calhoun County, Michigan

DEDICATION

Sadie Smith	Ward, S. R. A.	[L.S.]
Herbert J. Adams	At the Clark Peak	[L.S.]
Witness		

Notary Public, Calhoun County, Michigan.
My Commission expires Nov. 13, 1916

SURVEYORS' CERTIFICATE

TOWNSHIP CLERKS CERTIFICATE
 I HEREBY CERTIFY that this plat was approved by the Township Board of Emmett Township, on the
 11
 Surveyor
 Civil Engineer

On this 14th day of April, A.D. 1933,
I hereby certify that there are NO tax liens or titles held by the State on the lands described in the within particu-
lar, and that there are NO tax liens or titles held by individuals on said lands for the five years preceding the
date of said instrument, and that the taxes for the said period of five years are paid, as shown by the records of this
Office.

Emory S. McMillan

I hereby certify that this plan was approved by the Board of Supervisors of Calhoun County at a session thereof held at the City of Marshall on the 24th day of October, A. D. 1912.

Clara E. Mildey Chairman.

Will A. Gady Clerk of Board of Supervisors.

Filed in Auditor General's Dep't

Deputy Auditor General