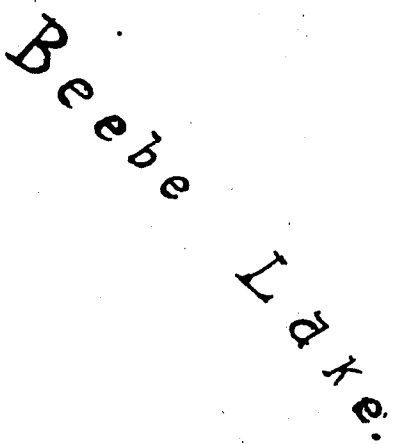




13542

COPY



**Auditor General,**

CERTIFICATE OF APPROVAL OF TOWN BOARD

I hereby certify that the plat hereon delineated is a correct one, and <sup>1 foot none</sup> 3/4 inch gaps <sup>v</sup> have been placed at points marked thus [o] as thereon shown. Land platted, and at all intersections of streets or streets and alleys.

ENTIRE PLAT VACATED  
6-6-32  
Voucher #1967-12-2-32

50 P. R. O. de Vancouver.  
CLK. Hiram Eaton.  
J. P. Arthur S. Randall. J. P.  
J. P. Arthur S. Randall.  
Dated this 14<sup>th</sup> day of June 1881.

[illegible]

REGISTERED OFFICE, **COMPY**  
 NEW YORK COUNTY, N.Y.  
 THIS OF *James M. McManus*  
*Edward Henry Mc 72*  
 WAS REGISTERED WITH 10 DWT OF  
*James M. McManus* A. D. 18 11 1/2 BLOCK,  
 N. Y. LANE 1 OF ONE  
 ON PAGE 35  
*James M. McManus*  
 NUMBER OF JERMS  
 ORIGINAL ON FILE  
 I hereby certify that this  
 copy is a true copy of the M/P  
 or PLAT forwarded the Registrar  
 of Deeds for recording.  
 COMPYED MC 8 1911

Auditor General.

Filed in Auditor General's Dep't.  
APR 19 1901

AUG 12 1941

Admiral GORDON

I HEREBY CERTIFY that there are no tax liens or titles held by the State on the lands described in this instrument and that there are no tax liens or titles held by any person on the said lands, and that the taxes on the said lands for the five years preceding the date of said instrument are paid as shown by the records of this office.

Harrison, Mich., Feb. 24, 1914.

J. B. O'Leary,  
County Treasurer.

I HEREBY CERTIFY that there are no tax liens or titles held by the State on the lands described in this instrument and that there are no tax liens or titles held by any person on the said lands, and that the taxes on the said lands for the five years preceding the date of said instrument are paid as shown by the records of this office.

Harrison, Mich., Feb. 24, 1914.

J. B. O'Leary,  
County Treasurer.

DATE NO. 2  
COPY,

1/5/

beginning at Meagher post on section line common to sections 14, 23, on west side of Beebe L. No. 1  
North 61° 30' W. 121' Thence S. 67° E. 113' Thence on same angle 121.1', Thence S. 65° 30' E. 215', Thence N. 35° 15' E. 378', Thence  
1587', Thence N. 5° 52' E. 229', Thence N. 71° E. 31', Thence S. 63° 30' E. 121', Thence S. 1° W. 310', Thence S. 63° 30' W. 679', Thence  
Thence S. 21° W. 91', Thence S. 74° 30' W. 684', Thence S. 95° E. 66', Thence S. 65° 30' E. 673', Thence S. 63° 30' E. 769', Thence  
1112' S. 52° E. 125', Thence S. 5° W. 116', Thence S. 31° 15' W. 133.5', Thence S. 54° W. 287', Thence S. 61° W. 822', Thence S. 60°  
W. 1002', Thence S. 89° W. 1254', Thence N. 80° W. 2144', Thence N. 91° W. 2197', Thence N. 40° 15' W. 2115', Thence N. 73° W. 1212'  
inside boundary line of land platting.

Know All Men by these presents, that we William C. Cornwell, Francis A. Fowler, Ernest H. Pettz, and Herbert B. Collins, Proprietors, and Made G. Cornwell, Ethel L. Fowler, Emily Pettz, and Katharine M. Collins, their wives, have caused the land embraced in the annexed plat to be surveyed, laid out and platted, to be known as Pinehurst Orchard Resort Association, and that the streets and alleys as shown on said plat are hereby dedicated to the use of the public.

County of \_\_\_\_\_  
State of Michigan.  
ss.

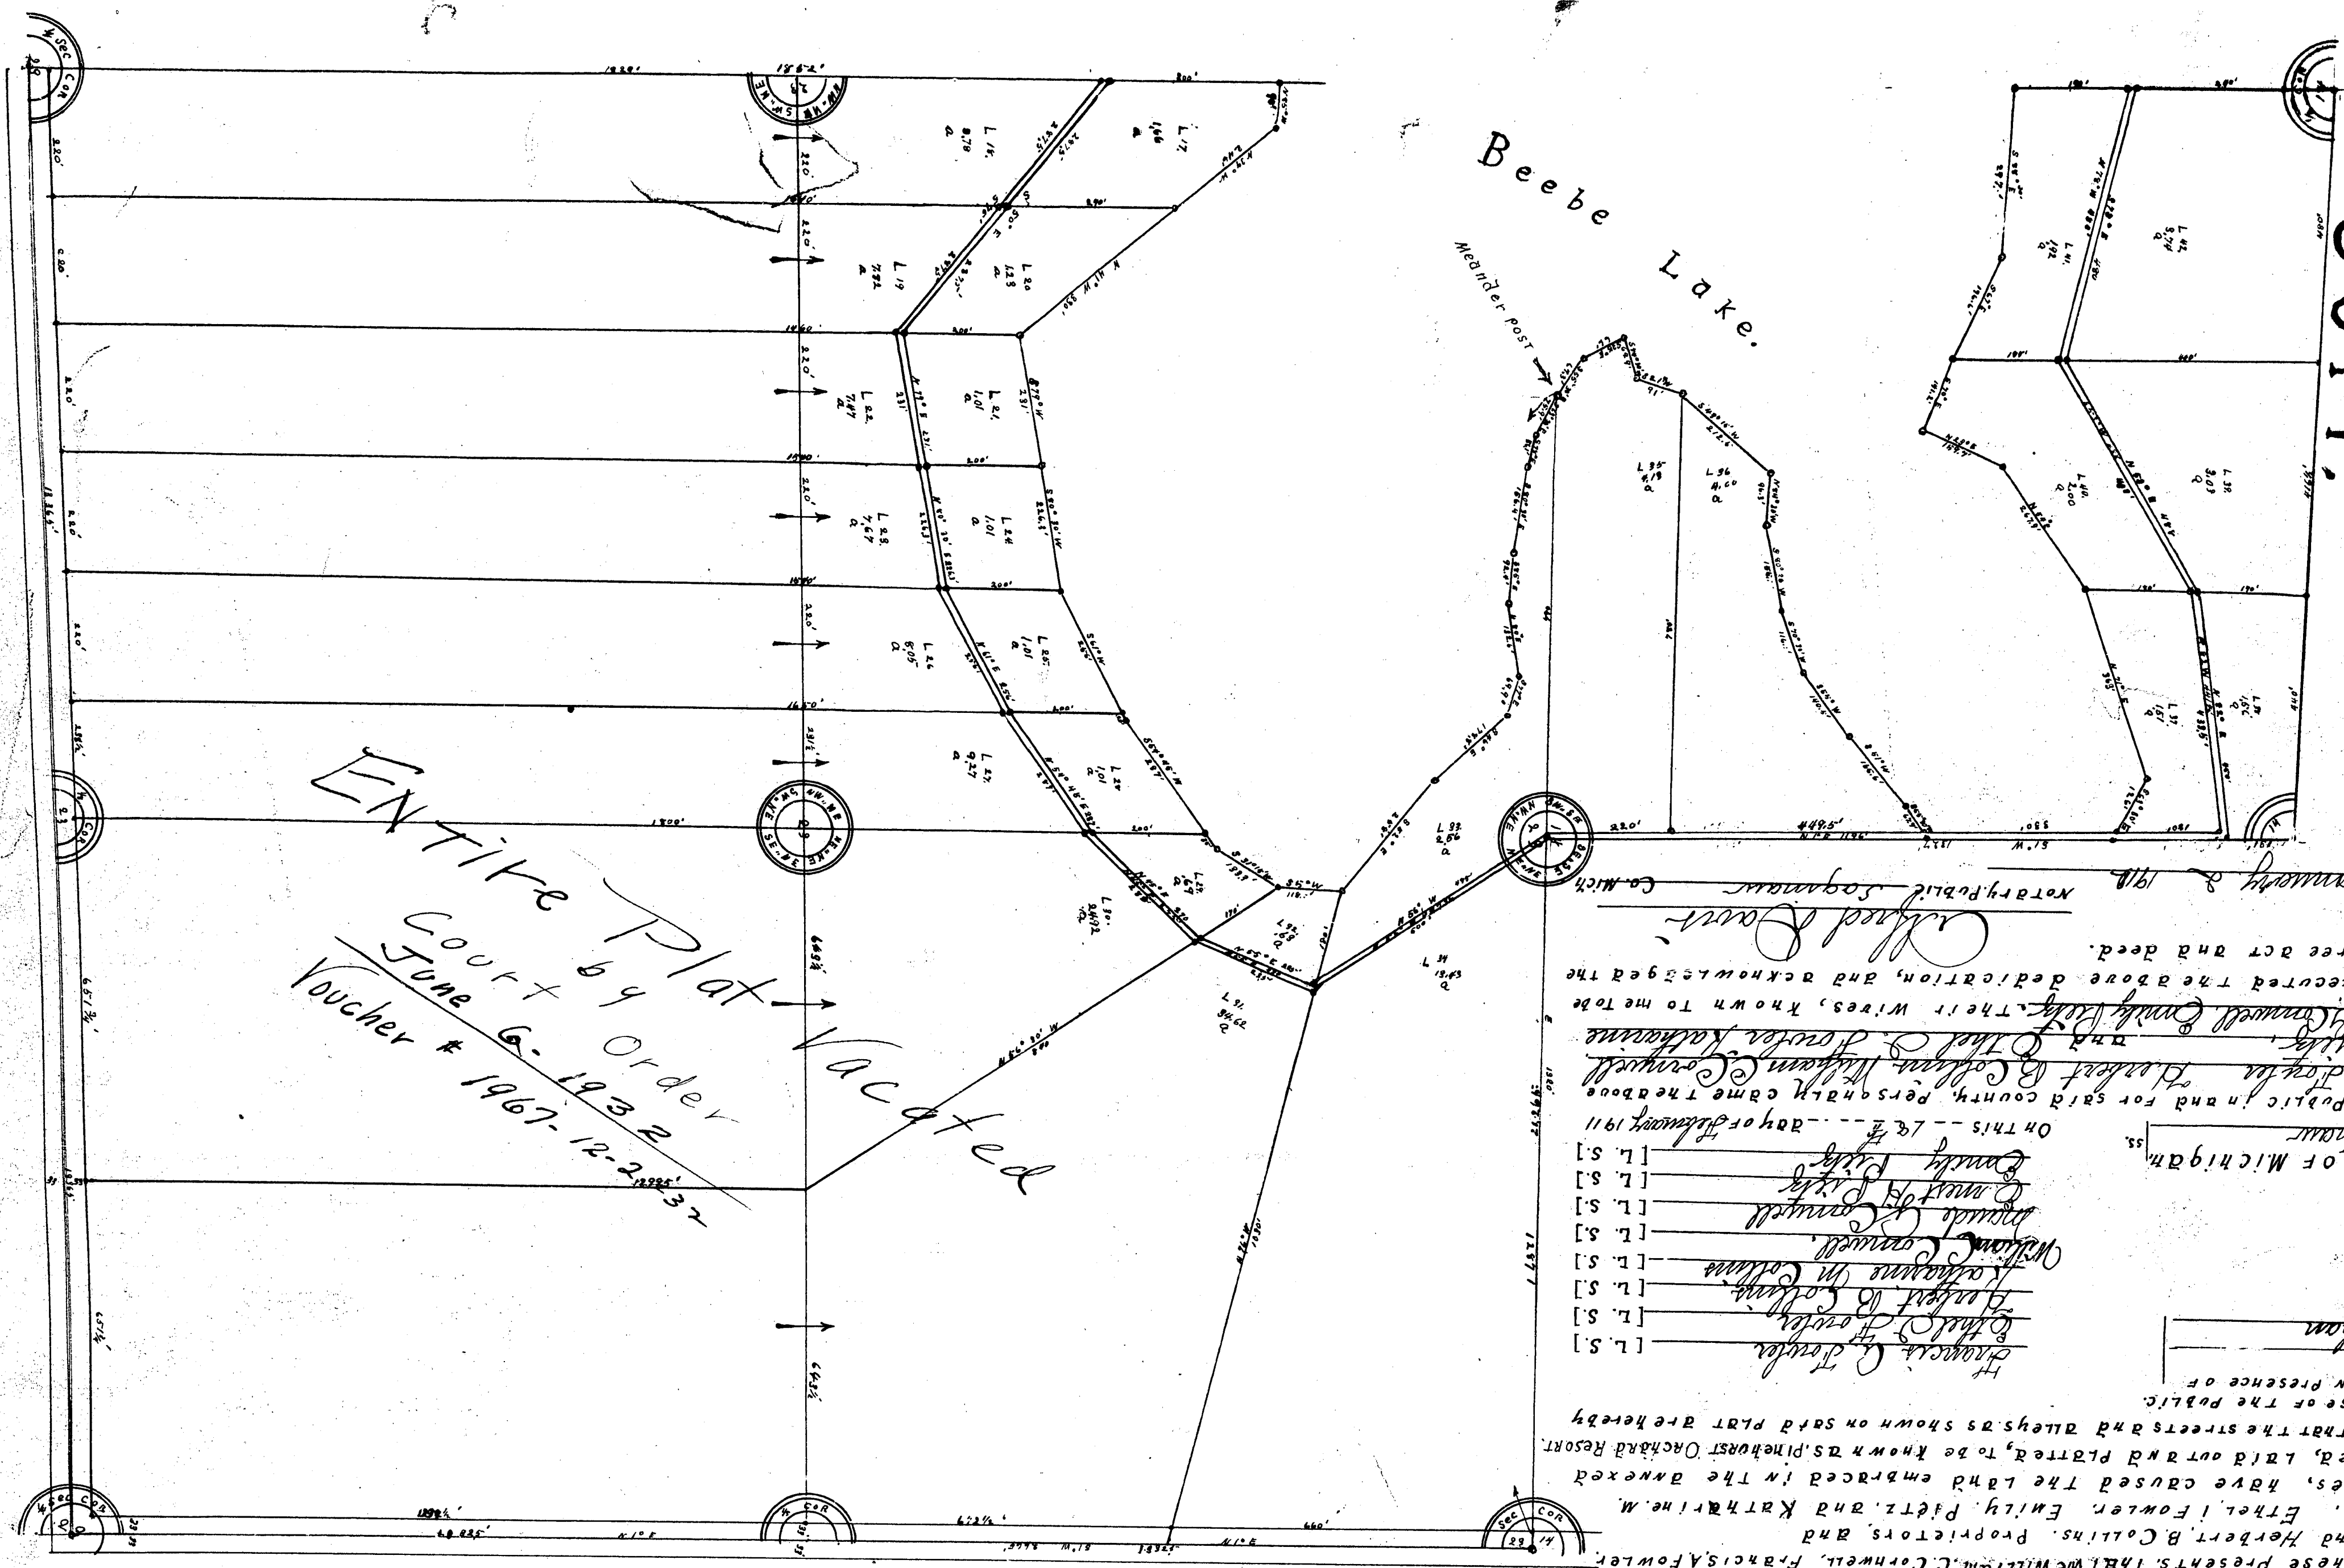
On this \_\_\_\_\_ day of February 1961

I, \_\_\_\_\_ County Clerk  
of said County,  
do hereby certify that  
the foregoing is a true  
and correct copy of  
the original as same  
appears in my records.

\_\_\_\_\_ County Clerk  
of said County.

Commission Expires January 2, 1918  
Notary Public, Coganau  
C. Mich

ENTIRE Plat Vacated  
Court & Order  
June 6, 1932  
Voucher # 1967-12-2332

[illegible]



DATE: NO. 2  
COPY,



*EN Title Plat*

*Court by Order*

*June 6-1932*

*Voucher # 1967-12-23*

*Vacated*

Know All men by these presents, THAT we William C. Cornwell, Francis A. Fowler, Ernest H. Plettz, and Herbert B. Collins, Proprietors, and Maude G. Cornwell, Ethel I. Fowler, Emily, Pletz, and Katherine M. Collins, Their wives, have caused the land embraced in the annexed plat to be surveyed, laid out and platted, to be known as Pinehurst Orchard Resort. Association, and that the streets and alleys as shown on said plat are hereby dedicated to the use of the public.

Signed, sealed in presence of

Edna D. Clark  
Edna D. Clark

State of Michigan ss.  
County of Saginaw

On this 12<sup>th</sup> day of February 1911

Francis A. Fowler  
Edna D. Clark  
Herbert B. Collins  
William C. Cornwell  
Maude G. Cornwell  
Emily Pletz  
Ethel I. Fowler  
Katherine M. Collins

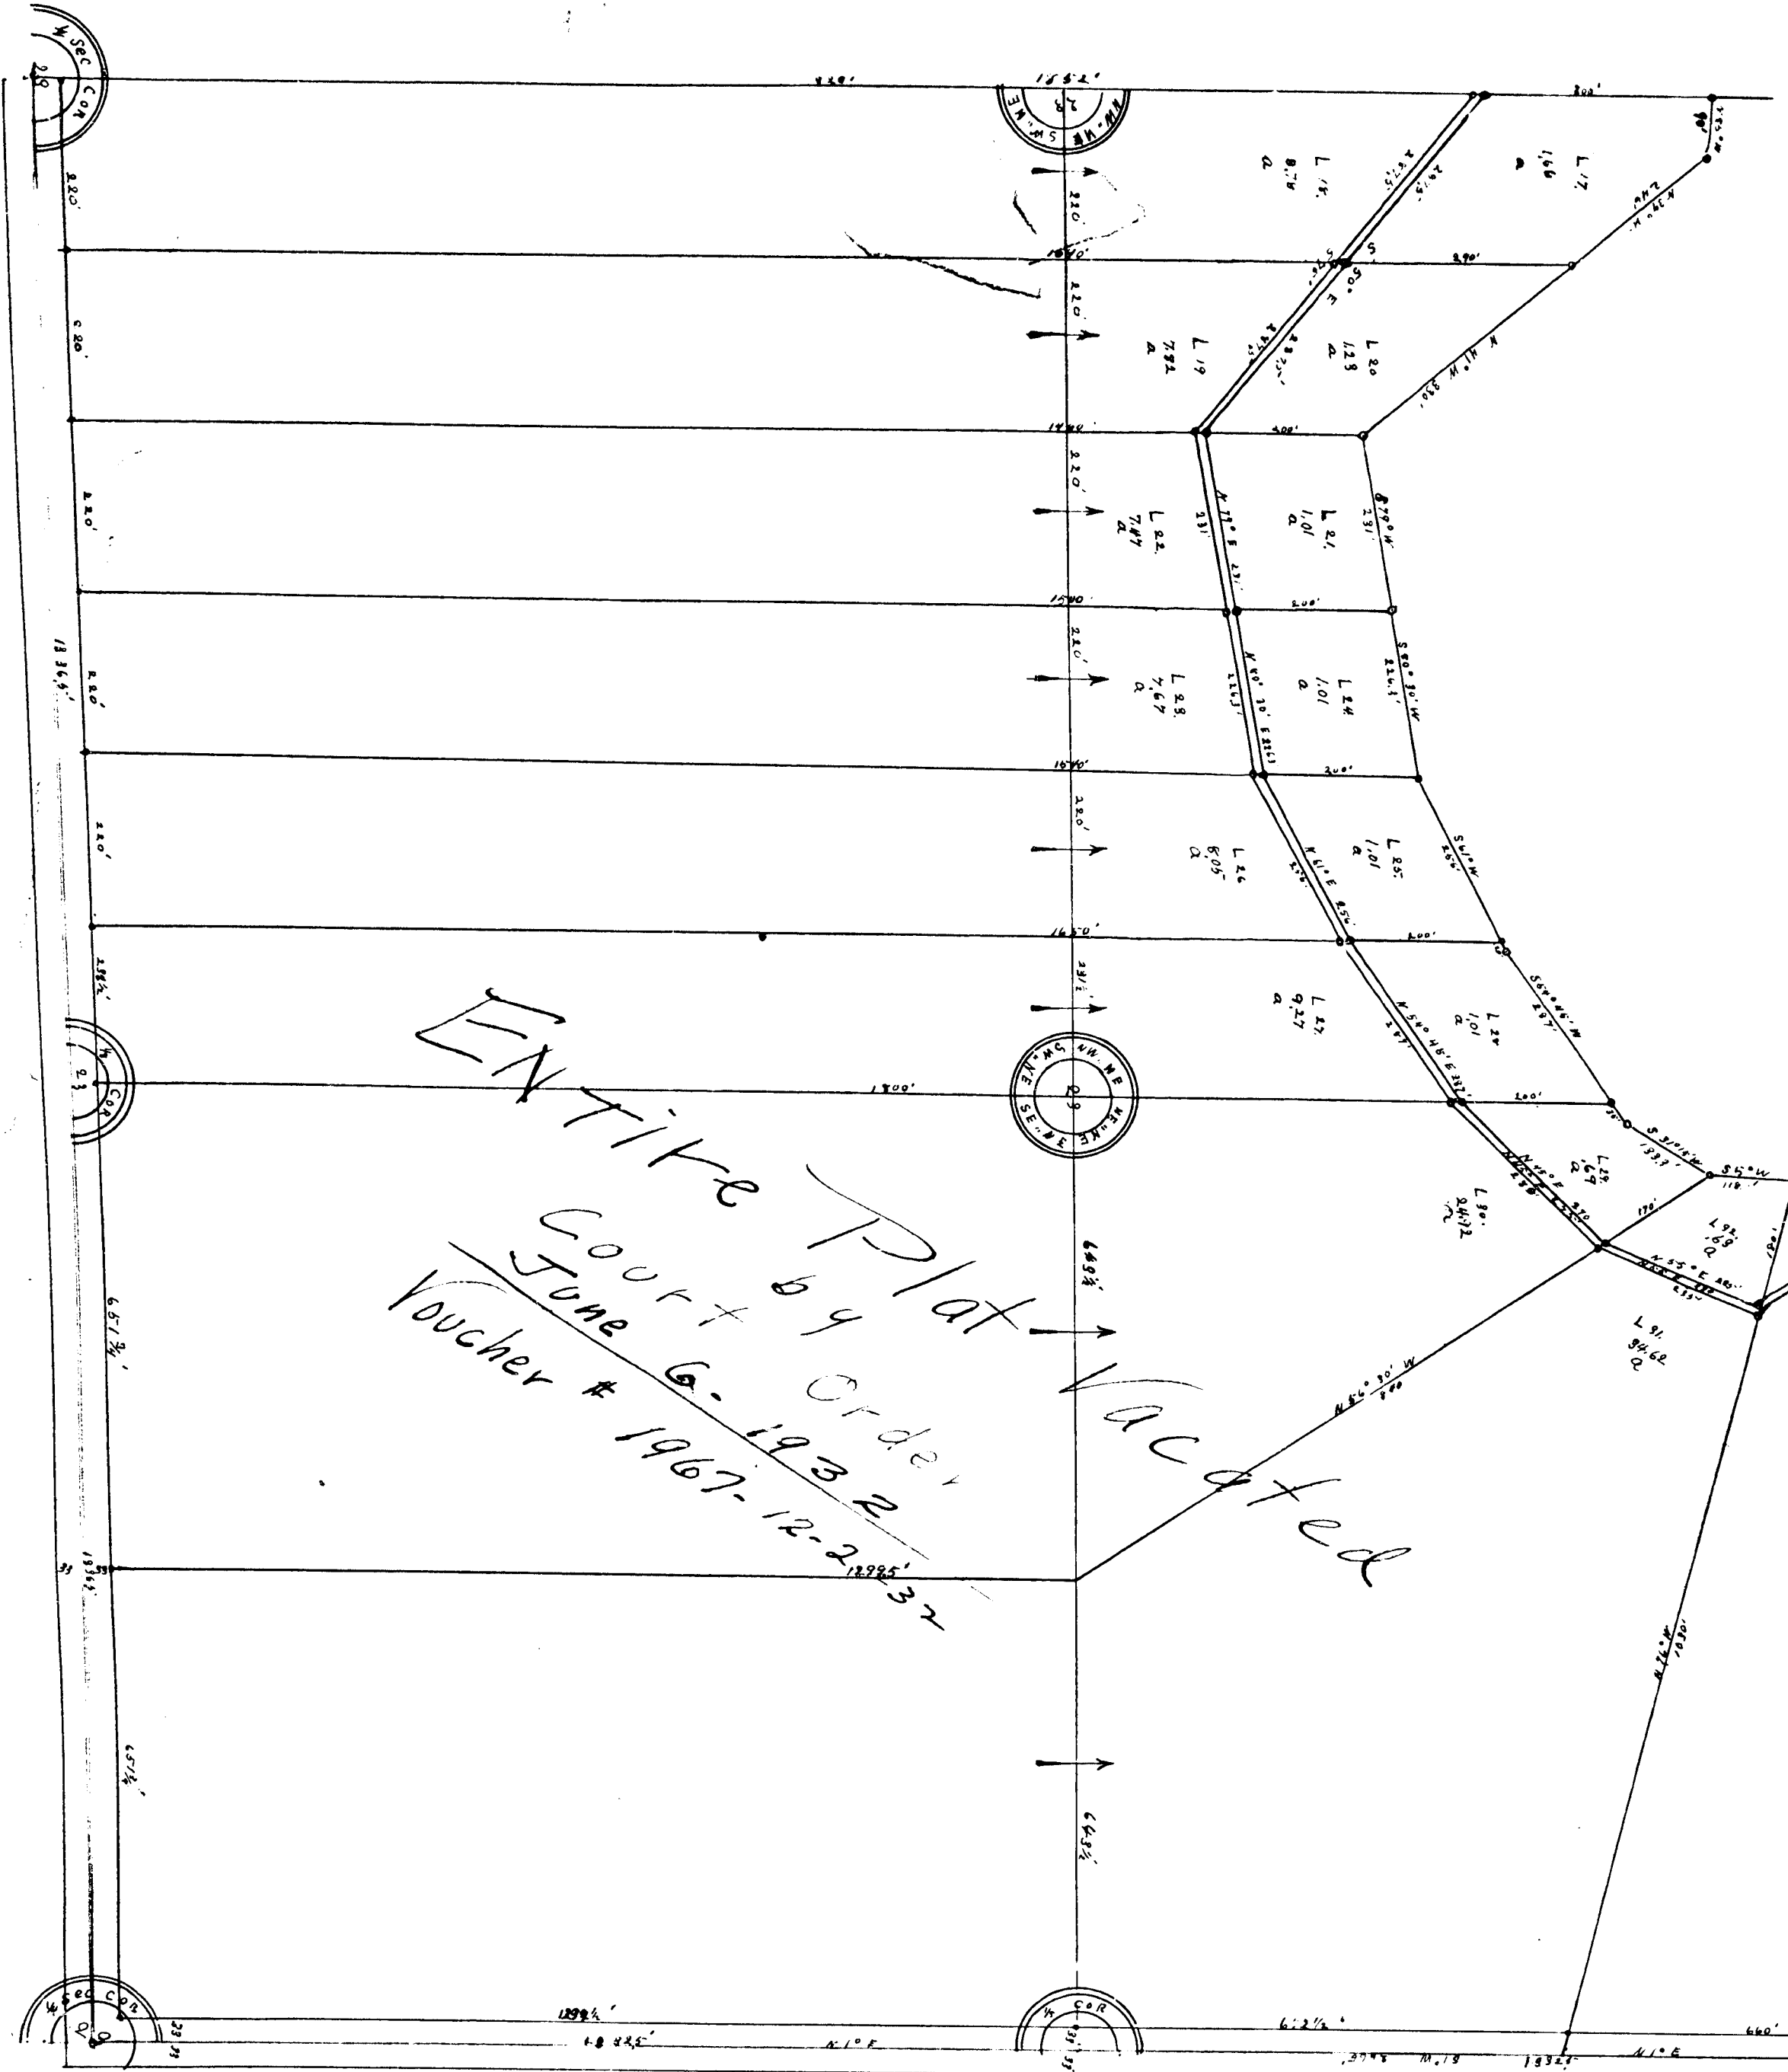
Before me, a Notary Public, in and for said county, personally came the above named Francis A. Fowler, Edna D. Clark, Herbert B. Collins, William C. Cornwell, Maude G. Cornwell, Emily Pletz, and Katherine M. Collins, husband and wife, and I Inel D. Fowler Katherine M. Collins, husband and wife, and I Inel D. Fowler, and acknowledged the same to be their free act and deed.

Notary Public  
Alfred J. Carr

Commission Expires January 2 1912

1911

Beginning at Meander Post on section line common to sections 14, 13, on west side of  
North 51° 30' W. 192' Thence S. 67° E. 111' Thence on some angle 1217' Thence S. 65° 30' E. 2415' Thence N. 35° 10' E. 850'  
1527' Thence N. 54° E. 2679' Thence N. 71° E. 323' Thence S. 45° 30' E. 121' Thence S. 1° W. 330' Thence S. 85°  
Thence S. 21° W. 91' Thence S. 74° 30' W. 189' Thence S. 94° E. 66' Thence S. 65° 30' E. 673' Thence S. 6°  
112° S. 52° E. 425' Thence S. 5° W. 118' Thence S. 5° 15' W. 133' Thence S. 54° 44' W. 237' Thence S. 61° W. 8  
W. 10412' Thence S. 80° W. 1254' Thence N. 80° W. 2244' Thence N. 91° W. 2197' Thence N. 70° 15' W. 2111' Thence N.  
inside boundary line of land plat 724.

[illegible]