


MAP OF CROSWELL and GEDDES' ADDITION to ADRIAN

Received and Filed
IN AUDITOR GENERAL'S OFFICE
January 12, 1891
M. R. Pratt
Deputy Auditor General.

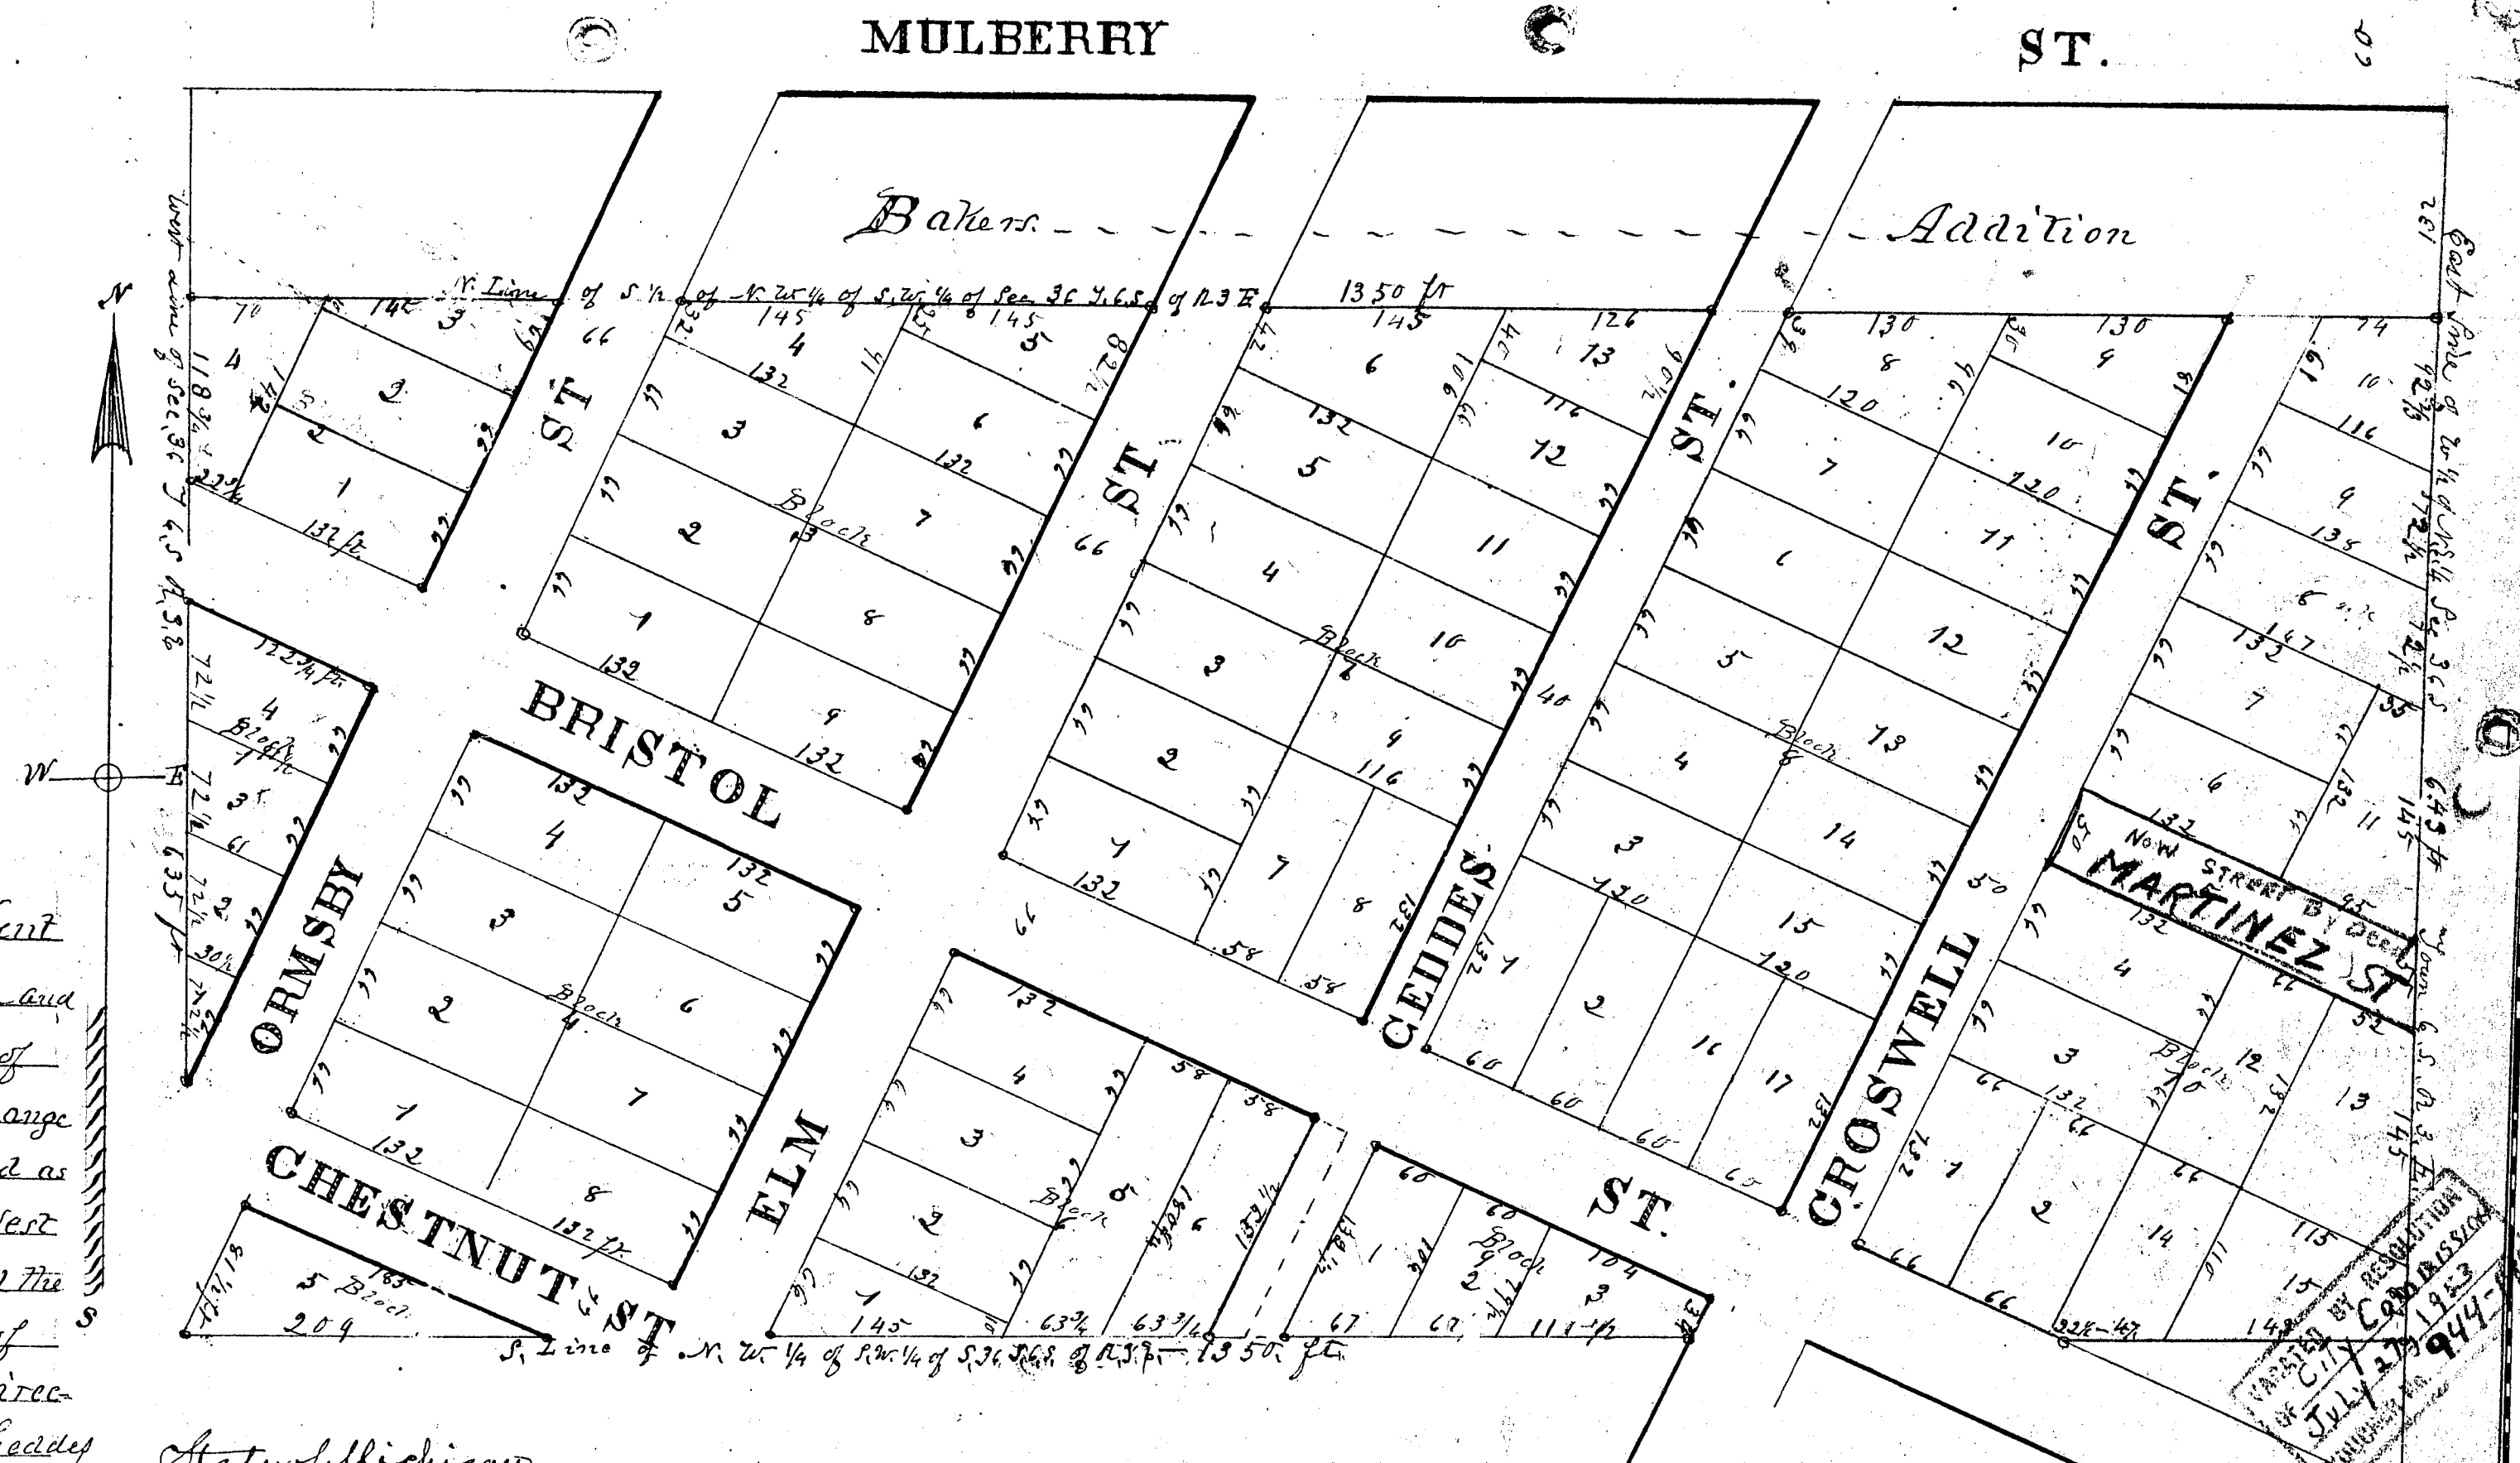

Know all men by these presents, that J. Burton Kent Civil Engineer and Surveyor, of Adrian County of Lenawee and State of Michigan, have Surveyed and Platted all that part of Section Number Thirty Six (36) Township Six (6) South, of Range Three East Meridian of Michigan, known and designated as the South half of the North West Quarter of the South West Quarter thereof containing twenty Acres more or less, And the foregoing is a full, true, and correct Map and Plat of Said Lands, the same having been done, under the direction and in behalf of ^{James L. Croswell} ~~James L. Croswell~~ and Norman Geddes of the City of Adrian, State and County aforesaid, And the same is to be known and recognized as (Croswell and Geddes' Addition to the City of Adrian) And ^{James L. Croswell} ~~James L. Croswell~~ and Norman Geddes, Owners and proprietors of the above described Lands, have caused the above mentioned Survey and the annexed plat thereof to be made by the said Burton Kent, Engineer and Surveyor, and have given thereto the name of Croswell and Geddes' Addition to the City of Adrian, as aforesaid, and we do hereby give grant, and dedicate to the public, to be used for the purposes designated all lands marked as Streets and shown on said Plat.

Given under our hands and Seal this 21st day of September 1889.
In presence of
C. R. Allen
J. R. Lockwood
Burton Kent
Daniel Croswell
Norman Geddes
James L. Croswell
On this 21st day of September A.D. 1889
personally appeared before me, a Notary Public in and for said County, the above named Burton Kent, Daniel Croswell, and Norman Geddes, to me known to be the same persons who executed the annexed Plat and Instruments, and acknowledged that they executed the same for the purposes herein expressed and implied, as their free act and deed.
M. R. Pratt
Notary Public

State of Michigan
County of Lenawee. On this 21st day of December A.D. 1889 before me a Notary Public in and for said County personally appeared Jane M. Geddes, wife of Norman Geddes, to me known to be the same person, who by that name executed the annexed plat and instruments and acknowledged that she executed the same for the uses and purposes therein expressed and implied as her free act and deed.
Wm B. Thompson
Notary Public

Examined and Approved
December 11th 1890.
M. R. Pratt
Deputy Auditor General

I hereby certify that the plat herein delineated is a correct one, and that permanent monuments consisting of vitrified Fire clay stakes, three inches in diameter and from one to two feet in length, have been planted at points marked thus (•) as the same shows at all angles in the boundaries of the land platted and at all intersections of street, or street, and alley.
Burton Kent
Surveyor

State of Michigan } We Alfred W. Smith Register of Deeds
County of Lenawee } and Burton Kent Surveyor hereby certify that we have carefully compared this copy with the original plat of Croswell and Geddes Addition to the City of Adrian and that it is an exact copy thereof and of the whole of each original paper plat.
Alfred W. Smith, Register of Deeds
Burton Kent, Surveyor

State of Michigan } Received for Record the 3rd day
Register of Deeds } of January A.D. 1891 at 10
Lenawee County } o'clock A. M. and recorded in
Record of Plats & City } on page 37.
Alfred W. Smith, Register

State of Michigan } We Alfred W. Smith Register
County of Lenawee } of Deeds and Burton
Kent Surveyor, hereby
certify that we have each carefully
compared the annexed copy with the plat
of Croswell & Geddes Addition to the City
of Adrian now of record in the office of the
said Register of Deeds, and that it is a true
transcript thereof, and of the whole
of such record.
Alfred W. Smith, Register of Deeds
Burton Kent, Surveyor

13576


Scale 100 ft one Inch

MAP OF CROSWELL and GEDDES'

Received and Filed
IN AUDITOR GENERAL'S OFFICE
July 12, 1891
Alfred W. Smith,
Deputy Auditor General.

ADDITION

to ADRIAN

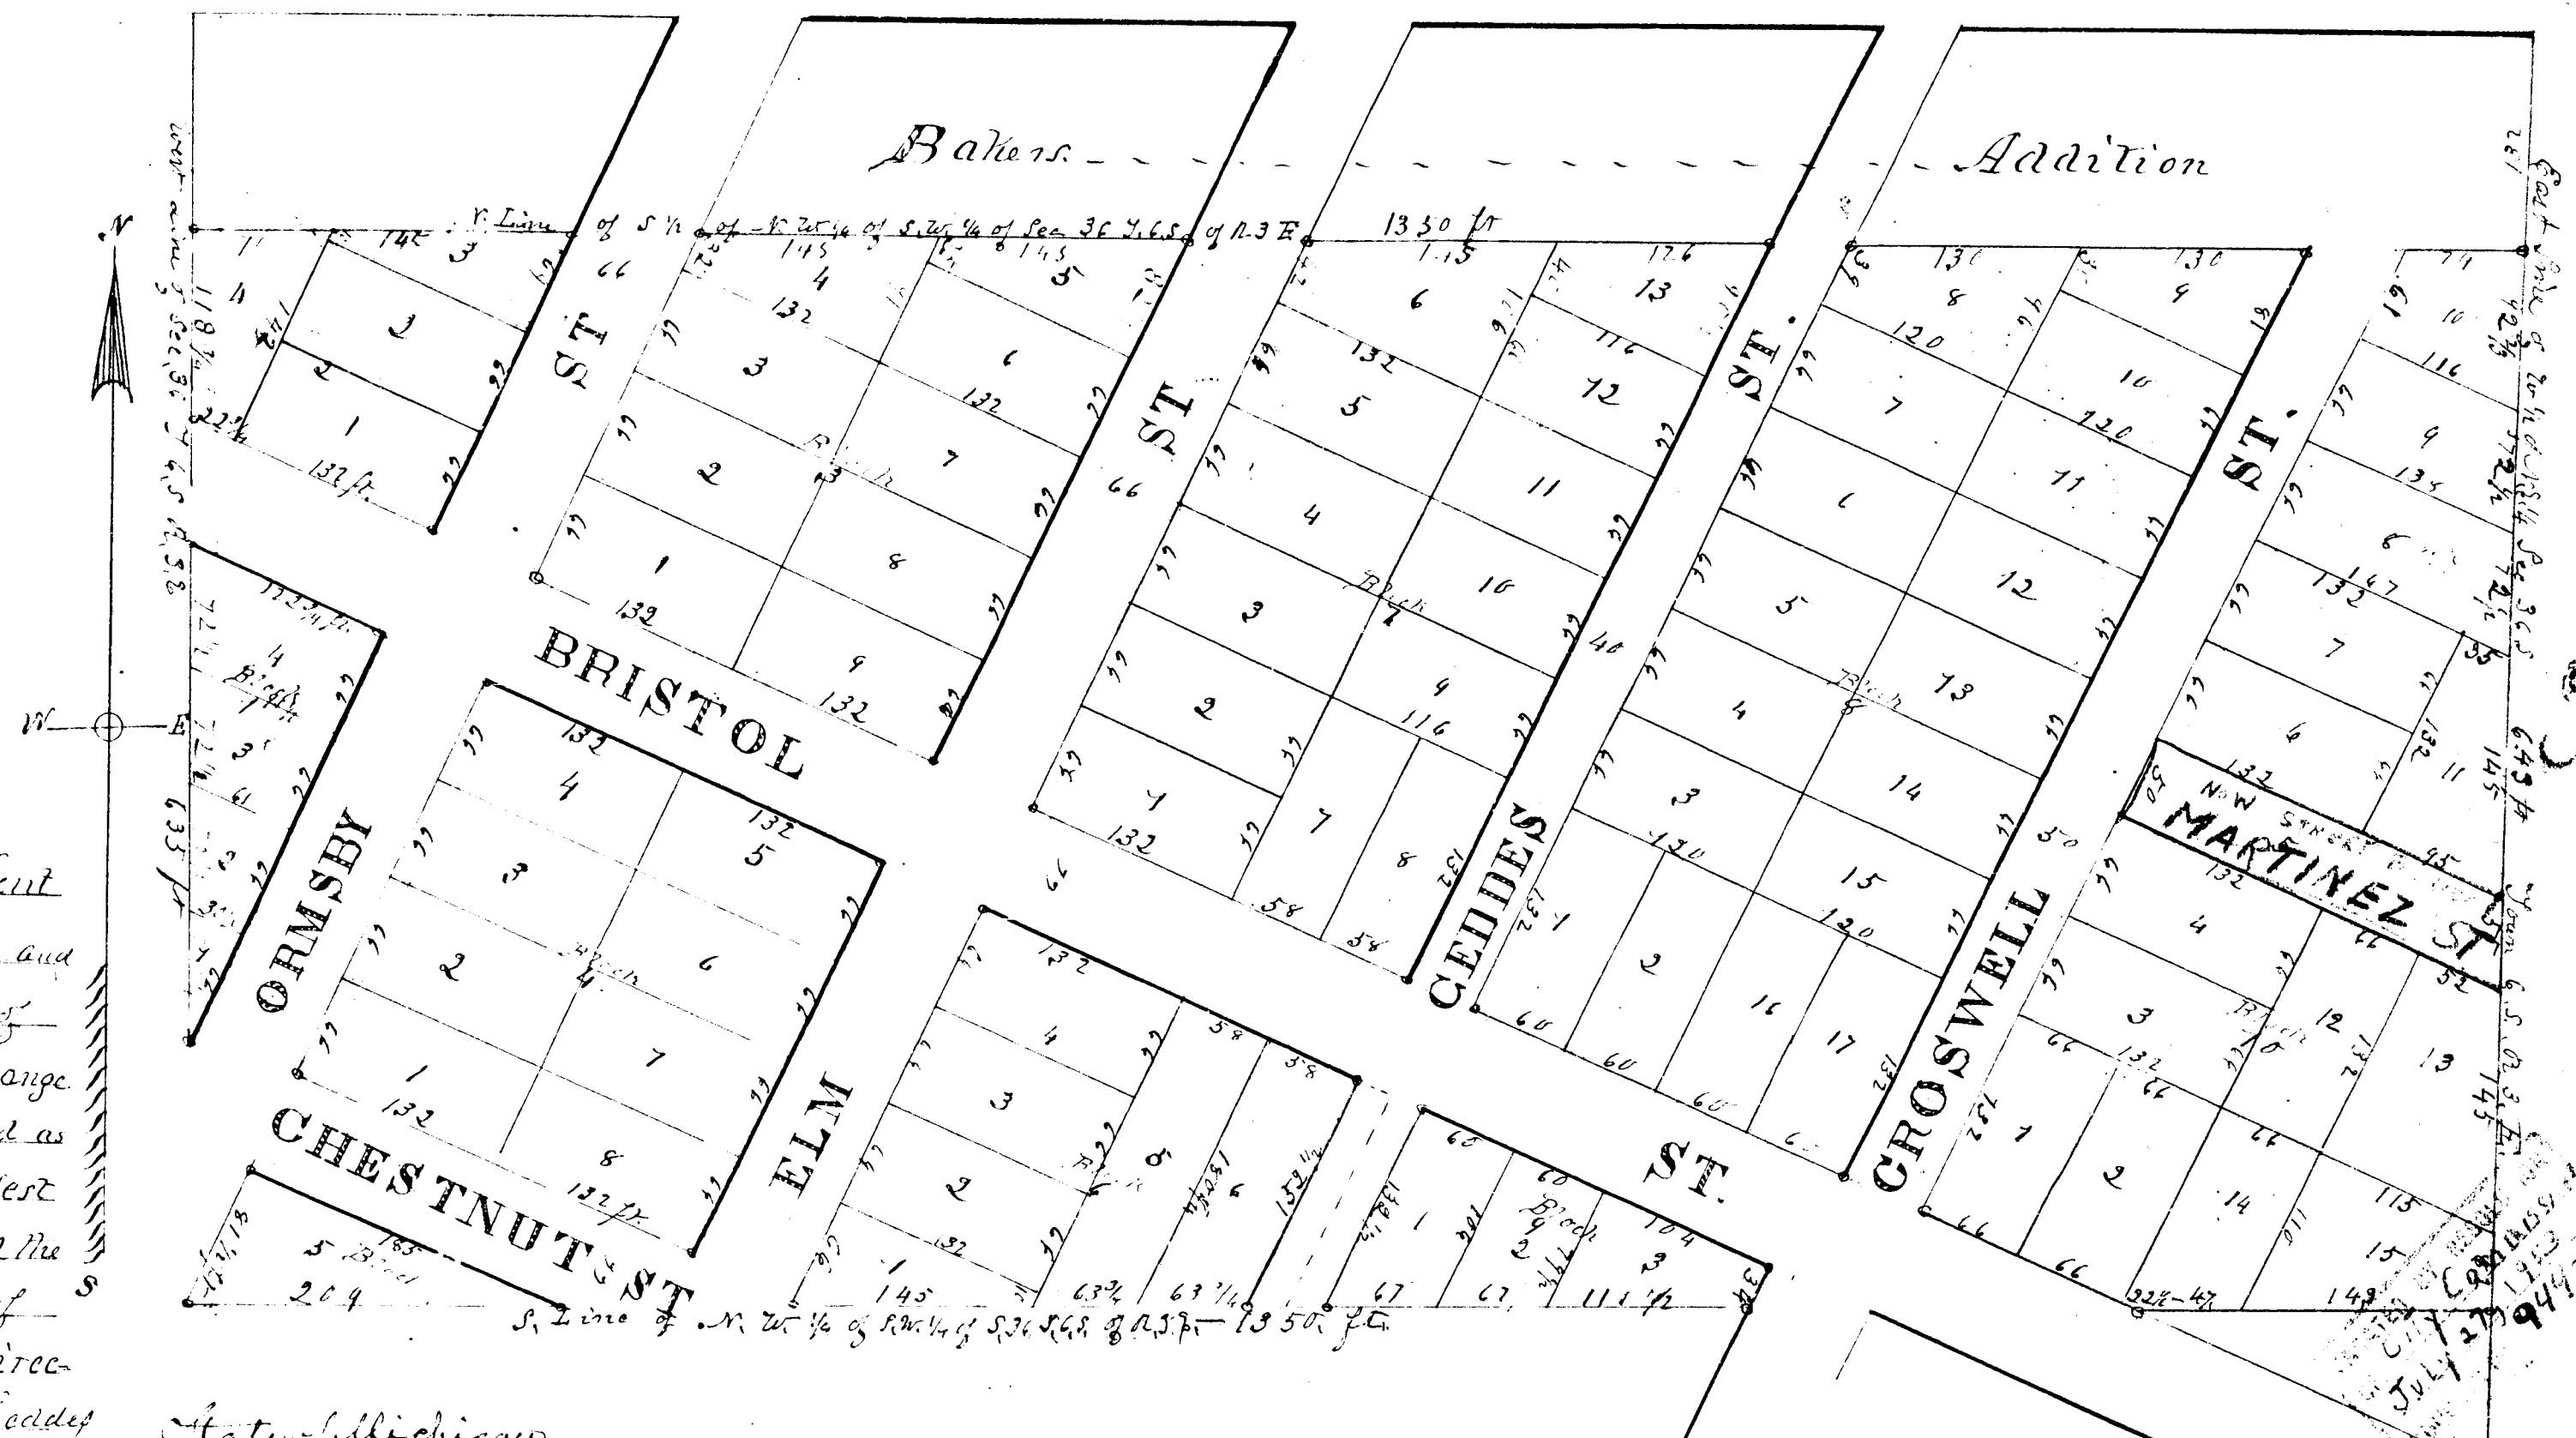

Know all men by these presents, that I, Burton Hunt civil Engineer and Surveyor, of Adrian County of Lenawee and State of Michigan, have surveyed and Platted all that part of Section Number thirty six (36) Township Six (6) South, of Range Three East Meridian of Michigan, known and designated as the South half of the North West Quarter of the South West Quarter thereof, containing twenty acres more or less, And the foregoing is a full, true, and correct Map and Plat of Said Lands, the same having been done, under the direction and in behalf of Lucy E. Groswell and Norman Geddes of the City of Adrian, State and County aforesaid, And the same is to be known and recognized as (Croswell and Geddes' Addition to the City of Adrian). And we, Samuel Groswell and Norman Geddes, Owners and proprietors of the above described Lands, have caused the above mentioned Survey and the annexed plat thereof to be made by the said Burton Hunt, Engineer and Surveyor, and have given unto the name of Groswell and Geddes' Addition to the City of Adrian, as aforesaid, and we do hereby give grant, and dedicate to the public, to be used for the purposes designated all lands marked as Streets and shown on said Plat.

Given under our hands and Seal this 21st day of September 1887.
Burton Hunt, Engineer and Surveyor.
Samuel Groswell, Owner.
Norman Geddes, Owner.

State of Michigan
County of Lenawee
Personally appeared before me, a Notary Public, in and for said County, the above named Burton Hunt, Samuel Groswell, and Norman Geddes, to me known to be the same persons who executed the annexed Plat and Instruments, and acknowledged that they executed the same for the purposes herein expressed, and I have signed these presents and caused them to be sealed and attested.

State of Michigan
County of Lenawee
On this 21st day of December AD 1887, before me Notary Public in and for said County personally appeared Samuel Geddes, wife of Norman Geddes, to me known to be the same person, who by that name executed the annexed plat and instruments and acknowledged that she executed the same for the uses and purposes therein expressed and implied as her free act and deed.

Examined and approved
December 11th 1890.
A. R. Hall
Deputy Auditor General

I hereby certify that the plat herein delineated is a correct one and that permanent monuments, consisting of iron pipe, stakes, three inches in diameter, set in concrete, one to two feet in length, have been placed at each point, marked thereon, as shown on the plat, and are in the boundaries of the land platted and are well exposed to view.

State of Michigan
County of Lenawee
We Alfred W. Smith, Register of Deeds and Burton Hunt, Surveyor, hereby certify that we have carefully compared this copy with the original plat of Groswell and Geddes' Addition to the City of Adrian and that it is a true and correct copy thereof and of the whole of such original map and plat.

State of Michigan
Register of Deeds
County of Lenawee
Received for Record the 3rd day of January AD 1891, at 10 o'clock A. M. and recorded in Record of Village & City Plats on page 37.
Alfred W. Smith, Register

State of Michigan
County of Lenawee
We Alfred W. Smith, Register of Deeds and Burton Hunt, Surveyor, hereby certify that we have each carefully compared the annexed copy with the plat of Groswell and Geddes' Addition to the City of Adrian now of record in the office of the said Register of Deeds, and that it is a true and correct copy thereof and of the whole of such original map and plat.

13576

Scale 100 ft. to 1 inch