


PLAT OF
DREXEL PARK
AN ADDITION TO
ADRIAN CITY,
LENAWEE CO. MICHIGAN.

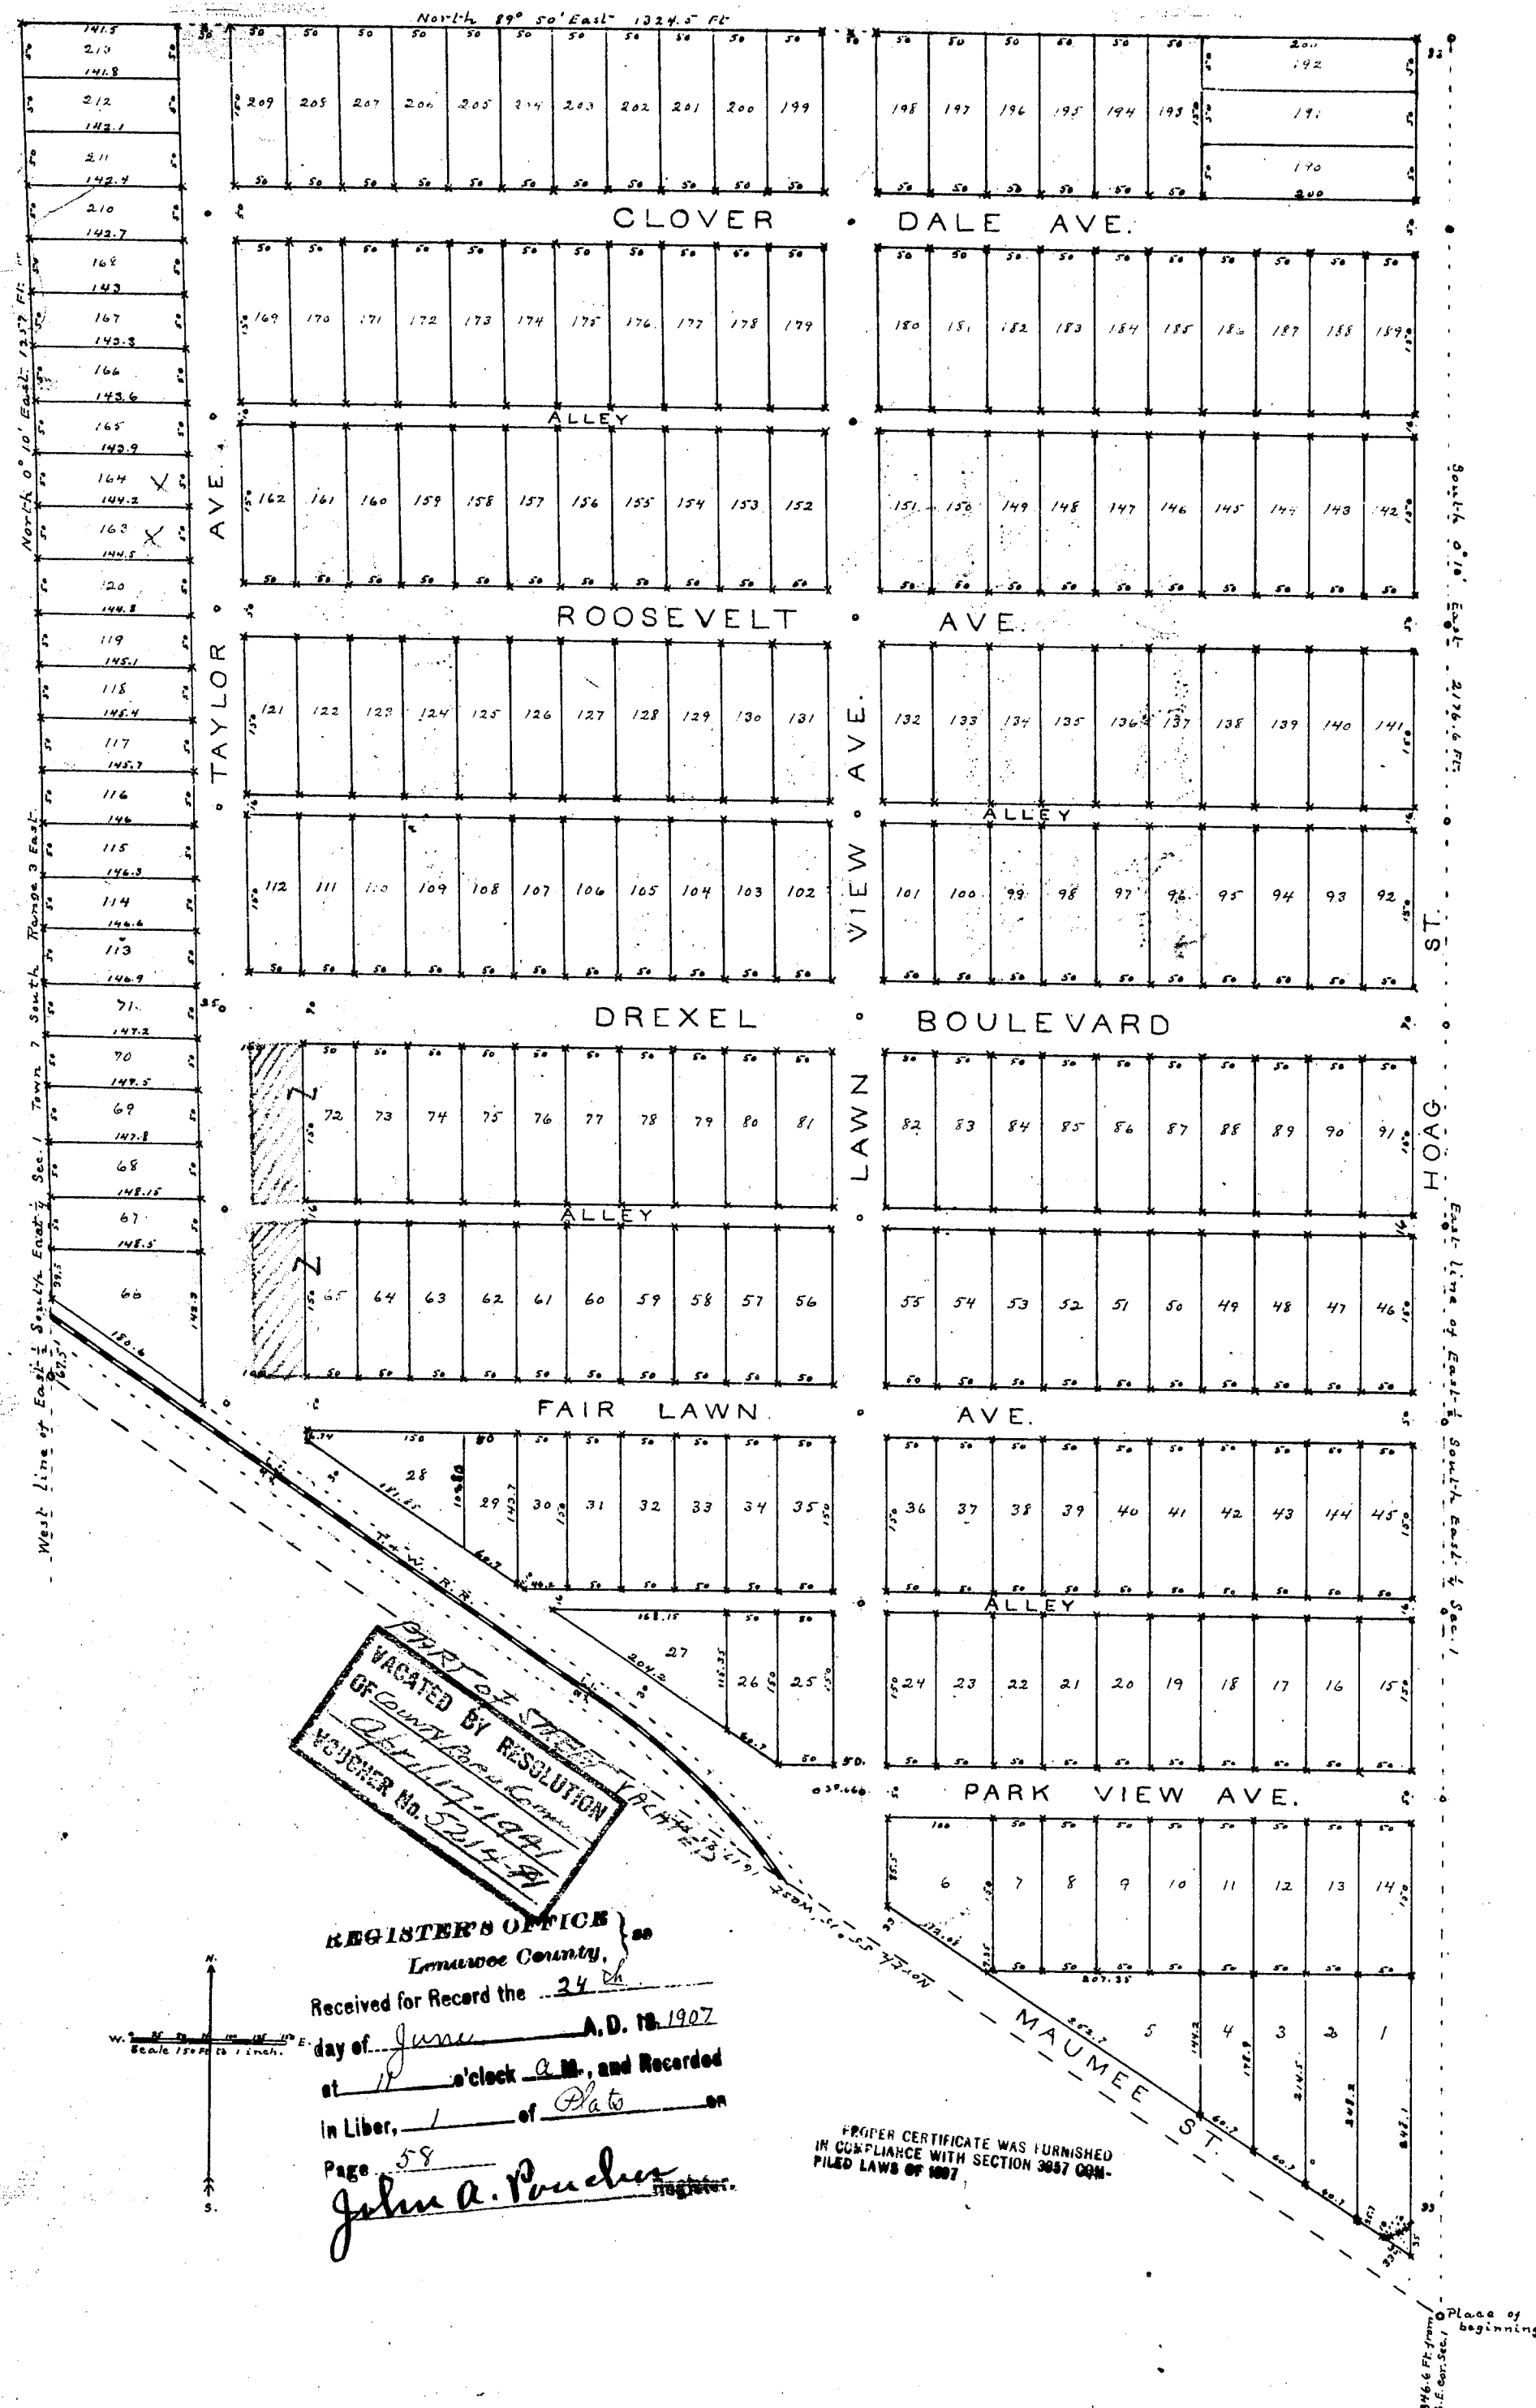

REGISTER'S OFFICE
Lenawee County,
Received for Record the 24th
day of June, A.D. 1907
at 1 o'clock A.M. and Recorded
in Liber. 1 of Date
Page 58
John A. Pouchier, Register.

PROPER CERTIFICATE WAS FURNISHED
IN COMPLIANCE WITH SECTION 3687 OSM.

DEDICATION

KNOW ALL MEN by these Presents, That I, J. W. Taylor (unmarried), as proprietor, have caused the land embraced in the annexed plat to be surveyed, laid out and platted, to be known as DREXEL PARK, an addition to ADRIAN CITY, LENAWEЕ CO. MICHIGAN and that the streets and alley as shown on said plat are hereby dedicated to the use of the public.

SIGNED AND SEALED IN PRESENCE OF

John A. Pouchier
Eva M. Shandley

J. W. Taylor

STATE OF MICHIGAN

County of Lenawee

On this 27th day of May, 1907, before me, a Notary Public

in and for said county, personally came the above named J. W. Taylor (single)

known to me to be the person who executed the above dedication,

and acknowledged the same to be his free act and deed.

John A. Pouchier

Notary Public (L.S.)
My commission expires Dec. 20th 1908.

DESCRIPTION OF LAND PLATTED.

The land embraced in the annexed plat of DREXEL PARK an addition to ADRIAN CITY, LENAWEЕ CO. MICHIGAN is described as follows; Commencing at a point in the east line of the east $\frac{1}{2}$ of the southeast $\frac{1}{4}$ of section 1 Town 7 South, Range 3 East, Meridian of Michigan 346.6 ft. north from the southeast corner thereof and running north $55^{\circ}15'$ west, 1617.25 ft. to the west line of said east $\frac{1}{2}$ of the southeast $\frac{1}{4}$ of section 1, thence north $0^{\circ}10'$ east along said line 1257 ft. thence north $89^{\circ}50'$ east 1324.5 ft. to the east line of the east $\frac{1}{2}$ of the southeast $\frac{1}{4}$ of section 1, thence south $0^{\circ}10'$ east 2176.6 ft. to the place of beginning.

SURVEYOR'S CERTIFICATE

I hereby certify that the plat hereon delineated is a correct one, and that permanent monuments, consisting of stakes and iron pipes have been planted at points marked thus (x) stakes (o) iron pipes as thereon shown at all angles in the boundaries of the land platted, and at all intersections of streets or streets and alleys.

Examined and Approved
June 1st 1907
John F. Wilkinson
Deputy Auditor General.

J. L. Richard
Surveyor.

STATE OF MICHIGAN

County of Lenawee

We, John A. Pouchier, Register of Deeds, and J. L. Richard, Surveyor,

hereby certify that we have each carefully compared this copy with the original plat of DREXEL PARK an addition to ADRIAN CITY, LENAWEЕ CO. MICHIGAN and that it is an exact copy thereof and of the whole of such original map or plat.

John A. Pouchier
J. L. Richard

Register of Deeds.
Surveyor.

STATE OF MICHIGAN

County of Lenawee

We, John A. Pouchier, Register of Deeds, and J. L. Richard, Surveyor,

hereby certify that we have each carefully compared the annexed copy with the plat of DREXEL PARK an addition to ADRIAN CITY, LENAWEЕ CO. MICHIGAN now of record in the office of said Register of Deeds, and that it is a true transcript therefrom and of the whole of such record.


RECEIVED AND FILED
IN AUDITOR GENERAL'S OFFICE,
JUL 15 1907
John F. Wilkinson
Deputy Auditor General.

John A. Pouchier
J. L. Richard

Register of Deeds.
Surveyor.

13596

PLAT OF
DREXEL PARK
AN ADDITION TO
ADRIAN CITY,
LENAWEE CO. MICHIGAN.

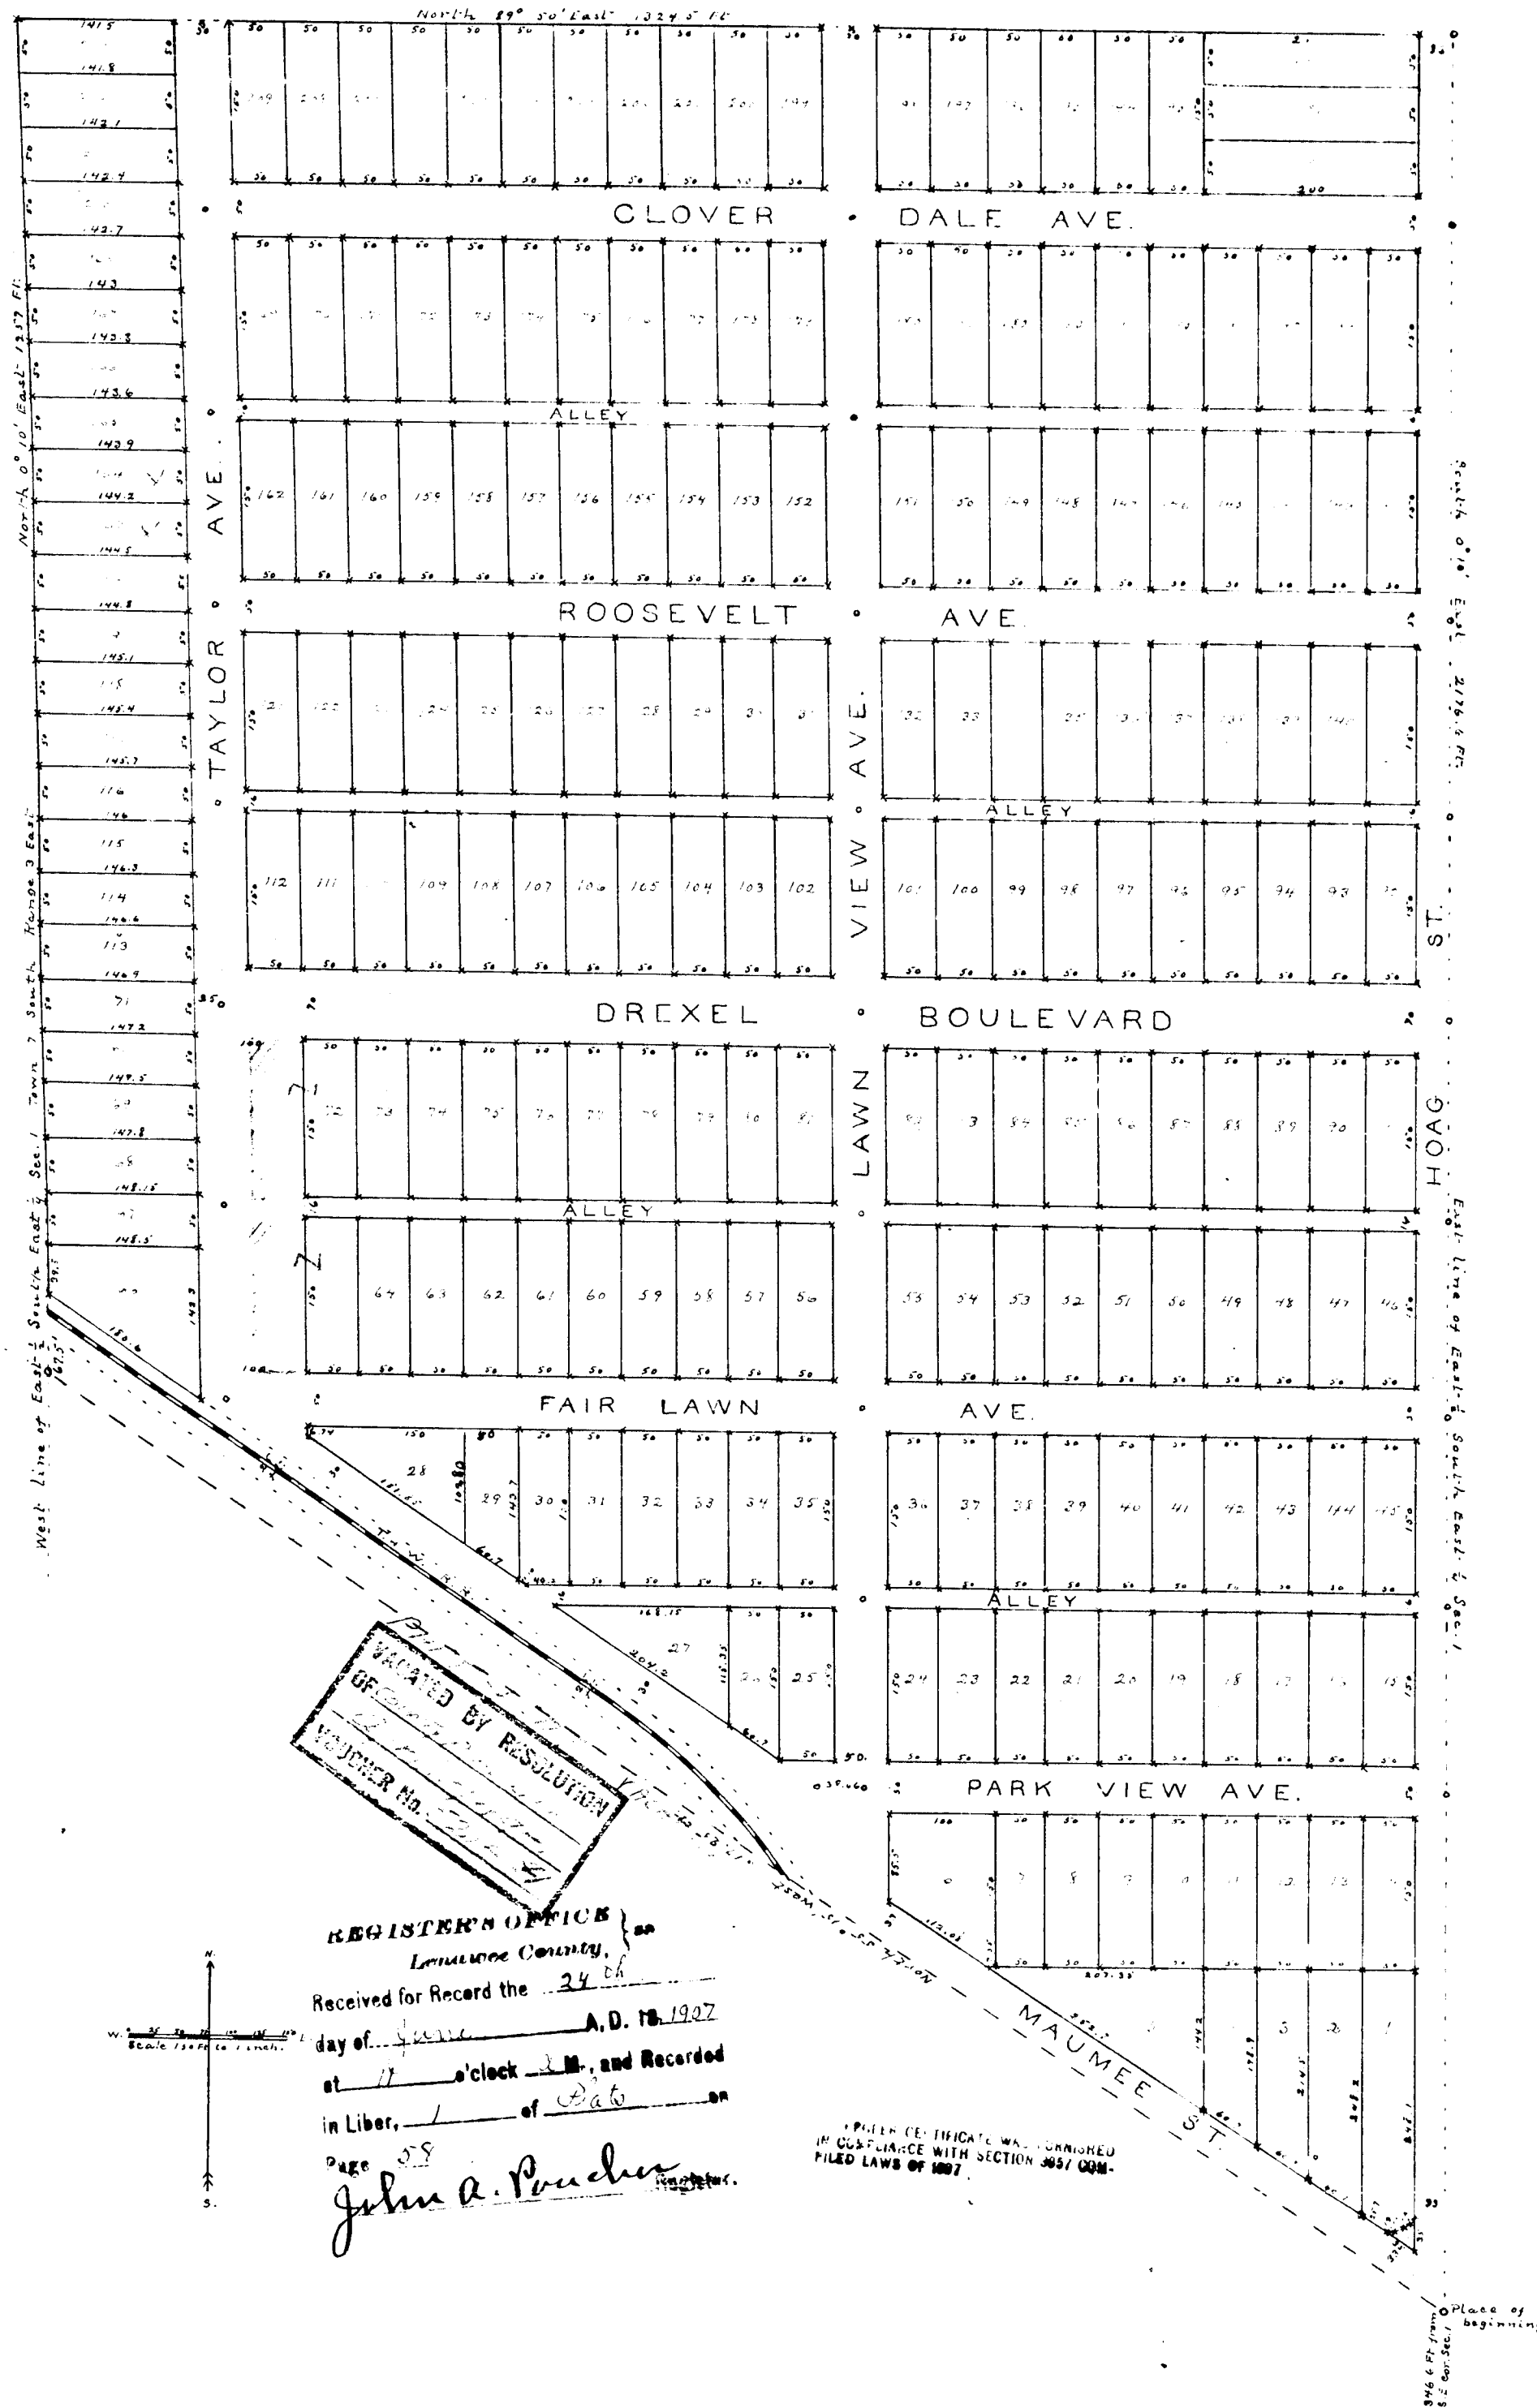

DEDICATION

KNOW ALL MEN by these Presents, That I, J. W. Taylor (unmarried) as proprietor, have caused the land embraced in the annexed plat to be surveyed, laid out and platted, to be known as DREXEL PARK, an addition to ADRIAN CITY, LENAWEЕ CO. MICHIGAN and that the streets and alley as shown on said plat are hereby dedicated to the use of the public.

SIGNED AND SEALED IN PRESENCE OF

John A. Poucher
Ever M. Sandberg

STATE OF MICHIGAN

County of Lenawee

On this 27th day of May, 1907, before me, a Notary Public

in and for said county, personally came the above named J. W. Taylor (single) known to me to be the person who executed the above dedication, and acknowledged the same to be his free act and deed.

John A. Poucher
Notary Public (L.S.)
My commission expires Dec 20th 1908

DESCRIPTION OF LAND PLATTED.

The land embraced in the annexed plat of DREXEL PARK an addition to ADRIAN CITY, LENAWEЕ CO. MICHIGAN is described as follows; Commencing at a point in the east line of the east $\frac{1}{2}$ of the southeast $\frac{1}{4}$ of Section 1 Town 7 South, Range 3 East, Meridian of Michigan 346.6 ft north from the southeast corner thereof and running north $85^{\circ} 15'$ west, 1617.25 ft to the west line of said east $\frac{1}{2}$ of the southeast $\frac{1}{4}$ of Section 1, thence north $0^{\circ} 10'$ east along said line 1257 ft, thence north $89^{\circ} 50'$ east 1224.5 ft to the east line of the east $\frac{1}{2}$ of the southeast $\frac{1}{4}$ of Section 1, thence south $0^{\circ} 10'$ east 2176.6 ft to the place of beginning.

SURVEYOR'S CERTIFICATE

I hereby certify that the plat hereon delineated is a correct one, and that permanent monuments, consisting of stakes and iron pipes have been planted at points marked thus (x) stakes (o) iron pipes as thereon shown at all angles in the boundaries of the land platted, and at all intersections of streets or streets and alleys.

Examined and Approved
June 1st 1907
John H. Wilkinson
Deputy Auditor General.

J. L. Richard
Surveyor.

STATE OF MICHIGAN

County of Lenawee

We, John A. Poucher, Register of Deeds, and J. L. Richard, Surveyor,

hereby certify that we have each carefully compared this copy with the original plat of DREXEL PARK an addition to ADRIAN CITY, LENAWEЕ CO. MICHIGAN and that it is an exact copy thereof and of the whole of such original map or plat.

John A. Poucher, Register of Deeds.
J. L. Richard, Surveyor.

STATE OF MICHIGAN

County of Lenawee

We, John A. Poucher, Register of Deeds, and J. L. Richard, Surveyor,

hereby certify that we have each carefully compared the annexed copy with the plat of DREXEL PARK an addition to ADRIAN CITY, LENAWEЕ CO. MICHIGAN now of record in the office of said Register of Deeds, and that it is a true transcript therefrom and of the whole of such record.

RECEIVED AND FILED
IN AUDITOR GENERAL'S OFFICE
JUL 15 1907
John H. Wilkinson
Deputy Auditor General.

John A. Poucher, Register of Deeds.
J. L. Richard, Surveyor.

13596