

Vacation Order
Hillside Avenue from Entire
by Council
City Commission
April 27-1931
Voucher #1203-5/15/31

- Vacation Order -
Entire Alley in Bk #6
Apr. 27-1931
Voucher #1004
5/15/31

Know all men by these presents, that the Geo. T. Smith Middlings Purifier Company a corporation organized and doing business under the laws of the state of Michigan in the city and county of Jackson, in said state, as proprietor by Geo. T. Smith its president, duly authorized, has caused the land described herewith and embraced in the annexed map or plat, to be surveyed laid out and platted to be known as Geo. T. Smith's Addition to the city of Jackson; that the streets and alleys as shown on said map or plat are hereby dedicated to the Mayor, Recorder and Aldermen of said city of Jackson, and their successors forever, solely for the use of the public as highways.

Signed and sealed in presence of } Geo. T. Smith Middlings Purifier Company
Jno. E. Harmon } Geo. T. Smith
Jno. E. Harmon } Pres.

State of Michigan } ss.
County of Jackson }

On this 15th day of July A.D. 1889 personally appeared before me a notary public in and for said county, Geo. T. Smith, to me known to be the president of the Geo. T. Smith Middlings Purifier Company, a corporation, the grantor named in the foregoing instrument and acknowledged that he executed the same as the free act and deed of said corporation by him as its president duly authorized for such purpose, and that the corporate seal thereunto attached is the corporate seal of said company.

Jno. E. Harmon
Notary Public Jackson County Michigan

DESCRIPTION OF LAND PLATTED

The land described and embraced in the annexed map or plat of Geo. T. Smith's Addition to the city of Jackson, Michigan is described as follows; being in the north east quarter of section thirty three (33) of town two (2) south range one (1) west with boundaries as follows, commencing at a point forty (40) feet east and thirty three (33) feet south of the center post of said section 33 - (said point of commencement being thirty three (33) feet south and twenty six hundred eight (2608) feet west of the east quarter post of said section 33) thence east parallel with the east and west quarter line of said section twelve hundred eighty four (1284) feet to the north and south center line of the northeast quarter of said section thence north on said center line seven hundred eighty one (781) feet to the north line of Hallett Street produced from Webster's Highland Addition, thence west fifty (50) feet, thence north parallel with the center line of said section eight hundred thirty five and fifty six one hundredths (835.56) feet to the north line of North Street produced - thence west on the north line of North Street twelve hundred thirty four (1234) feet to a point forty (40) feet east of the north and south quarter line of said section 33, thence south sixteen hundred sixteen and fifty six one hundredths (1616.56) feet to the place of beginning.

I hereby certify that the map or plat hereon delineated is a correct one of the land above described, and that permanent monuments consisting of iron pipe 1/2" diameter 30" long have been planted at all points marked thus (o) as thereon shown at all angles in boundaries of the land platted and at all intersections of streets or streets and alleys

Chas. B. Hyde
Surveyor

Witnesses to monuments
A. Maple 12" x 8 3/4" W. 12.0 ft Maple 10" x 7 1/2" E. 6.45 ft
B. Elm 20" x 8 1/2" W. 42.9 ft Elm 8" x 4 1/2" W. 52.8 ft
C. Elm 20" x 8 1/2" W. 28.9 ft Maple 8" x 9 1/2" E. 101.4 ft

Examined and approved August 2-1889.

H. R. Pratt. Deputy Auditor General.

State of Michigan } ss.
County of Jackson }

We, Chas. B. Townsend Register of Deeds and Chas. B. Hyde Surveyor, hereby certify that we have each carefully compared this copy with the original plat of Geo. T. Smith's Addition to the city of Jackson and that it is an exact copy thereof, and of the whole of such original map or plat.

Chas. B. Townsend Register of Deeds

Chas. B. Hyde Surveyor

Received for record the 22nd day of August A.D. 1889 at 2 o'clock
P.M. and recorded in Book 9 of Plats Page 9.

Chas. B. Townsend Register of Deeds.

State of Michigan } ss.
County of Jackson }

We, Chas. B. Townsend Register of Deeds and Chas. B. Hyde Surveyor, hereby certify that we have each carefully compared the annexed copy with the plat of Geo. T. Smith's Addition to the city of Jackson, now of record in office of said Register of Deeds, and that it is a true transcript therefrom and of the whole of such record.

Chas. B. Townsend Register of Deeds.

Chas. B. Hyde Surveyor.


ORDER OF VACATION

BELLE AVE. from S. line of Hallett St
to N. line of Garrison St Vacated by
Resolution of city commission
adopted Nov 8-1915

Voucher 1358-1927

GEO. T. SMITH'S ADDITION TO THE CITY OF JACKSON MICHIGAN.

Scale: 120 feet equal on inch. Scale of feet.
Iron stakes indicated thus (o).

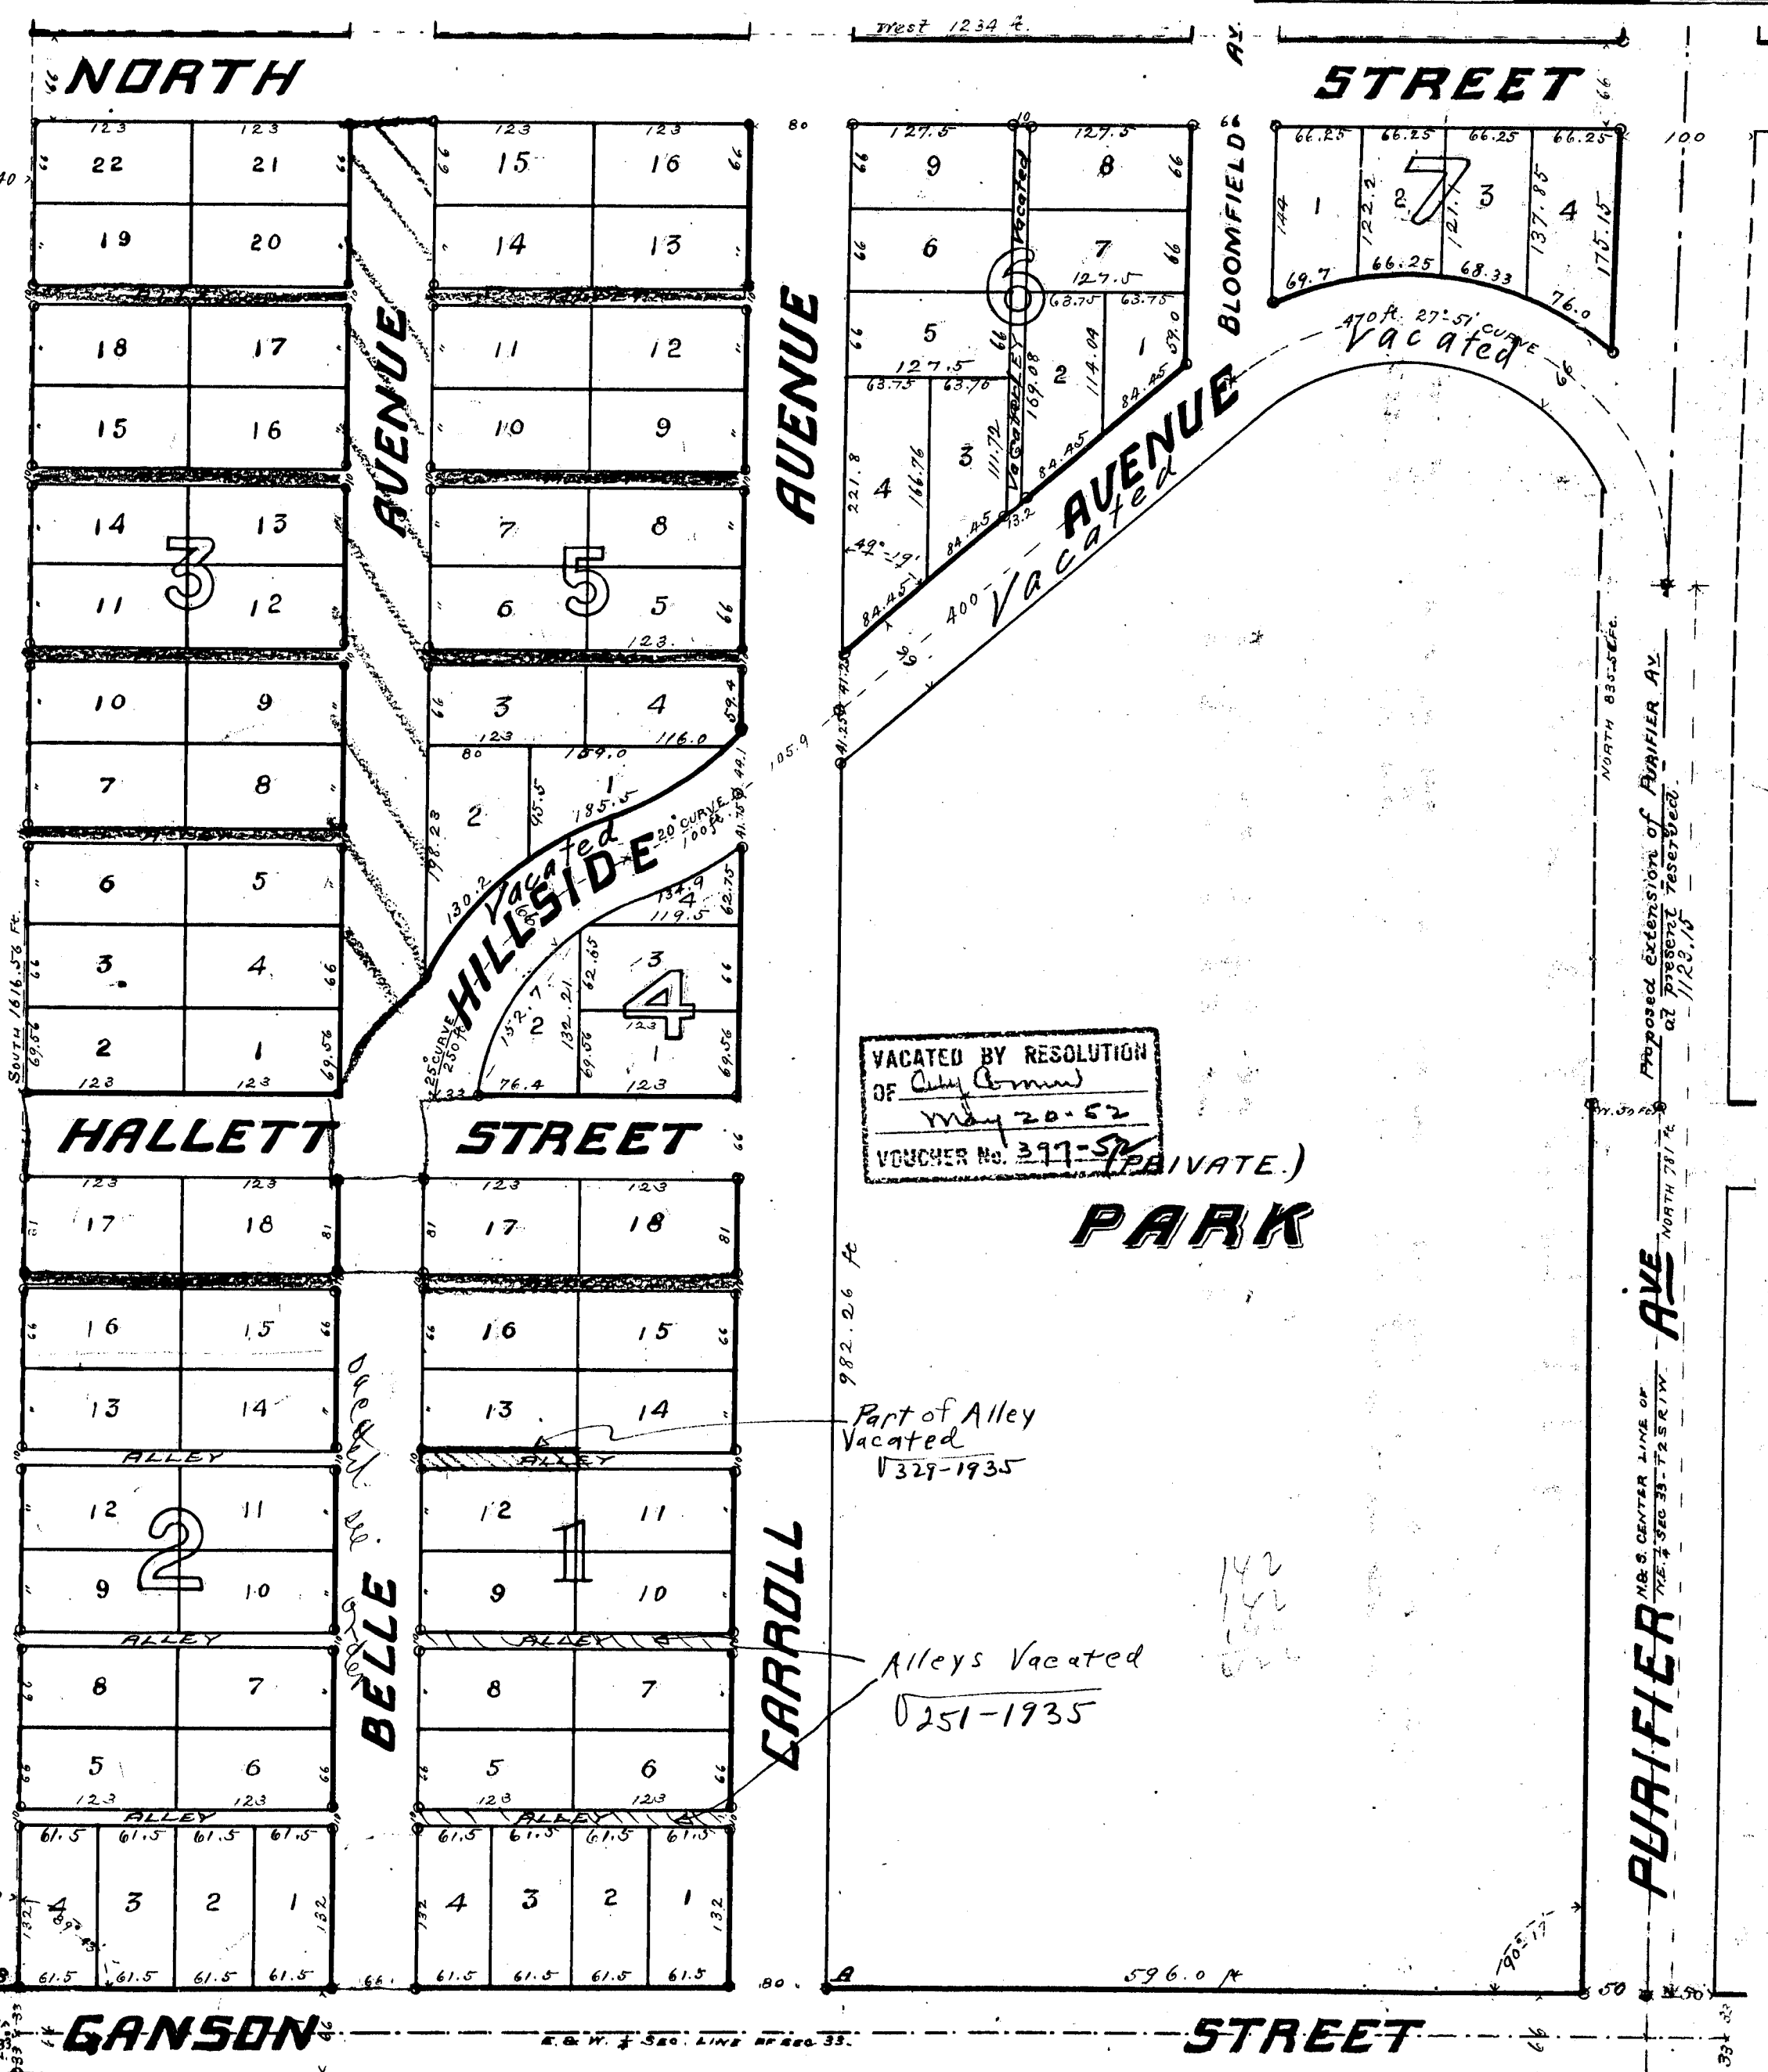

Received and Filed
in Auditor General's Office
April 4-1931
Deputy Auditor General

2541

13796

Voucher #1003 - 5/15/31 DEDICATION

Signed and Sealed in presence of
M. Harmon
Jno. E. Winn

On this 15th day of July A.D. 1889 personally appeared before me a notary public in and for Saddle County Geo. T. Smith, to me known to be the president of the Geo. T. Smith Haddings Purifier Company, a corporation, the grantor named in the foregoing instrument and acknowledged that he executed the same as the free act and deed of said corporation by him as its president duly authorized for such purpose and that the corporate seal thereunto attached is the corporate seal of said company.

Mr. E. Winn

The land described and embraced in the annexed map or plat of Geo T. Smith's Addition to the city of Jackson, Michigan is described as follows; being in the north east quarter of section thirty three (33) of town two (2) South range one (1) west with boundaries as follows, commencing at a point forty (40) feet east and thirty three (33) feet south of the center post of said section 33. (said point of commencement being thirty three (33) feet south and twenty six hundred eight (2608) feet west of the east quarter post of said section 33) thence east parallel with the east and west quarter line of said section twelve hundred eighty four (1284) feet to the north and south center line of the northeast quarter of said section, thence north in said center line seven hundred eighty one (781) feet to the north line of Hall's Street produced from Nebster's Highland Addition. thence west fifty (50) feet, thence north parallel with the center line aforesaid, eight hundred thirty five and fifty six one hundredths (835 $\frac{56}{100}$) feet to the north line of North street produced. thence west on the north line of North street twelve hundred thirty four (1234) feet to a point forty (40) feet east of the north and south quarter line of said section 33, thence south sixteen hundred sixteen and fifty six one hundredths (1616 $\frac{56}{100}$) feet to the place of beginning.

I hereby certify that the map or plat hereon delineated is a correct one of the land above described, and that permanent monuments consisting of iron pipe $1\frac{1}{2}$ " diameter 30" long have been planted at all points marked thus (o) as thereon shown at all angles or boundaries of the land platted and at all intersections of streets or streets and alleys.

Witnesses to monuments.

A. Maple 12" N. 83½° W. 12.0 ft Maple 10" N. 75½° E. 4.45 ft
 B. Elm 20" S. 85½° W. 42.9 ft Elms N 48½° W. 52.8 ft
 C. Elm 20" N. 4½° W. 28.7 ft Maple 8" S. 9½° E. 101.0 ft.

Examined and approved August 2. 1889.

H. R. Pratt. Deputy Auditor General.

State of Michigan } S.S.
County of Jackson }

County of Jackson } ss. We Chas. E. Townsend Register of deeds and Chas. B. Hyde
Surveyor, hereby certify that we have each carefully compared this copy with
the original plat of Geo. T. Smith's Addition to the city of Jackson and that it
is an exact copy thereof, and of the whole of such original map or plat.

Chas. E. Townsend Register of Deeds

Chas B. Hyde, Surveyor

Received for record the ^{2nd} day of August A.D. 1889 at 2 o'clock
A.M. and recorded in Letter ^{of} Plats page 9.

Chas. C. Johnson Register of Deeds.

State of Michigan } ss.
County of Jackson }

County of Jackson } ss. We Chas. E. Townsend Register of Deeds and Chas. B. Hyde
surveyor, hereby certify that we have each carefully compared the annex-
ed copy with the plat of Geo. T. Smith's Addition to the city of Jackson, now
of record in office of said Register of deeds, and that it is a true transcript
therefrom and of the whole of such record. 6 117

Chas E. Thompson, Register of Deeds.

Chas B. Hyde Surveyor.

ORDER OF VOUCHER


BELLE AVE. from E. King to Hallam St
to N. 1st St. Harrison St. Varied by
K. 1st St. to Harrison St.

University 1355-1429

Voucher # 1004

TO THE CITY OF JACKSON MICHIGAN.

Scale: 120 feet equal on inch. *Scale of feet.*
Iron stakes indicated thus (·).

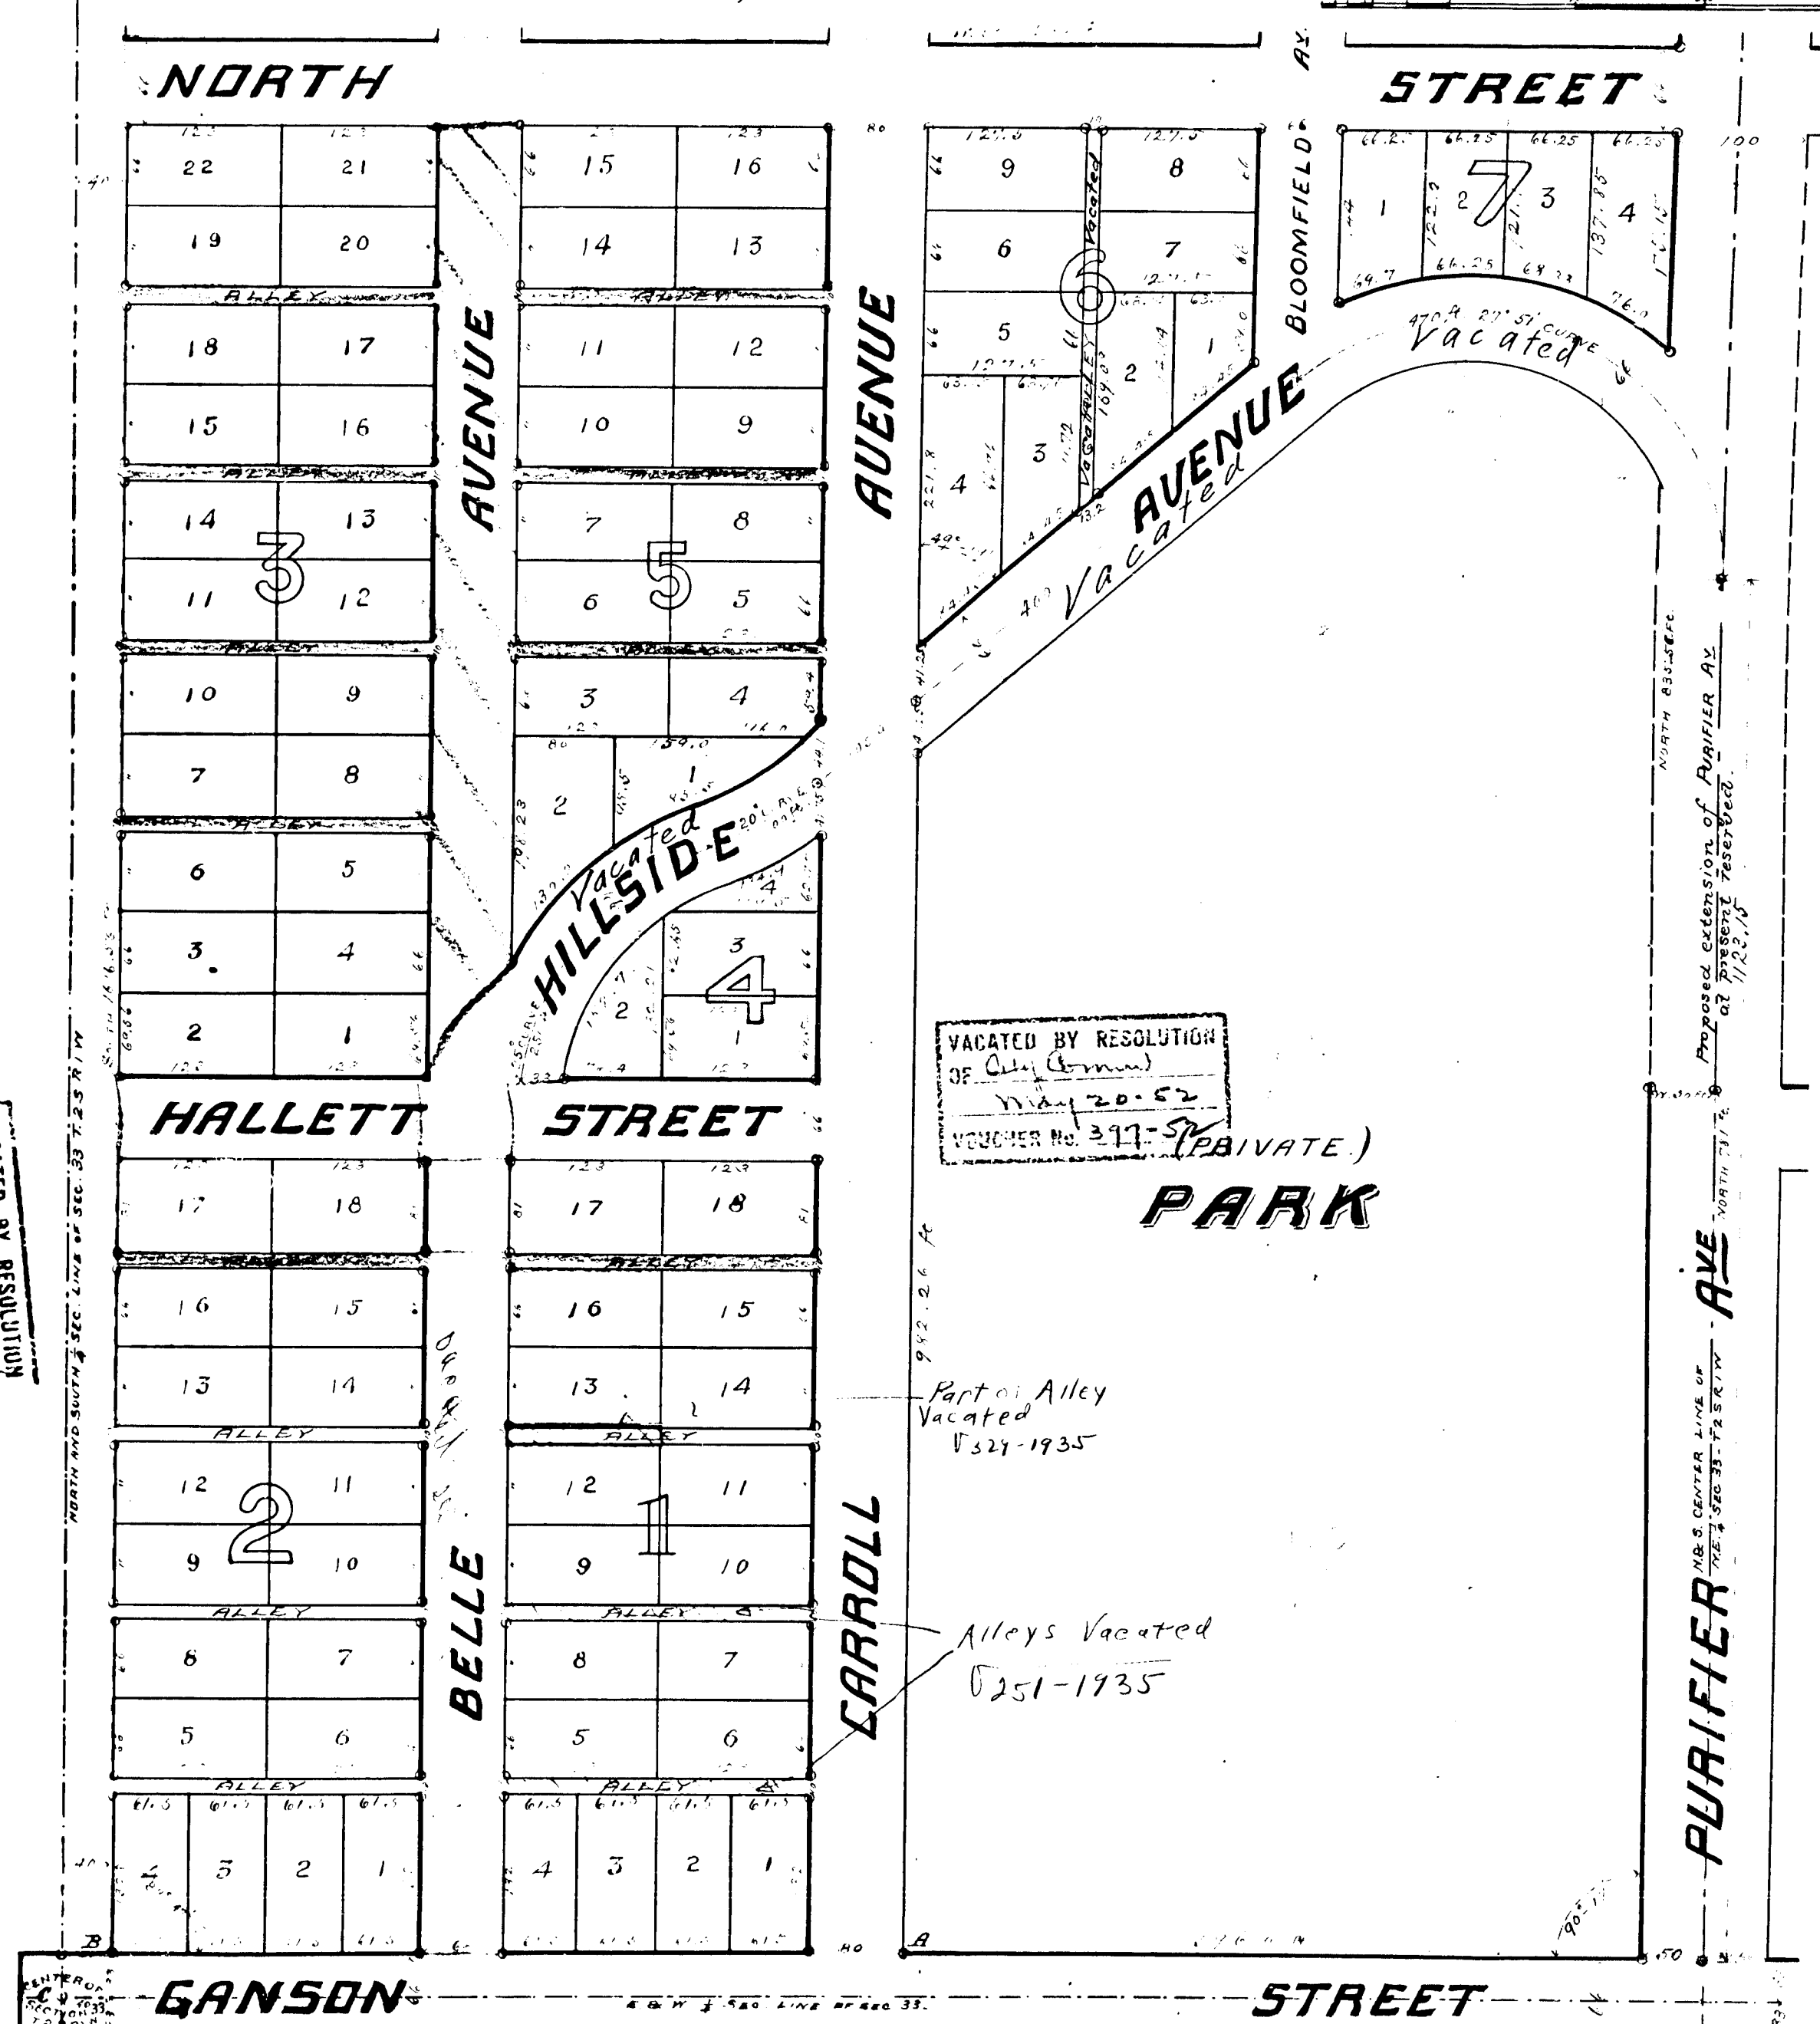

N.B. Intersections of lot and street lines are not exactly at right angles; said lines being laid parallel to the $\frac{1}{4}$ sec. lines with angles as sh

Received and Filed
IN AUDITOR GENERAL'S OFFICE
September 4, 1989
H. R. Smith
Deputy Auditor General

2841

13796