

Blocks 9-10-11 Deeded to City as
streets also 7' wide on S. side of
lot 1-14 & lot 14. All S.
Voucher # 1336-7-6-31



VACATION ORDER
of parts of all alleys in
blocks 8-9-10-11-12 vacated
by City Commission Dec. 27-1889
Voucher # 1004-5/11/81

Geo. T. Smith's

Addition Number 2, To the City of Jackson Michigan

Scale: 120 Ft = 1 Inch.

Received and Filed
IN AUDITOR GENERAL'S OFFICE
November 8 1889
By Auditor General

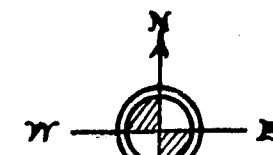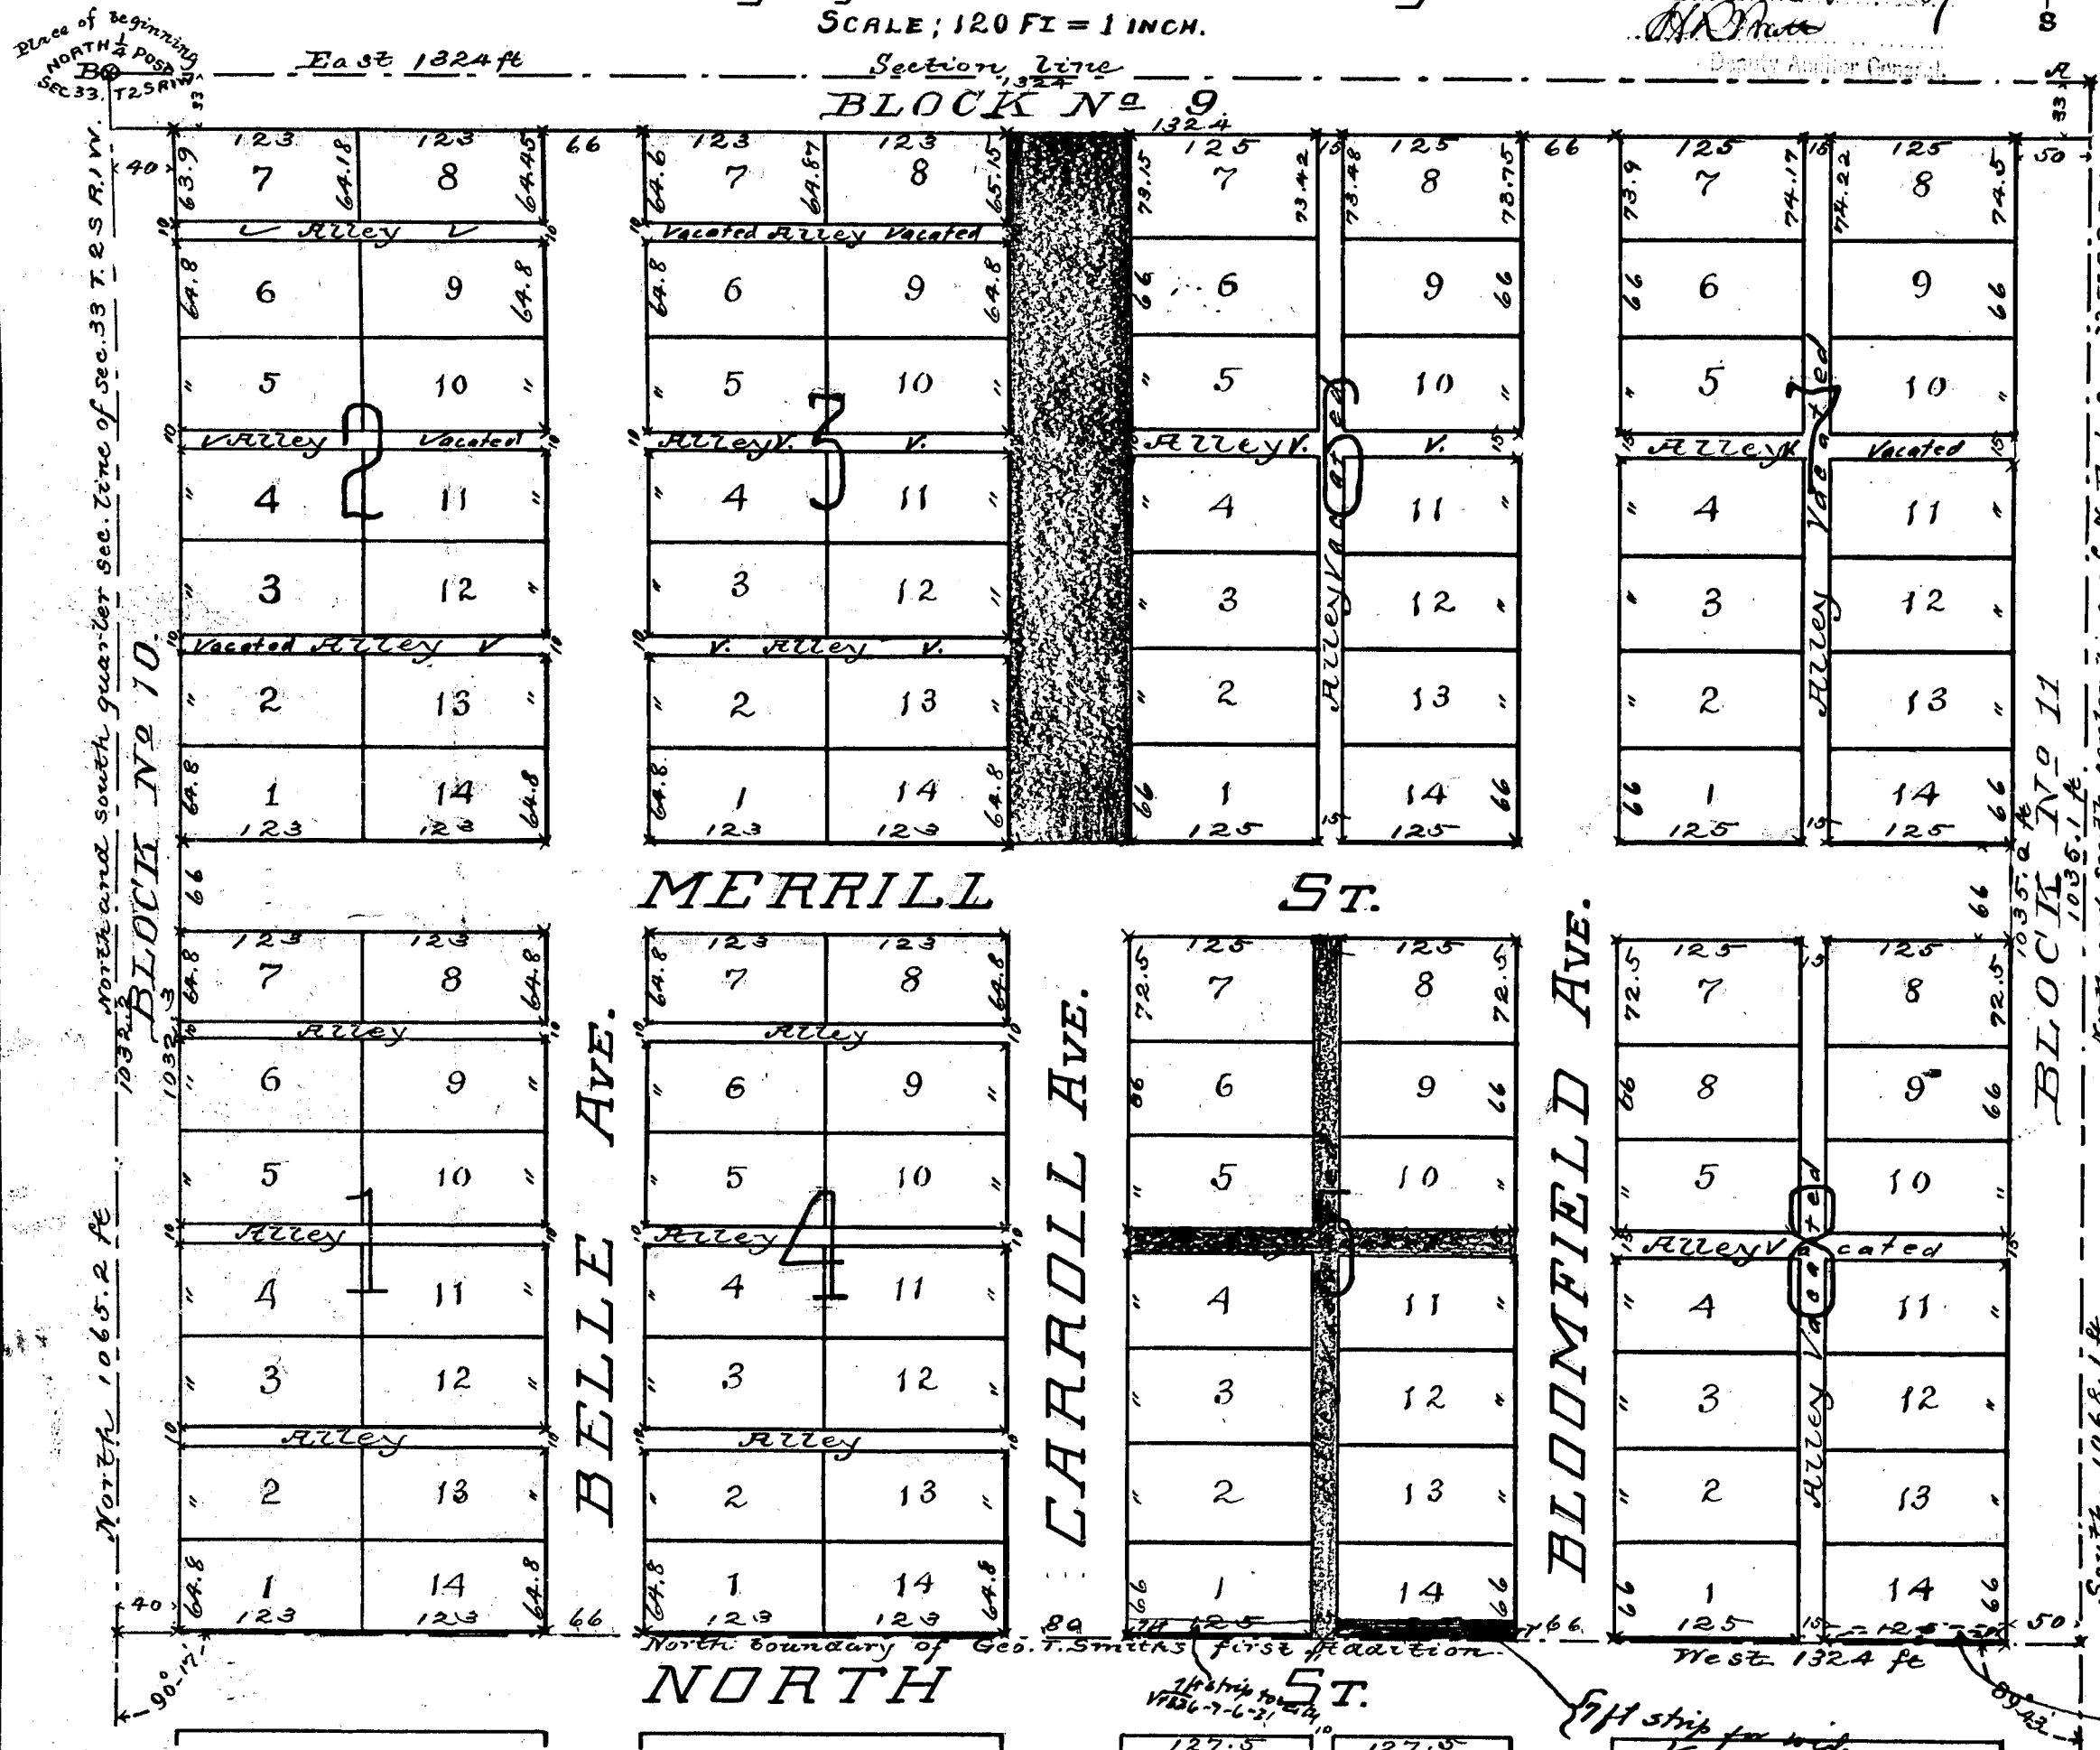

Dedication
Know all men by these presents, that the Geo. T. Smith Mouldings Purifier Company a corporation organized and doing business under the laws of the state of Michigan, in the city and county of Jackson in said state, as proprietor by Geo. T. Smith its president duly authorized, has caused the land described herewith and embraced in the annexed map or plat to be surveyed laid out and platted to be known as Geo. T. Smith's Addition Number 2, to the city of Jackson Michigan; that the streets and alleys as shown on said map or plat are hereby dedicated to the Mayor, Recorder and Aldermen of said city of Jackson solely for the use of the public as highways
Signed and sealed in presence of
J. H. Dickey
Julian J. Bennett
Geo. T. Smith Pres.
of Geo. T. Smith Mouldings Purifier Co.

State of Michigan } ss
County of Jackson }
On this 28th day of October A.D. 1889 personally appeared before me a Notary Public in and for said county, Geo. T. Smith to me known to be the president of the Geo. T. Smith Mouldings Purifier Company, a corporation, the grantor named in the foregoing instrument, and acknowledged that he executed the same as the free act and deed of said corporation, by him as its president duly authorized for such purpose and that the corporate seal thereunto attached is the corporate seal of said company.

VACATED BY RESOLUTION
OF CITY COMMISSION
DECEMBER 3-1889
VOUCHER No. 716-57

Chas. B. Wood
Notary Public Jackson Co. Michigan.

Description of Land Platted.

The land embraced in the annexed plat of Geo. T. Smith's Addition No. 2, to the city of Jackson Michigan is described as follows, Commencing at a tile monument the quarter post in the north line of section thirty three (33) town two (2) south range one (1) west, thence east along the north line of the section, thirteen hundred twenty four (1324) feet to the north and south center line of the north east quarter of said section, thence south along said center line ten hundred sixty eight and one tenth (1068.1) feet to the north line of North street which is the north boundary of Geo. T. Smith's first Addition, thence west on the north line of North street thirteen hundred twenty four (1324) feet to the north and south quarter line of said section, thence north on said quarter line ten hundred sixty five and two tenths (1065.2) feet to the place of beginning.

I hereby certify that the plat hereon delineated is a correct one and that permanent monuments consisting of iron pipe 36" long have been planted at points marked thus (x) as thereon shown at all angles in the boundaries of the land platted and at all intersections of streets or streets and alleys
Chas. B. Hyde Surveyor.

Examined and Approved November 2 1889.
H. R. Pratt, Deputy Auditor General.

State of Michigan } s.s.
County of Jackson }
We Chas. E. Townsend Register of Deeds and Chas. B. Hyde Surveyor hereby certify that we have each carefully compared this copy with the original plat of Geo. T. Smith's Addition No. 2 to the city of Jackson Michigan and that it is an exact copy thereof and of the whole of such original map or plat.

Chas. E. Townsend Register of Deeds
Chas. B. Hyde Surveyor

Received for record the 7 day of November A.D. 1889 at 11 o'clock A.M. and recorded in Book 4 of Plats on page 12.

Chas. E. Townsend Register of Deeds

Witnesses to Monuments.
A. Elm 12" N. 12° W. 54.5 ft. Poplar 12" S. 84° W. 53 ft.
B. Oak 7" N. 38° E. 22.8 ft. Y. Oak 18" S. 13° W. 13.7 ft.
State of Michigan } ss.
County of Jackson }
We Chas. E. Townsend Register of Deeds and Chas. B. Hyde Surveyor hereby certify that we have each carefully compared the annexed copy with the plat of Geo. T. Smith's Addition No. 2 to the city of Jackson Michigan now of record in the office of said Register of Deeds and that it is a true transcript therefrom and of the whole of such record.

Chas. E. Townsend Register of Deeds,
Chas. B. Hyde Surveyor.

Bloomfield Ave. changed Bryant St
Jan 5-1920
Vol 480-1925

Drawn by W.G. Fargo.

13799


1396-7-6-31

Voucher # 1024 - 5/25/31

Addition Number 2,
To the City of Jackson Michigan

SCALE: 120 FT = 1 INCH.

November 8 87
Chas. D. Moore

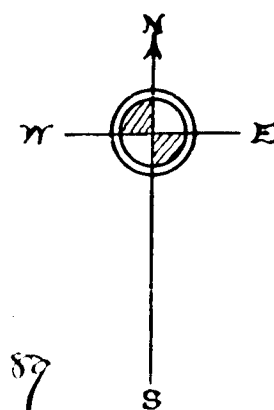

Dedications

Know all men by these presents, that the Geo. T. Smith Mill-ellings Purifier Company a corporation organized and doing bus-iness under the laws of the state of Michigan, in the city and County of Jackson insaid state, as proprietor by Geo. T. Smith its president duty authorized, has caused the land described herewith and embue-
ed in the annexed map or plat to be surveyed laid out and platteed to be known as Geo. T. Smiths Addition Number 2, to the city of Jackson Michigan; that the streets and alleys as shown on said map or plat are hereby dedicated to the Mayor, Recorder and Aldermen of said city of Jackson solely for the use of the public as highways

Signed and Sealed in presence of

Wm H. Drickey
Julian J. Bennett

Geo. T. Smith *Pres't*

of Geo. T. Smith Mouldings Purifier Co.

State of Michigan } ss
County of Jackson }

On this 28th day of October A.D. 1889 personally appeared before me a Notary Public in and for said county, Geo. T. Smith to me known to be the president of the Geo. T. Smith Mouldings Purifier Company, a corporation, the grantor named in the foregoing instrument, and acknowledged that he executed the same as the free act and deed of said corporation, by him as its president duly authorized for such purpose and that the corporate seal thereunto attached is the corporate seal of said company.

Chas. B. Wood
Notary Public Jackson Co. Michigan.

VACATED BY RESOLUTION
CITY COMMISSION
DECEMBER 3, 1957
VOLUME NO. 796-57

Description of Land Platted.

The land embraced in the annexed plat of Geo. T. Smith's Addition No 2, to the city of Jackson, Michigan is described as follows, Commencing at a tile monument the quarter post in the north line of section thirty three (33) town two (2) South range one (1) West, thence east along the north line of the section, thirteen hundred twenty four (1324) feet to the north and south center line of the north east quarter of said section, thence south along said center line ten hundred sixty eight and one tenth (1068.1) feet to the north line of North street which is the north boundary of Geo. T. Smith's first Addition, thence west on the north line of North street thirteen hundred twenty four (1324) feet to the north and south quarter line of said section, thence north on said quarter line ten hundred sixty five and two tenths (1065.2) feet to the place of beginning.

I hereby certify that the plat heron delineated is a correct one and that permanent monuments consisting of iron pipe 30" long have been planted at points marked thus (x) as thereon shown at all angles in the boundaries of the land platted and at all intersections of streets or streets and alleys

Chas. B. Hyde Surveyor.

Examined and Approved November 2 1889.

H. R. Pratt, Deputy Auditor General.

State of Michigan } S.S.
County of Jackson }

County of Jackson. We Chas. E. Townsend Register of Deeds and Chas. B. Hyde Surveyor hereby certify that we have each carefully compared this copy with the original plat of Geo. T. Smiths Addition No 2 to the city of Jackson Michigan and that it is an exact copy thereof and of the whole of such original map or plat.

Wm. & Townsend
Chas. B. Hyde
Register of Deeds
Surveyor

Received for record the 7 day of November A.D. 1889 at 11 o'clock
A.M. and recorded in Book 4 of Plats on page 12.

Chas. E. Townsend Register of Deeds.

Witnesses to Monuments

A. Elm 12" N. 12° W. 54.5 ft.
B. W. oak 7" N. 38½° E. 22.8 ft.

Poplar 12" S. 84° W. 5.3 ft.
Y. oak 18" S. 13½° W. 13.7 ft.

State of Michigan } ss.
County of Jackson }

County of Jackson } ss. We Chas. E. Townsend Register of Deeds and Chas. B. Hyde surveyor
hereby certify that we have each carefully compared the annexed copy with the plat
of Geo. T. Smith's Addition No 2 to the city of Jackson Michigan now of record in
the office of said Register of Deeds and that it is a true transcript therefrom and of
the whole of such record.

Wm. E. Townsend
New Hyde

Register of Deeds,
Surveyor.

Bloomfield Ave. changed Bryant St
Jan 5-1920

100-1130-1925-

Drawn by W. G. Fargo.

2891

13799

CITY OF JACKSON



MICHIGAN

UNDER COMMISSION-MANAGER GOVERNMENT

OFFICE OF
EVERETT D. CATTELL
CITY CLERK

RESOLUTION
STREET VACATION

BY THE CITY COMMISSION:

WHEREAS, a petition has been filed by all of the persons, firms and corporations owning property abutting on or located in, under or over a street in the City of Jackson, Michigan, for the vacation of said street, more particularly described as:

Bryant Street lying between W. North St. and W. Merrill St., being a part of George T. Smith Addition No. 2.

AND WHEREAS, it is determined that all persons, firms and corporations who and which will be affected by said vacation have filed with the City Commission their written consent to the same, and that it is necessary for the health, welfare, comfort and safety of the people of the City to vacate and discontinue such street.

NOW, THEREFORE, BE IT RESOLVED, that said street be and the same is hereby vacated, and the land shall revert to the abutting property free from any claim or right on the part of the public and that all public claims and rights in and to said street are hereby forever barred, and

BE IT FURTHER RESOLVED, that the vacation of said street is upon the condition that the title to the water, sewer, and gas pipe, appurtenances and facilities, and all electric and communication poles, wires, conduits, cables, appurtenances and facilities now or hereafter in, under, or over said street are reserved to and shall remain in the respective owners thereof, their successors or assigns, together with the easement and continued right to occupy said street within the right-of-way thereof for public utility purposes, with present and additional facilities and to operate, repair, maintain, replace and remove the same to the same effect and in the same manner as if said street remained a public way.

State of Michigan)
County of Jackson) ss.
City of Jackson)

I, Everett D. Cattell, Clerk in and for the City of Jackson, County and State aforesaid, do hereby certify that the foregoing is a true and compared copy of a resolution adopted by the City Commission of the City of Jackson, Michigan, on December 14, 1965.

IN WITNESS WHEREOF, I have hereto
affixed my signature and the seal of
the City of Jackson, Michigan, this
15th day of December, 1965.

Everett D. Cattell CITY CLERK

Noted 12799
Page

do-
Jacobson