

Know all men by these presents that I Margaret Murray as proprietor have caused the land embraced in the annexed plat and hereinafter described to be surveyed laid out and platted to be known as Murray's Addition to the City of Jackson, Michigan and that the streets as shown on said plat are hereby dedicated to the use of the public as highways; which said land so embraced in the said annexed plat is described as follows to-wit: Commencing on the east and west quarter line of section thirty six (36) in Town two (2) South of Range one (1) West at a point sixty (60) rods east of the west quarter post of said section, thence north parallel with the west line of said section 36 two thousand six hundred fifty one and three tenths (2651 $\frac{3}{10}$) feet to the north line of said section, thence east on section line one hundred sixty five (165) feet, thence south parallel with west line of said section two thousand six hundred fifty and nine tenths (2650 $\frac{9}{10}$) feet to east and west quarter line aforesaid, thence west on quarter section line one hundred sixty five (165) feet to the place of beginning.

In Witness whereof the said Margaret Murray has hereunto set her hand and seal this 10th day of March A.D. 1894

Signed and sealed in presence of

P. H. Murray

Wm G. Fargo

Margaret Murray [I.S.]

State of Michigan } ss.
County of Jackson

On this 10th day of March A.D. 1894 before me, a Notary Public in and for said County, personally came the above named Margaret Murray known to me to be the person named in and who executed the above dedication and acknowledged the same to be her free act and deed

Wm G. Fargo

Notary Public Jackson, Mich.

I hereby certify that the plat hereon delineated is a correct one and that permanent monuments consisting of iron pipes ^{about} one inch in diameter and at least thirty inches long, have been planted at points marked thus (o) as thereon shown at all angles in the boundaries of the land platted and at all intersections of streets

Wm G. Fargo
Surveyor


Witness Trees at point of Commencement
Maple 10" N 48 $\frac{1}{2}$ ° E 44 $\frac{1}{4}$ Links
" " 6" N 62 $\frac{1}{2}$ ° W 64 $\frac{1}{4}$ "

Examined and Approved
March 17 - 1894
D. B. Ainger
Deputy Auditor General

Murray's ADDITION

To the City of
JACKSON MICHIGAN.

SCALE: 200 ft. to an inch. 500 feet

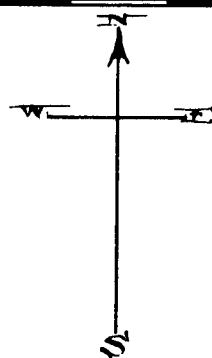

Received for record this 9th day of April at 3 o'clock P. M. and recorded in Book 5 of Plats on page 13

Charles Edmund
Register of Deeds

State of Michigan } ss.
County of Jackson

We, C. E. Townsend Register of Deeds, and Wm G. Fargo Surveyor, hereby certify that we have each carefully compared this copy with the original plat of Murray's Addition to the City of Jackson Michigan and that it is an exact copy thereof and of the whole of such original map or plat

Charles Edmund
Register of Deeds

Wm G. Fargo
Surveyor

State of Michigan } ss.
County of Jackson


We, C. E. Townsend Register of Deeds, and Wm G. Fargo Surveyor, hereby certify that we have each carefully compared the annexed copy with the plat of Murray's Addition to the City of Jackson Michigan, now of record in the office of said Register of Deeds, and that it is a true transcript thereof and of the whole of such record

Charles Edmund
Register of Deeds

Wm G. Fargo
Surveyor

State of Michigan } ss.
County of Jackson
Certificate filed in compliance with
Sec 135 of Senate Bill No 199 Act of 1893

Charles Edmund
Register of Deeds

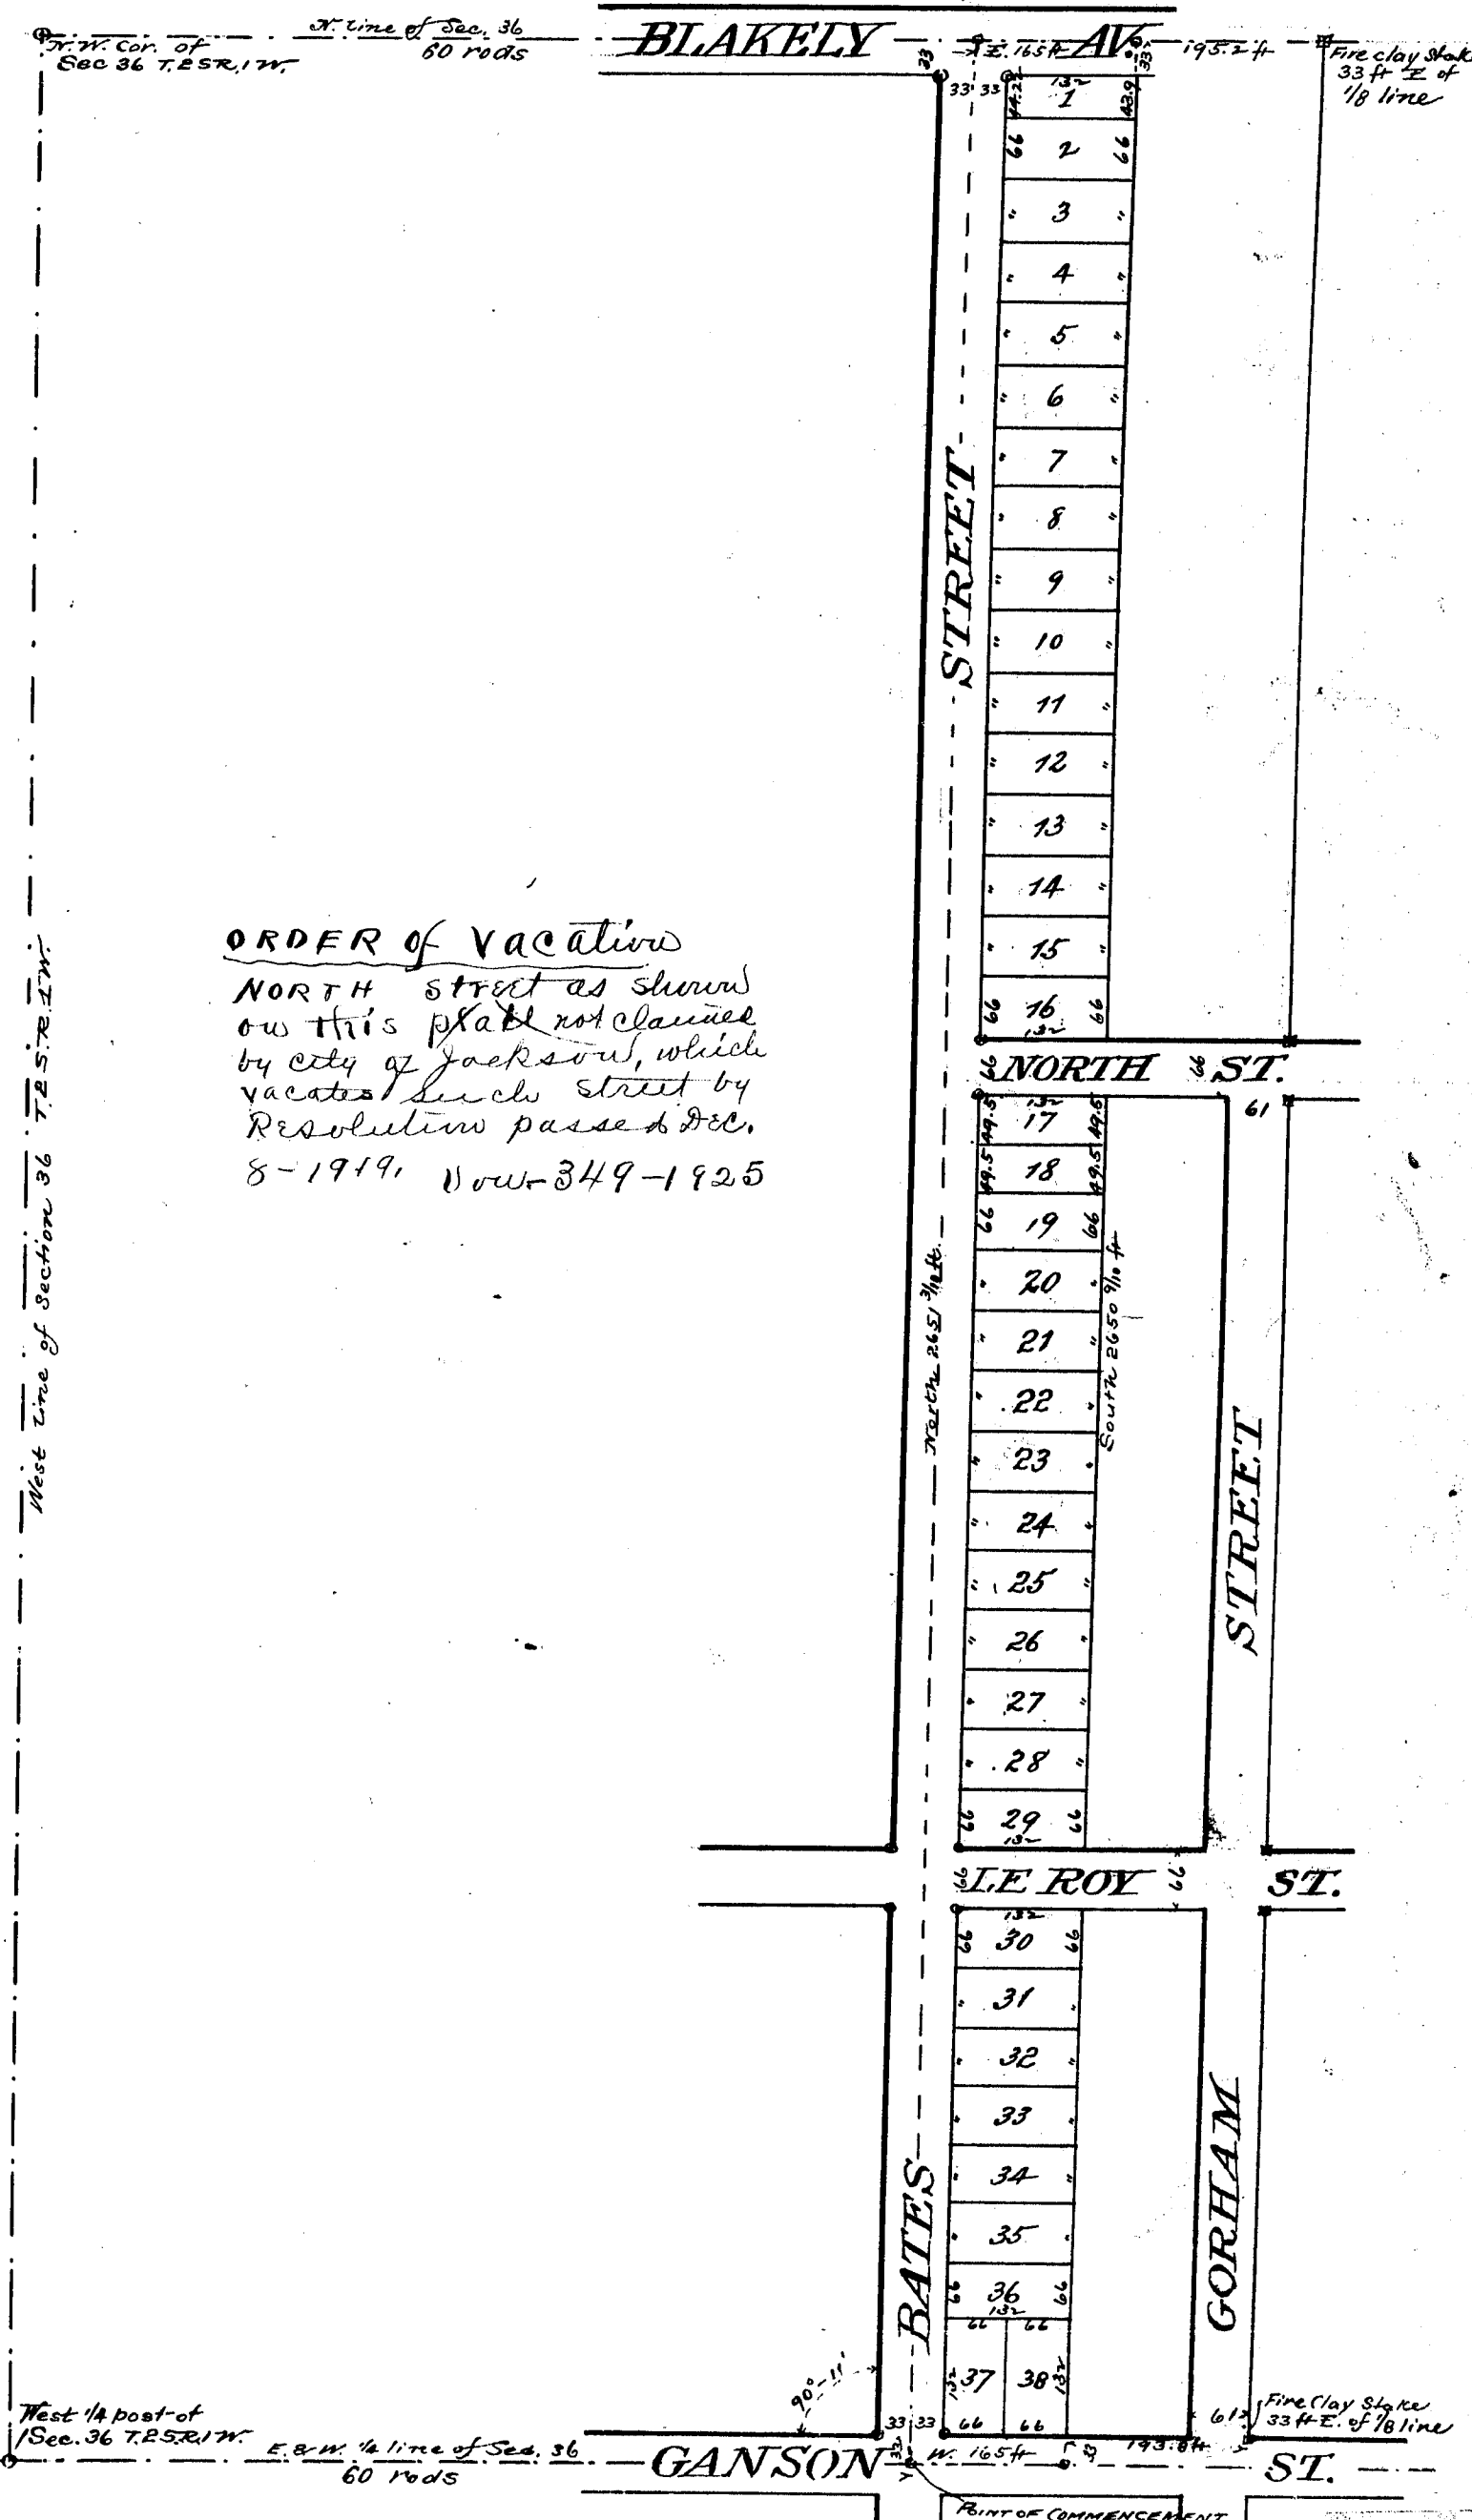

ORDER of VACATION

NORTH Street as shown on this plat not claimed by City of Jackson, which vacated such street by Resolution passed Dec. 8-1919, Now 349-1925

Know all men by these presents that I Margaret Murray as proprietor have caused the land embraced in the annexed plat and hereinafter described to be surveyed laid out and platted to be known as Murray's Addition to the City of Jackson, Michigan and that the streets as shown on said plat are hereby dedicated to the use of the public as highways, which said land is embraced in the said annexed plat is described as follows to wit: Commencing on the east and west quarter line of section thirty-six (36) in Town two (2) South of Range one (1) West at a point sixty (60) rods east of the west quarter post of said section, thence north parallel with the west line of said section 36 two thousand six hundred fifty one and three tenths (2651 $\frac{3}{10}$) feet to the north line of said section, thence east on section line one hundred sixty five (165) feet, thence south parallel with west line of said section two thousand six hundred fifty and nine tenths (2650 $\frac{9}{10}$) feet to east and west quarter line aforesaid, thence west on quarter section line one hundred sixty five (165) feet to the place of beginning.

In Witness whereof the said Margaret Murray has hereunto set her hand and seal this 10th day of March 1894
Signed and sealed in presence of
E. H. Murray
Wm G. Fargo

State of Michigan } ss.
County of Jackson }

On this 10th day of March A.D. 1894 before me, a Notary Public in and for said County, personally came the above named Margaret Murray known to me to be the person named in and who executed the above dedication and acknowledged the same to be her free act and deed

Wm G. Fargo
Notary Public Jackson, Mich.

I hereby certify that the plat hereon delineated is a correct one and that permanent monuments consisting of iron pipe, one inch in diameter and at least thirty inches long, have been planted at points marked thus (O) as thereon shown at all angles in the boundaries of the land platted and at all intersections of streets

Wm G. Fargo
Surveyor


Witness Trees at point of Commencement
Maple 10' N 48 $\frac{1}{2}$ ° E 44 $\frac{1}{4}$ links
" " 6' N 62 $\frac{1}{2}$ ° W 64 $\frac{1}{4}$ "

Examined and Approved
March 17 1894
D. B. Ainger
Deputy Auditor General

Murray's ADDITION

To the City of
JACKSON MICHIGAN

SCALE: 200 ft. to an inch

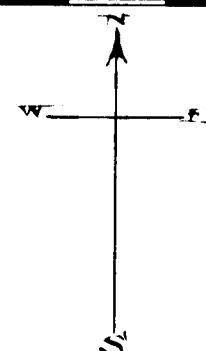

Received for record this 9th day of April
at 3 o'clock P. M. and recorded in
Book 5 of Plats on page 13

Charles E. Townsend
Register of Deeds

State of Michigan } ss.
County of Jackson }

We, C. E. Townsend Register of Deeds, and Wm G. Fargo Surveyor, hereby certify that we have each carefully compared this copy with the original plat of Murray's Addition to the City of Jackson Michigan and that it is an exact copy thereof and of the whole of such original map or plat

Charles E. Townsend
Register of Deeds

Wm G. Fargo
Surveyor

State of Michigan } ss.
County of Jackson }


We, C. E. Townsend Register of Deeds, and Wm G. Fargo Surveyor, hereby certify that we have each carefully compared the annexed copy with the plat of Murray's Addition to the City of Jackson Michigan, now of record in the office of said Register of Deeds, and that it is a true transcript thereof and of the whole of such record

Charles E. Townsend
Register of Deeds

State of Michigan } ss.
County of Jackson }

Certificate filed in compliance with
Sec 135 of Senate Bill No 199 Act of 1893

Charles E. Townsend
Register of Deeds

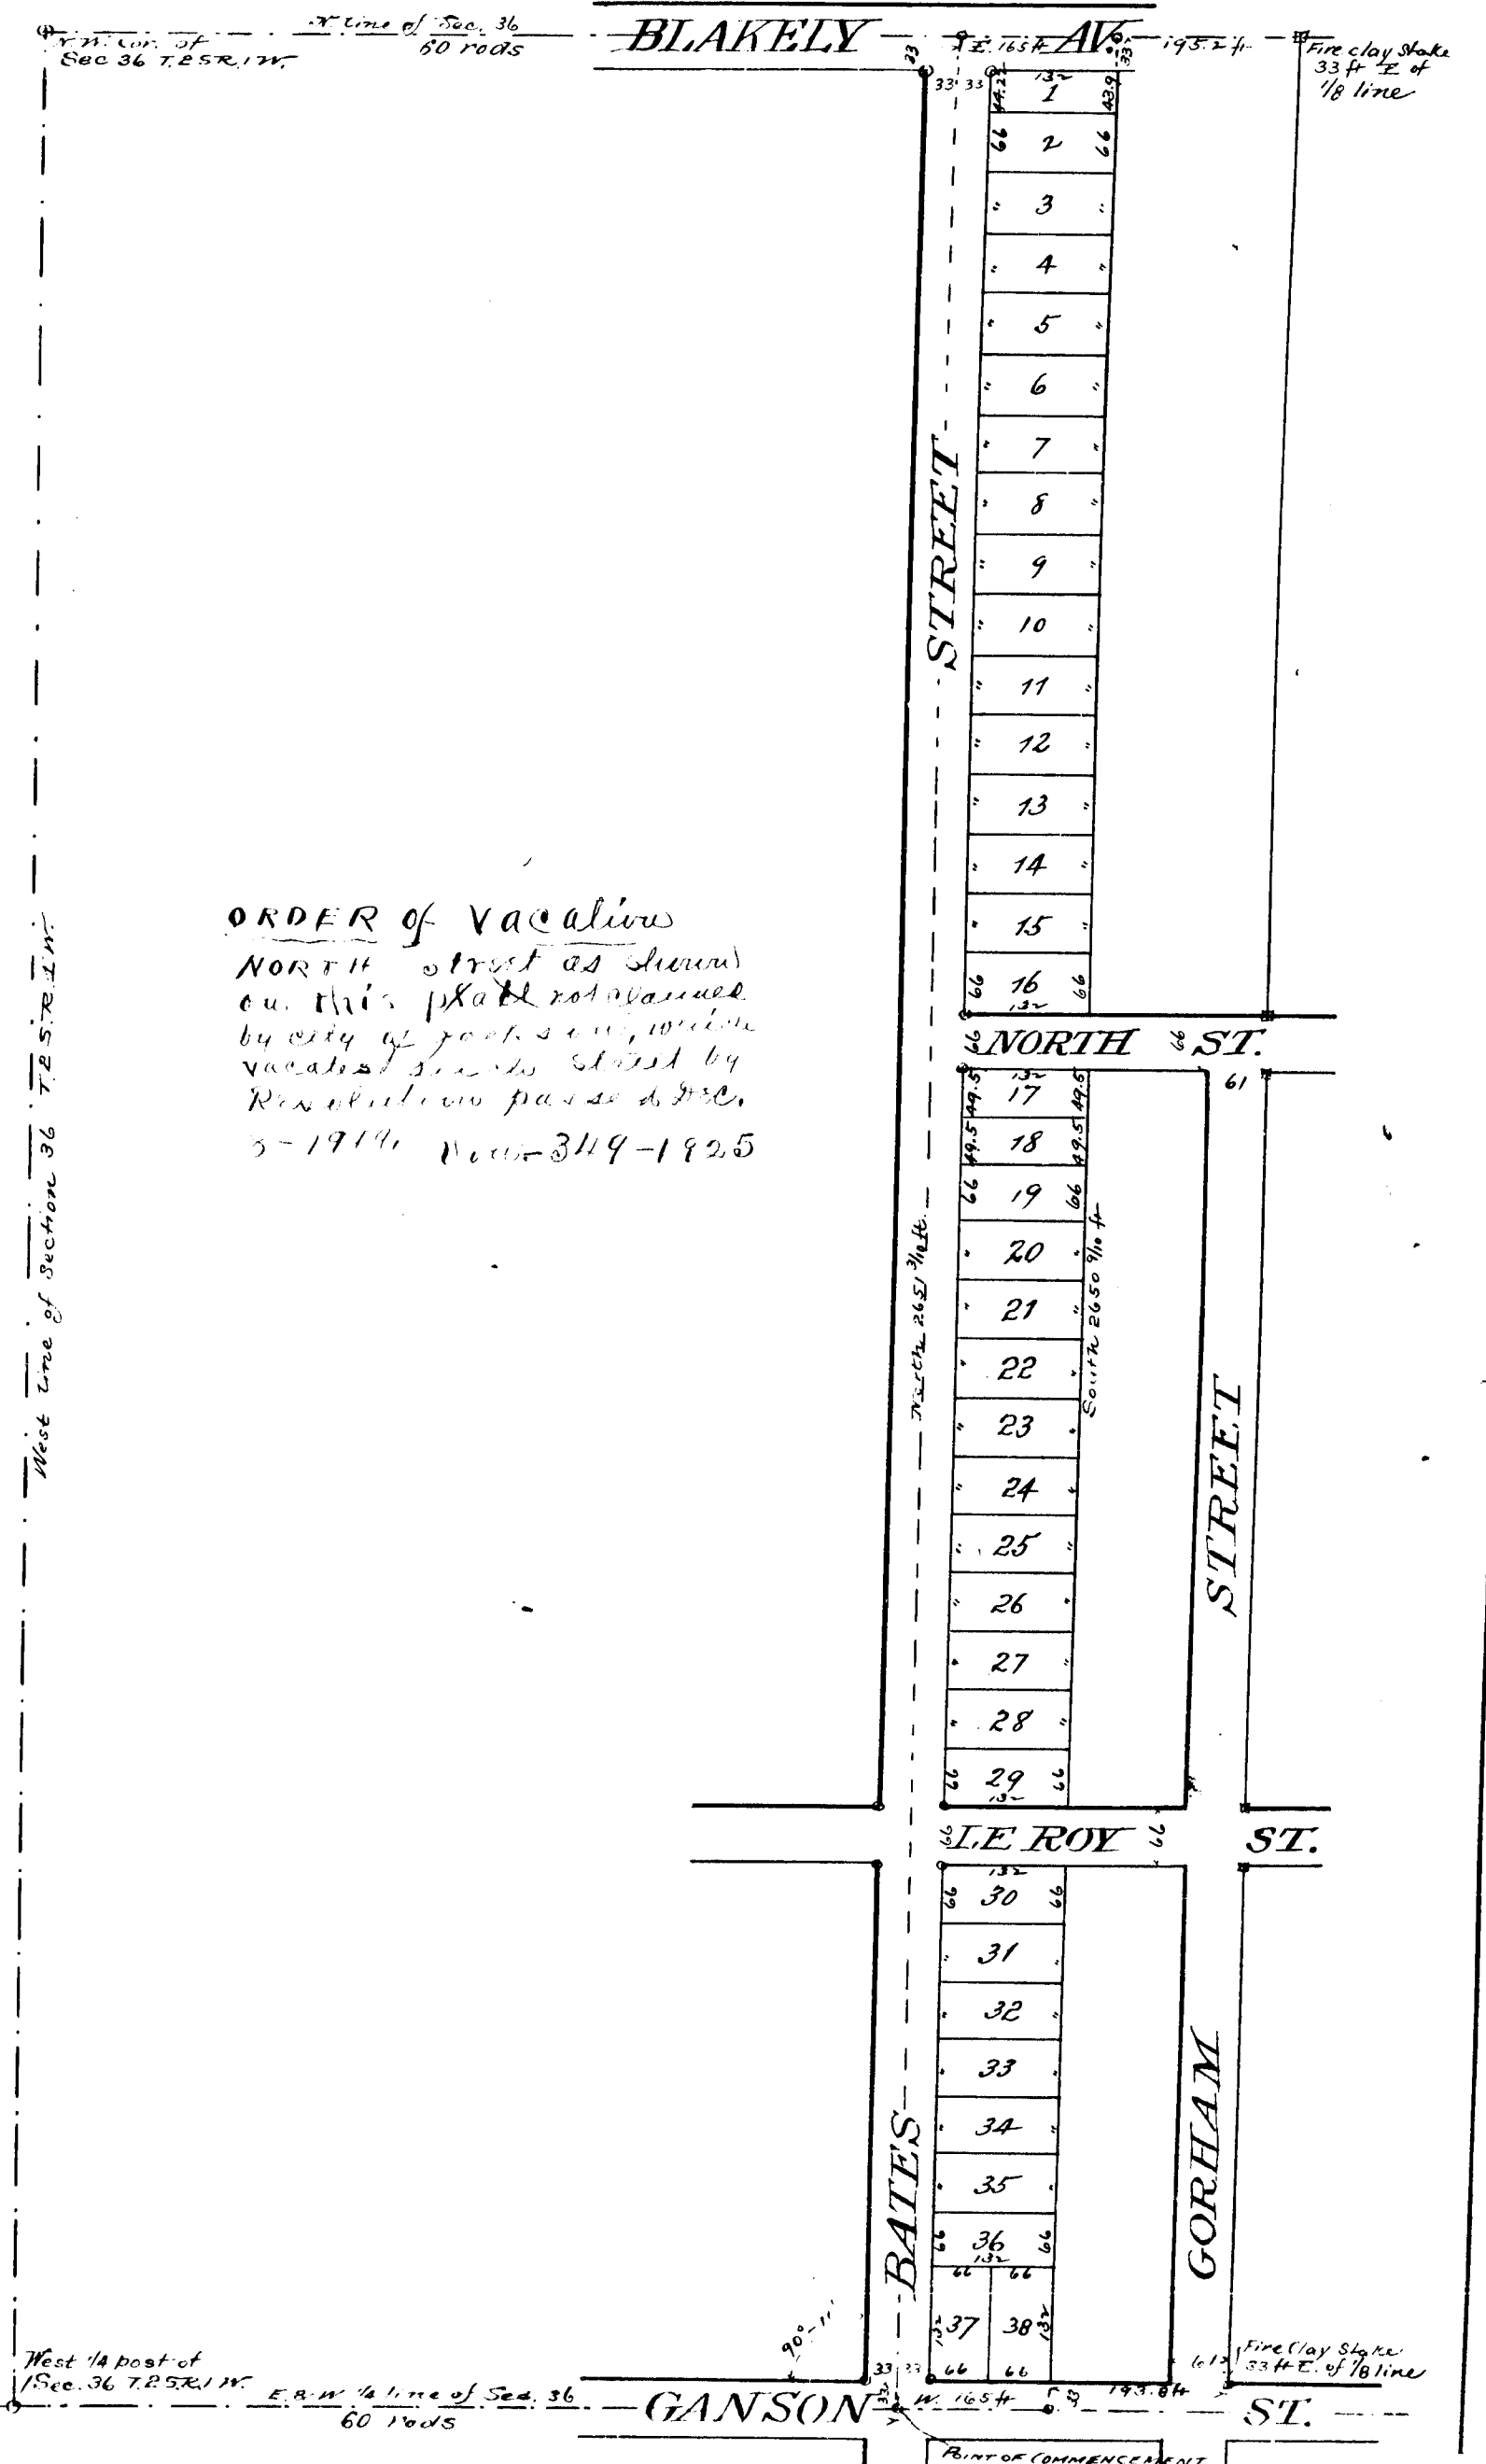

ORDER of Vacation
NORTH Street as shown
on this plat not vacated
by City of Jackson, within
vacated streets shown by
Resolution passed Dec.
5-1914. Vol. 319-1925