

know all men by these presents that I, Jackson C. Williamson (a minor) as proprietor, have caused the land embraced in the annexed plat, and hereinafter described, to be surveyed, laid out and platted to be known as Williamson's Addition to the City of Jackson, Michigan, and that the streets and alleys as shown on said plat are hereby dedicated to the use of the public; which said land so embraced in the said annexed plat is described as follows, to wit, commencing at a point thirty three (33) feet north and thirty three (33) feet east of the south quarter post of section thirty three (33) in Town three (2) South of Range one (1) West, running thence N 89° 56' E and parallel with the south line of said section thirty three, eleven hundred twenty four and six tenths (1124.6) feet to a point ten rods west of the east line of the west half of the south east quarter of said section 33, thence N 0° 0' E. (parallel with said E. line of W. 1/2 of SE. 1/4 Sec. 33) fifteen hundred thirty and eight tenths (1530.8) feet to the southerly line of Wildwood Avenue, thence along said Avenue N. 68° 47' W. four hundred ninety nine and ninety five one hundredths (499.95) feet, thence south one and one tenth (1.1) feet, thence westerly along a one degree curve, to the left, radially distant three hundred thirty and one half (330.5) feet southerly from the center line of track and right of way of the Michigan Central Railroad Company, six hundred ninety two and six tenths (692.6) feet to a point, thirty three (33) feet east of the north and south quarter line of said section, thence south and parallel with said quarter line, fifteen hundred three and seven tenths (1503.7) feet to the place of beginning.

In Witness Whereof the said Jackson C. Williamson has hereunto set his hand and seal at the City of Jackson and State of Michigan on this twelfth day of December 1895.

Signed and sealed in presence of

Geo. W. Lamb

Jackson C. Williamson (L.S.)

State of Michigan } ss
County of Jackson

On this 12th day of December 1895 before me a Notary Public in and for said County personally came the above named Jackson C. Williamson, known to me to be the person named in and who executed the above dedication, and acknowledged the same to be his free act and deed.

Wm. Fargo

I hereby certify that the plat hereon delineated is a correct one and that permanent monuments consisting of iron pipe about one inch in diameter and from 20 to 30 inches long have been planted at points marked thus (o) as thereon shown at all angles in the boundaries of the land platted and at all intersections of streets and alleys

Wm. Fargo
SURVEYOR

Examined and Approved
Dec. 24th 1895

D. B. Ainger
Deputy Auditor General.

Vacation of alley
Alley on N. side of Lots 194 and 193
vacated by City Commission
July 30-1928
Voucher 1175-1928

RECEIVED AND FILED
IN AUDITOR GENERAL'S OFFICE

Aug 15 1896

Deputy Auditor General.

Reference Points.

At NE. cor. lot 1 { NE. cor. house S 51° W 18.9 ft
... N 84° W 60.5
NW. . . 3 { Maple 5' N 32° W 14.5
... 8 N 48° E 9.7
NE. . . 61 { " 7 N 81° E 17.9
... 6 N 15° W 60.3
NE. . . 123 { Br. oak 18 N 43° E 34.2
NW. . . 65 { " 20 S 57° E 36.3
... Maple 5' N 30° E 7.7
S.E. . . 168 { Hick. 14 N 67° E 79.0
NW. . . 186 { Elm - N 27° E 120.5
... - N 77° W 104.0
SW. . . 199 { Hick 18 N 22° E 45.8
... Maple 18 N 64° W 75.4

State of Michigan } ss
County of Jackson } ss
Register of Deeds and Wm. G. Fargo surveyor
hereby certify that we have each carefully compared this copy with the original plat of Williamson's Addition to the City of Jackson Michigan and that it is an exact copy thereof and of the whole of such original map or plat.

Wm. G. Fargo Surveyor
Wm. G. Fargo Register of Deeds

Register's Office } ss
Jackson County } ss
This instrument was presented and filed for record this 10th day of July, 1896 as proper certificate was furnished in compliance with Section 135, Act 206 Laws of 1893.
Recorded the 10th day of July 1896 at 10 o'clock P. M. in Book 5 of Plats on page 24.

VACATED BY ORDER OF
JACKSON CITY COMMISSION
AUGUST 30, 1938
VOUCHER NO. 238-38


State of Michigan } ss
County of Jackson } ss
Register of Deeds and Wm. G. Fargo surveyor
hereby certify that we have each carefully compared the annexed copy with the plat of Williamson's Addition to the City of Jackson Michigan, now of record in the office of said Register of Deeds and that it is a true transcript therefrom and of the whole of such record.

Wm. G. Fargo Surveyor
Wm. G. Fargo Register of Deeds

WEST MAIN STREET changed to MICHIGAN AVENUE Jan 19-1924
Vow 73-1925

Wildwood Terrace changed to Daniel Road
Jan 10-1928
Vow 50-1928

VACATED BY RESOLUTION
OF CITY COMMISSION
September 10, 1938
VOUCHER NO. 451-58

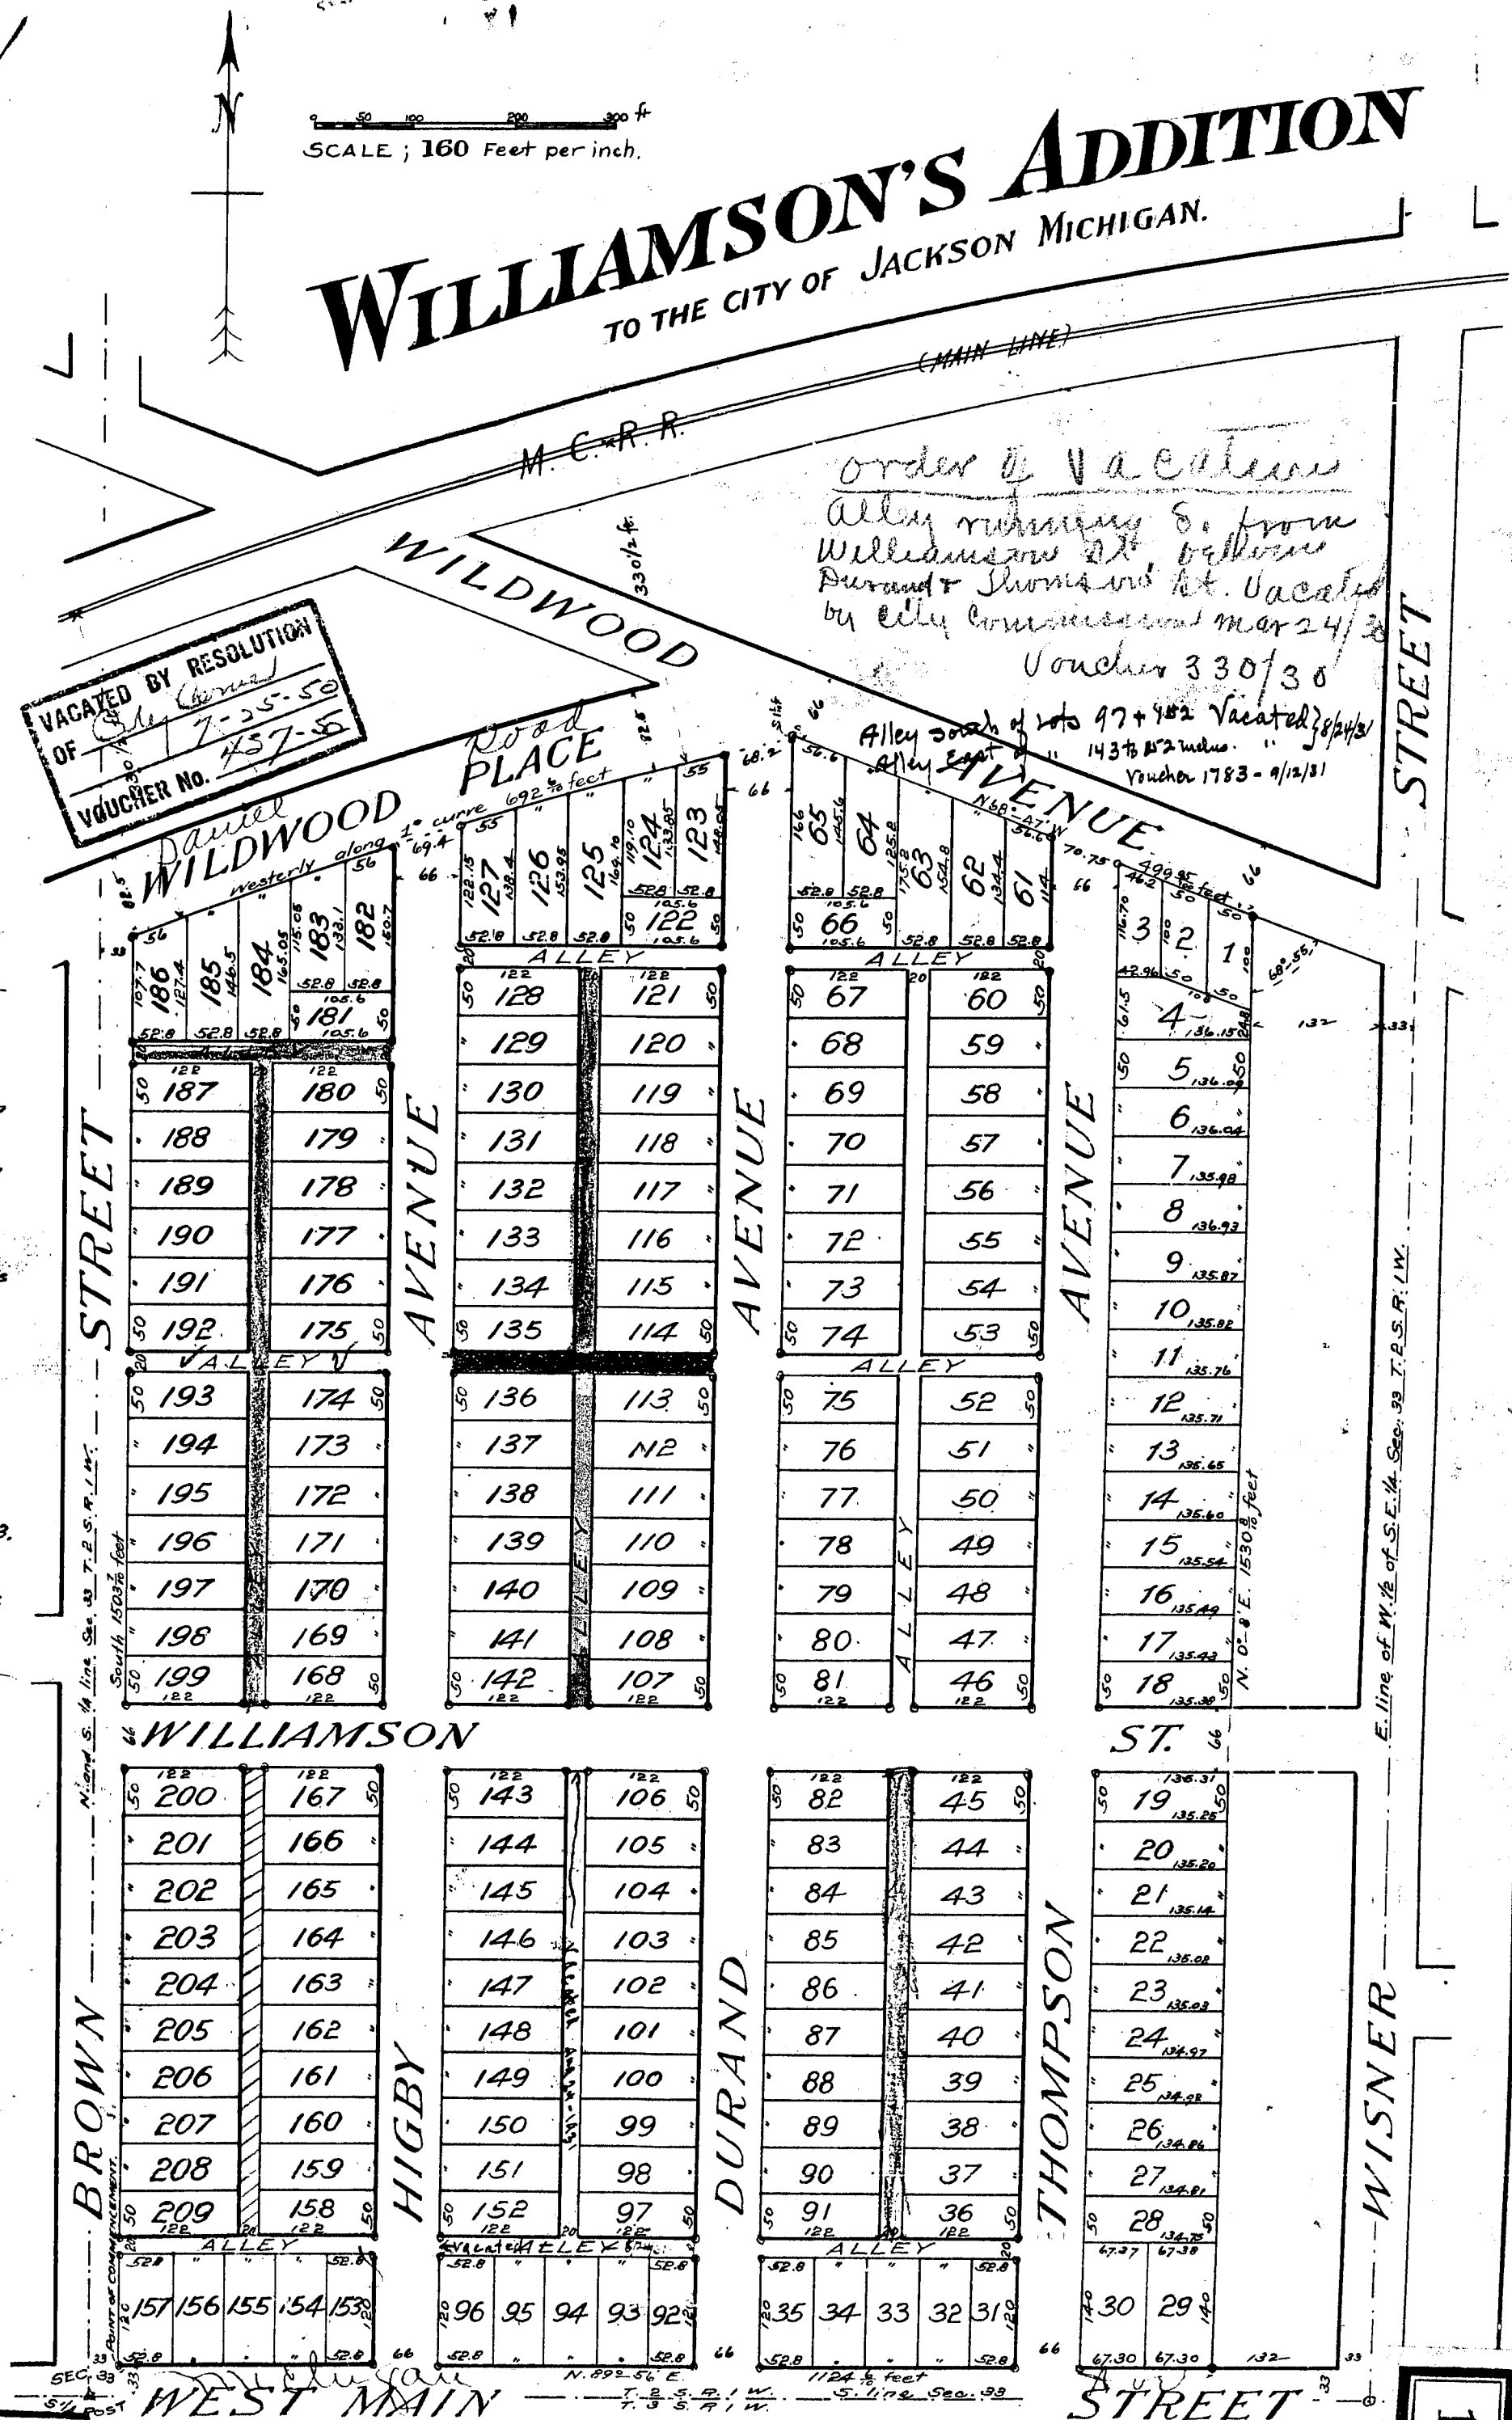

13829

4391

Know all men by these presents that I, Jackson C. Williamson (widower) as proprietor, have caused the land embraced in the annexed plat, and hereinafter described, to be surveyed, laid out and platted to be known as Williamson's Addition to the City of Jackson, Michigan, and that the streets and alleys as shown on said plat are hereby dedicated to the use of the public; which said land so embraced in the said annexed plat is described as follows, to wit, commencing at a point thirty three (33) feet north and thirty three (33) feet east of the south quarter post of section thirty three (33) in Town two (2) South of Range one (1) West, running thence N 89° 56' E and parallel with the south line of said section thirty three, eleven hundred twenty four and six tenths (1124.6%) feet to a point ten rods west of the east line of the west half of the south east quarter of said section 33, thence N 0° 0' E. (parallel with said E. line of W. 1/2 of SE 1/4 Sec. 33) fifteen hundred thirty and eight tenths (1530.8%) feet to the southerly line of Wildwood Avenue, thence along said Avenue N 68° 47' W four hundred ninety nine and ninety five one hundredths (499.95%) feet, thence south one and one tenth (1.1%) feet, thence westerly along a one degree curve, to the left, radially distant three hundred thirty and one half (330.5%) feet southerly from the center line of track and right of way of the Michigan Central Railroad Company, six hundred ninety two and six tenths (692.6%) feet to a point, thirty three (33) feet east of the north and south quarter line of said section, thence south and parallel with said quarter line, fifteen hundred three and seven tenths (1503.7%) feet to the place of beginning.

In Witness whereof the said Jackson C. Williamson has hereunto set his hand and seal at the City of Jackson and State of Michigan on this twelfth day of December 1895.

Signed and sealed in presence of

Geo. H. Lamb

Jackson C. Williamson (L.S.)

State of Michigan
County of Jackson

On this 12th day of December 1895 before me a Notary Public in and for said County personally came the above named Jackson C. Williamson, known to me to be the person named in and who executed the above dedication, and acknowledged the same to be his free act and deed.

Wm. Fargo

I hereby certify that the plat hereon delineated is a correct one and that permanent monuments consisting of iron pipe about one inch in diameter and from 20 to 30 inches long have been planted at points marked thus (o) as thereon shown at all angles in the boundaries of the land platted and at all intersections of streets, and alleys

Wm. Fargo
SURVEYOR

Examined and Approved
Dec. 24th 1895

D. B. Anger
Deputy Auditor General

Vacation of alley
alley on N. side of Lots 194 and 195
vacated by City Commissioners
July 30-1928
Voucher 1175-1928

RECEIVED AND FILED
IN AUDITOR GENERAL'S OFFICE
Aug 15 1896
1396
Deputy Auditor General

Reference Points.
At NE. cor. lot 1 NE. cor. house S 51° W 18.9 ft
... N 84° W 60.5
NW. . 3 Maple 5' N 32° W 14.5
... 8 N 48° E 9.7
NE. . 61 . 10 S 79° W 11.2
... 7 N 81° E 17.9
NE. . 123 . 6 N 15° W 60.3
... Brook 18 N 43° E 34.2
NW. . 65 . 20 S 57° E 36.3
... Maple 6' N 30° E 7.7
S.E. . 168 Hick 14 N 6° E 79.0
N.W. . 186 Elm - N 27° E 120.5
... - N 77° E 104.0
SW. . 199 Hick 15 N 22° E 45.8
... Maple 18 N 64° W 75.4

State of Michigan
County of Jackson ss. *Wm. C. Hammond*
Register of Deeds and Wm. G. Fargo surveyor
hereby certify that we have each carefully compared this copy with the original plat of Williamson's Addition to the City of Jackson Michigan and that it is an exact copy thereof and of the whole of such original map or plat.

Wm. C. Hammond Register of Deeds
Wm. Fargo Surveyor

Register's Office ss.
This instrument was presented and filed for record this 11th day of July 1896 as proper certificate was furnished in compliance with Section 135, Act 206 Laws of 1893.

Recorded the 10th day of July 1896 at 10 o'clock A.M. in Book 5 of Plats on page 24.

Wm. C. Hammond
Aug 10 30 1896
Voucher No. 238-38


State of Michigan
County of Jackson ss. *Wm. C. Hammond*
Register of Deeds and Wm. G. Fargo surveyor
hereby certify that we have each carefully compared the annexed copy with the plat of Williamson's Addition to the city of Jackson Michigan, now of record in the office of said Register of Deeds and that it is a true transcript therefrom and of the whole of said record.

Wm. C. Hammond Register of Deeds
Wm. Fargo Surveyor

WEST MAIN STREET changed to MICHIGAN AVENUE July 19 1896
Voucher 7-1-96
Wildwood Square changed to Daniel Park
July 10-1928
Voucher 50-1928

VACATED BY RESOLUTION
OF
VOUCHER No.

VACATED BY RESOLUTION
OF
VOUCHER No. 421-58

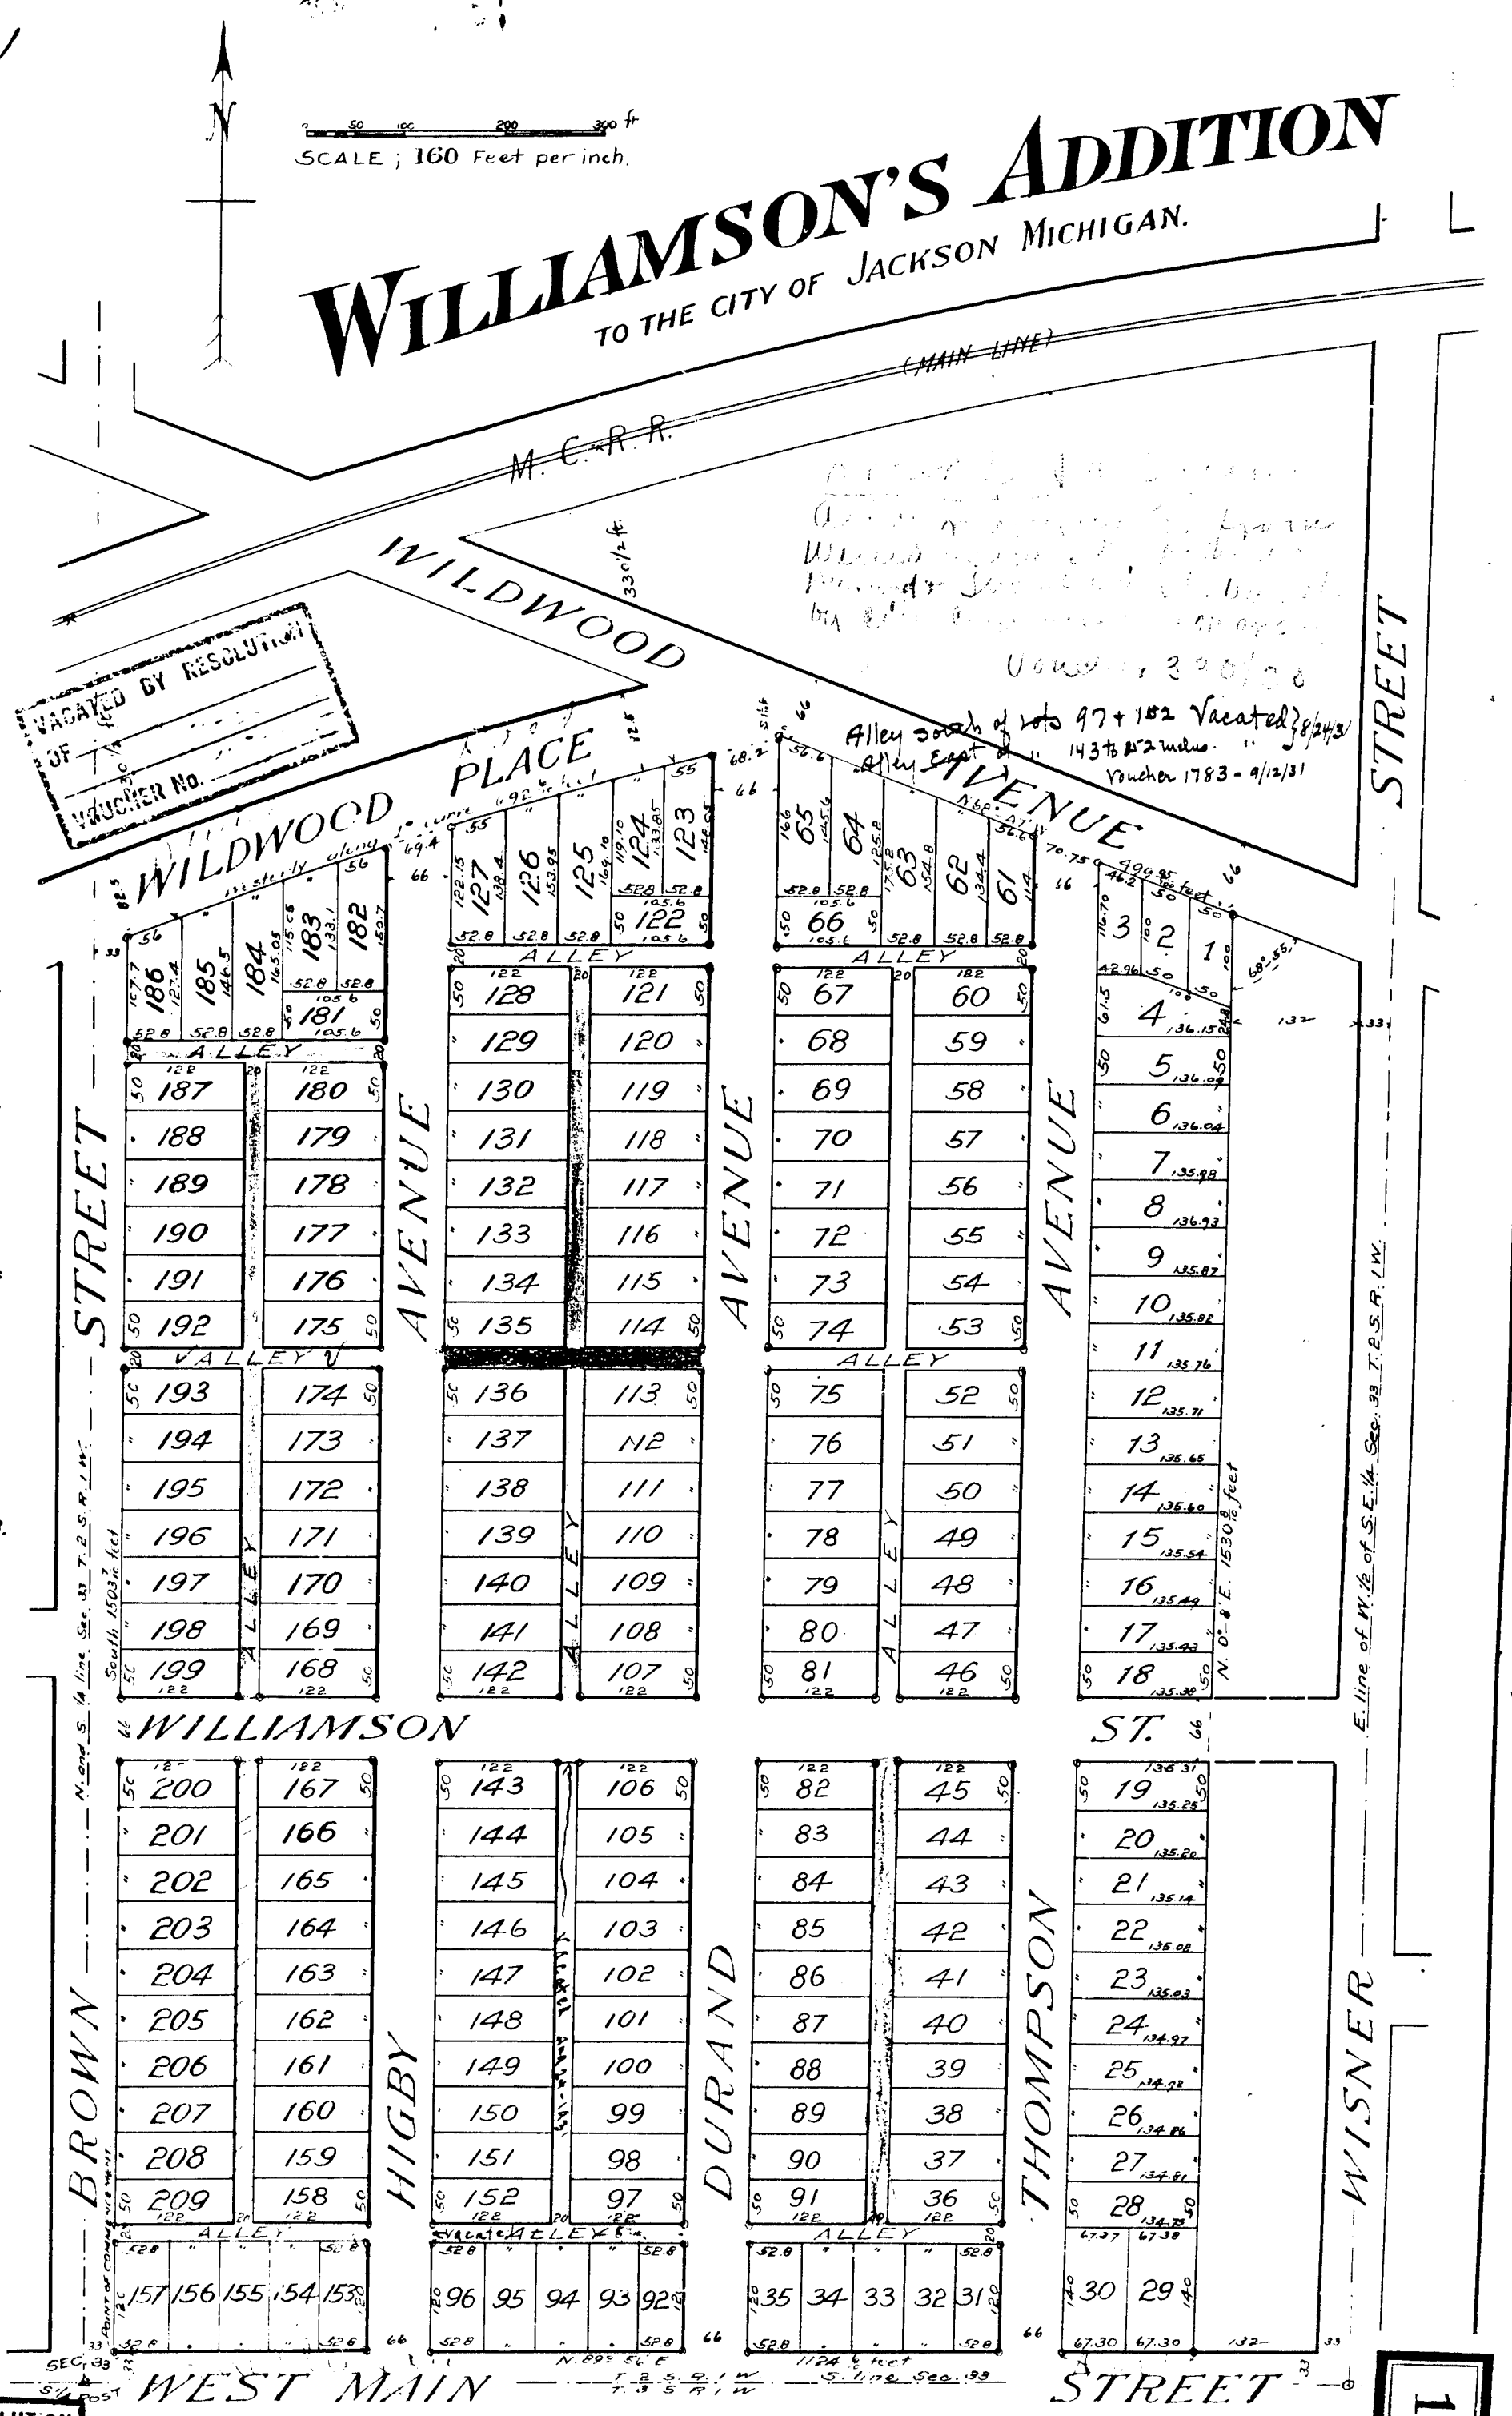

JAN 5 1 41 PM '73

= RESOLUTION =

REGISTER OF DEEDS
JACKSON COUNTY, MICH.*Jean M. Conway*

BY THE CITY COMMISSION:

WHEREAS, petition has been filed by all of the persons, firms and corporations owning property abutting on a portion of an alley in the City of Jackson, Michigan, for the vacation of that portion of said alley more particularly described as:

The northeast corner of Lot 13, Block 3 South, Range 2 East, thence South along the east line of Lots 13 and 14 in said Block to the North line of Wesley Street, thence east along the north line of Wesley Street to the southwest corner of Lot 15 in said Block, thence north along the west line of Lots 15 and 16 in said Block to the south line of Washington Street, thence west along the south line of Washington Street to the place of beginning, being the fourth alley east of Francis Street running north and south as lies between Washington Avenue and Wesley Street in Block 3 South, Range 2 East, of the original plat of Jacksonburgh.

Jackson
13829
9128

AND WHEREAS, it is determined that all persons, firms and corporations who and which shall be affected by said vacation have filed with the City Commission their written consent to the same, and that it is necessary for the health, welfare, comfort and safety of the people of the City to vacate and discontinue such alley, subject to the limitations hereinafter set forth,

NOW, THEREFORE, BE IT RESOLVED, that said portion of said alley be and the same is hereby vacated, and the land shall revert to the abutting property free from any claim or right on the part of the public, except as hereinafter set forth, and that all other public claims and rights in and to said alley are hereby forever barred.

BE IT FURTHER RESOLVED, that the vacation of said alley is upon the condition that the title to all water, sewer, and gas pipe, appurtenances and facilities; and all electric and communication poles, wires, conduits, cables, appurtenances and facilities now or hereafter in, under or over said street are reserved to and shall remain in the respective owners thereof, their successors or assigns, together with the easement and continued right to occupy said street, within the right-of-way thereof for public utility purposes, with present and additional facilities and to operate, repair, maintain, replace and remove the same to the same effect and in the same manner as if said street remained a public way.


* * *

State of Michigan)
County of Jackson) ss.
City of Jackson)

I, H. M. Conway, Clerk in and for the City of Jackson, County and State aforesaid, do hereby certify that the foregoing is a true and complete copy of a Resolution adopted by the City Commission of the City of Jackson, Michigan, on December 19, 1972.


IN WITNESS WHEREOF, I have hereto affixed my signature and the seal of the City of Jackson, Michigan, this 19th day of December, 1972.

H. M. Conway CITY CLERK

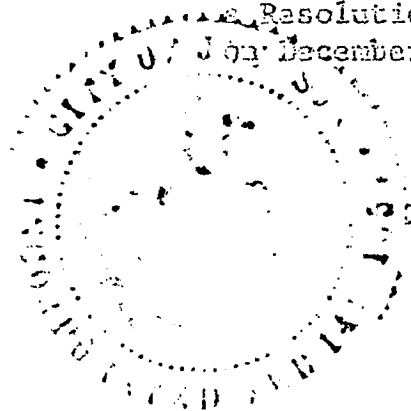

Commonwealth Associates, Inc.

Vacated 12/19/72

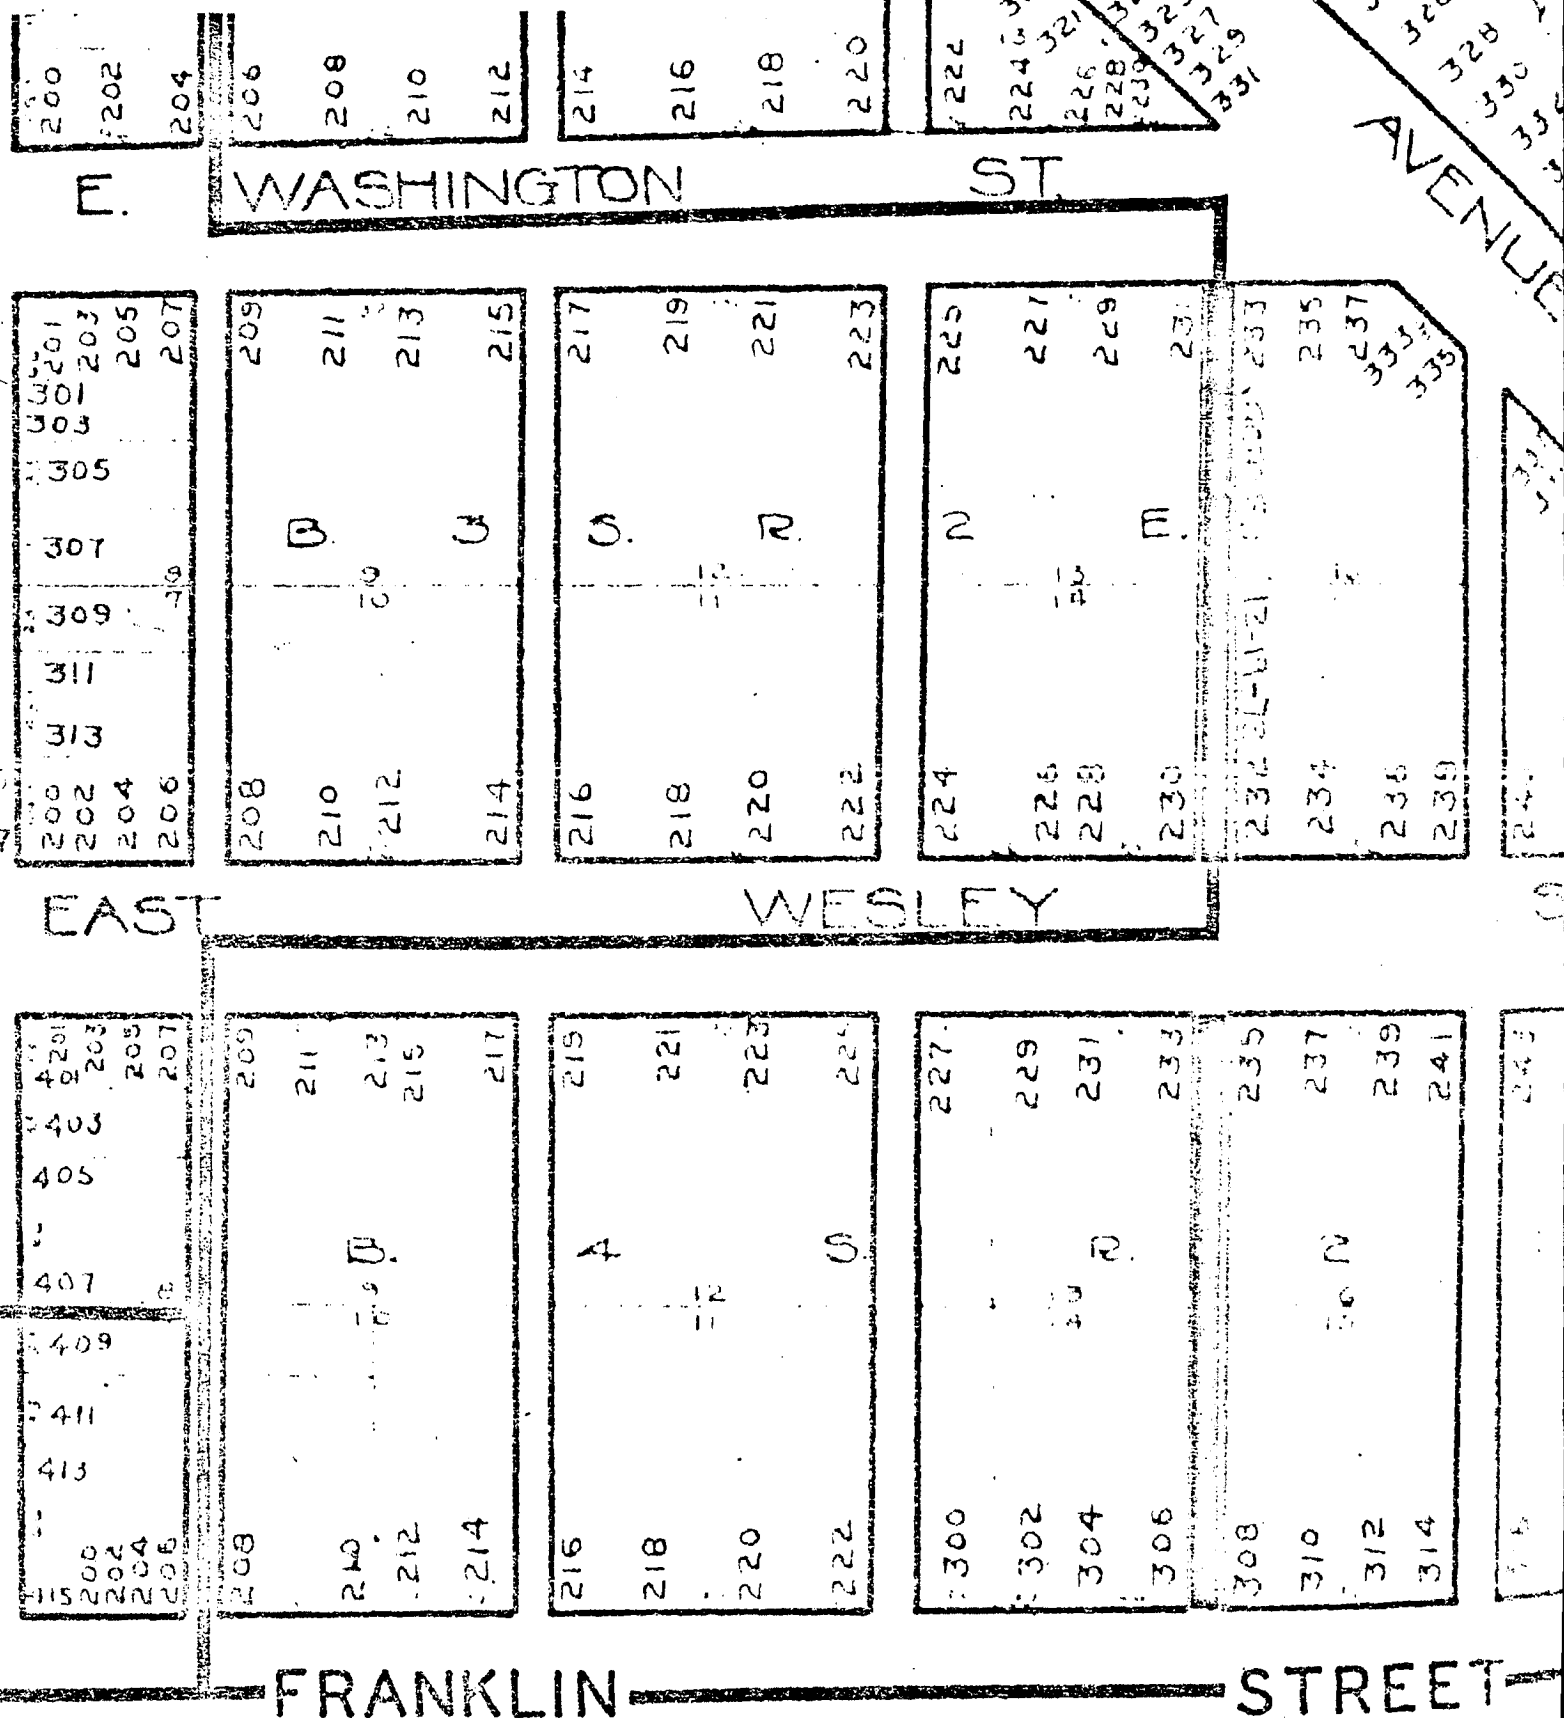

WILLIAMSON'S ADDITION. Lots 122-125-126-127- 121 & 128.
Wesley & Franklin - Lots 13-14-15-16, Blk. 4 S, R 2 E. - Jacksonburg Addn.
Washington and Wesley - Lots 13-14, 15-16, Blk. 3 S, R 2E, - Jacksonburg Addn.

JAN 5 1 41 PM '73

REGISTER OF DEEDS
JACKSON COUNTY, MICH.*John M. Conway*

- RESOLUTION -

BY THE CITY COMMISSION:

WHEREAS, petition has been filed by all of the persons, firms and corporations owning property abutting on a portion of an alley in the City of Jackson, Michigan, for the vacation of that portion of said alley more particularly described as:

The fourth alley east of Francis Street, running in a north south direction between East Wesley Street and East Franklin Street in the City of Jackson, said alley abutting Lots 13, 14, 15 and 16 in Block 4 South, Range 2 East, of the original plat of the Village of Jacksonburgh now City of Jackson.

Jackson
9/28
13879

AND WHEREAS, it is determined that all persons, firms and corporations who and which shall be affected by said vacation have filed with the City Commission their written consent to the same, and that it is necessary for the health, welfare, comfort and safety of the people of the City to vacate and discontinue such alley, subject to the limitations hereinafter set forth,

NOW, THEREFORE, BE IT RESOLVED, that said portion of said alley be and the same is hereby vacated, and the land shall revert to the abutting property free from any claim or right on the part of the public, except as hereinafter set forth, and that all other public claims and rights in and to said alley are hereby forever barred.

BE IT FURTHER RESOLVED, that the vacation of said alley is upon the condition that the title to all water, sewer, and gas pipe, appurtenances and facilities; and all electric and communication poles, wires, conduits, cables, appurtenances and facilities now or hereafter in, under or over said street are reserved to and shall remain in the respective owners thereof, their successors or assigns, together with the easement and continued right to occupy said street, within the right-of-way thereof for public utility purposes, with present and additional facilities and to operate, repair, maintain, replace and remove the same to the same effect and in the same manner as if said street remained a public way.

* * *

State of Michigan)
County of Jackson) ss.
City of Jackson)

I, H. M. Conway, Clerk in and for the City of Jackson, County and State aforesaid, do hereby certify that the foregoing is a true and complete copy of a Resolution adopted by the City Commission of the City of Jackson, Michigan, on December 19, 1972.

IN WITNESS WHEREOF, I have hereto affixed my signature and the seal of the City of Jackson, Michigan, this 19th day of December, 1972.

H. M. Conway CITY CLERK

Jackson
13829

FEB 15 1 40 PM '73

REGISTER OF DEEDS
JACKSON COUNTY, MICH.

Frank M. Wills

A. H. COUNTY CLERK

WHEREAS, petition has been filed by all of the persons, firms, and corporations owning property abutting on an alley in the City of Jackson, Michigan, for the vacation of said alley more particularly described as:

Alley adjoining Lots 121, 122, 123, 124, 125 and 126,
Williamson's Addition

AND WHEREAS, it is determined that all persons, firms and corporations who and which shall be affected by said vacation have filed with the City Commission their written consent to the same, and that it is necessary for the health, welfare, comfort and safety of the people of the City to vacate and discontinue such alley, subject to the limitations hereinafter set forth,

NOW, THEREFORE, BE IT RESOLVED, that said portion of said alley be and the same is hereby vacated, and the land shall revert to the abutting property free from any claim or right on the part of the public, except as hereinafter set forth, and that all other public claims and rights in and to said alley are hereby forever barred.

BE IT FURTHER RESOLVED, that the vacation of said alley is upon the condition that the title to all water, sewer, and gas pipe, appurtenances and facilities; and all electric and communication poles, wires, conduits, cables, appurtenances and facilities now or hereafter in, under or over said alley are reserved to and shall remain in the respective owners thereof, their successors or assigns, together with the easement and continued right to occupy said alley, within the right-of-way thereof for public utility purposes, with present and additional facilities and to operate, repair, maintain, replace and remove the same to the same effect and in the same manner as if said alley remained a public way.

* * *

State of Michigan)
County of Jackson) ss.
City of Jackson)

I, H. M. Conway, Clerk in and for the City of Jackson, County and State aforesaid, do hereby certify that the foregoing is a true and complete copy of a Resolution adopted by the City Commission of the City of Jackson, Michigan, on January 2, 1973.

IN WITNESS WHEREOF, I have hereto
affixed my signature and the seal
of the City of Jackson, Michigan,
this 2nd day of January, 1973.

H. M. Conway CITY CLERK



Jackson Allstar Dairy

Vacated 1/2/73

WILLIAMSON'S ADDITION.

Lots 122-125-126, 127,
121 & 128

13829

1320
1318
1316
1314
1312

DANIEL

RD

229	230
227	228
226	

VACATED 1-2-73

225	224
223	222
221	220
219	218
217	216
215	214

AVENUE

233	236
231	234
230	232

241	239
237	235
233	

229	228
227	226
225	224
223	222
221	220
219	218
217	216
215	214

AVENUE

231	229
227	225
223	221
219	217
215	

213	212
211	210
209	208
207	206
205	204

HIGBY

213	212
211	210
209	208
207	206
205	204

DURAND

213	211
209	207
205	

R

BY THE CITY COMMISSION:

WHEREAS, a petition has been filed by all of the persons, firms and corporations owning property abutting on or located in, under or over a street in the City of Jackson, Michigan, for the vacation of said street, more particularly described as:

That portion of Williamson Street in the City of Jackson, Jackson County, Michigan, described as being bounded on the East by Lot 16 of Robinson's Wisner Street Addition to the City of Jackson; on the South by Lot 19 of Williamson's Addition to the City of Jackson, according to the recorded plat thereof; on the North by Lot 18 of said Williamson's Addition; and on the West by the West line of said Lot 19 extended North to the Southwest corner of Lot 18 of said Williamson's Addition.

AND WHEREAS, it is determined that all persons, firms and corporations who and which will be affected by said vacation have filed with the City Commission their written consent to the same, and that it is necessary for the health, welfare, comfort and safety of the people of the City to vacate and discontinue such street;

NOW, THEREFORE, BE IT RESOLVED, that said street be and the same is hereby vacated, and the land shall revert to the abutting property free from any claim or right on the part of the public and that all public claims and rights in and to said street are hereby forever barred, and

BE IT FURTHER RESOLVED, that the vacation of said street is upon the condition that the title to all water, sewer, and gas pipe, appurtenances and facilities, and all electric and communication poles, wires, conduits, cables, appurtenances and facilities now or hereafter in, under, or over said street are reserved to and shall remain in the respective owners thereof, their successors or assigns, together with the easement and continued right to occupy said street within the right-of-way thereof for public utility purposes, with present and additional facilities and to operate, repair, maintain, replace and remove the same to the same effect and in the same manner as if said street remained a public way.

* * *

State of Michigan)
County of Jackson) ss.
City of Jackson)

I, Everett D. Cattell, Clerk in and for the City of Jackson, County and State aforesaid, do hereby certify that the foregoing is a true and compared copy of a resolution adopted by the City Commission of the City of Jackson, Michigan, on January 19, 1965.

IN WITNESS WHEREOF, I have hereunder affixed my signature and the seal of the City of Jackson, this 9th day of February, 1965.

Everett D. Cattell City Clerk

12/1/65
Eugene
Ward 2
Map 8-10

Williamson Addn.

Scale 1" = 100'

Vacation Street as crosshatched

