

On Section 34.

Know all men by these presents, that whereas the Common Council of the City of Jackson, by the adoption of a resolution (which was duly approved by the Mayor) at a meeting held July 20-1896, did vacate the southern portion of Grace Avenue, extending north from the northerly line of Wildwood Avenue to the westerly line of lots 4 and 5 as hereby platted in Withington's Subdivision of part of OAKLAWN Addition to the City of Jackson Michigan; now therefore we William H. Withington and Julia C. Withington his wife, as proprietors have caused the land embraced in the annexed plat and hereinafter described to be surveyed laid out and platted to be known as WITHINGTON'S SUBDIVISION of part of OAKLAWN ADDITION to the City of Jackson Michigan, and that Grace Avenue as thereon shown is hereby dedicated to the use of the public

Which said land so embraced in the said annexed plat is described as follows to wit: lots one, two, three, four, five, thirty, thirty one, thirty two, thirty three and thirty four (1-2-3-4-5-30-31-32-33-34) in Oaklawn Addition to the City of Jackson Michigan, also that part of Grace Avenue, as platted in said Oaklawn Addition, which lies between the northerly line of Wildwood Avenue and the north line of lots 5 and 30 in said Oaklawn Addition. Which premises above described include Grace Avenue hereby platted within the same lines as was heretofore conveyed to the City of Jackson for street purposes by deed from said W^m H. Withington and wife, dated July 20-1896 and recorded in liber 147 of Deeds at page 600.

In witness Whereof the said William H. Withington and Julia C. Withington his wife have hereunto set their hands and seals at the City of Jackson and State of Michigan, this 26th day of September 1896.

Signed and sealed in presence of:

Hannah McCall
Ella Murphy

William H. Withington
Julia C. Withington

(L.S.)

(L.S.)

State of Michigan } ss.
County of Jackson }

On this 26th day of September 1896 before me the undersigned a Notary Public in and for said County, personally came the above named William H. Withington and Julia C. Withington his wife, known to me to be the persons named in and who executed the above dedication and acknowledged the same to be their free act and deed.

Charles K. Perrine
Notary Public in and for
Jackson County Mich.

Surveyor's Certificate.

I hereby certify that the plat hereon delineated is a correct one

and that permanent monuments, consisting of iron pipe and solid iron pins from 1/4 to 1 1/2 inches in diameter and 20 to 30 inches long.

and thus for solid pins have been planted at points marked thus (X) as thereon shown at all angles in the boundaries of the land platted and at all intersections of streets, and at points of curve thereon shown.

Wm G. Fargo
SURVEYOR.

REGISTERS OFFICE, } ss. This instrument was presented and
JACKSON COUNTY. }

filed for record this 30th day of Oct. 1896 as proper certificate was furnished in compliance with Section 135, Act 206, Laws of 1893.

Recorded the 30th day of Oct. 1896 at 4 o'clock,

P. M., in Plat Book No. 5 on page 28

Wm G. Fargo
Register of Deeds.

Examined and Approved

Oct. 12 1896

D. B. Singer

Deputy Auditor General.

RECORDED AND FILED

IN AUDITOR GENERAL'S OFFICE

August 1st 1897
John J. Williams
Deputy Auditor General.

WITHINGTON'S SUBDIVISION OF PART OF OAKLAWN ADDITION

TO THE CITY OF JACKSON MICHIGAN.

SCALE, 80 FEET TO AN INCH

ORDER OF VACATION

That part of Grace street lying between Wildwood Ave. and the North line of Lots 5 and 30 as shown on this plat vacated by Jackson City Commission May 14-1925.

Now- 427-1925

STATE OF MICHIGAN, } ss.
COUNTY OF JACKSON. }

Register of Deeds, and Wm G. Fargo Surveyor, hereby certify that we have each carefully compared this copy with the original plat of Withington's Subdivision of part of Oaklawn Addition to the City of Jackson Michigan and that it is an exact copy thereof and of the whole of such original map or plat.

Wm G. Fargo
Register of Deeds.

Wm G. Fargo
Surveyor.


STATE OF MICHIGAN, } ss.
COUNTY OF JACKSON. }

Register of Deeds, and Wm G. Fargo Surveyor, hereby certify that we have each carefully compared the annexed copy with the plat of Withington's Subdivision of part of Oaklawn Addition to the City of Jackson Michigan now of record in the office of said Register of Deeds, and that it is a true transcript therefrom and of the whole of such record.

Wm G. Fargo
Register of Deeds.

Wm G. Fargo
Surveyor.

Note: Blue lines and figures pertain to the Plat of OAKLAWN Addition.
Points of reverse curve at A, and B are 65 feet north of south line of lots 4 and 31.

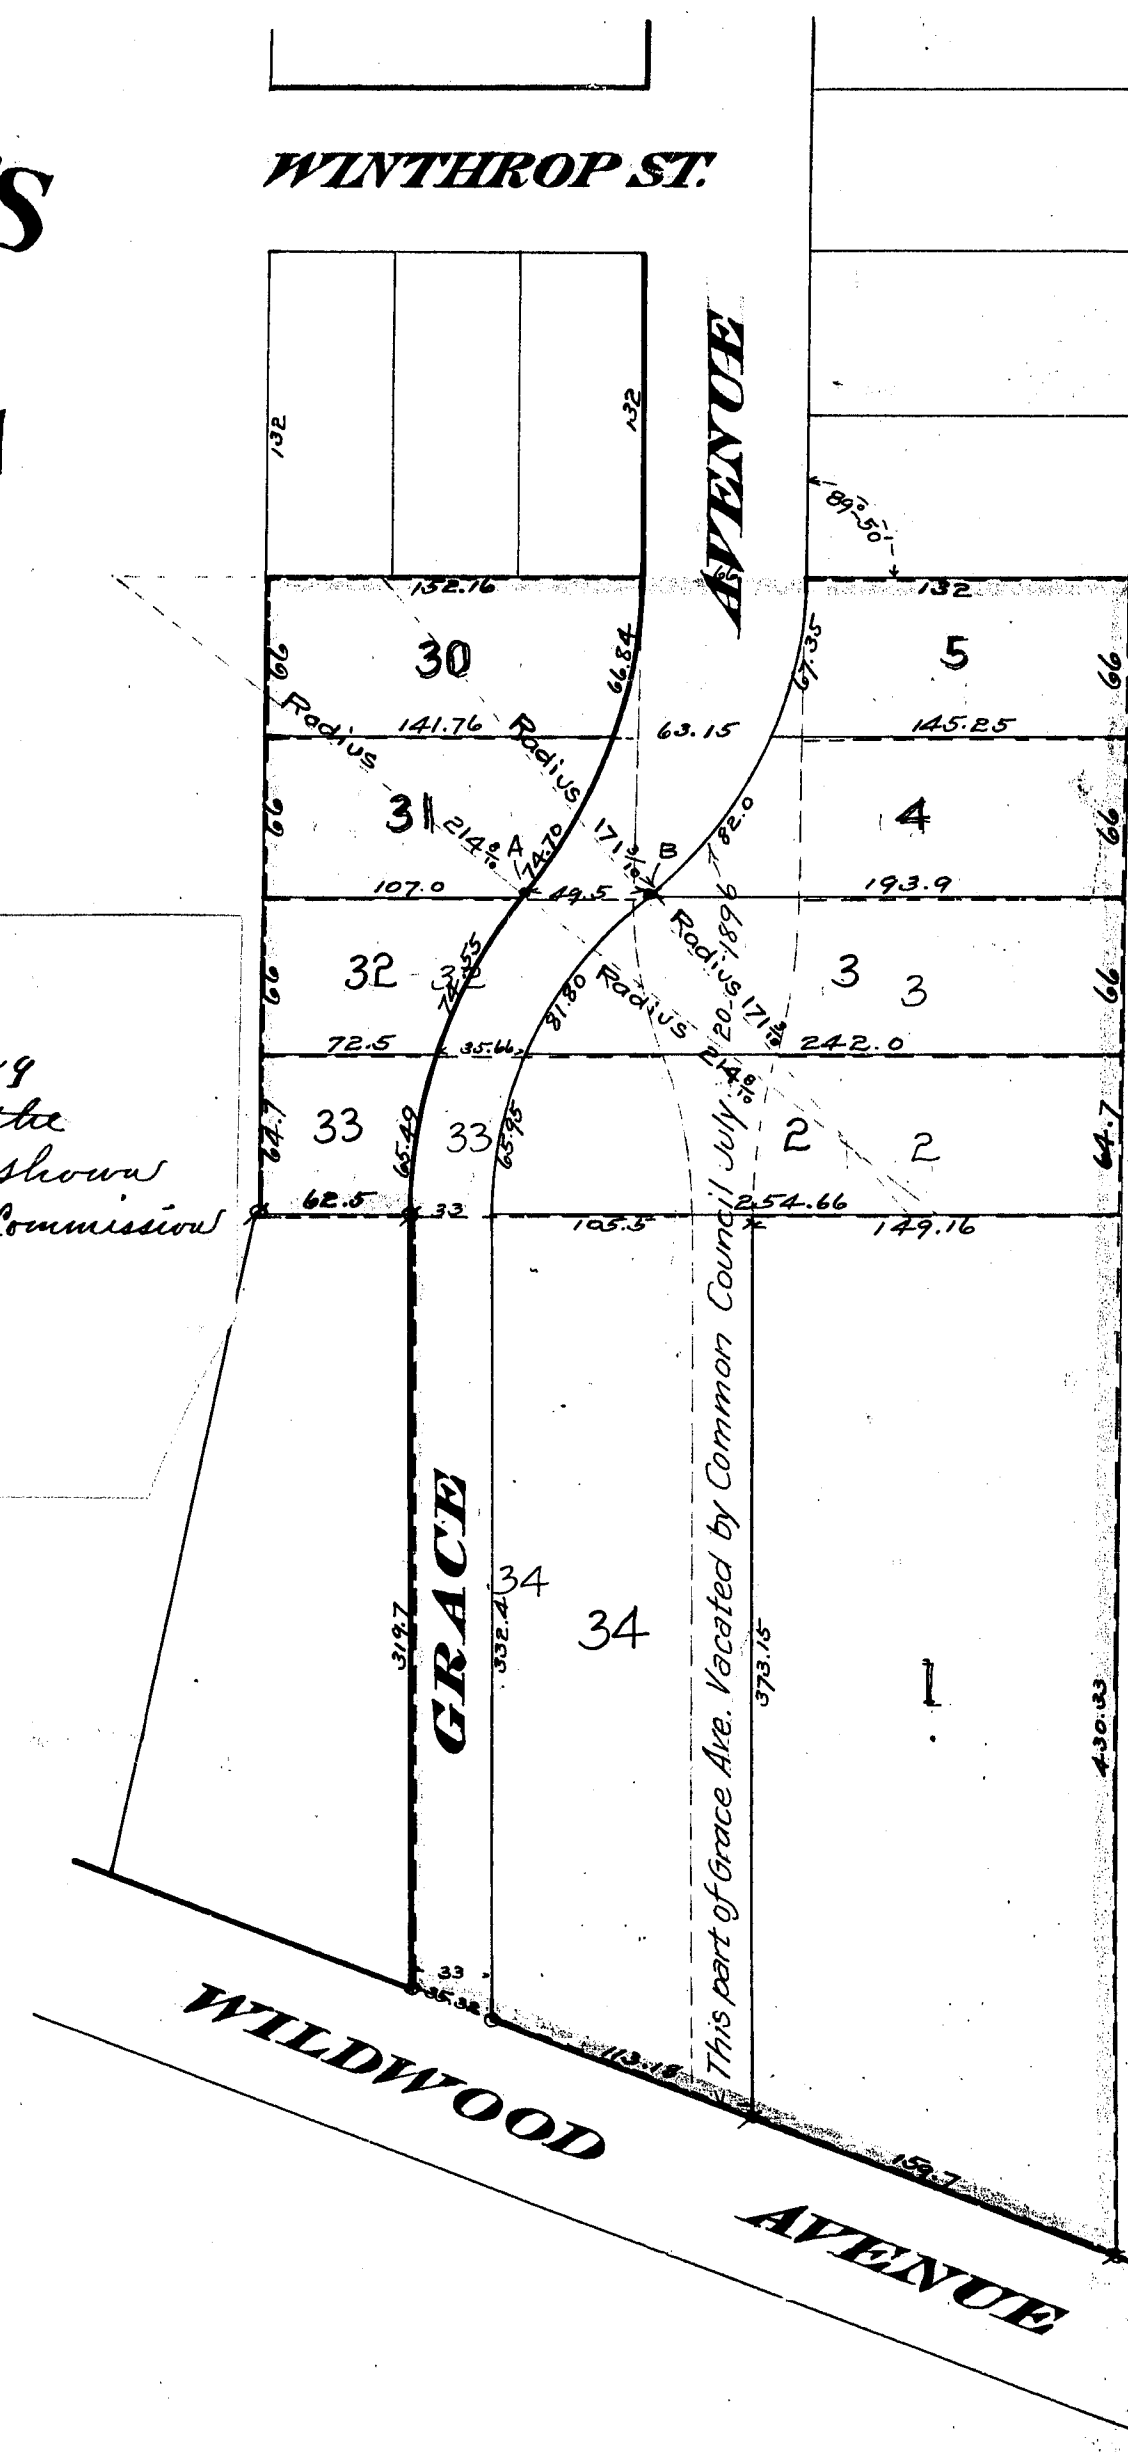

13833

Know all men by these presents, that whereas the Common Council of the City of Jackson, by the adoption of a resolution (which was duly approved by the Mayor) at a meeting held July 20-1896, did vacate the southern portion of Grace Avenue, extending north from the northerly line of Wildwood Avenue to the westerly line of lots 4 and 5 as hereby platted in Withington's Subdivision of part of OAKLAWN Addition to the City of Jackson Michigan; now therefore we William H. Withington and Julia C. Withington his wife, as proprietors have caused the land embraced in the annexed plat and hereinafter described to be surveyed laid out and platted to be known as WITHINGTON'S SUBDIVISION of part of OAKLAWN ADDITION to the City of Jackson Michigan, and that Grace Avenue, as hereon shown is hereby dedicated to the use of the public

Which said land so embraced in the said annexed plat is described as follows to wit: lots one, two, three, four, five, thirty, thirty one, thirty two, thirty three and thirty four (1-2-3-4-5-30-31-32-33-34) in Oaklawn Addition to the City of Jackson Michigan, also that part of Grace Avenue, as platted in said Oaklawn Addition, which lies between the northerly line of Wildwood Avenue and the north line of lots 5 and 30 in said Oaklawn Addition. Which premises above described include Grace Avenue hereby platted within the same lines as was heretofore conveyed to the City of Jackson for street purposes by deed from said W^m H. Withington and wife, dated July 20-1896 and recorded in liber 147 of Deeds at page 600.

In witness Whereof the said William H. Withington and Julia C. Withington his wife have hereunto set their hands and seals at the City of Jackson and State of Michigan, this 26th day of September 1896.

Signed and Sealed in presence of:

Hannah McCall
Ella Murphy

William H. Withington
Julia C. Withington

(L.S.)

(L.S.)

State of Michigan } ss.
County of Jackson }

On this 26th day of September 1896 before me the undersigned a Notary Public in and for said County, personally came the above named William H. Withington and Julia C. Withington his wife, known to me to be the persons named in and who executed the above dedication, and acknowledged the same to be their free act and deed.

Charles K. Perrine
Notary Public in and for
Jackson County Mich.

Surveyor's Certificate.

I hereby certify that the plat hereon delineated is a correct one

and that permanent monuments, consisting of iron pipe and
solid iron pins from 3/4 to 1 1/2 inches in diameter
and 20 to 30 inches long

and thus for solid pins
have been planted at points marked thus on the plat as thereon shown
at all angles in the boundaries of the land platted and at all intersections of streets, and at points of curve, thereon shown.

Wm G Fargo
SURVEYOR.

REGISTERS OFFICE, } ss.
JACKSON COUNTY. }

filed for record this 26th day of Sept, 1896, as proper certificate was furnished in compliance with Section 135, Act 206, Laws of 1893.

Recorded the 30th day of Dec, 1896 at 4 o'clock,

P.M., in Plat Book No. 3 on page 28

Wm G Fargo
Register of Deeds.

Examined and Approved

Oct 12 1896

D. B. Singer
Deputy Auditor General.

RECORDED AND FILED

IN AUDITOR GENERAL'S OFFICE

John J. McKeen
Deputy Auditor General

WITHINGTON'S SUBDIVISION OF PART OF OAKLAWN ADDITION

TO THE CITY OF JACKSON MICHIGAN.

SCALE: 80 FEET TO AN INCH

ORDER OF VACATION

That part of Grace Street lying between Wildwood Ave. and the North line of lots 5 and 30 as shown on this plat vacated by Jackson City Commission May 14-1925.

Now-427-1925

STATE OF MICHIGAN, } ss.
COUNTY OF JACKSON. }

Register of Deeds, and Wm G Fargo, Surveyor, hereby certify that we have each carefully compared this copy with the original plat of Withington's Subdivision of part of Oaklawn Addition to the City of Jackson Michigan, and that it is an exact copy thereof and of the whole of such original map or plat.


Wm G Fargo
Register of Deeds.
Wm G Fargo
Surveyor.

STATE OF MICHIGAN, } ss.
COUNTY OF JACKSON. }

Register of Deeds, and Wm G Fargo, Surveyor, hereby certify that we have each carefully compared the annexed copy with the plat of Withington's Subdivision of part of Oaklawn Addition to the City of Jackson Michigan, and that it is a true transcript therefrom and of the whole of such record.

Wm G Fargo
Register of Deeds.
Wm G Fargo
Surveyor.

Note: Blue lines and figures pertain to the Plat of OAKLAWN Addition.
Points of reverse curve at A, and B are $\frac{65}{100}$ feet north of south line of lots 4 and 31.

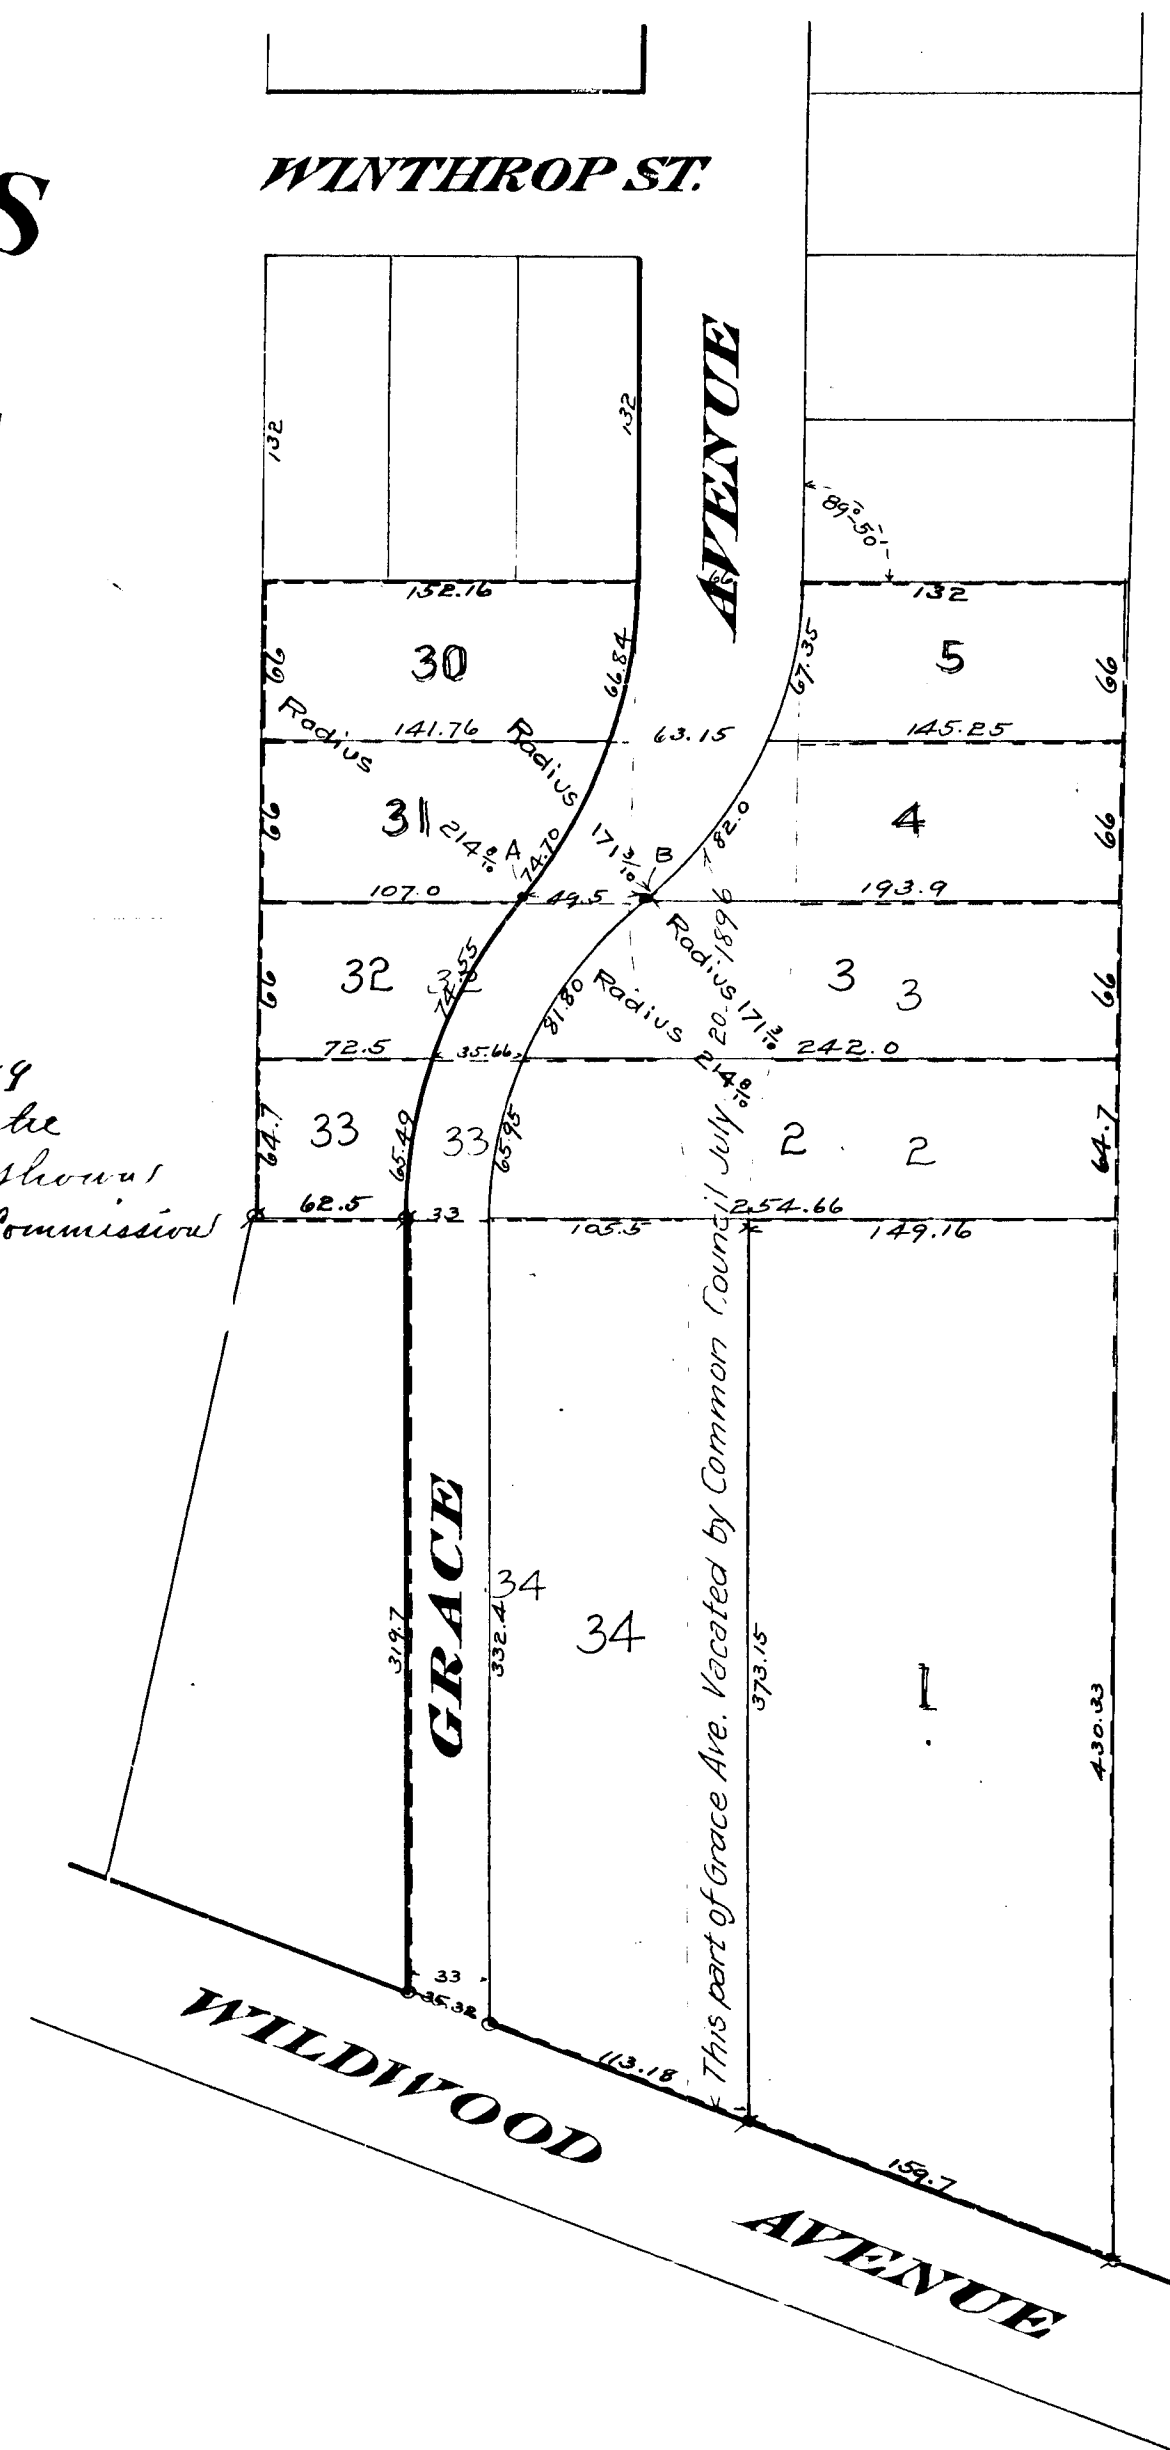

13833