

Know all men by these presents, that we Stephen H Carroll as proprietor, and Lena Carroll his wife, have caused the land embraced in the annexed plat and hereinafter described to be surveyed laid out and platted to be known as FOURTH STREET ADDITION to the City of Jackson, Michigan, and the streets and alleys shown on said plat are hereby dedicated to the use of the public.

In Witness Whereof we have hereunto set our hands and seals this 12th day of October 1899.

Signed and Sealed in presence of,

Thomas J. Birney
M.A. Henry

Stephen H. Carroll (L.S.)
Mrs Lena Carroll (L.S.)

STATE OF Michigan

COUNTY OF Jackson On this 12th day of October

1899 before me, a Notary Public in and for said county, personally came the above named.

Stephen H. Carroll
and Lena Carroll

Known to me to be the person &c. named in and who executed the above dedication

and acknowledged the same to be their free act and deed.

Thomas J. Birney
Notary Public Jackson County Mich.

Description of Land Platted.

The land embraced in the annexed plat of Fourth Street Addition is described as follows to wit; The south one third (1/3) of the southwest quarter of the northwest quarter of section three (3) in Town three (3) south, Range one (1) West; excepting therefrom a parcel of land commencing at a point three hundred and twenty three (323) feet north and thirty three (33) feet west of the southeast corner of above described land, running thence west parallel with quarter section line one hundred twenty (20) feet thence north fifty six and nine tenths (56 9/10) feet, thence east one hundred twenty (20) feet, thence south fifty seven and eight tenths (57 8/10) feet to the place of beginning.

Surveyor's Certificate.

I hereby certify that the plat hereon delineated is a correct one

and that permanent monuments, consisting of iron pipes one inch in diameter and twenty three to thirty six inches long have been planted at points marked thus as as thereon shown at all angles in the boundaries of the land platted and at all intersections of streets, in streets and alleys

104
Revenue Stamp
Cancelled

Wm. J. Fargo
Surveyor


Examined and Approved

Oct. 21st 1899

John F. Wilkinson
Deputy Auditor General.

FOURTH STREET ADDITION TO THE CITY OF JACKSON MICHIGAN.

Note: Part of lots 18 & 19 deeded to City of Jackson recorded Dec. 30 1915 (shown in red) V139-36

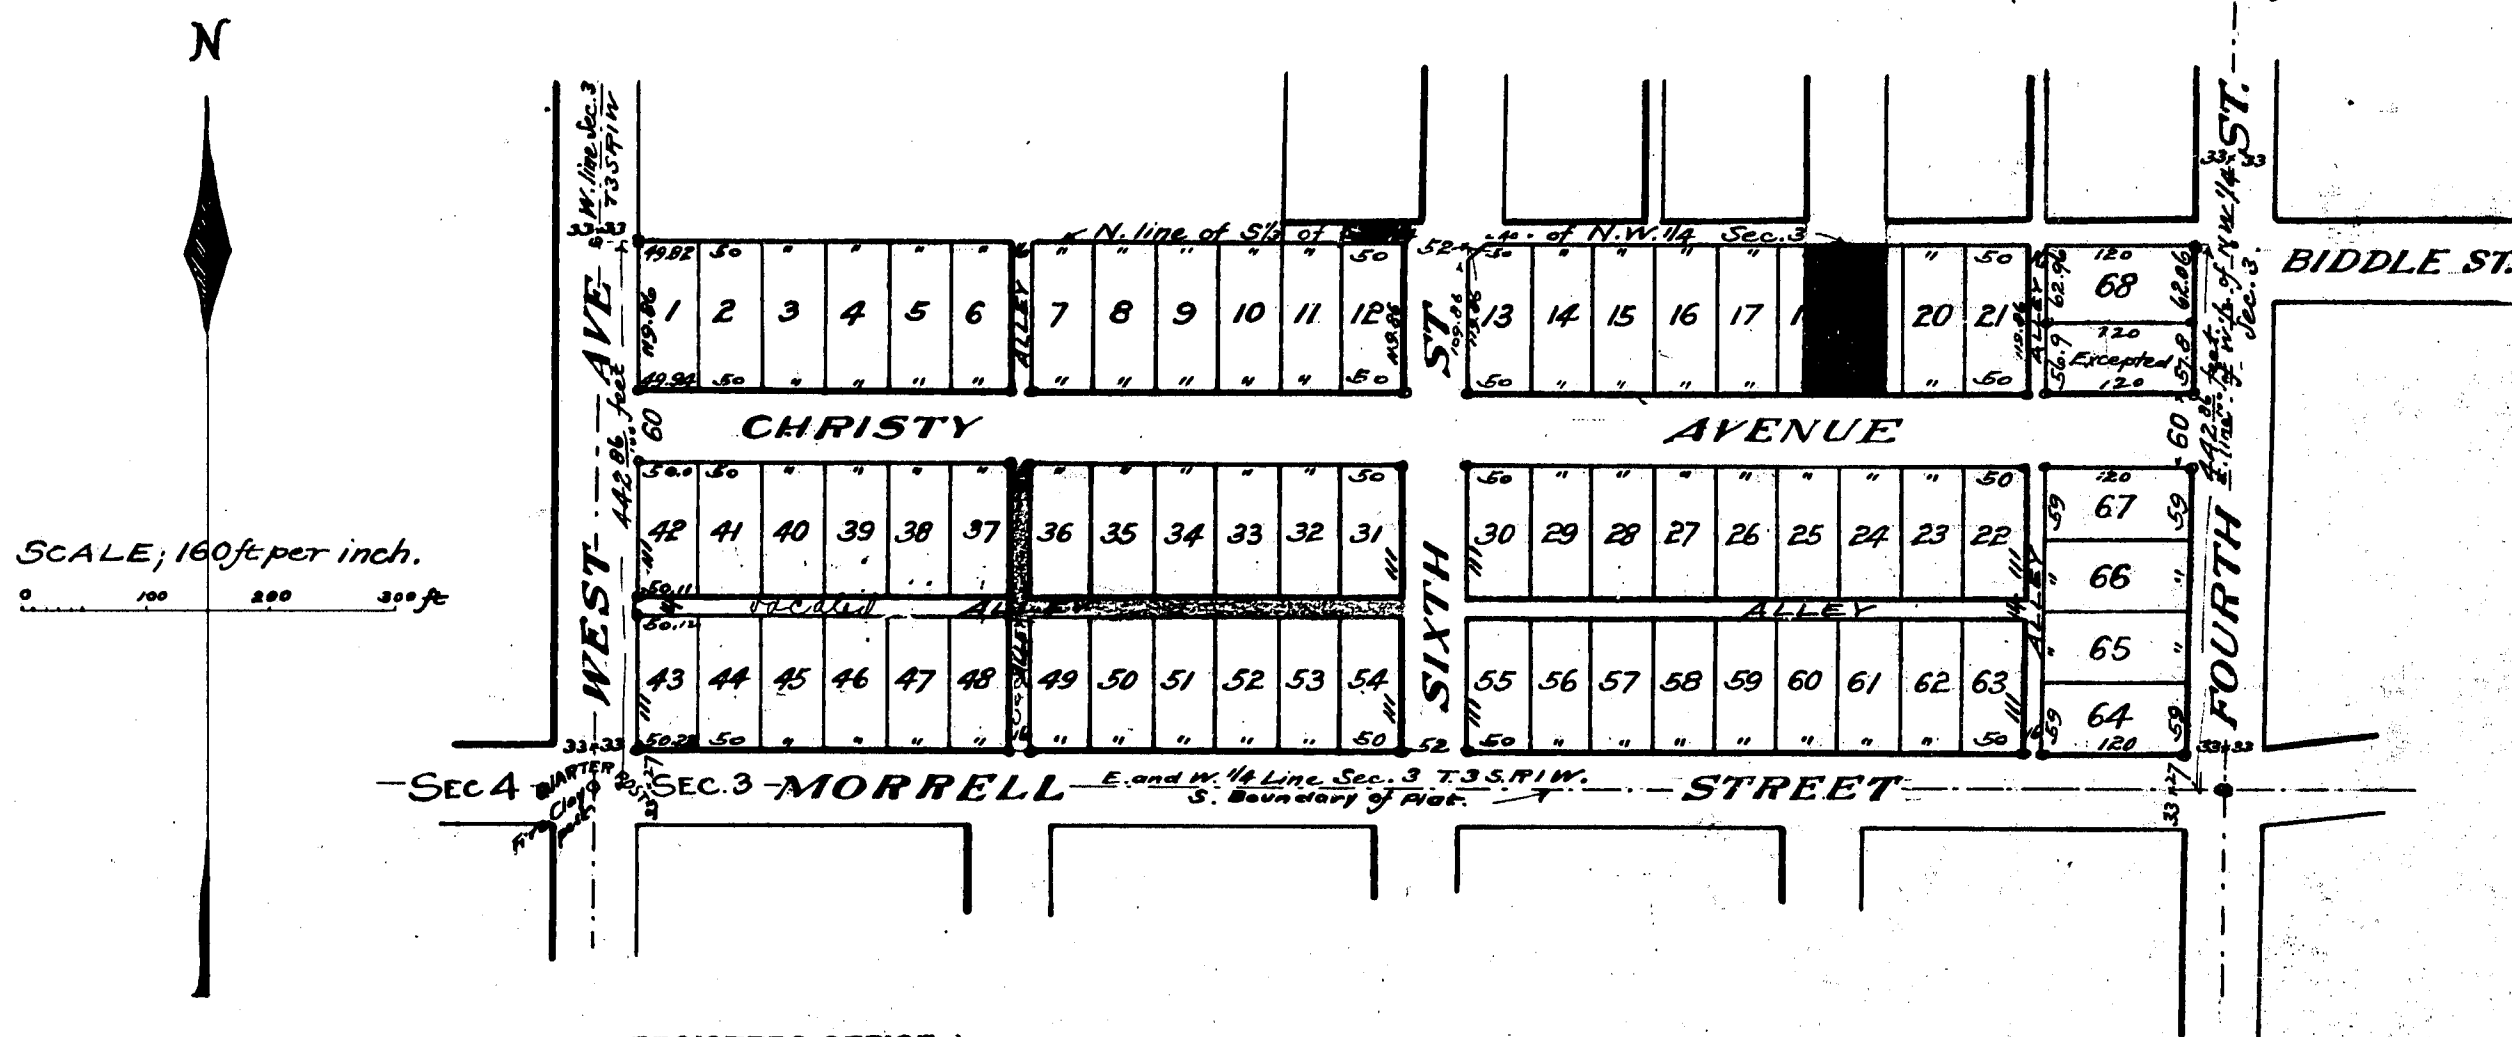

REGISTERS OFFICE, JACKSON COUNTY. ss This instrument was presented and

filed for record this 31st day of October 1899 as proper certificate was furnished in compliance with Section 135, Act 154 Laws of 1895

Recorded the 31st day of October 1899 at 11:25 o'clock.

A.M., in Plat Book No. 14 on page 14

Wesley Sears
Register of Deeds.

VACATED BY RESOLUTION
OF City Commission
Aug. 26, 1932
VOUCHER No. 359-53

VACATED BY RESOLUTION
OF City Commission
Aug. 11, 1932
VOUCHER No. 283-62

STATE OF MICHIGAN, ss We Wesley Sears

Register of Deeds, and Wm. J. Fargo Surveyor, hereby certify that we have each carefully compared this copy with the original plat of Fourth Street Addition to the City of Jackson Michigan and that it is an exact copy thereof and of the whole of such original map or plat.

Wesley Sears
Register of Deeds.

Wm. J. Fargo
Surveyor.

104
Revenue Stamp
Cancelled

RECEIVED AND FILED.
IN AUDITOR GENERAL'S OFFICE,

June 6, 1900
John F. Wilkinson
Deputy Auditor General.

ORDER of vacation

South 111 ft of alley, between
Lots 48 & 49 vacated by
Resolution of Common
Council adopted 1009/27

Voucher 1557/27 & V139-36

ORDER OF VACATION

West 300 ft of E & W alley, being
that part between Lots 37 to 42
and 43 to 48 vacated by Resolution
of City Commission adopted 409/1928
Voucher 503-1928 & Vm 139-36

STATE OF MICHIGAN, ss We Wesley Sears

Register of Deeds, and Wm. J. Fargo Surveyor, hereby certify that we have each carefully compared the annexed copy with the plat of Fourth Street Addition to the City of Jackson Michigan now of record in the office of said Register of Deeds, and that it is a true transcript therefrom and of the whole of such record.

Wesley Sears
Register of Deeds.

Wm. J. Fargo
Surveyor.

104
Revenue Stamp
Cancelled

22333-190

13845

4842

Know all men by these presents, that we Stephen H Carroll as proprietor, and Lena Carroll his wife, have caused the land embraced in the annexed plat and hereinafter described to be surveyed laid out and platted to be known as FOURTH STREET ADDITION to the City of Jackson, Michigan, and the streets and alleys shown on said plat are hereby dedicated to the use of the public.

In Witness Whereof we have hereunto set our hands and seals this 12th day of October 1899.

Signed and Sealed in presence of,

Thomas J. Birney
M.A. Neary

Stephen H. Carroll (L.S.)
Mrs Lena Carroll (L.S.)

STATE OF Michigan

COUNTY OF Jackson On this 12th day of October 1899 before me, a Notary Public in and for said county, personally came the above named.

Stephen H. Carroll
and Lena Carroll

Known to me to be the person or persons named in and who executed the above dedication and acknowledged the same to be their free act and deed.

Thomas J. Birney
Notary Public Jackson County, Mich.


Description of Land Platted.

The land embraced in the annexed plat of Fourth Street Addition is described as follows to wit; The south one third (1/3) of the southwest quarter of the northwest quarter of section three (3) in Town three (3) south, Range one (1) West; excepting therefrom a parcel of land commencing at a point three hundred and twenty three (323) feet north and thirty three (33) feet west of the southeast corner of above described land, running thence west parallel with quarter section line one hundred twenty (20) feet thence north fifty six and nine tenths (56 9/10) feet, thence east one hundred twenty (20) feet, thence south fifty seven and eight tenths (57 8/10) feet to the place of beginning.

Surveyor's Certificate.

I hereby certify that the plat herein delineated is a correct one

and containing monuments, consisting of one inch in diameter and twenty three
to thirty six inches long
have been planted at points marked thereon as shown at all angles in the boundaries of the land platted and at all intersections of streets, alleys and allies

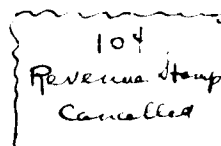


John F. Wilkinson
Deputy Auditor General.

Examined and Approved
Oct. 21st 1899
John F. Wilkinson
Deputy Auditor General.

FOURTH STREET ADDITION TO THE CITY OF JACKSON MICHIGAN.

Note: Part of Lots 18819 deeded to City of Jackson recorded Dec. 31, 1915 (shown in red) V139-36

N
SCALE: 160 ft. per inch.
0 100 200 300 ft
S

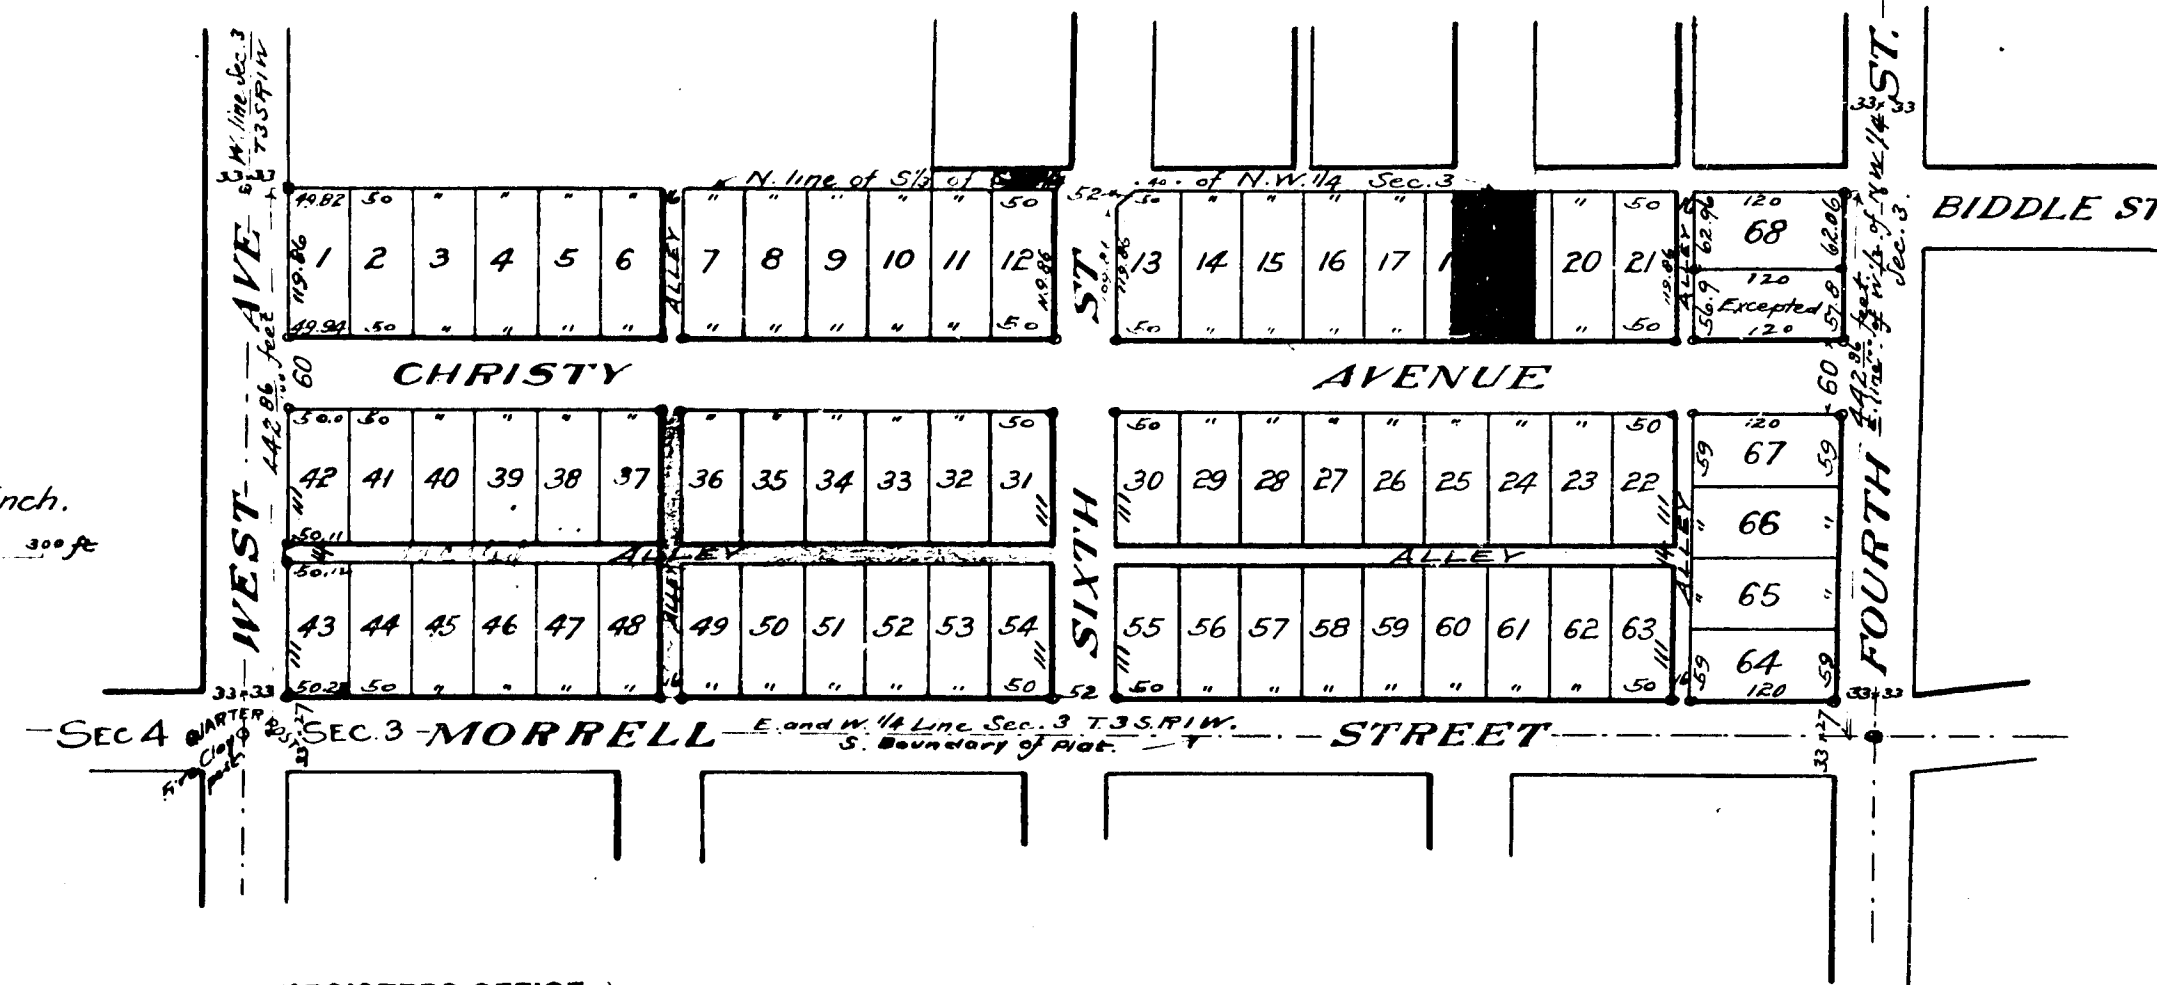



REGISTERS OFFICE, JACKSON COUNTY, MI. This instrument was presented and

filed for record this 31st day of October 1899 as proper certificate was furnished in compliance with Section 135, Act 154 Laws of 1895

Recorded the 31st day of October 1899 at 11²⁵ o'clock.

A.M., in Plat Book No. 16 on page 14


Wesley Seare Register of Deeds.

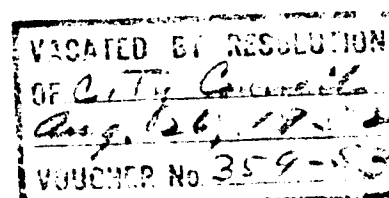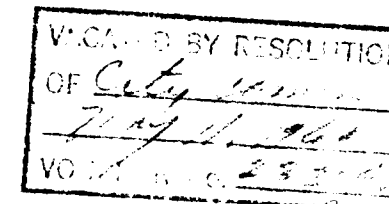

STATE OF MICHIGAN, COUNTY OF JACKSON, MI. We, Wesley Seare

Register of Deeds, and John F. Wilkinson Surveyor, hereby certify that we have each carefully compared this copy with the original plat of Fourth Street Addition to the City of Jackson, Michigan and that it is an exact copy thereof and of the whole of such original map or plat.

Wesley Seare Register of Deeds.
John F. Wilkinson Surveyor.

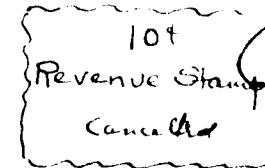

RECEIVED AND FILED.
IN AUDITOR GENERAL'S OFFICE,
JUL 1 1900
John F. Wilkinson
Deputy Auditor General.

ORDER OF VACATION

South 111 ft of alley between Lots 48 & 49 vacated by Resolution of Common Council adopted Nov 9/27 Voucher 1557/27 & V139-36

ORDER OF VACATION

West 300 ft of E & W alley being that part between Lots 37 to 42 and 43 to 48 vacated by Resolution of City Commissioners adopted Apr 9 1928 Voucher 503-1928 & Vm 139-36

STATE OF MICHIGAN, COUNTY OF JACKSON, MI. We, Wesley Seare

Register of Deeds, and John F. Wilkinson Surveyor, hereby certify that we have each carefully compared the annexed copy with the plat of Fourth Street Addition to the City of Jackson, Michigan and that it is a true transcript thereof and of the whole of such record.

Wesley Seare Register of Deeds.
John F. Wilkinson Surveyor.



13845

4842