


By City Commission, City of Jackson, Mississippi, vacated August 11-1927

Book 114-1929

By resolution of the City Commission vacated August 11-1927

Books in the map are placed in the same order as in the map

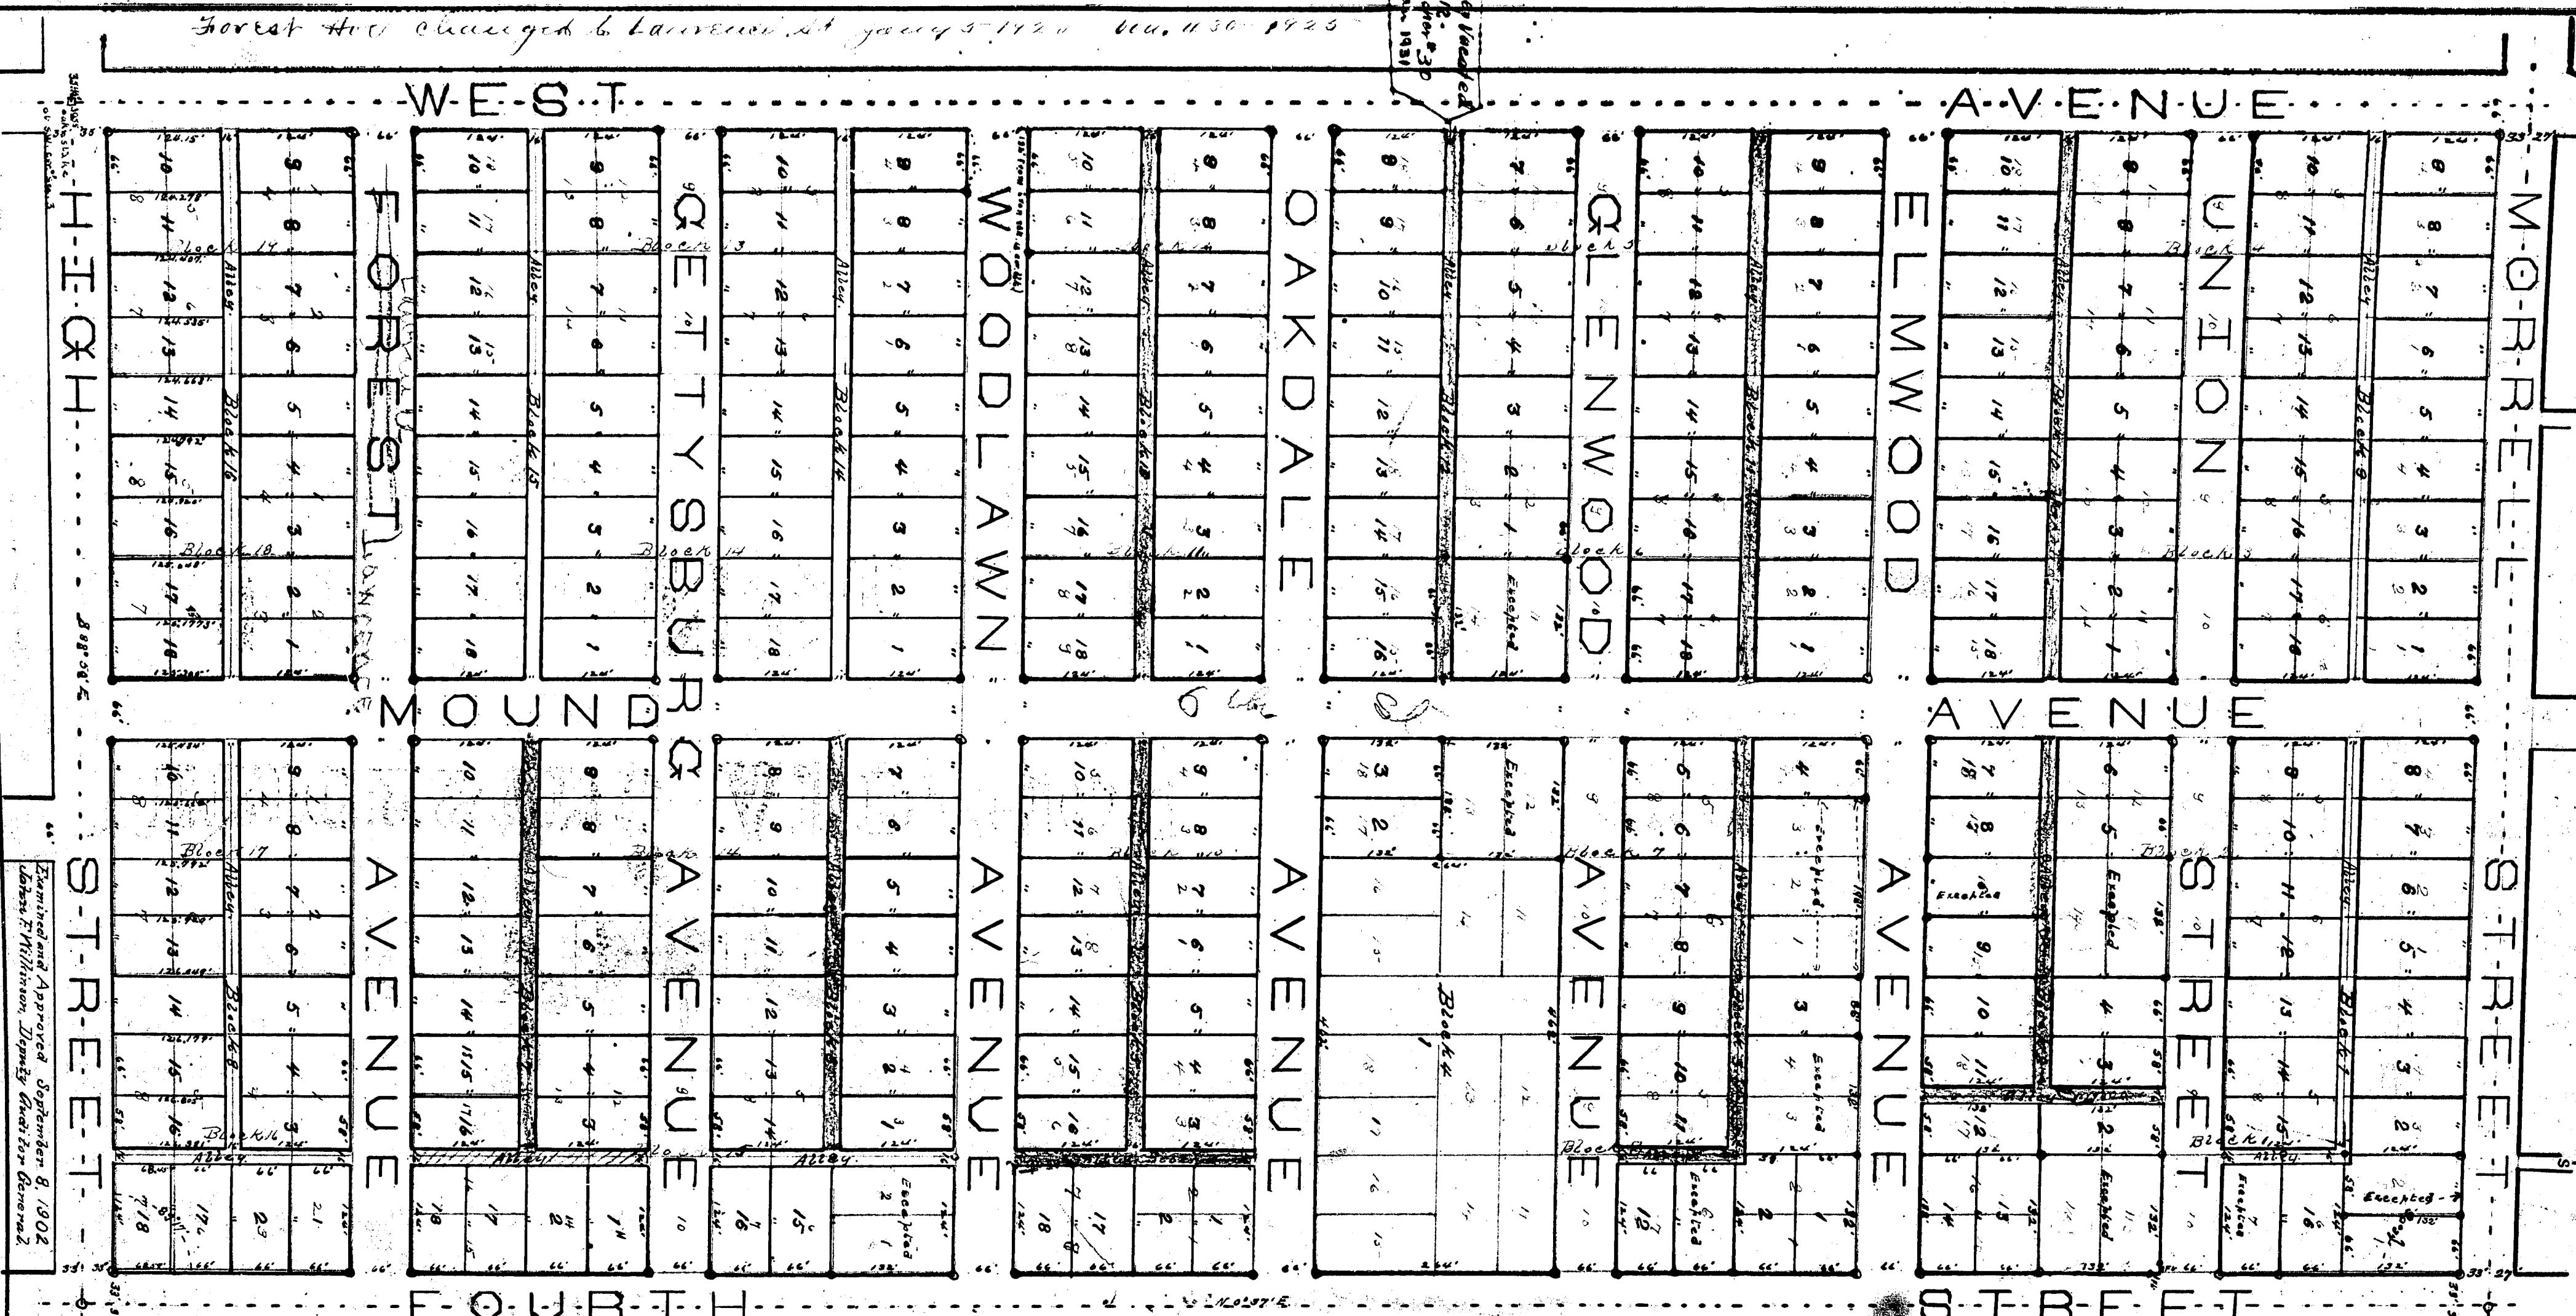

JACKSON MOUND ADDITION

RECEIVED AND FILED.
AUDITOR GENERAL'S OFFICE.

August 31, 1927

Know all men by these presents, that the C. H. Manly Company, Limited, as proprietors have caused the land embraced in the annexed plat to be surveyed and out and platted to be known as Jackson Mound Addition to the City of Jackson, Mississippi, and the streets as shown on said plat are hereby dedicated to the use of the public. The alleys are to be the joint property of all owners of land in the block through which the alley passes and to be closed only by the consent of all the owners of lands in said block. All trees, gravel, sand and stone in said streets are hereby reserved to the party of the first part.

In Witness Whereof "The C. H. Manly Company, Limited," has caused these presents to be signed by Charles H. Manly, its Chairman and George H. Ormstead, its Treasurer, this 25 day of July, 1902

Signed in presence of
Charles H. Manly, Chairman
George H. Ormstead, Treasurer

State of Michigan: before me a Notary Public in and for said County, personally came the above named Charles H. Manly, Chairman and George H. Ormstead, Treasurer of the C. H. Manly Company, Limited, to me known to be the persons named in and who executed the above dedication and acknowledged the same to be their free act and deed and the free act and deed of said Company.

Notary Public.
Mesley Dears

Description of Land Platted
The land embraced in the annexed plat of Jackson Mound Addition is described as follows to-wit: The West half of the South West quarter of Section 3 Town 3 South Range 1 West, excepting therefrom Lots 2, 7, 11, 14 Block 1, Lots 13, 14, 16 Block 2, Lots 11, 14 Block 5, Lots 1, 2, 3, 12, 13 Block 7, Lots 3, 4, 6 Block 8, Lots 1, 2 Block 15 Lathrop's Addition

Surveyors Certificate
I hereby certify that the plat herein delineated is correct one and that permanent monuments consisting of iron pipe from 1 to 1 1/2 and 16 long have been planted at points marked @, as shown on the plat, and that the boundaries of land platted and at the intersection of all streets.

Josiah B. Frost, Surveyor
State of Michigan: Mesley Dears, Register of Deeds County of Jackson, and H. G. Manly, Draftsman hereby certify that we have each carefully compared this copy with the Original plat of Jackson Mound Addition to the City of Jackson, Michigan, and that it is an exact copy thereof and of the whole of such map or plat.

Mesley Dears, Register of Deeds
H. G. Manly, Draftsman

State of Michigan: The within instrument was County of Jackson Received for record the 31 day of Sept A.D. 1902 at 9 o'clock A.M., and recorded in Liber 6 of Plats on Page 20. The Tax Certificate required by the laws of the State of Michigan is required by the laws of the State of Michigan. Mesley Dears, Register of Deeds County of Jackson, and H. G. Manly, Draftsman hereby certify that we have each carefully compared the annexed copy with the plat of Jackson Mound Addition now of record in the office of said Register of Deeds, and that it is a true transcript thereof and of the whole of such record.

Mesley Dears, Register of Deeds.
H. G. Manly, Draftsman.

City of Jackson
 Recorder's Office
 100 N. 1st St.
 Jackson, Miss.
 39201

Scale 1/8" = 100'

Order of location
 Resolution of the City Commission passed
 at a regular session held on the 25th day of
 March 1923 - Volume 287-1923.

JACKSON MOUNTAIN ADDITION

RECEIVED AND FILED
 IN THE CITY CLERK'S OFFICE
 March 31 1923

Know all men by these presents, That the C. H. Manly Company, Limited, as promoters have caused the land embraced in the annexed plat to be surveyed and laid out and platted to be known as Jackson Mountain Addition to the City of Jackson, Michigan, and the streets as shown on said plat are hereby dedicated to the use of the public. The alleys are to be the joint property of all owners of land in the block through which the alley passes and to be closed only by the consent of all the owners of lands in said block. All trees, gravel, sand and stone in said streets are hereby reserved to the party of the first part.

In Witness Whereof "The C. H. Manly Company, Limited," has caused these presents to be signed by Charles H. Manly, its Chairman and George H. Olmstead, its Treasurer, this 25 day of July 1902

Signed and attested in presence of
 Charles H. Manly, Chairman
 George H. Olmstead, Treasurer

State of Michigan: On this 25 day of July 1902 County of Jackson: before me a Notary Public in and for said County, personally came the above named Charles H. Manly, Chairman and George H. Olmstead, Treasurer of the C. H. Manly Company, Limited, to me known to be the persons named in and who executed the above dedication and acknowledged the same to be their free act and deed and the free act and deed of said Company.

Notary Public.
 Wesley Sears

Description of Land Platted
 The land embraced in the annexed plat of Jackson Mountain Addition is described as follows to-wit: The West half of the South West quarter of Section 3 Town 3 South Range 1 West - excepting therefrom Lots 2, 11, 14 Block 1, Lots 13, 14, 16 Block 2, Lots 11, 14 Block 6, Lots 1, 2, 3, 12, 13 Block 7, Lots 3, 4, 6 Block 8, Lots 1, 2 Block 15 Lathrop's Addition.

I hereby certify That the plat hereon delineated is a correct one and that permanent monuments consisting of iron pipe from 1 to 1 1/2 inch and 16 long have been planted at points marked on, as thereon shown angles in the boundaries of land platted and at the intersection of all streets.

Josiah B. Frost, Surveyor
 State of Michigan: The Wesley Sears, Register of Deeds County of Jackson, and H. B. Manly, Draftsman hereby certify that we have each carefully compared this copy with the Original plat of Jackson Mountain Addition to the City of Jackson, Michigan, and that it is an exact copy thereof and of the whole of such map or plat.

Wesley Sears Register of Deeds
 H. B. Manly Draftsman

State of Michigan: The within instrument was Received for Record the 9 day of Sept. A.D. 1902 at 9 o'clock A.M., and recorded in Liber 6 of Plats on Page 20. The Tax Certificate required by Law has been furnished Wesley Sears, Register of Deeds State of Michigan. The Wesley Sears, Register of Deeds County of Jackson and H. B. Manly, Draftsman hereby certify that we have each carefully compared the annexed copy with the plat of Jackson Mountain Addition now of record in the office of said Register of Deeds, and that it is a true transcript thereof from and of the whole of such record.

Wesley Sears Register of Deeds.
 H. B. Manly, Draftsman.

