


JACKSON CO., MICH.

LOCATED ON THE SOUTH-EAST FRACTIONAL 1/4

OF
SECTION 24, T.3S., R.1E5).

Scale-100' to 1."

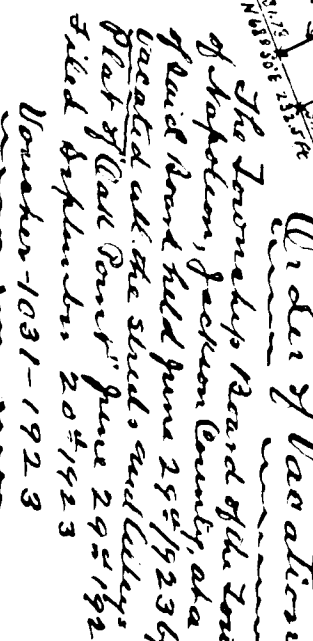

STATE OF MICHIGAN, }
COUNTY OF JACKSON, } SS.
REGISTRAR'S OFFICE.

The Tax Certificate required by law having been furnished.

DEDICATION.

Known and mostly these presents that we
 name. To - 6000 population, and obtained of such this
 we have caused the land embraced in the following
 descriptions and shown in the annexed plat to be surveyed,
 laid out and granted, to be known as OAK POINT
 fraction of County, Michigan). Y^{tes}.

Description

SIGNED AND SEALED IN PRESENCE OF
 Anna & Charles
 M. S. Carter
 Daniel M. Cook
 Daniel S. Cook

State of Michigan, ss. On this 28th day of April A. 1903
County of Jackson, ss. before me a Notary Public in and for said county personally ap-
peared the above named Frank M. Cook and Alva E. Cook his wife
known to me to be the persons named in and who executed the
above declaration and severally acknowledged the same before me
free act and deed.
Notary Public.
James W. McKill

SURVEYORS' CERTIFICATE

[illegible]

meets in order to
don't get out.
paid 13. 17th

} SURVEYORS,

Examined and Approved

June 13, 1903

IN AUDITOR GENERAL'S OFFICE

Deputy Auditor General

State of Mississippi } ss. The Olney Sears, Register of Deeds, and
County of Jackson, } Josiah B. Bryant, Surveyor, hereby certify that
we have carefully compared the annexed copy with the plat of OAK
POINT, Jackson County, Mississippi, soon of record in the office of
said Register of Deeds, and that it is a true and correct thereof, which
of said record.

Witness my hand and seal, this 11th day of March, A.D. 1884.

Josiah B. Bryant
REGISTER OF DEEDS
SURVEYOR.

The Walter Searcy, Register of Deeds, and
Joseph B. Frost, Surveyor, hereby certify that
 compared the annexed copy with the plat of OAK
 lands, the original town of record in the office of
 said Register is a duplicate of those of said plat which
 is an exact copy thereof and of the whole of said original
 map or plat
 Witness my hand and seal of office this 1st day of
 July 1894.
Walter Searcy REGISTER OF DEEDS,
Joseph B. Frost SURVEYOR.

13850