


HOVEY'S SUBDIVISION

BLOCK 11, MURPHY'S ADDITION TO THE

CITY OF JACKSON,
MICHIGAN.

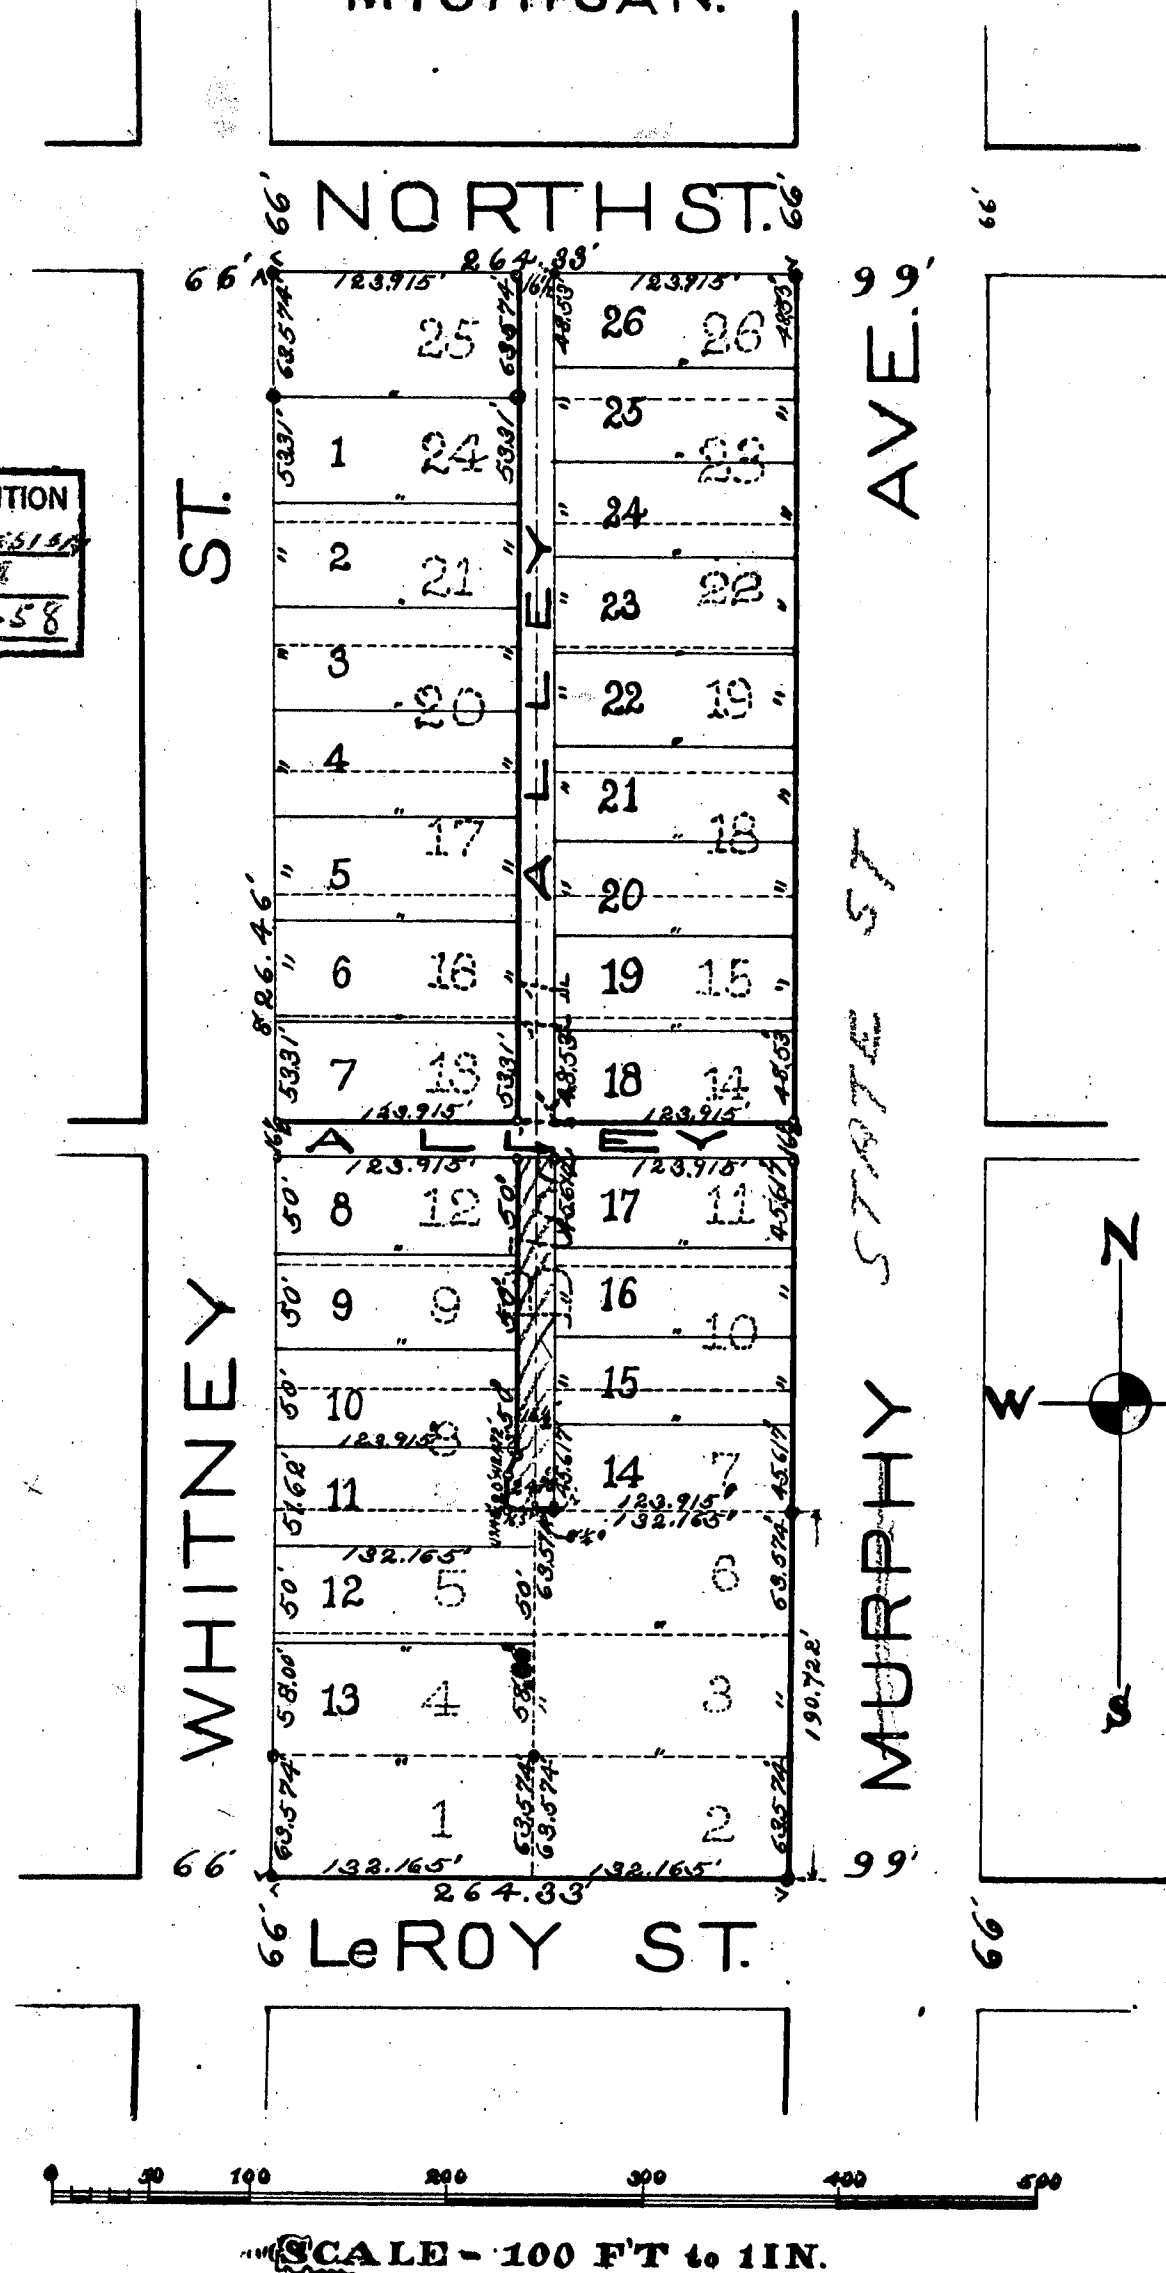

VACATED BY RESOLUTION
OF CITY COMMISSIONERS
MAY 13, 1958
VOUCHER No. 288-58

STATE OF MICHIGAN, ss. We, Wesley Sears, Register of Deeds,
County of Jackson, ss. We, Wesley Sears, Register of Deeds,
and Josiah B. Frost, Surveyor, hereby certify that we
have each carefully compared this copy with the original
plat of Hovey's Subdivision of Block 11, Murphy's Addi-
tion to the City of Jackson, Michigan, and that it is an
exact copy thereof and of the whole of said original map or plat.
Wesley Sears, Register of Deeds,
Josiah B. Frost, Surveyor.

DEDICATION.

Know all men by these presents, that we, Ansel N. Hovey, proprie-
tor, and Jennie B. Hovey, his wife, have caused the land embraced in the
following description and shown on the annexed plat to be surveyed,
laid out and platted, to be known as Hovey's Subdivision of Block 11,
Murphy's Addition to the City of Jackson, Michigan.

DESCRIPTION.

Land on the West half of the East half of the North-West Quarter of
Section 35, T. 2 S. R. 1 W. described as Block 11, (eleven) in Murphy's
Addition to the City of Jackson, Michigan, excepting therefrom Lots 1-
2-3-6 and 25 of said Block and that the Alleys shown are hereby dedi-
cated to the public for the purposes indicated. A strip of land in the
South-West corner of Lot 7 in said Block 11 of the original plat of Murphy's
Addition, one foot wide North and South by eight & one fourth feet East &
West joining said reserved lot 6, is reserved as private property and
included in the Alley.

SIGNED AND SEALED } Mrs. R. B. Tabor
IN PRESENCE OF } Edward Vandervoort.

Ansel N. Hovey
Jennie B. Hovey

State of Michigan, ss. On this 19th day of October, A.D. 1903, before me, a Notary
Public in and for said County, personally came the above named
Ansel N. Hovey and Jennie B. Hovey his wife, known to me to be the
persons who executed the above dedication and acknowledged
the same to be their free act and deed.

Josiah B. Frost,
Notary Public.

I hereby certify that the plat hereon delineated is a correct one and
that permanent monuments consisting of iron pipe have been plant-
ed at all points marked thus (c) as thereon shown, at all angles in the
boundaries of the land platted and at all intersections of streets
and alleys. Original lots shown by dotted lines.

Josiah B. Frost,
Surveyor.

Register's Office, ss. This instrument
Jackson County, ss. was presented and filed for record
this 22nd day of January 1904 as proper
certificate was furnished in compli-
ance with section 135, act 154, Laws of
1895. Recorded this 22nd day of January
1904 at 2 o'clock, P.M., in plat book No. 6
on page 24.

Wesley Sears
Register of Deeds.

Examined and Approved

Dec 7 5th 1903

John F. Dickinson
Deputy Auditor General.

RECEIVED AND FILED.

IN AUDITOR GENERAL'S OFFICE,

Feb 8 - 1904


John F. Dickinson
Deputy Auditor General.

HOVEY'S SUBDIVISION

BLOCK 11, MURPHY'S ADDITION TO THE

CITY OF JACKSON,
MICHIGAN.

VACATED BY RESOLUTION
OF CITY COUNCIL
MAY 12, 1903
VOUCHER No. 258-56

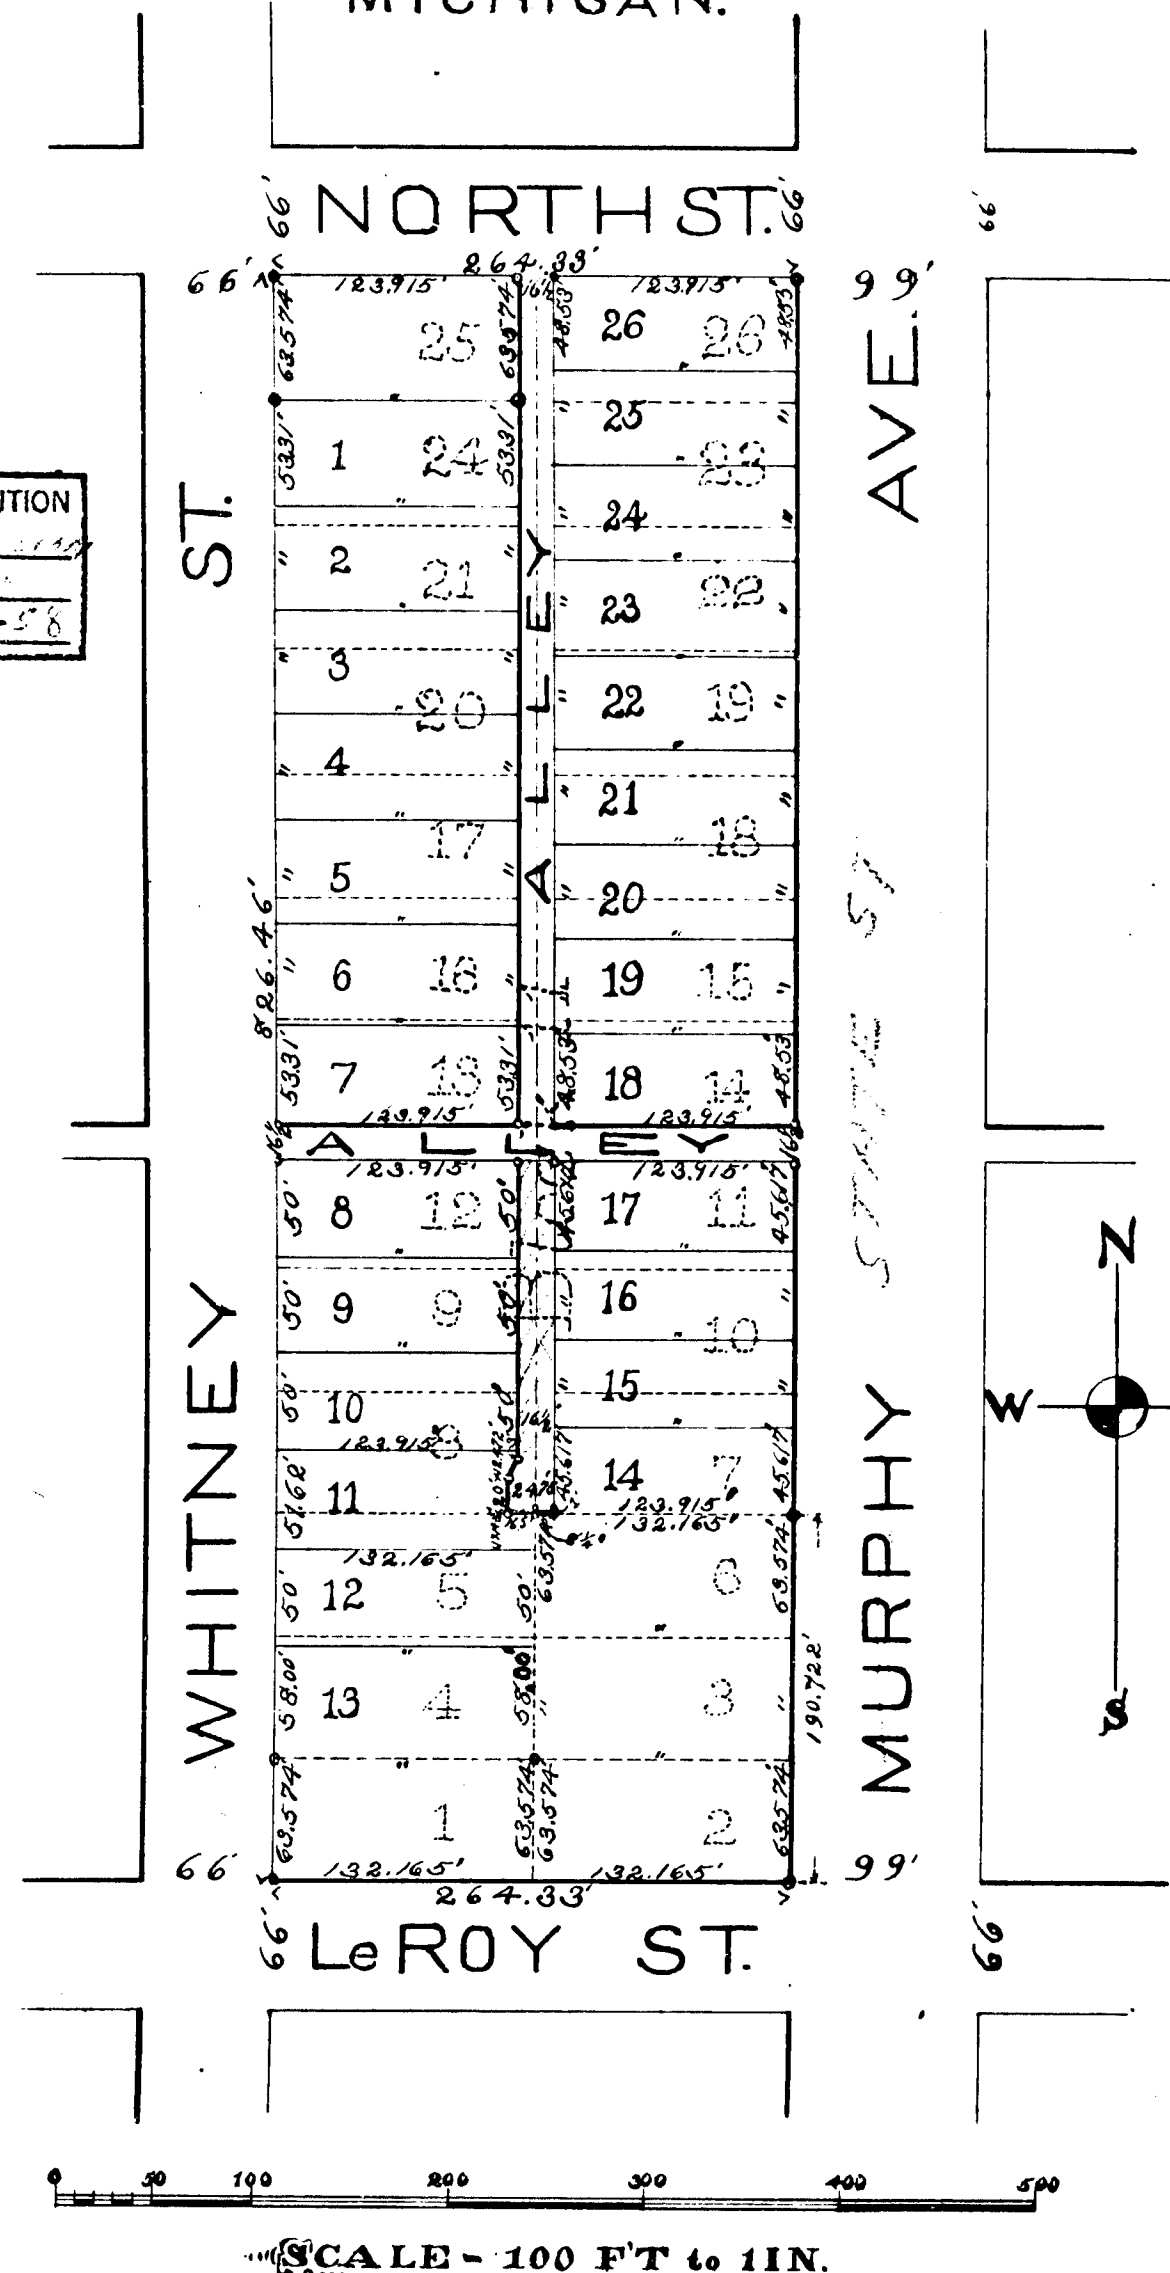

STATE OF MICHIGAN, ss. We, Wesley Sears, Register of Deeds, County of Jackson, hereby certify that we have each carefully compared the annexed copy with the plat of Hovey's Subdivision of Block 11, Murphy's Addition to the City of Jackson, Michigan, now of record in the office of said Register of Deeds, and that it is a true and correct copy of the whole of said record.

STATE OF MICHIGAN, ss. We, Wesley Sears, Register of Deeds, County of Jackson, hereby certify that we have each carefully compared this copy with the original plat of Hovey's Subdivision of Block 11, Murphy's Addition to the City of Jackson, Michigan, and that it is a true and correct copy thereof and of the whole of said original plat.

DEDICATION.
Know all men by these presents, that we, Ansel N. Hovey, proprietor, and Jennie B. Hovey, his wife, have caused the land embraced in the following description and shown on the annexed plat to be surveyed, laid out and platted, to be known as Hovey's Subdivision of Block 11, Murphy's Addition to the City of Jackson, Michigan.

DESCRIPTION.
Land on the West half of the East half of the North-West Quarter of Section 35, T. 2 S. R. 1 W., described as Block 11, (eleven) in Murphy's Addition to the City of Jackson, Michigan, excepting therefrom Lots 1-2-3-6 and 25 of said Block, and that the Alleys shown are hereby dedicated to the public for the purposes indicated. A strip of land in the South-West corner of Lot 1 in said Block 11 of the original plat of Murphy's Addition, one foot wide North and South by eight & one fourth feet East & West joining said reserved lot 6 is reserved as private property and included in the Alley.

SIGNED AND SEALED } Mrs. R. L. Tabor
IN PRESENCE OF } Edward Vandervoort.
Ansel N. Hovey
Jennie B. Hovey

State of Michigan, ss. On this 19th day of October, A.D. 1903, before me, a Notary Public in and for said County, personally came the above named Ansel N. Hovey and Jennie B. Hovey his wife, known to me to be the persons who executed the above dedication and acknowledged the same to be their free act and deed.

Josiah B. Frost,
Notary Public.

I hereby certify that the plat hereon delineated is a correct one and that permanent monuments consisting of iron pipe have been planted at all points marked thus (c), as thereon shown, at all angles in the boundaries of the land platted and at all intersections of streets and alleys. Original lots shown by dotted lines.

Registers Office, ss. This instrument was presented and filed for record this 2^d day of JANUARY 1904 as proper certificate was furnished in compliance with section 135, act 154, Laws of 1895. Recorded this 2^d day of JANUARY 1904 at 2 o'clock, P.M. in plat book No. 6 on page 24.

Wesley Sears
Register of Deeds.

Examined and Approved
Dec 7 5th 1903
John M. Dickinson
Deputy Auditor General.
RECEIVED AND FILED.
IN AUDITOR GENERAL'S OFFICE,
Feb 8 - 1904
John M. Dickinson
Deputy Auditor General.