


Attest Dec. 35 To S. R. I. W. 6006

HALL & KENNEDY' ALTERATION OF BLOCK 3 AND LOT 7 BLOCK 2
LOOMIS' HOMEWILD ADDITION
TO THE CITY OF JACKSON, MICHIGAN.

Scale 100 feet = one inch.

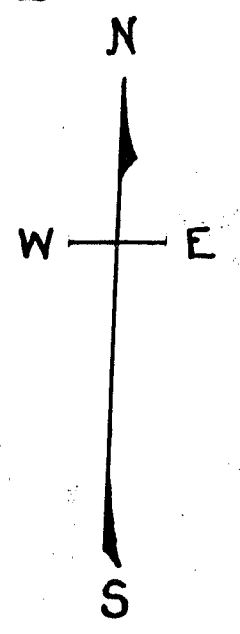

DEDICATION

Know all men by these presents, that we, Harry R. Hall, Annie M. Hall, his wife, and Robert L. Kennedy (a single man) as proprietors have caused the land embraced in the annexed plat and hereinafter described to be surveyed, laid out and platted to be known as HALL & KENNEDY' ALTERATION OF BLOCK 3 AND LOT 7 BLOCK 2 LOOMIS' HOMEWILD ADDITION to the City of Jackson, Michigan, and that the street and alley as shown on said plat are hereby dedicated to the use of the public; which said land so embraced in the said annexed plat is described as follows, to wit:- All of Block 3 and Lot 7 Block 2 LOOMIS' HOMEWILD ADDITION to the City of Jackson, Michigan.

In witness whereof we have hereunto set our hands and seals this 16th day of November 1906.

Signed and Sealed in presence of
Margaret Ryan
Charlotte Rohr

Harry R. Hall (L.S.)
Annie M. Hall (L.S.)
Robert L. Kennedy (L.S.)

State of Michigan } ss
County of Jackson }

On this 16th day of November 1906 before me a Notary Public in and for said County personally came the above named Harry R. Hall, Annie M. Hall, his wife, and Robert L. Kennedy (a single man) known to me to be the persons named in and who executed the above dedication and acknowledged the same to be their free act and deed.

Margaret Ryan
Notary Public
My Term Expires Oct 31, 1909.

Examined and Approved
January 5, 1907
John F. Wilkinson
Deputy Auditor General.

Surveyor's Certificate.
I hereby certify that the plat hereon delineated is a correct one and that permanent monuments, consisting of iron pipe from 20 to 30 inches long and about one inch in diameter have been planted at points marked thus + as thereon shown at all angles in the boundaries of the land platted and at all intersections of streets or streets and alleys

James C. Riley, Surveyor

STATE OF MICHIGAN, } ss
County of Jackson, } W. Wesley SEARS
Register of Deeds, and JAMES C. RILEY, Surveyor,
hereby certify that we have each carefully compared this copy of HALL & KENNEDY' ALTERATION OF BLOCK 3, with the original plat of Block 3, Loomis' HOMEWILD ADDITION and that it is an exact copy thereof and of the whole of such original map or plat.

Wesley Sears, Register of Deeds.
James C. Riley, Surveyor.


REGISTERS OFFICE, } ss: This instrument was presented
JACKSON COUNTY, }

and filed for record this 7th day of JANUARY 1907 as proper certificate was furnished in compliance with Section 138, Act 206 Laws of 1893

Recorded the 7th day of JANUARY 1907 at 11:00 o'clock,
P. M., in Plat Book No. 7 on page 8
Wesley Sears, Register of Deeds.

STATE OF MICHIGAN, } ss
County of Jackson, } W. Wesley SEARS
Register of Deeds, and JAMES C. RILEY, Surveyor,
hereby certify that we have each carefully compared the annexed copy with the plat of HALL & KENNEDY' ALTERATION OF BLOCK 3, and Lot 7 Block 2, Loomis' HOMEWILD ADDITION now on record in the office of said Register of Deeds, and that it is a true transcript therefrom and the whole of such record.

Wesley Sears, Register of Deeds.
James C. Riley, Surveyor.

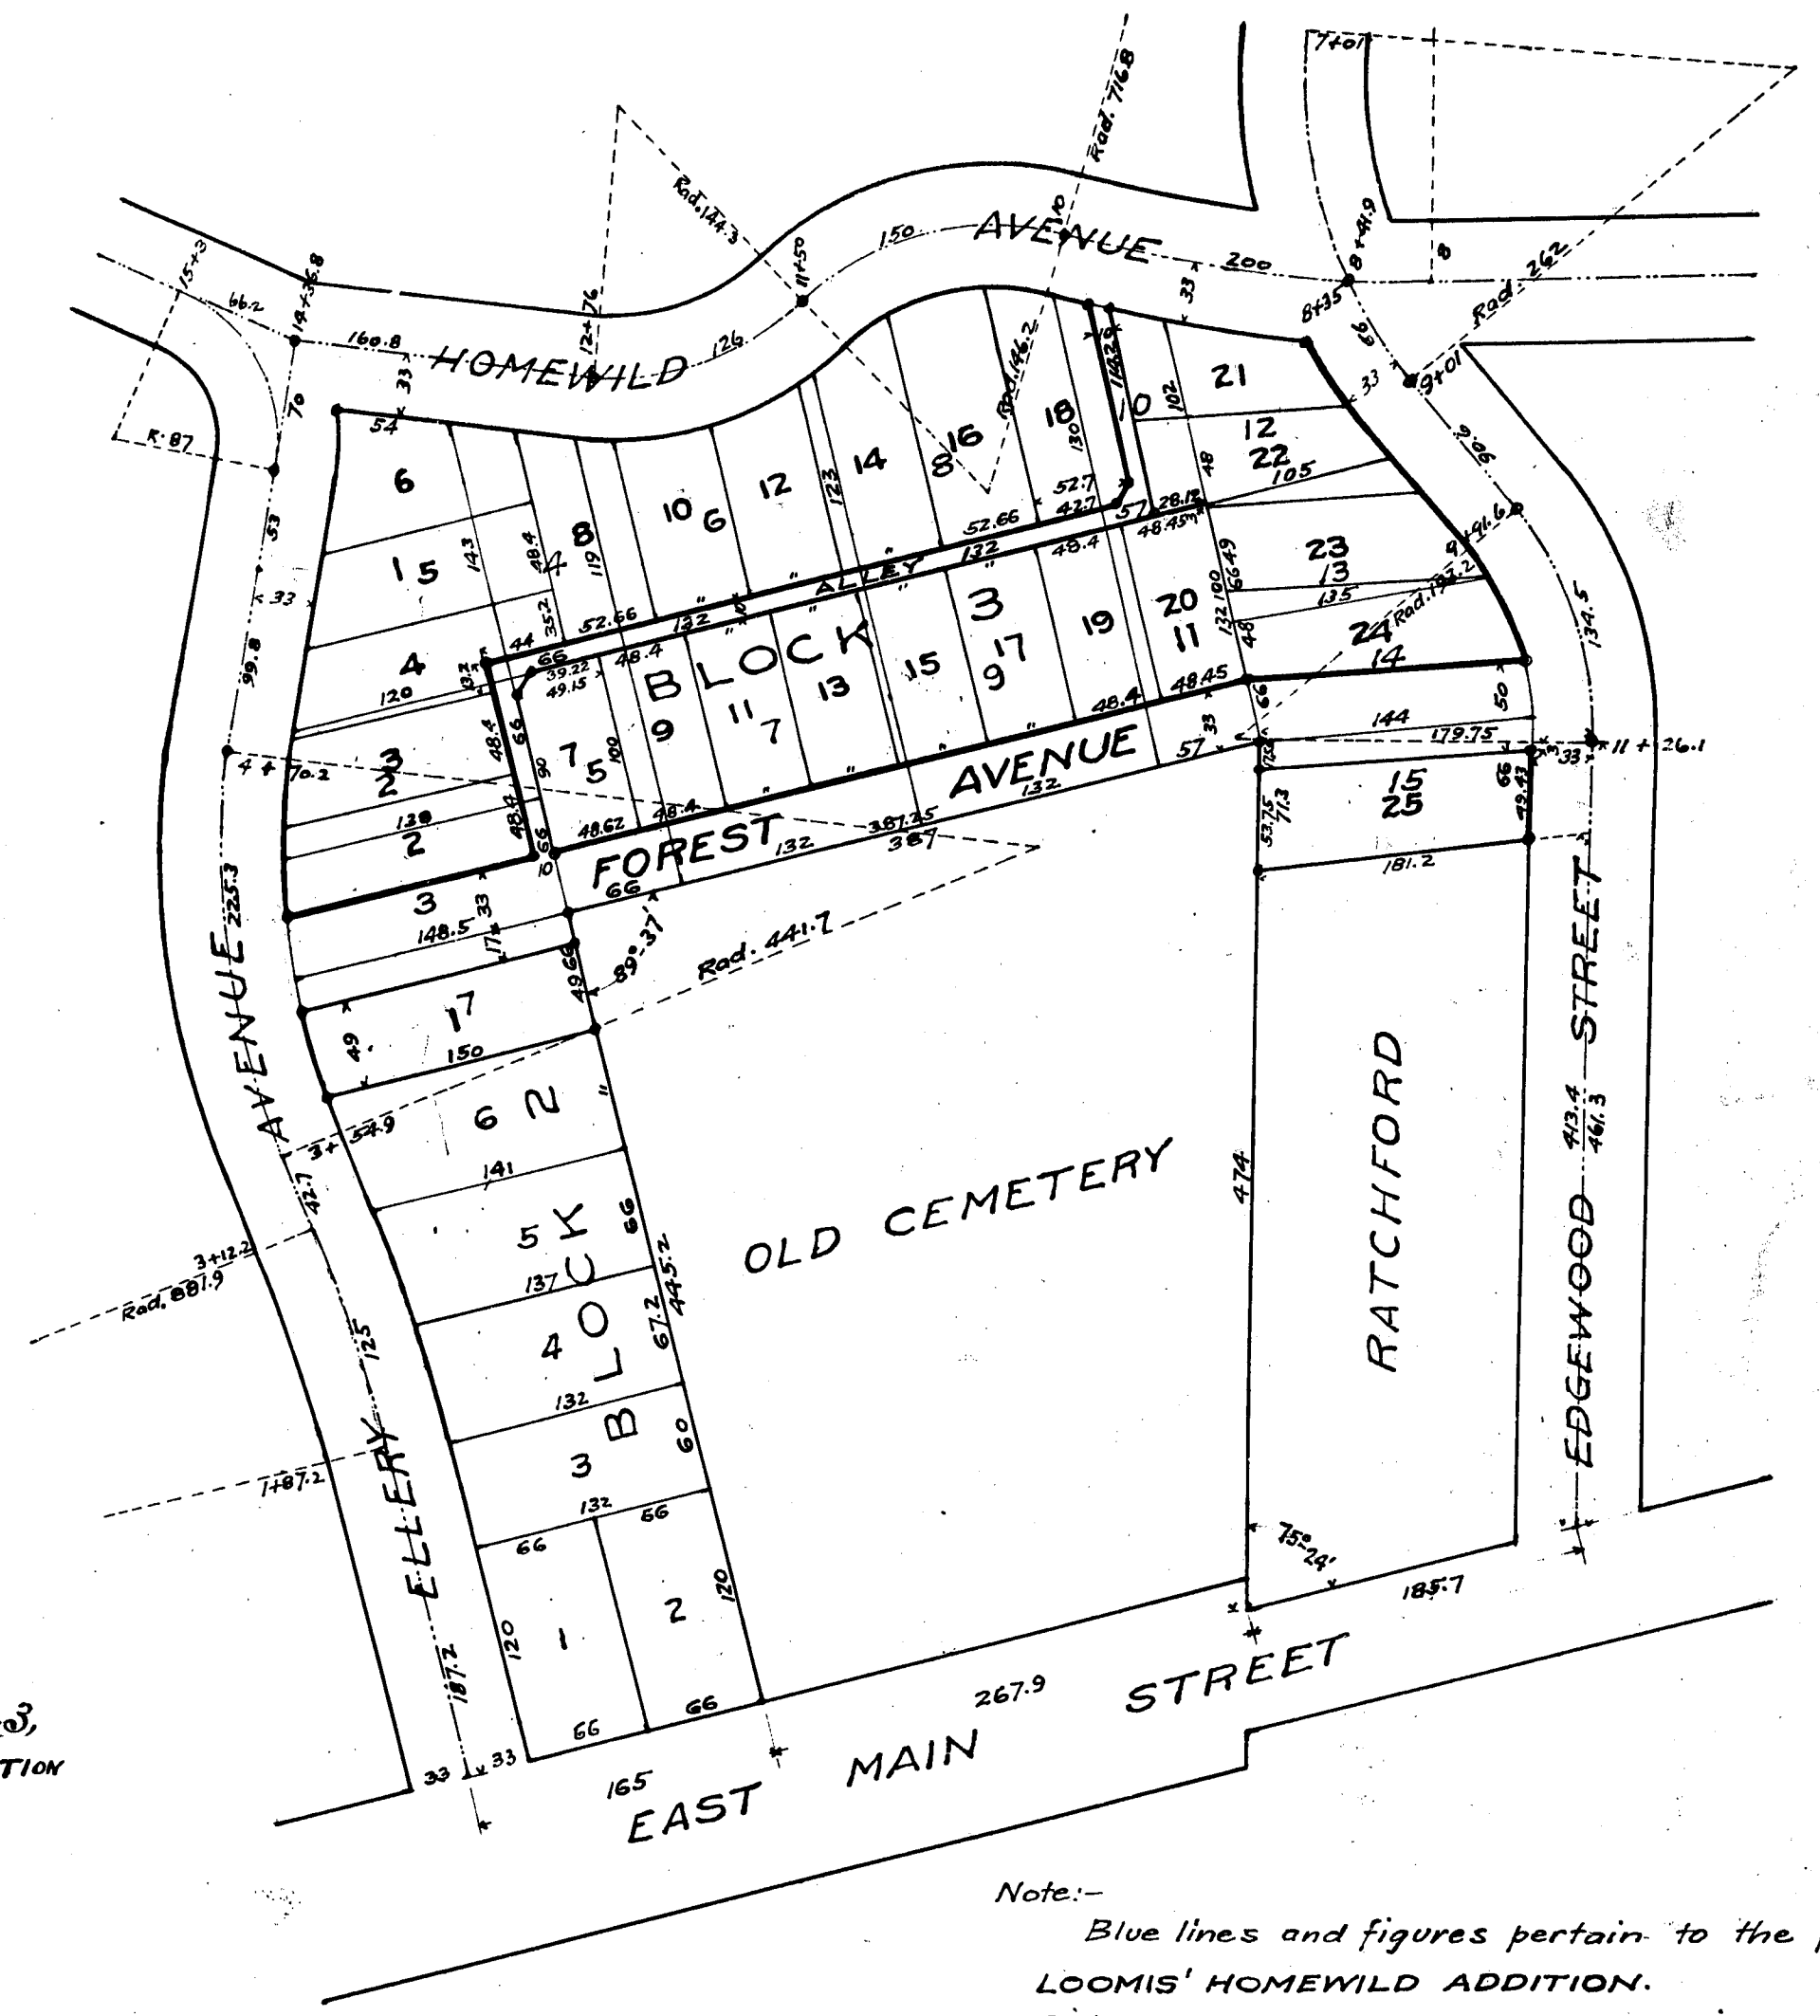

Note:-
Blue lines and figures pertain to the plat of LOOMIS' HOMEWILD ADDITION.
Distances on curves are measured in chords of 100 feet
And pluses in accordance with Railroad practice in laying out curves.

RECEIVED AND FILED,
IN AUDITOR GENERAL'S OFFICE,
Jan. 13, 1907
John F. Wilkinson
Deputy Auditor General.

DEDICATION

Know all men by these presents, that we, Harry R. Hall, Annie M. Hall, his wife, and Robert L. Kennedy (a single man) as proprietors have caused the land embraced in the annexed plat and hereinafter described to be surveyed, laid out and platted to be known as HALL & KENNEDY' ALTERATION OF BLOCK 3 AND LOT 7 BLOCK 2 LOOMIS' HOMEWILD ADDITION to the City of Jackson, Michigan, and that the street and alley as shown on said plat are hereby dedicated to the use of the public; which said land so embraced in the said annexed plat is described as follows, to wit:- All of Block 3 and Lot 7 Block 2 LOOMIS' HOMEWILD ADDITION to the City of Jackson, Michigan.

In witness whereof we have hereunto set our hands and seals this 16th day of November 1906.

Signed and Sealed in presence of

Margaret Payne
Charlotte Rohr

Harry R. Hall (L.S.)
Annie M. Hall (L.S.)
Robert L. Kennedy (L.S.)

State of Michigan } ss
County of Jackson }

On this 16th day of November 1906 before me a Notary Public in and for said County personally came the above named Harry R. Hall, Annie M. Hall, his wife, and Robert L. Kennedy (a single man) Known to me to be the persons named in and who executed the above dedication and acknowledged the same to be their free act and deed.

Margaret Payne

Notary Public
My Term Expires Oct 31, 1907

Examined and Approved
January 5th 1907
John P. Wilkinson
Deputy Auditor General.

Surveyor's Certificate.

I hereby certify that the plat heron delineated is a correct one

and that permanent monuments, consisting of iron pipe

from 20 to 30 inches long and about one inch in diameter

have been planted at points marked thus + as thereon shown at all angles in the boundaries of the land platted and at all intersections of streets or streets and alleys

James C. Riley, Surveyor

STATE OF MICHIGAN, } ss
County of Jackson, } W. Wesley Sears

Register of Deeds, and
James C. Riley, Surveyor,
hereby certify that we have each carefully compared the annexed copy with the plat of HALL & KENNEDY' ALTERATION OF BLOCK 3, and Lot 7, Block 2, Loomis' Homewild Addition and that it is a correct copy thereof and of the whole of such original map or plat.

W. Wesley Sears, Register of Deeds.
James C. Riley, Surveyor.

REGISTERS OFFICE, } ss: This instrument was presented
JACKSON COUNTY, }

and filed for record this 1st day of JANUARY 1907 as proper certificate was furnished in compliance with Section 133, Act 206, Laws of 1893

Recorded the 7th day of JANUARY 1907 at 4:00 o'clock,

P. M., in Plat Book No. 7 on page 8

W. Wesley Sears, Register of Deeds.


STATE OF MICHIGAN, } ss
County of Jackson, } W. Wesley Sears

Register of Deeds, and
James C. Riley, Surveyor,
hereby certify that we have each carefully compared the annexed copy with the plat of HALL & KENNEDY' ALTERATION OF BLOCK 3, and Lot 7, Block 2, Loomis' Homewild Addition and that it is a true transcript therefrom and the whole of such record.

W. Wesley Sears, Register of Deeds.
James C. Riley, Surveyor.

HALL & KENNEDY' ALTERATION OF BLOCK 3 AND LOT 7 BLOCK 2 LOOMIS' HOMEWILD ADDITION TO THE CITY OF JACKSON, MICHIGAN.

Scale 100 feet = one inch.

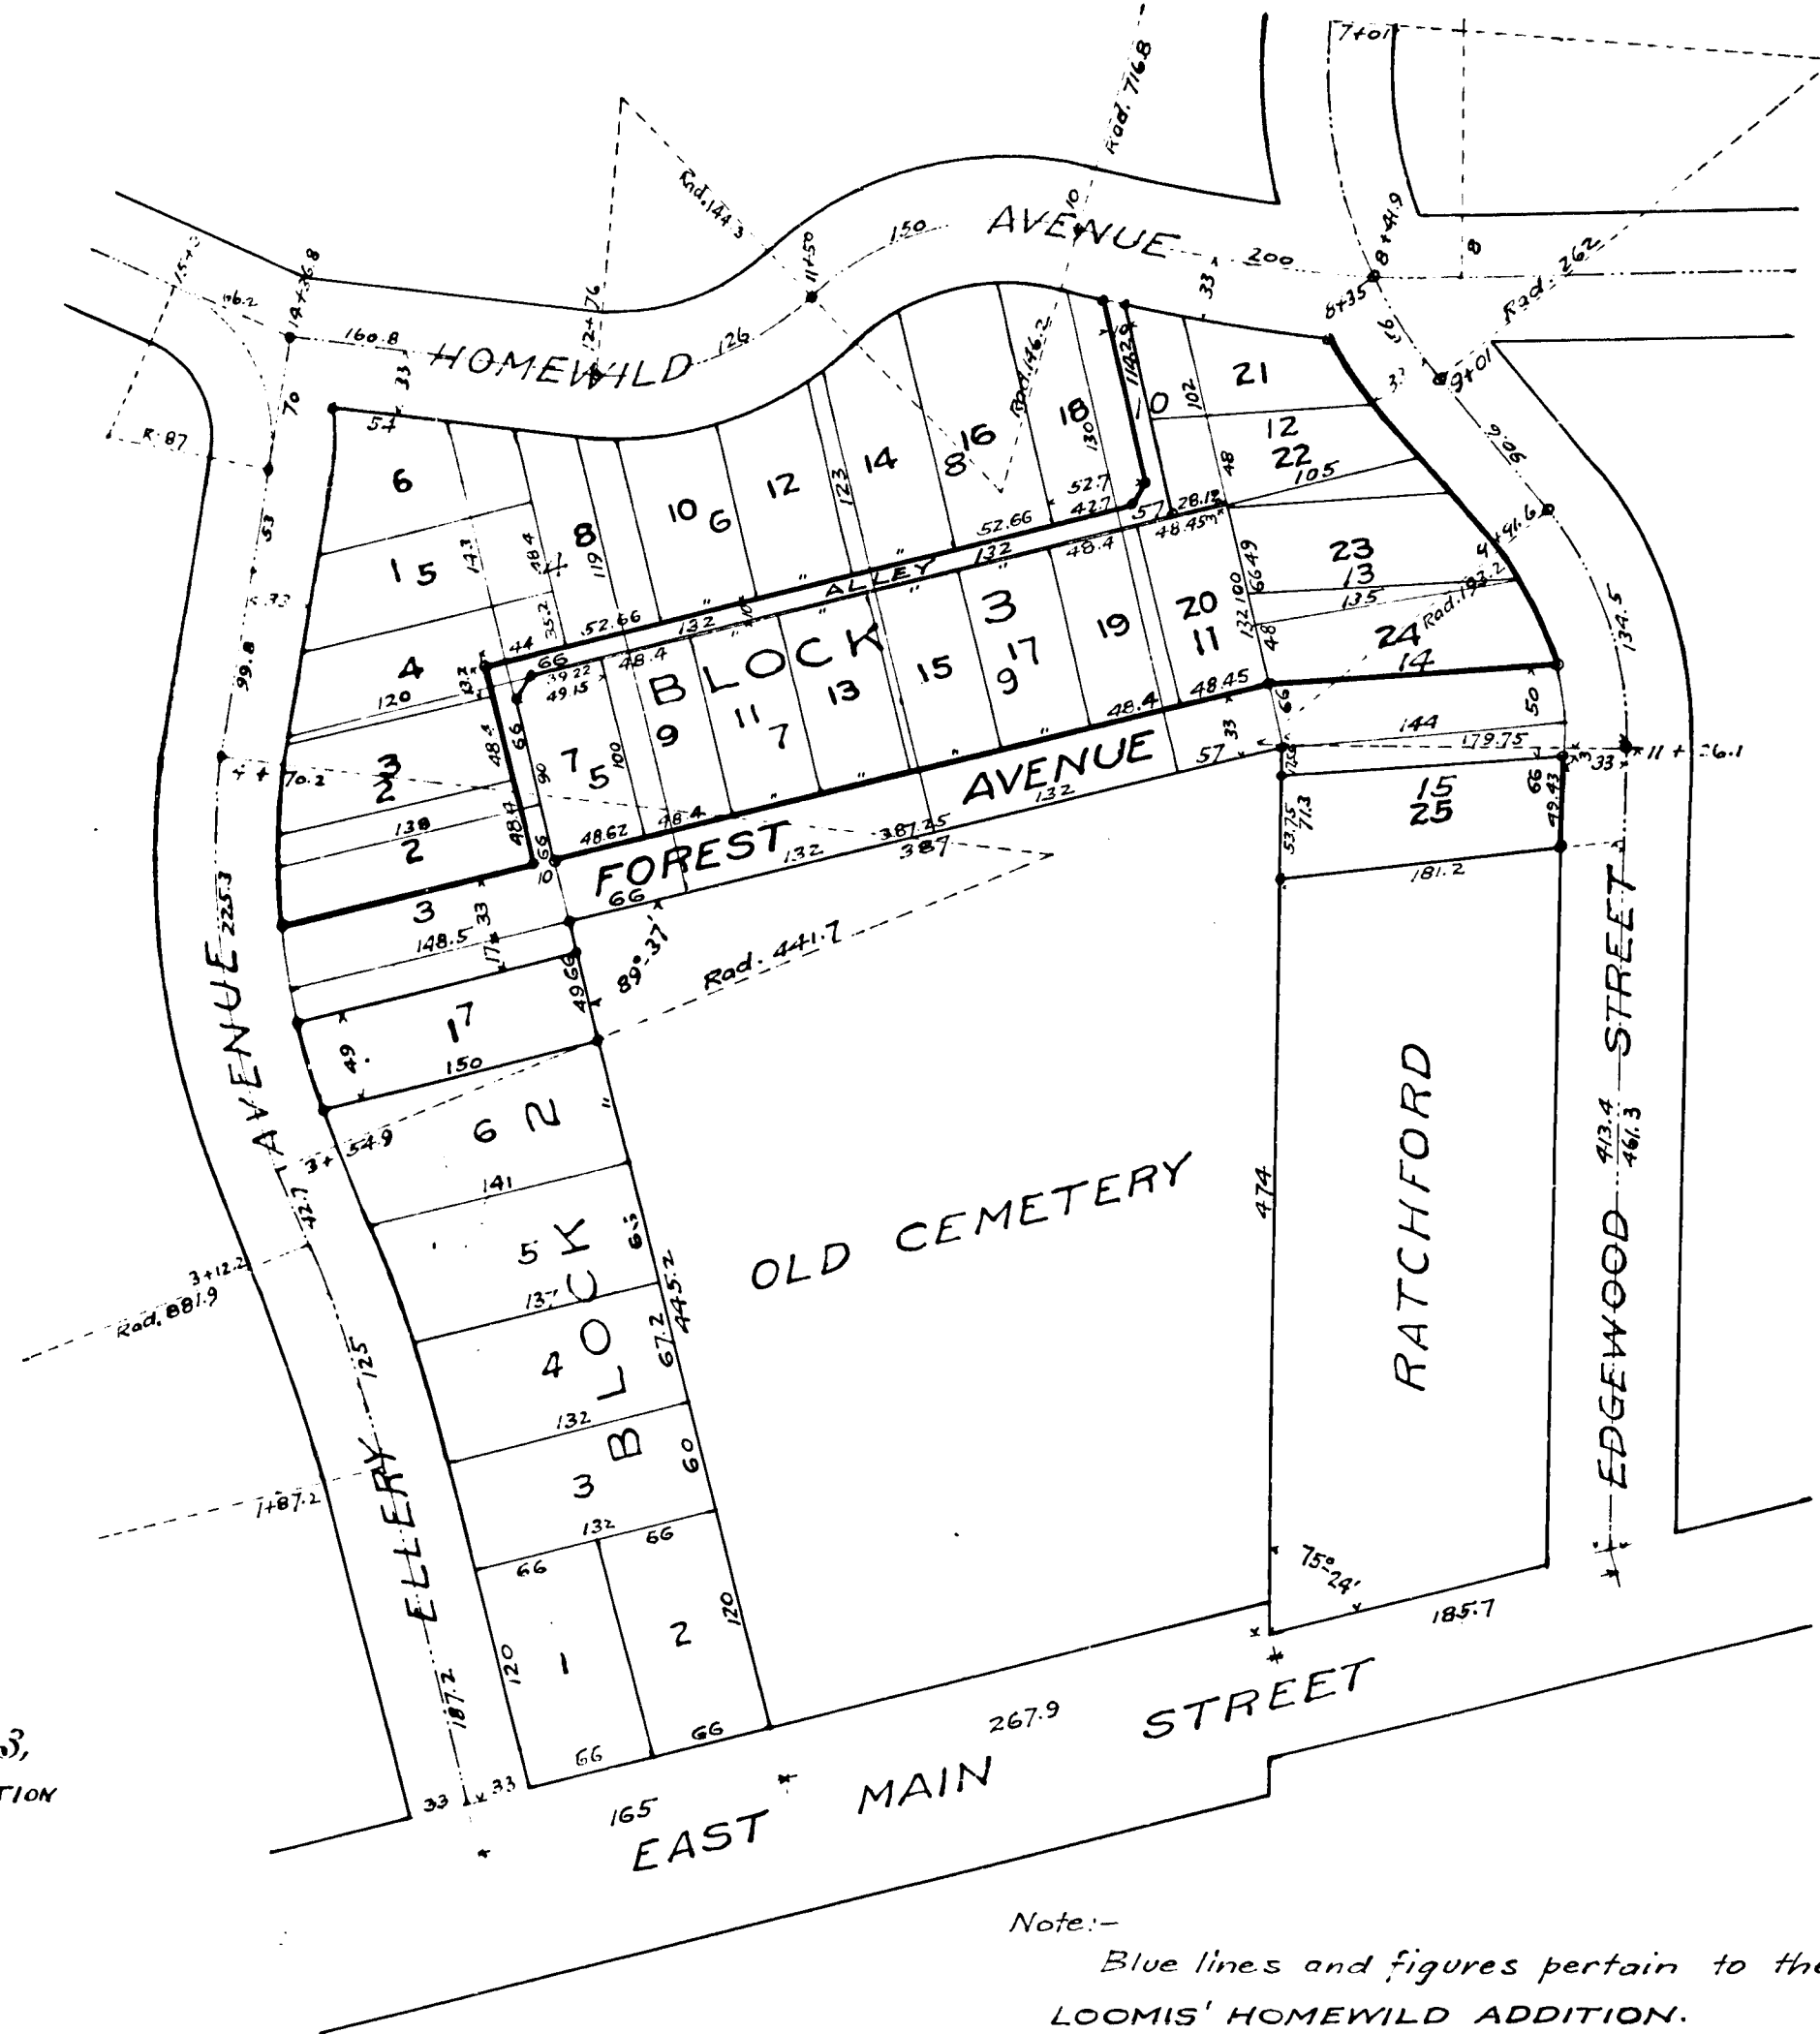

Note:-

Blue lines and figures pertain to the plat of LOOMIS' HOMEWILD ADDITION.

Distances on curves are measured in chords of 100 feet and pluses in accordance with Railroad practice in laying out curves.

RECEIVED AND FILED,
IN AUDITOR GENERAL'S OFFICE,
Feb 13, 1907

John P. Wilkinson
Deputy Auditor General.