

DEDICATION.

Know all men by these presents, that we, Harry R. Hall, Annie M. Hall, his wife, and Robert L. Kennedy (a single man), as proprietors, have caused the land embraced in the annexed plat and hereinafter described to be surveyed, laid out and platted to be known as HALL & KENNEDY'S SUBDIVISION OF PART OF SHOEMAKERS ADDITION to the City of Jackson, Michigan; which said land so embraced in the annexed plat is described as follows, to wit: Commencing forty nine and one half (49½) feet south and thirteen hundred fifty two and thirty five one hundredths (1352.35) feet west of the Northeast corner of Section 4 T.3 S.R.1W., thence west parallel with north line of said section two hundred sixty four (264) feet, thence south one hundred thirty two (132) feet, thence east one hundred thirty two (132) feet, thence south four hundred sixty two (462) feet, thence east one hundred thirty two (132) feet, thence north five hundred ninety four (594) feet to place of beginning. Except Lots A and B.

In Witness Whereof the said Harry R. Hall, Annie M. Hall, his wife, and Robert L. Kennedy (a single man) have hereunto set their hands and seals at the City of Jackson and State of Michigan this 25th day of April 1907.

Signed and Sealed in Presence of

Charlotte Pohn
Margaret Ryan

State of Michigan } ss
County of Jackson }

Harry R. Hall (L.S.)
Annie M. Hall. (L.S.)
Robert L. Kennedy (L.S.)

On this 25th day of April 1907 before me a Notary Public in and for said County personally came the above named Harry R. Hall, Annie M. Hall, his wife, and Robert L. Kennedy (a single man) known to me to be the persons named in and who executed the above dedication and acknowledged the same to be their free act and deed.

Margaret Ryan Notary Public
My Term Expires Oct 31, 1909

STATE OF MICHIGAN, } ss. We WESLEY SEARS
County of Jackson, }
Register of Deeds, and James L. Riley, Surveyor,
hereby certify that we have each carefully compared the annexed copy with the plat of Hall & Kennedy's Subdivision of part of Shoemakers Addition now on record in the office of said Register of Deeds, and that it is a true transcript therefrom and the whole of such record.

Wesley Sears Register of Deeds.
James L. Riley Surveyor.

STATE OF MICHIGAN, } ss. We WESLEY SEARS
County of Jackson, }
Register of Deeds, and James L. Riley, Surveyor,
hereby certify that we have each carefully compared this copy

with the original plat of Hall & Kennedy's Subdivision of part of Shoemakers Addition and that it is an exact copy thereof and of the whole of such original map or plat.

Wesley Sears Register of Deeds.
James L. Riley Surveyor.

REGISTERS OFFICE, } ss. This instrument was presented
JACKSON COUNTY, }

and filed for record this 27th day of June 1907 as proper certificate was furnished in compliance with Section 136, Act 206 Laws of 1893

Recorded the 27th day of June, 1907 at 9 45 o'clock,

A. M., in Plat Book No. 7 on page 9
Wesley Sears Register of Deeds.

Surveyor's Certificate.

I hereby certify that the plat hereon delineated is a correct one

and that permanent monuments, consisting of iron pipe fixed


28 to 30 inches long and about one inch in diameter

have been planted at points marked thus * as thereon shown at all angles in the boundaries of the land platted and at all intersections of streets.

James L. Riley Surveyor

HALL & KENNEDY'S SUBDIVISION OF PART OF SHOEMAKERS ADDITION TO THE CITY OF JACKSON, MICHIGAN.

Scale 100 feet = one inch.

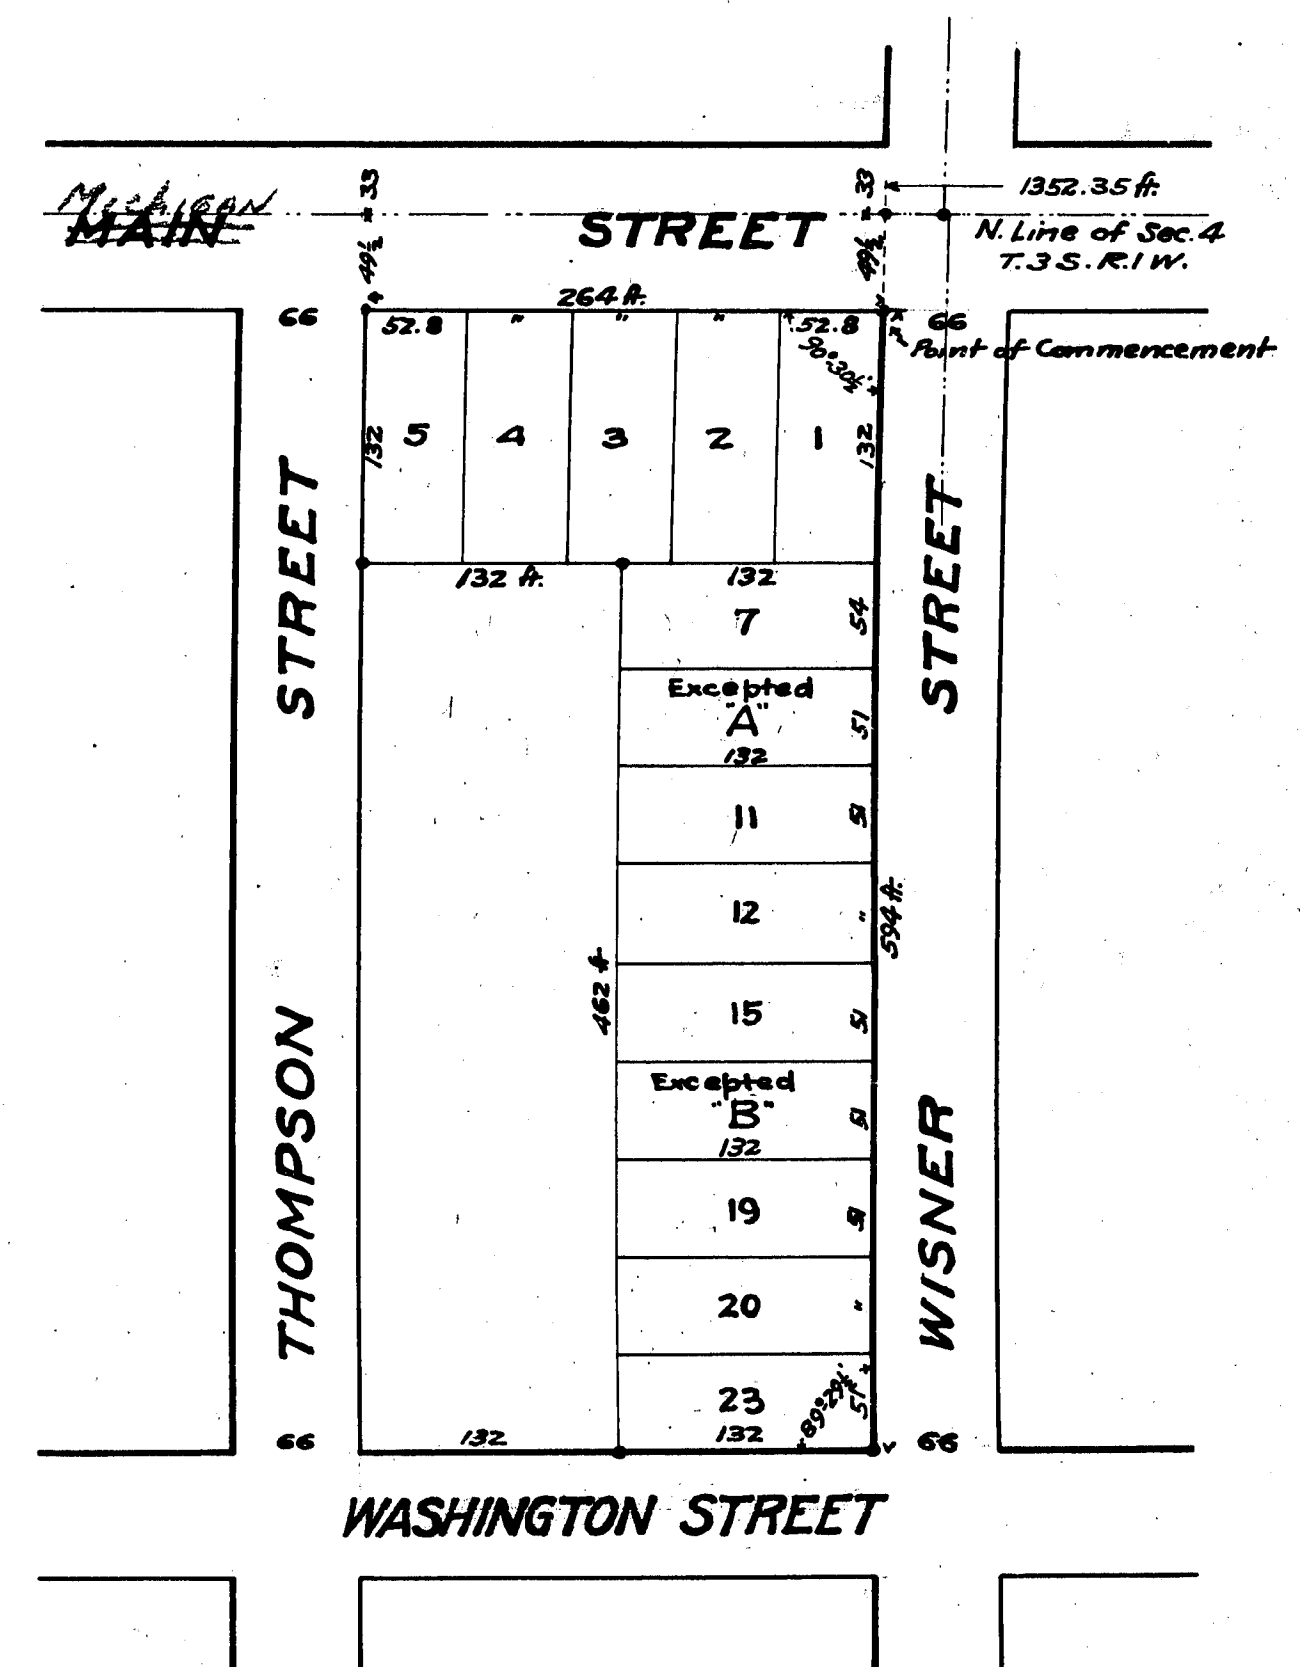

MAIN STREET changed to
Michigan AVENUE Jan 19-1924
Vol 73-1935

DEDICATION.

Know all men by these presents, that we, Harry R. Hall, Annie M. Hall, his wife, and Robert L. Kennedy (a single man), as proprietors, have caused the land embraced in the annexed plat and herein after described to be surveyed, laid out and platted to be known as HALL & KENNEDY'S SUBDIVISION OF PART OF SHOEMAKERS ADDITION to the City of Jackson, Michigan; which said land so embraced in the annexed plat is described as follows, to wit; Commencing forty nine and one half (49½) feet south and thirteen hundred fifty two and thirty five one hundredths (1352.35) feet west of the Northeast corner of Section 4 T.3 S.R.1W., thence west parallel with north line of said section two hundred sixty four (264) feet, thence south one hundred thirty two (132) feet, thence east one hundred thirty two (132) feet, thence south four hundred sixty two (462) feet, thence east one hundred thirty two (132) feet, thence north five hundred ninety four (594) feet to place of beginning. Except Lots A and B.

In Witness Whereof the said Harry R. Hall, Annie M. Hall, his wife, and Robert L. Kennedy (a single man) have hereunto set their hands and seals at the City of Jackson and State of Michigan this 20th day of April 1907.

Signed and Sealed in Presence of

Charlotte C. Pike
Margaret C. Pike

State of Michigan } ss
County of Jackson }

On this 20th day of April 1907 before me a Notary Public in and for said County personally came the above named Harry R. Hall, Annie M. Hall, his wife, and Robert L. Kennedy (a single man) known to me to be the persons named in and who executed the above dedication and acknowledged the same to be their free act and deed.

Margaret C. Pike Notary Public
My Term Expires 31. 31. 1911

STATE OF MICHIGAN, } ss
County of Jackson, } ss

WESLEY SEARS
Register of Deeds, and James B. Riley, Surveyor,
hereby certify that we have each carefully compared the annexed copy with the plat of Hall & Kennedy's Subdivision of part of Shoemakers Addition now on record in the office of said Register of Deeds, and that it is a true transcript therefrom and the whole of such record.

Wesley Sears Register of Deeds.
James B. Riley Surveyor.

STATE OF MICHIGAN, } ss
County of Jackson, } ss

WESLEY SEARS
Register of Deeds, and James B. Riley, Surveyor,
hereby certify that we have each carefully compared this copy

with the original plat of Hall & Kennedy's Subdivision of part of Shoemakers Addition and that it is an exact copy thereof and of the whole of such original map or plat.

Wesley Sears Register of Deeds.
James B. Riley Surveyor.

REGISTERS OFFICE, } ss
JACKSON COUNTY, } ss

This instrument was presented and filed for record this 21st day of April 1907 as proper certificate was furnished in compliance with Section 136, Act 206 Laws of 1893

Recorded the 27th day of April 1907 at 4:45 o'clock,

A. M., in Plat Book No. 1 on page 7
Wesley Sears Register of Deeds.


Surveyor's Certificate.

I hereby certify that the plat herein delineated is a correct one and that permanent monuments, consisting of iron pipe from 20 to 30 inches long and about one inch in diameter have been planted at points marked thus * as thereon shown at all angles in the boundaries of the land platted and at all intersections of streets.

James B. Riley, Surveyor

HALL & KENNEDY'S SUBDIVISION OF PART OF SHOEMAKERS ADDITION TO THE CITY OF JACKSON, MICHIGAN.

0 100 200 300 400 500 ft.
Scale 100 feet = one inch.

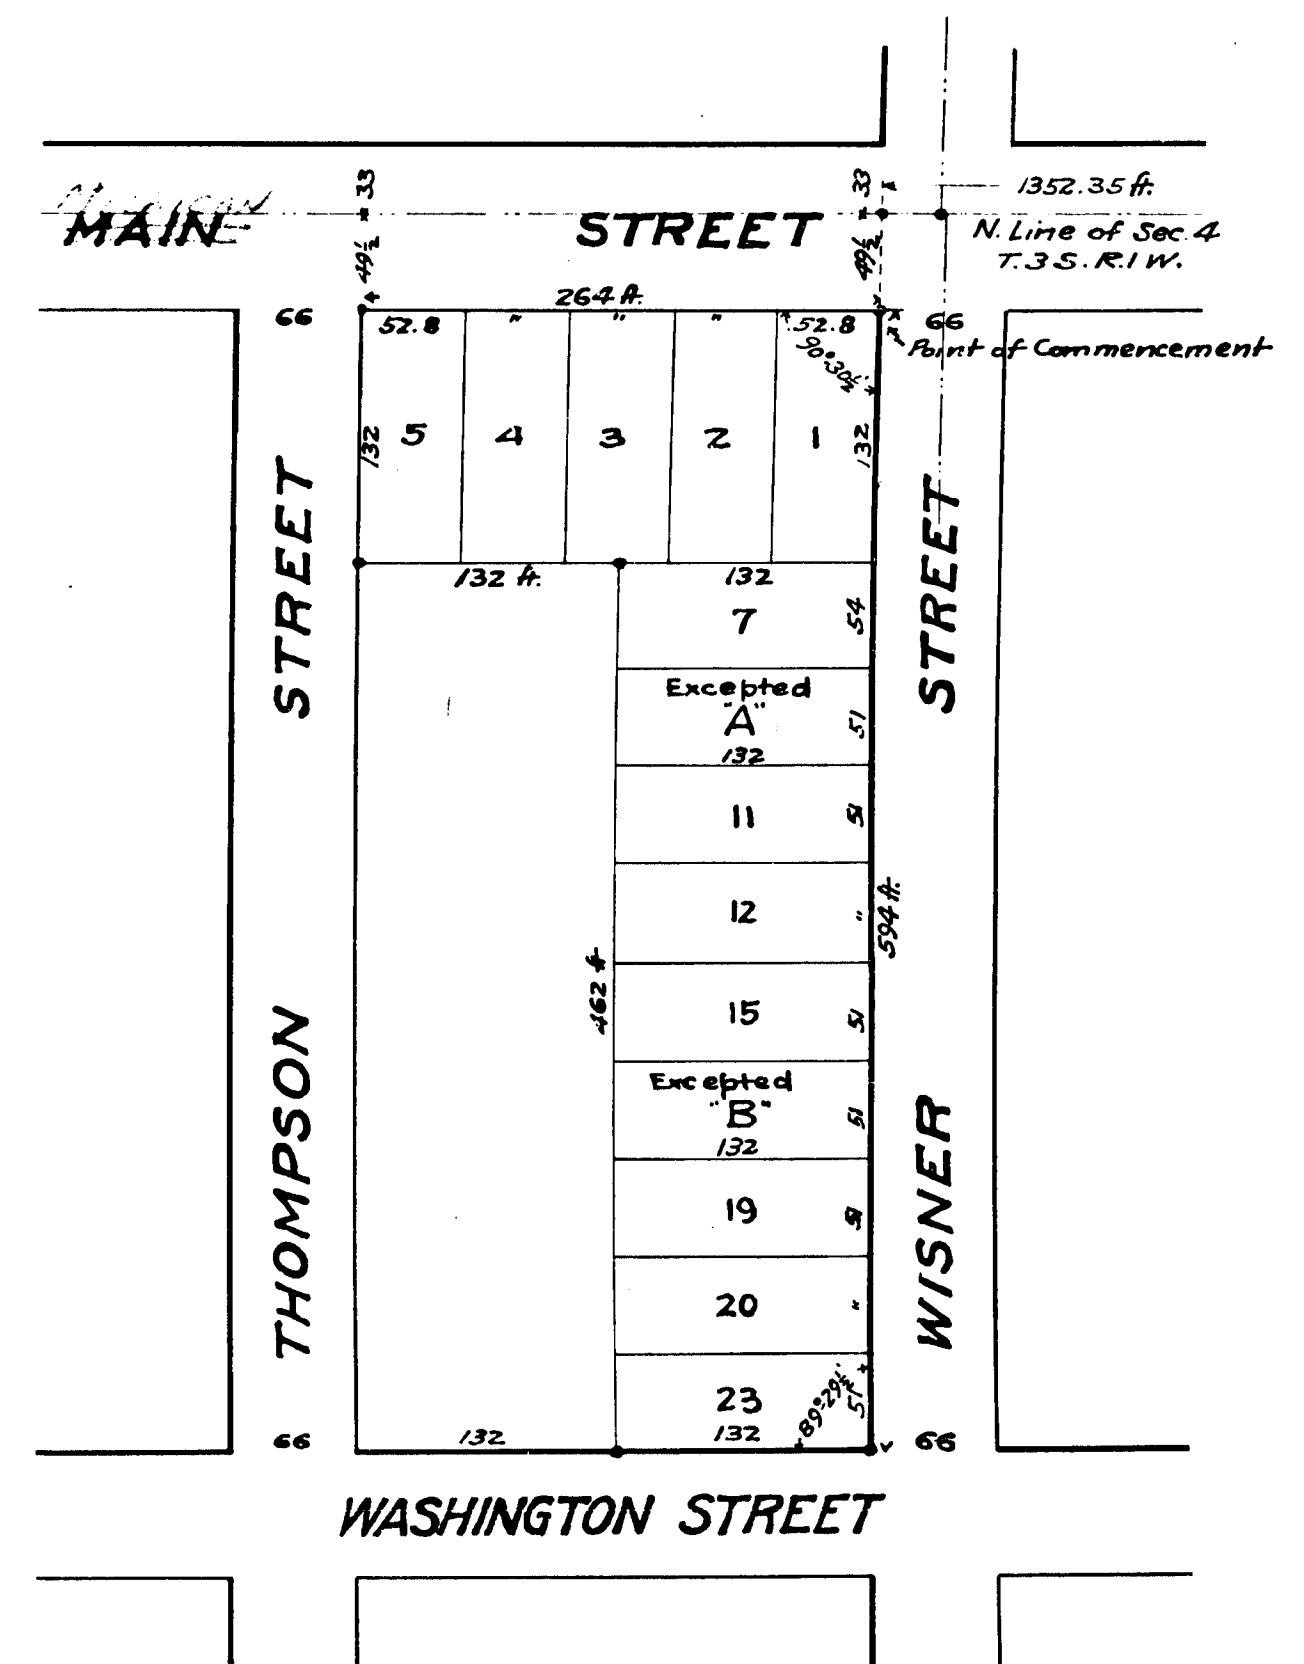

MAIN STREET changed to
MICHIGAN AVENUE 10/11/1924.
Vol 73 1920