

ORDER OF VACATION

THE ALLEY RUNNING NORTH from Franklin Street between lots 14, 15, 16, 999, 1000.

Examined and Approved
MAY 2-1912

A. S. Hansen
Deputy Auditor General

DEDICATION.

Know all men by these presents, that we, N. P. Dodge Jr. and Laura W. Dodge, his wife, as proprietors, have caused the land embraced in the annexed plat and hereinafter described to be surveyed, laid out and platted to be known as BELMONT PARK being a part of the NW 1/4 and a part of N 1/2 of the SW 1/4 of Section Four (4) Town Three (3) South, Range One (1) West, Township of Summit, County of Jackson, Michigan; and that the streets and alleys as shown on said plat are hereby dedicated to the use of the public; which said land so embraced in the said annexed plat is described as follows, to wit:-

Commencing at a point on the west line of Section Four (4) Town Three (3) South, Range One (1) West six hundred sixty (660) feet south of the Northwest Corner of said section, thence S. 89° 33' E. fourteen hundred forty four and fifty nine one hundredths (1444.59) feet, thence S. 0° 05' W. four hundred ninety five (495) feet, thence S. 89° 33' E. two hundred seventy six (276) feet, thence N. 0° 17' W. four hundred ninety five (495) feet, thence S. 89° 33' E. six hundred twenty nine and fifty five one hundredths (629.55) feet, thence S. 0° 05' W. two hundred ninety seven (297) feet, thence S. 89° 33' E. three hundred one and ninety five one hundredths (301.95) feet to the N and S 1/4 line of said Section Four (4), thence S. 0° 05' W. fourteen hundred seventy and three tenths (1470.3) feet along the N and S 1/4 line of said Section Four (4), to a point two hundred sixty six and forty five one hundredths (266.45) feet north of the center of said Section Four (4), thence S. 47° 44' W. two hundred ninety nine and one tenth (299.1) feet, thence S. 55° 38' W. eight hundred eighty nine and three tenths (889.3) feet, thence N. 73° 50' W. seventeen hundred sixty four (1764) feet to the west line of said section four (4), thence N. 0° 05' E. nineteen hundred ninety nine and five tenths (1999.5) feet to the place of beginning.

Signed and Sealed in Presence of
A. L. Root.
H. D. Brown
State of Nebraska ss
County of Douglas

N. P. Dodge Jr. (L.S.)
Laura W. Dodge (L.S.)


On this 14th day of March 1912 before me, a Notary Public in and for said County personally came the above named N. P. Dodge Jr. and Laura W. Dodge, his wife, known to me to be the persons named in and who executed the above dedication and acknowledged the same to be their free act and deed.

St. Name Change
VACATED BY RESOLUTION
OF BOARD OF COMMISSIONERS
December 31, 1907
VOUCHER No. 26-59

Belmont Park
MAY 2-1912
Notary Public. My Term Expires
H. D. Brown
May 10th 1917

I hereby certify that this copy is a true copy of the MAP or PLAT forwarded to the Register of Deeds for recording.
MAY 2-1912
A. S. Hansen
Deputy Auditor General.

VACATED BY CIRCUIT COURT
ORDER 19
VOUCHER No. 753-41

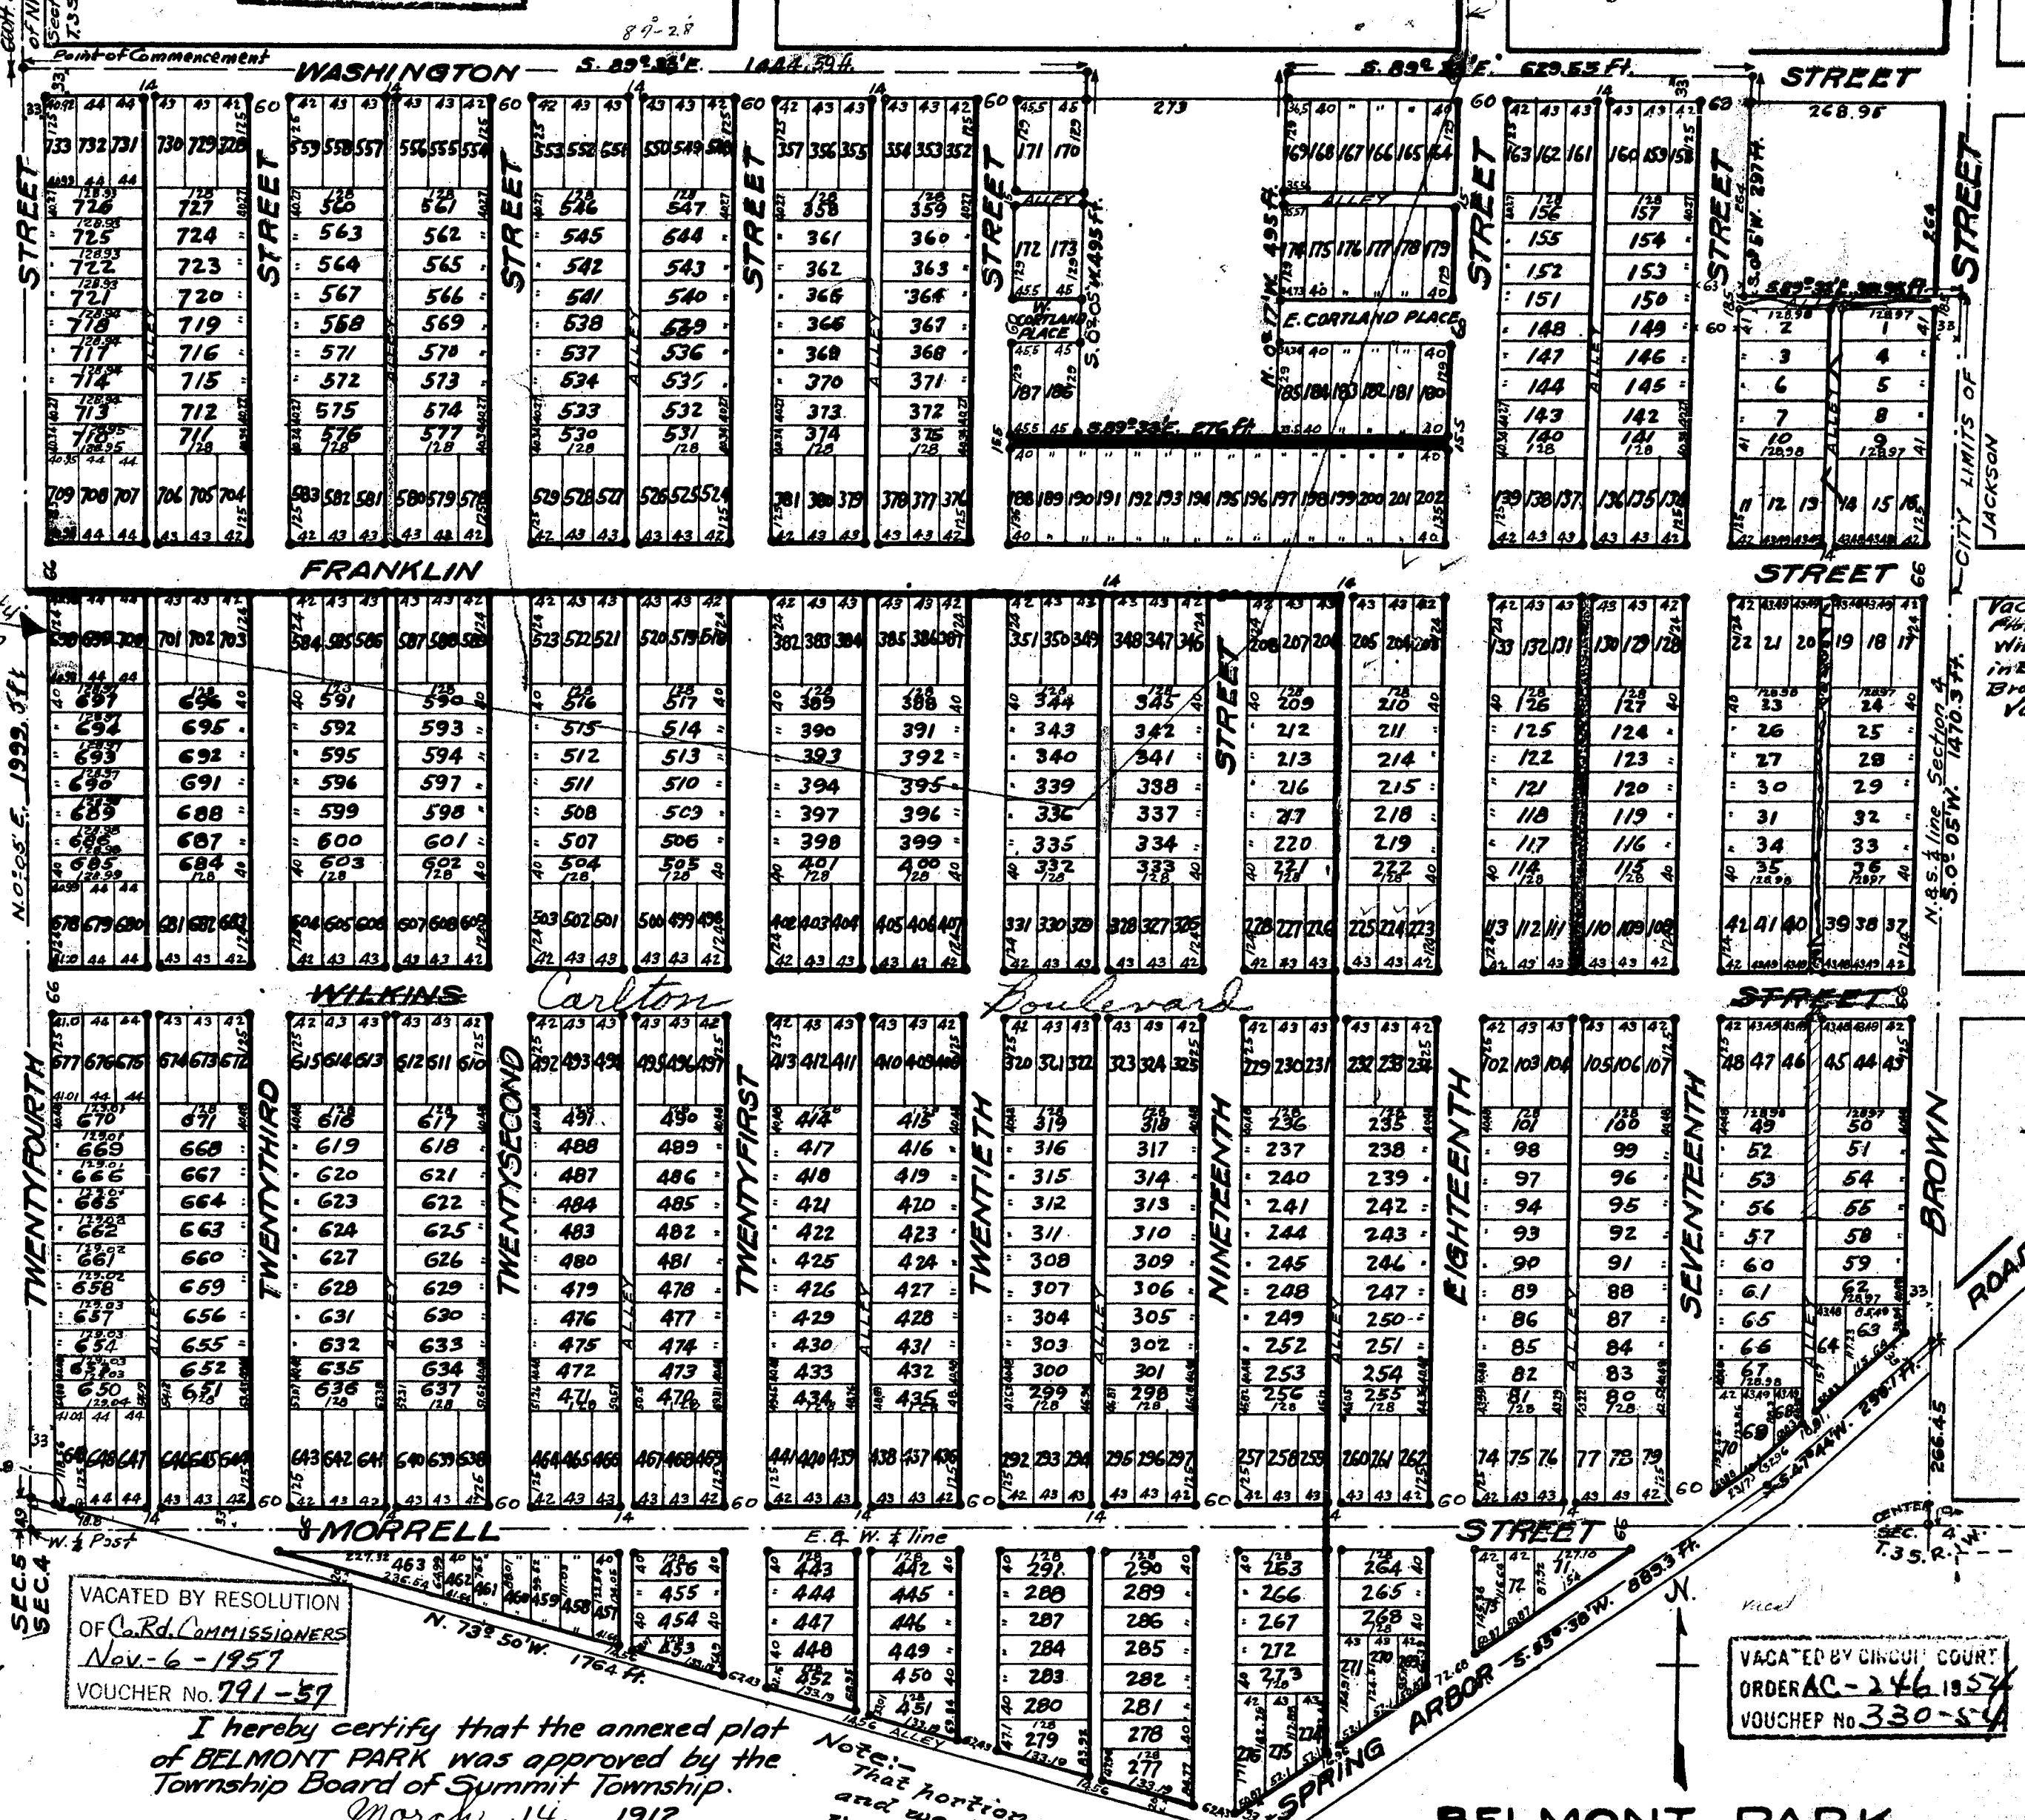

I hereby certify that the annexed plat of BELMONT PARK was approved by the Township Board of Summit Township.
March 14, 1912.
Daniel O'Brien
Township Clerk.

State of Michigan ss
County of Jackson
I hereby certify that I have examined the records of this office relating to the description of land hereon platted as BELMONT PARK being a part of the NW 1/4 and a part of N 1/2 of the SW 1/4 of Section 4 T. 3 S. R. 1 W. Township of Summit, County of Jackson, Michigan, and from such examination I find that there are no tax liens or titles held by the state and that there are no tax liens or titles held by individuals on said lands, for the five years preceding the 14th day of March 1912, and that the taxes for said period of five years are paid, as shown by the records of this office.

Edw. M. Ziegler March 14th 1912.
County Treasurer
of Jackson County.

Filed in Auditor General's Dep't
MAY 8-1912
A. S. Hansen
Deputy Auditor General.

BELMONT PARK
BEING A PART OF THE NW 1/4 AND A PART OF N 1/2 OF THE SW 1/4 OF SECTION 4 T. 3 S. R. 1 W. TOWNSHIP OF SUMMIT, COUNTY OF JACKSON, MICHIGAN.

SCALE: 200 FEET = ONE INCH.
ALL DIMENSIONS ARE IN FEET AND DECIMALS THEREOF.

Surveyor's Certificate.
I hereby certify that the plat hereon delineated is a correct one and that permanent monuments, consisting of iron pipe one inch in diameter and 4' long have been planted at points marked thus + as shown shown at all angles in the boundaries of the land platted and at all intersections of streets and alleys *James B. Foley, Surveyor*

13882
14357

THE ALLY RUNNING NORTH FROM
Fragation Street between 1st and 2nd
on the west side of the street. It
also the ally extending east from Brown Street
to the East line of 17th Street. Bounded on the
south by 1st and 2nd Streets and on the west
by the Vol. 17422

Geo. S. Hansen
Deputy Auditor General

Know all men by these presents, that we, N. P. Dodge Jr. and Laura W. Dodge, his wife, as proprietors, have caused the land embraced in the annexed plat and hereinafter described to be surveyed, laid out and platted to be known as BELMONT PARK being a part of the NW $\frac{1}{4}$ and a part of N $\frac{1}{2}$ of the SW $\frac{1}{4}$ of Section Four (4) Town Three (3) South, Range One (1) West, Township of Summit, County of Jackson, Michigan; and that the streets and alleys as shown on said plat are hereby dedicated to the use of the public; which said land so embraced in the said annexed plat is described as follows, to wit:—

Signed and Sealed in Presence of
A. L. Root.
H. L. Brown
State of Nebraska } ss
County of Douglas }

N. P. Dodge Jr. (L.S.)
Laura W. Dodge (L.S.)

On this 14th day of March 1912 before me, a Notary Public in and for said County personally came the above named N.P. Dodge Jr. and Laura W. Dodge, his wife, known to me to be the persons named in and who executed the above dedication and acknowledged the same to be their free act and deed.

VACATED BY RESOLUTION
OF Bd. of Comm.
December 31, 1958
VOUCHER No. 86-57

H. D. Brown

H. L. Brown

May 10th 1917

I hereby certify that this copy is a true copy of the MAP or Plan forwarded the Register of Deeds for recording.

Compared MAY 2-1912
Charles H. Hanson
Deputy Auditor General.

I hereby certify that the annexed plat of BELMONT PARK was approved by the Township Board of Summit Township.

March 14, 1912

Daniel O'Brien
 Township C

State of Michigan } ss
County of Jackson }

I hereby certify that I have examined the records of this office relating to the description of land hereon platted as BELMONT PARK being a part of the NW 1/4 and a part of N 1/2 of the SW 1/4 of Section 4 T. 3 S. R. 1 W., Township of Summit, County of Jackson, Michigan, and from such examination I find that there are no tax liens or titles held by the state and that there are no tax liens or titles held by individuals on said lands, for the five years preceding the 1st day of March 1912 and that the taxes for said period of five years are paid as shown by the records of this office.

Harold M. Rogers. March 14th 1912.

County Treasurer
of Jackson County

Filed in Auditor General's Dep't

MAY 6-1912


Geo. L. Hunter
Deputy Auditor General.

BEING A PART OF THE NW $\frac{1}{4}$ AND A PART OF N $\frac{1}{2}$ OF THE SW $\frac{1}{4}$
OF SECTION 4 T.3 S. R.1 W.
TOWNSHIP OF SUMMIT, COUNTY OF JACKSON, MICHIGAN

0 50 100 200 300 400 500 feet
SCALE :- 200 FEET = ONE INCH.

Surveyor's Certificate.
I hereby certify that the plat hereon delineated is a correct one
and that permanent monuments, consisting of iron pipe
one inch in diameter and 24" long

have been planted at points marked thus ; as thereon shown
at all angles in the boundaries of the land platted and in an inter-
section of streets and Alleys James B. Riley Surveyor

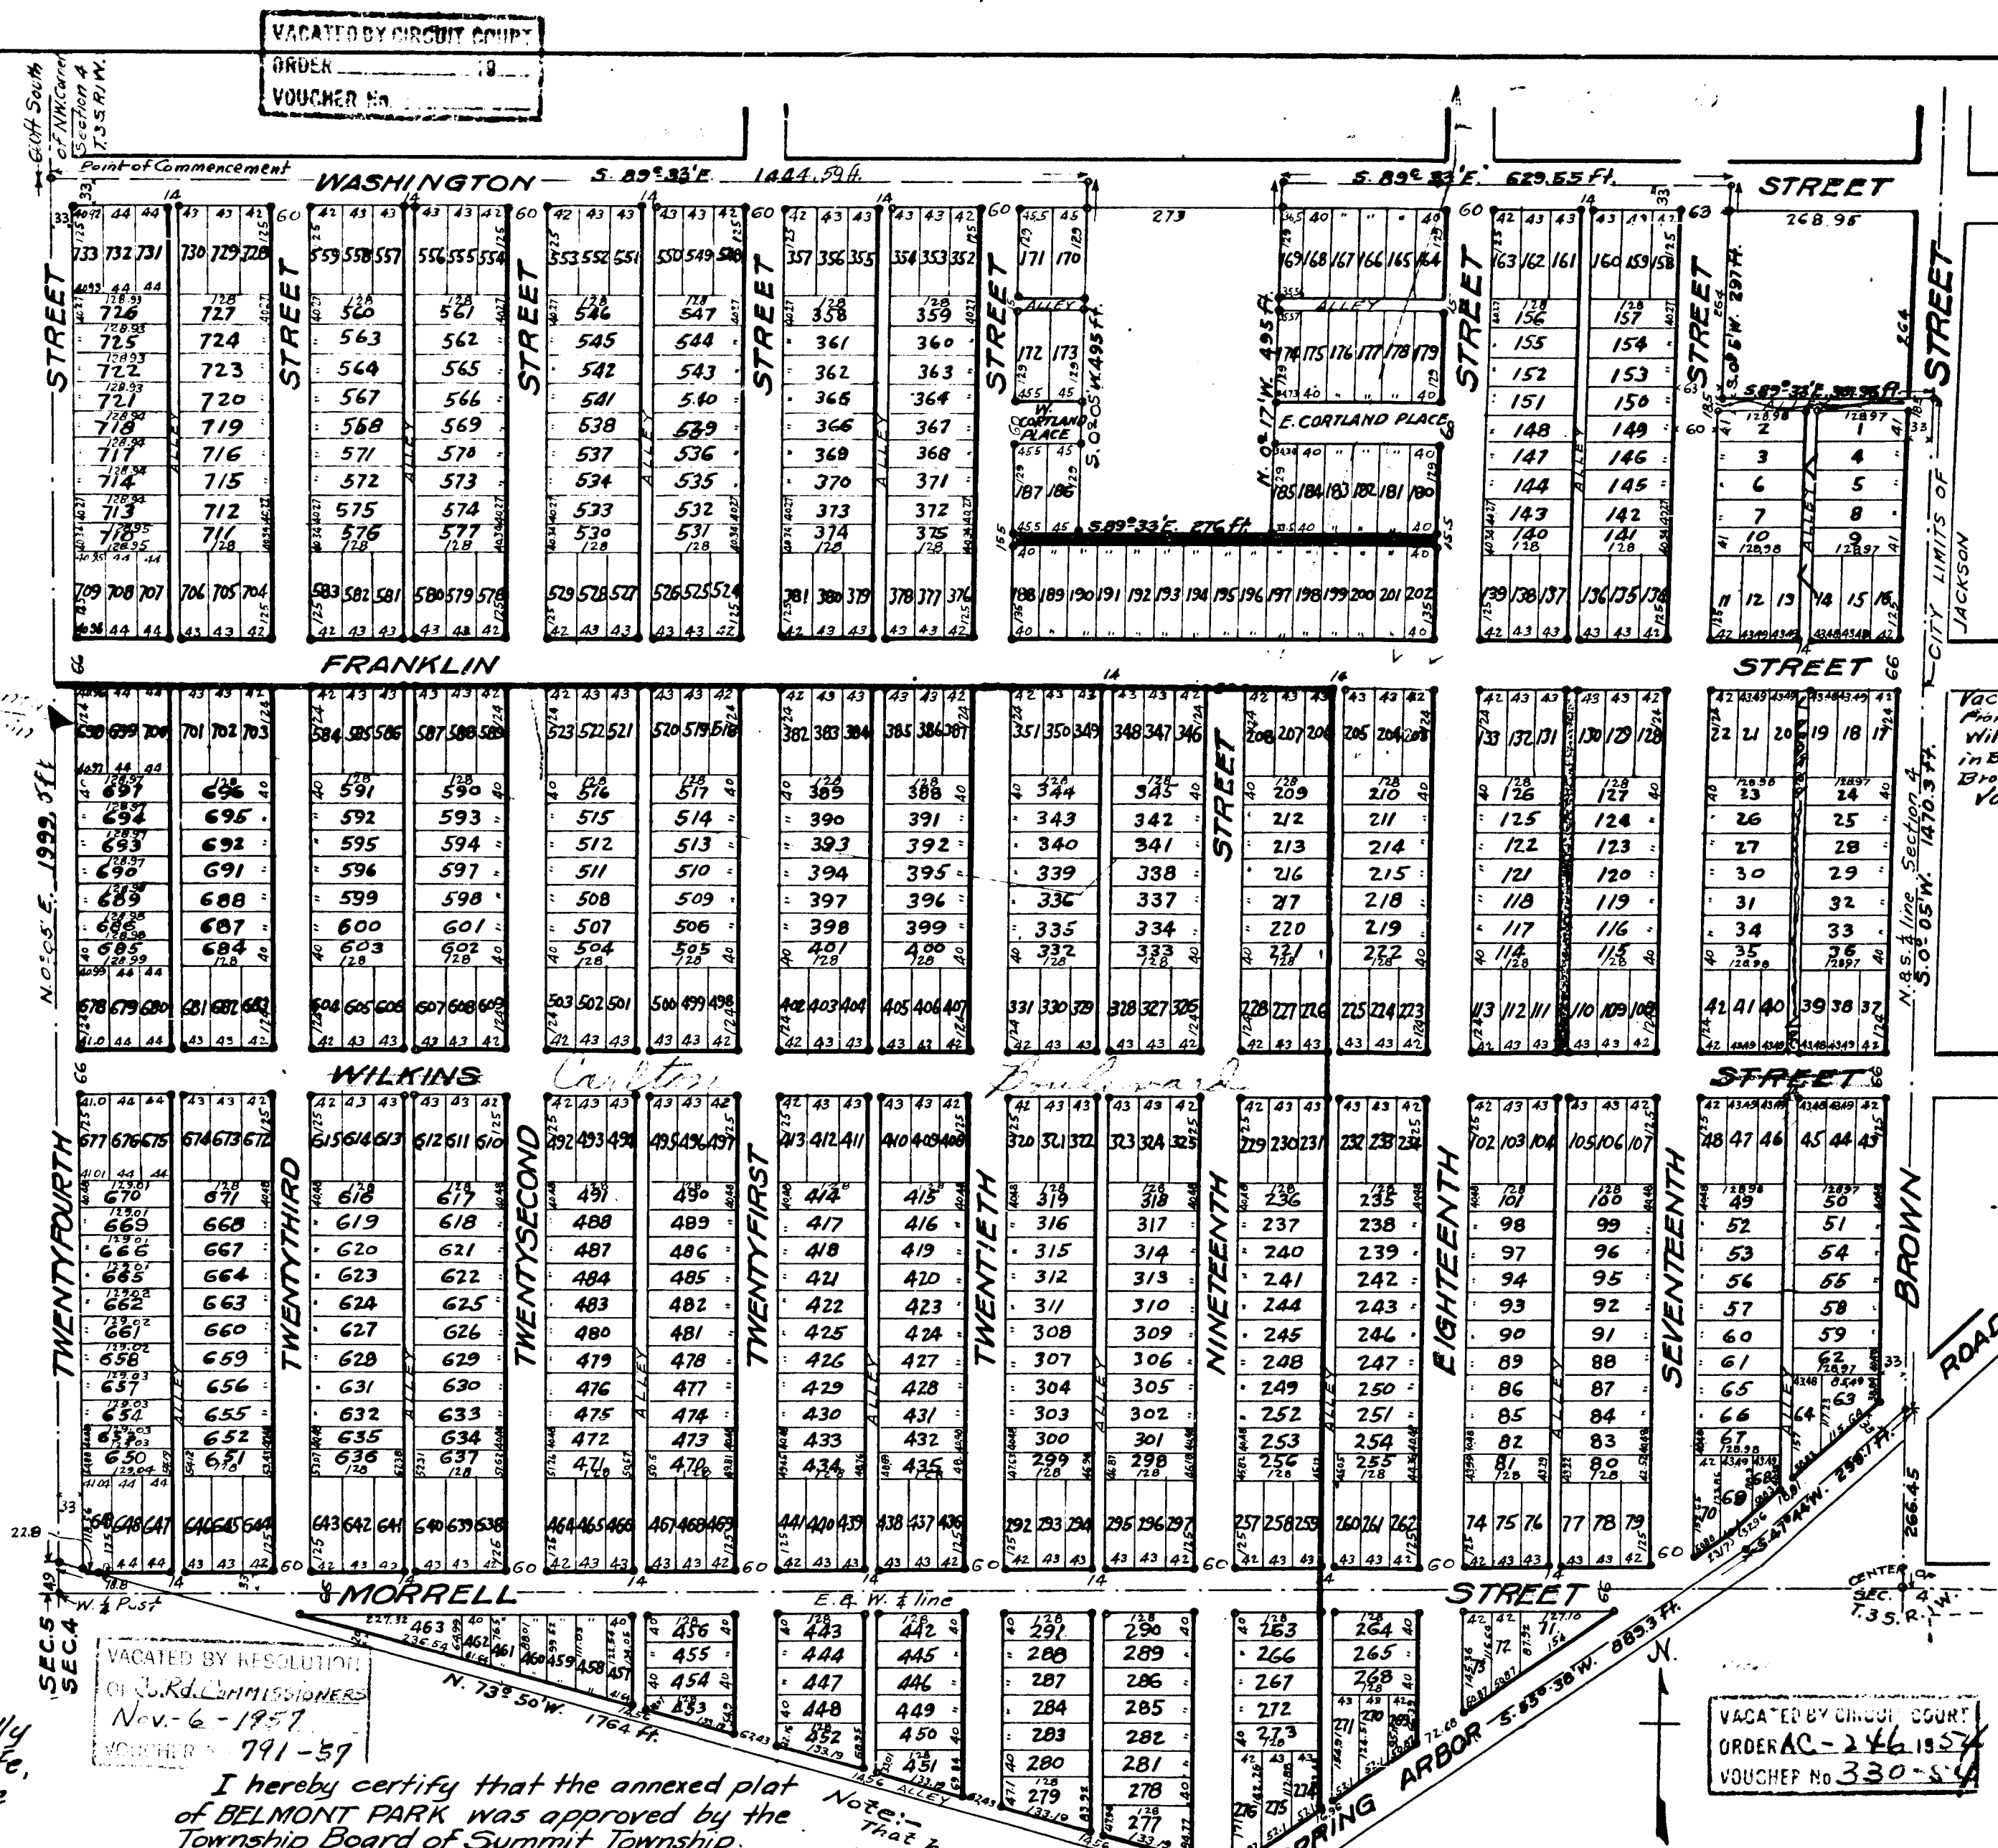

Vacation of Al
from Franklin to
Wilkins Street
in Block Lying be
Brown and 17th
Voucher # 2
Feb. 9th-19

VACATED BY CIRCUIT COURT
ORDER AC-2461957
VOUCHER NO 330-54

13882

10

Jackson County Vacations

PLAT- BELMONT PARK

In re petition)
N.P.Dodds Jr)
to Vacate part)
of Plat)

ORDERED: That all that portion of the Plat of

BELMONT PARK


DESCRIBED as follows;
All that part of Belmont Park lying South of the South
line of Franklin Street and west of the west line of an
alley or said Alley continued running north and south
lying midway between Eighteenth and Nineteenth Streets,
Said land constituting a part of the North west quarter
and a prt of the north half of southwest quarter of sec-
tion 4, Town 3 South range 1 west, Township of Summit,
Jackson County, Michigan, be and the same is hereby VACATED

Order Judge Jas.A.Parkinson
November 3, 1913
Journal T page 62-3

Aud Gen Dept Vol ¹⁶⁹ ~~164~~ page ¹³⁸⁸² ~~12251~~ ✓
County record Plat Book 8 page 2

Eddy & Bennett
Plat Examiners
March 16 1916

137

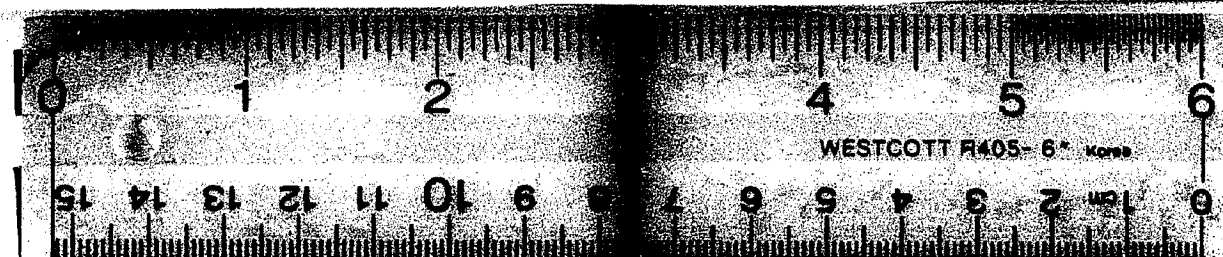

16 X