


40

6787
CORA J WARD
NOTARY
PUBLIC
JACKSON CO WICH
"90

Surveyor:

CONTINUED TO SHEET NUMBER THREE

ESSEX HEIGHTS NUMBER TWO
SHEET NUMBER TWO OF THREE SHEETS

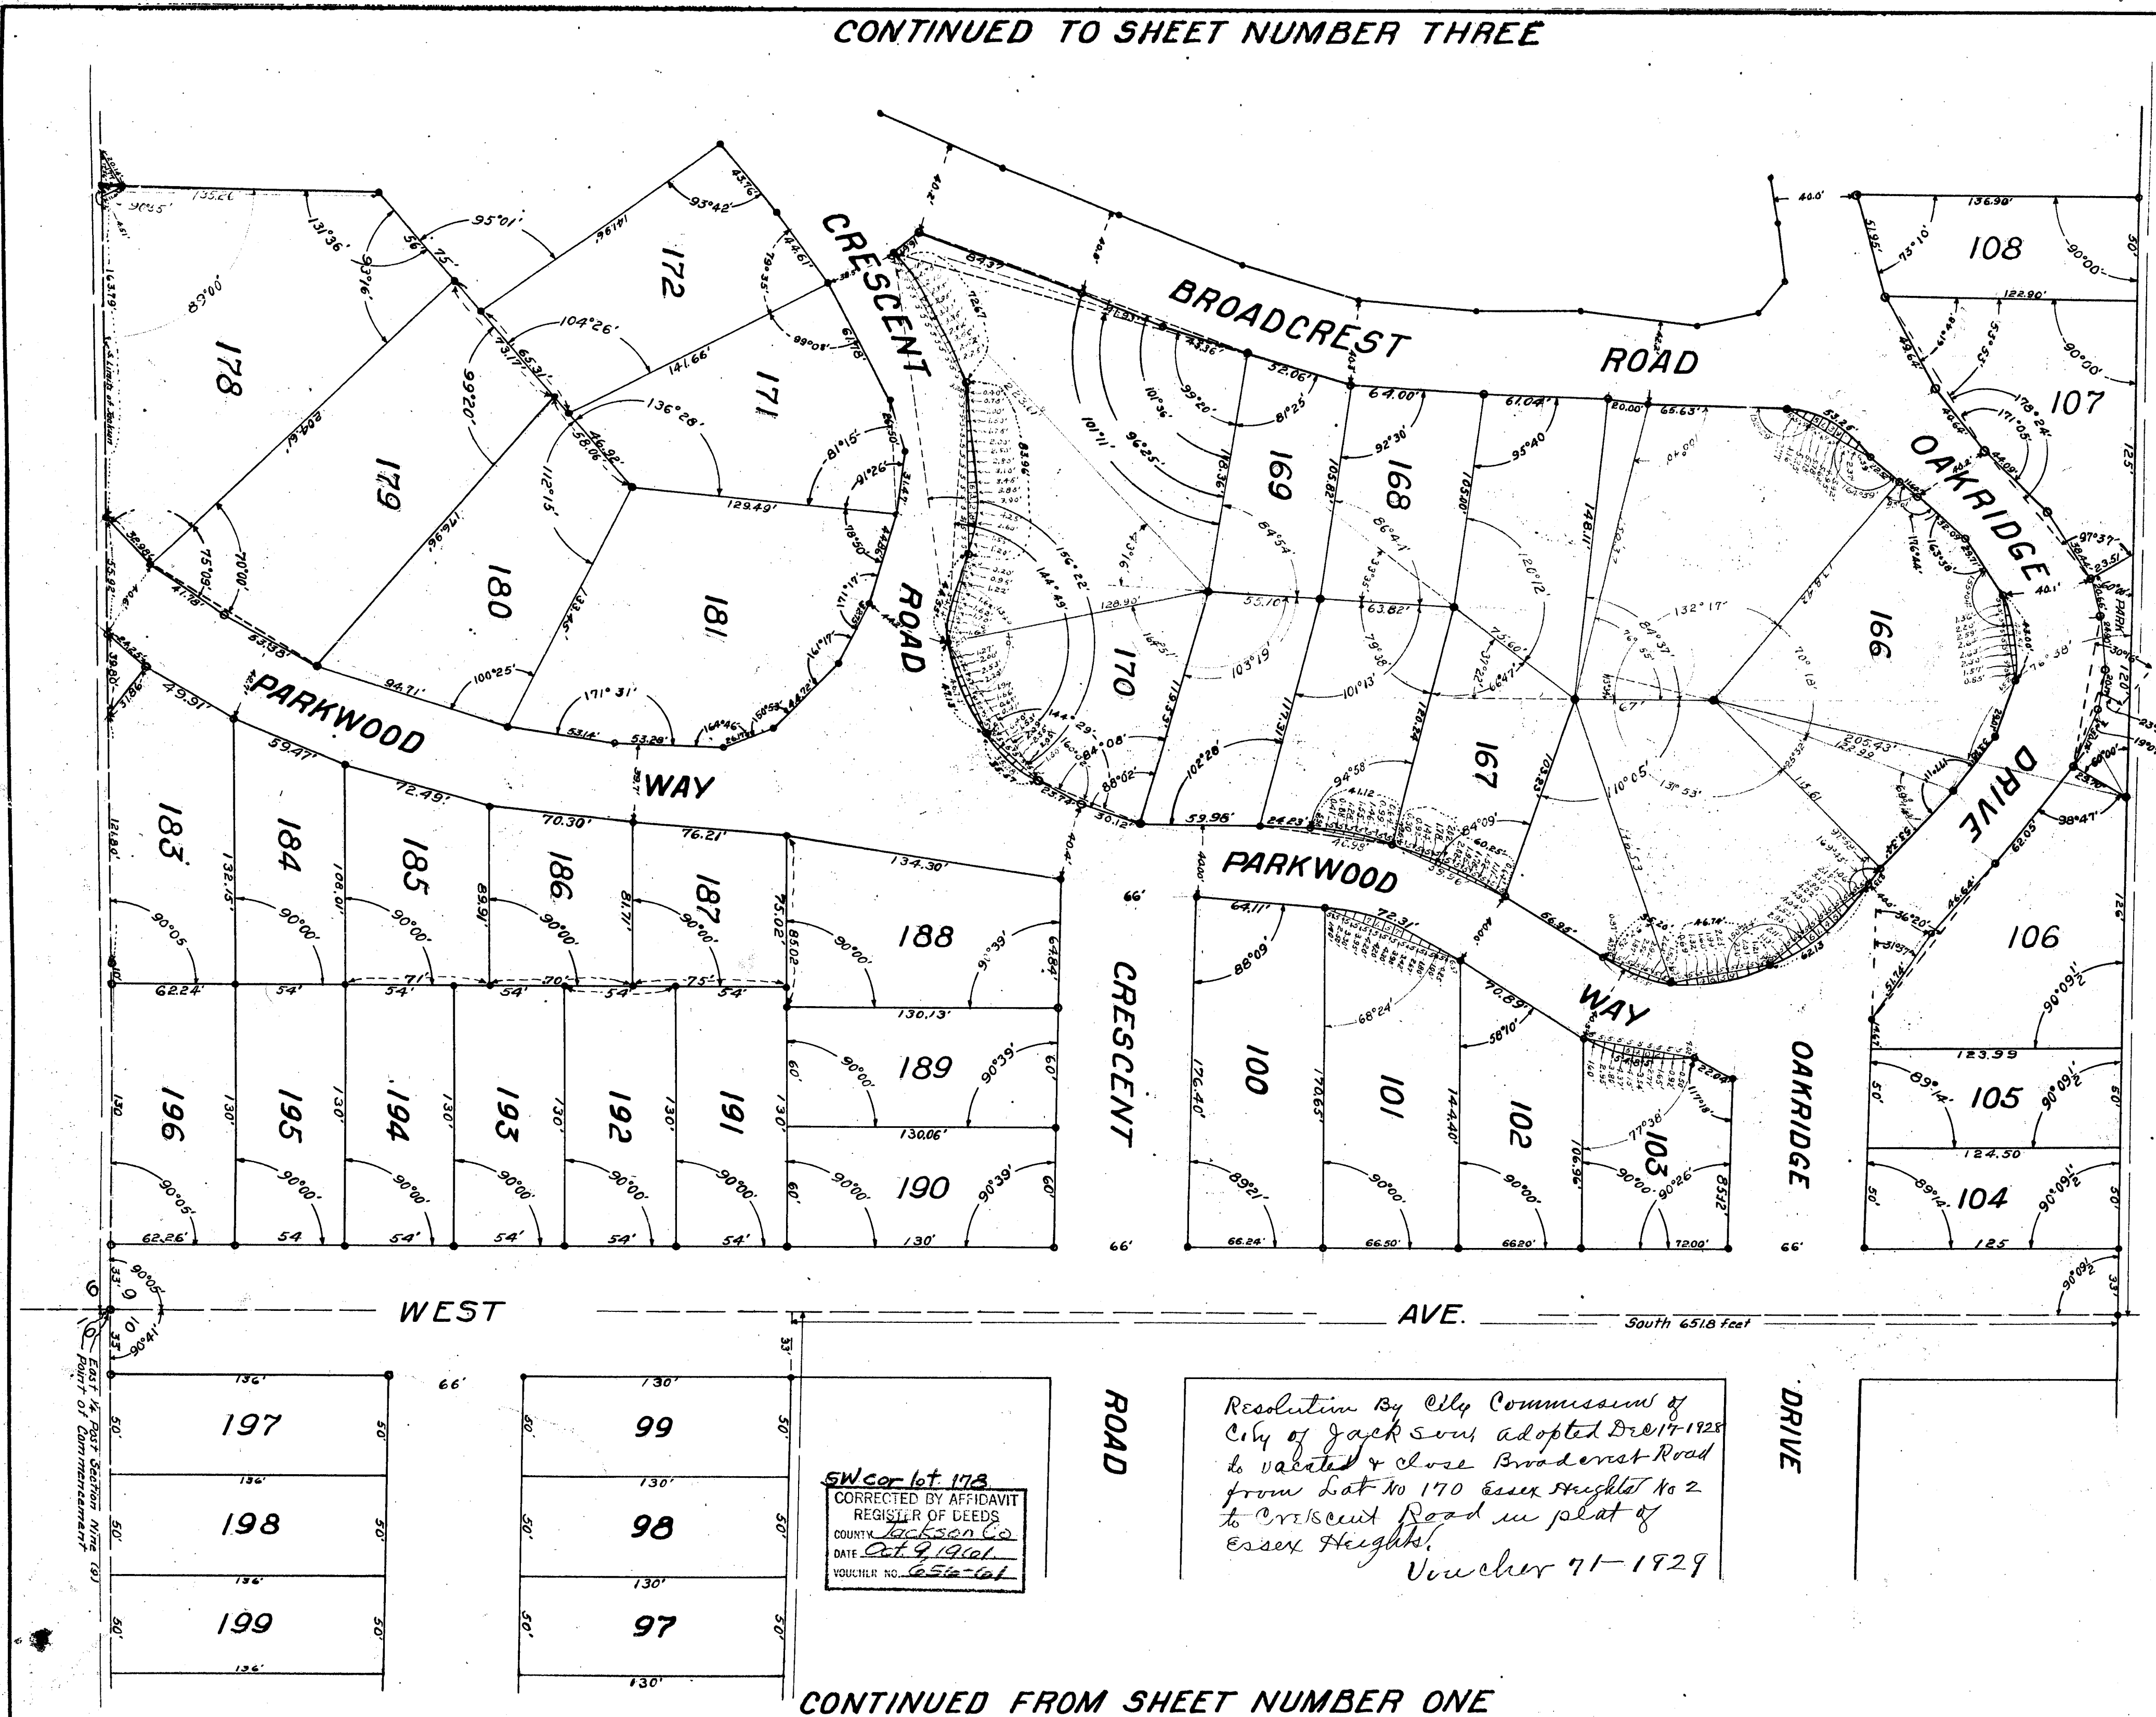


CONTINUED FROM SHEET NUMBER ONE

13917

CONTINUED TO SHEET NUMBER THREE


ESSEX HEIGHTS NUMBER TWO
SHEET NUMBER TWO OF THREE SHEETS

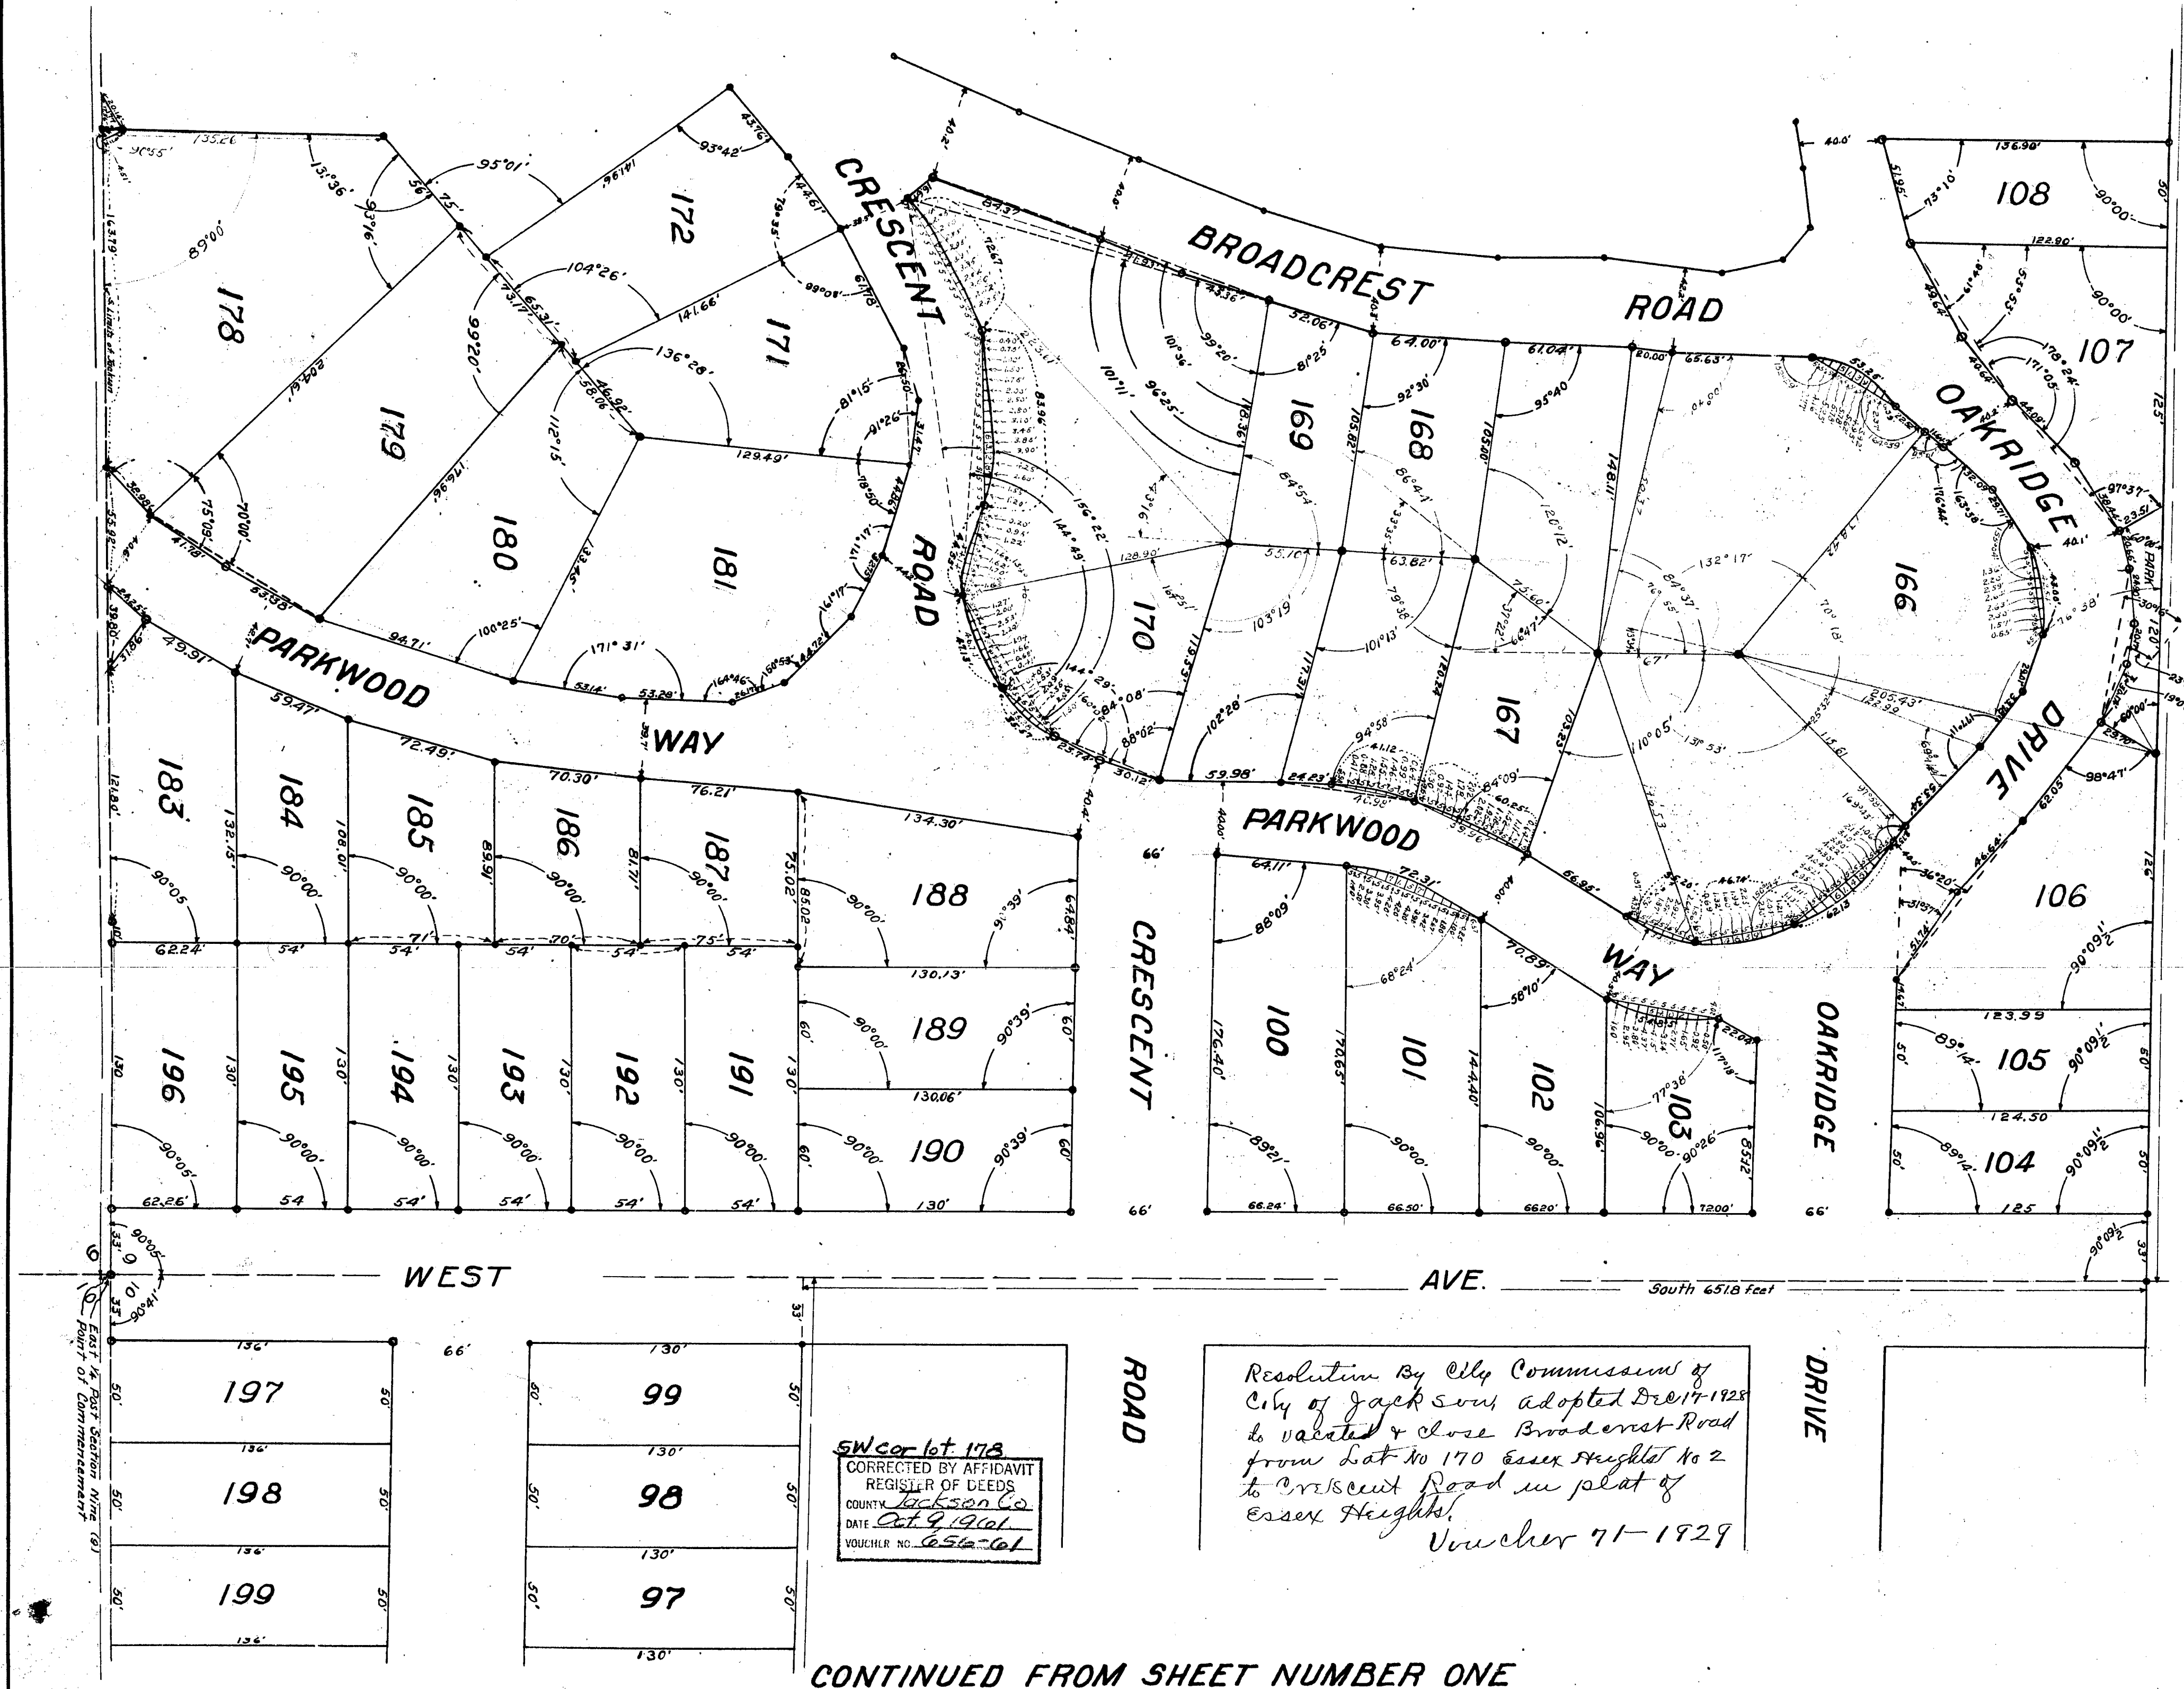

13917

ESSEX HEIGHTS NUMBER TWO
SHEET NUMBER THREE OF THREE SHEETS

13917

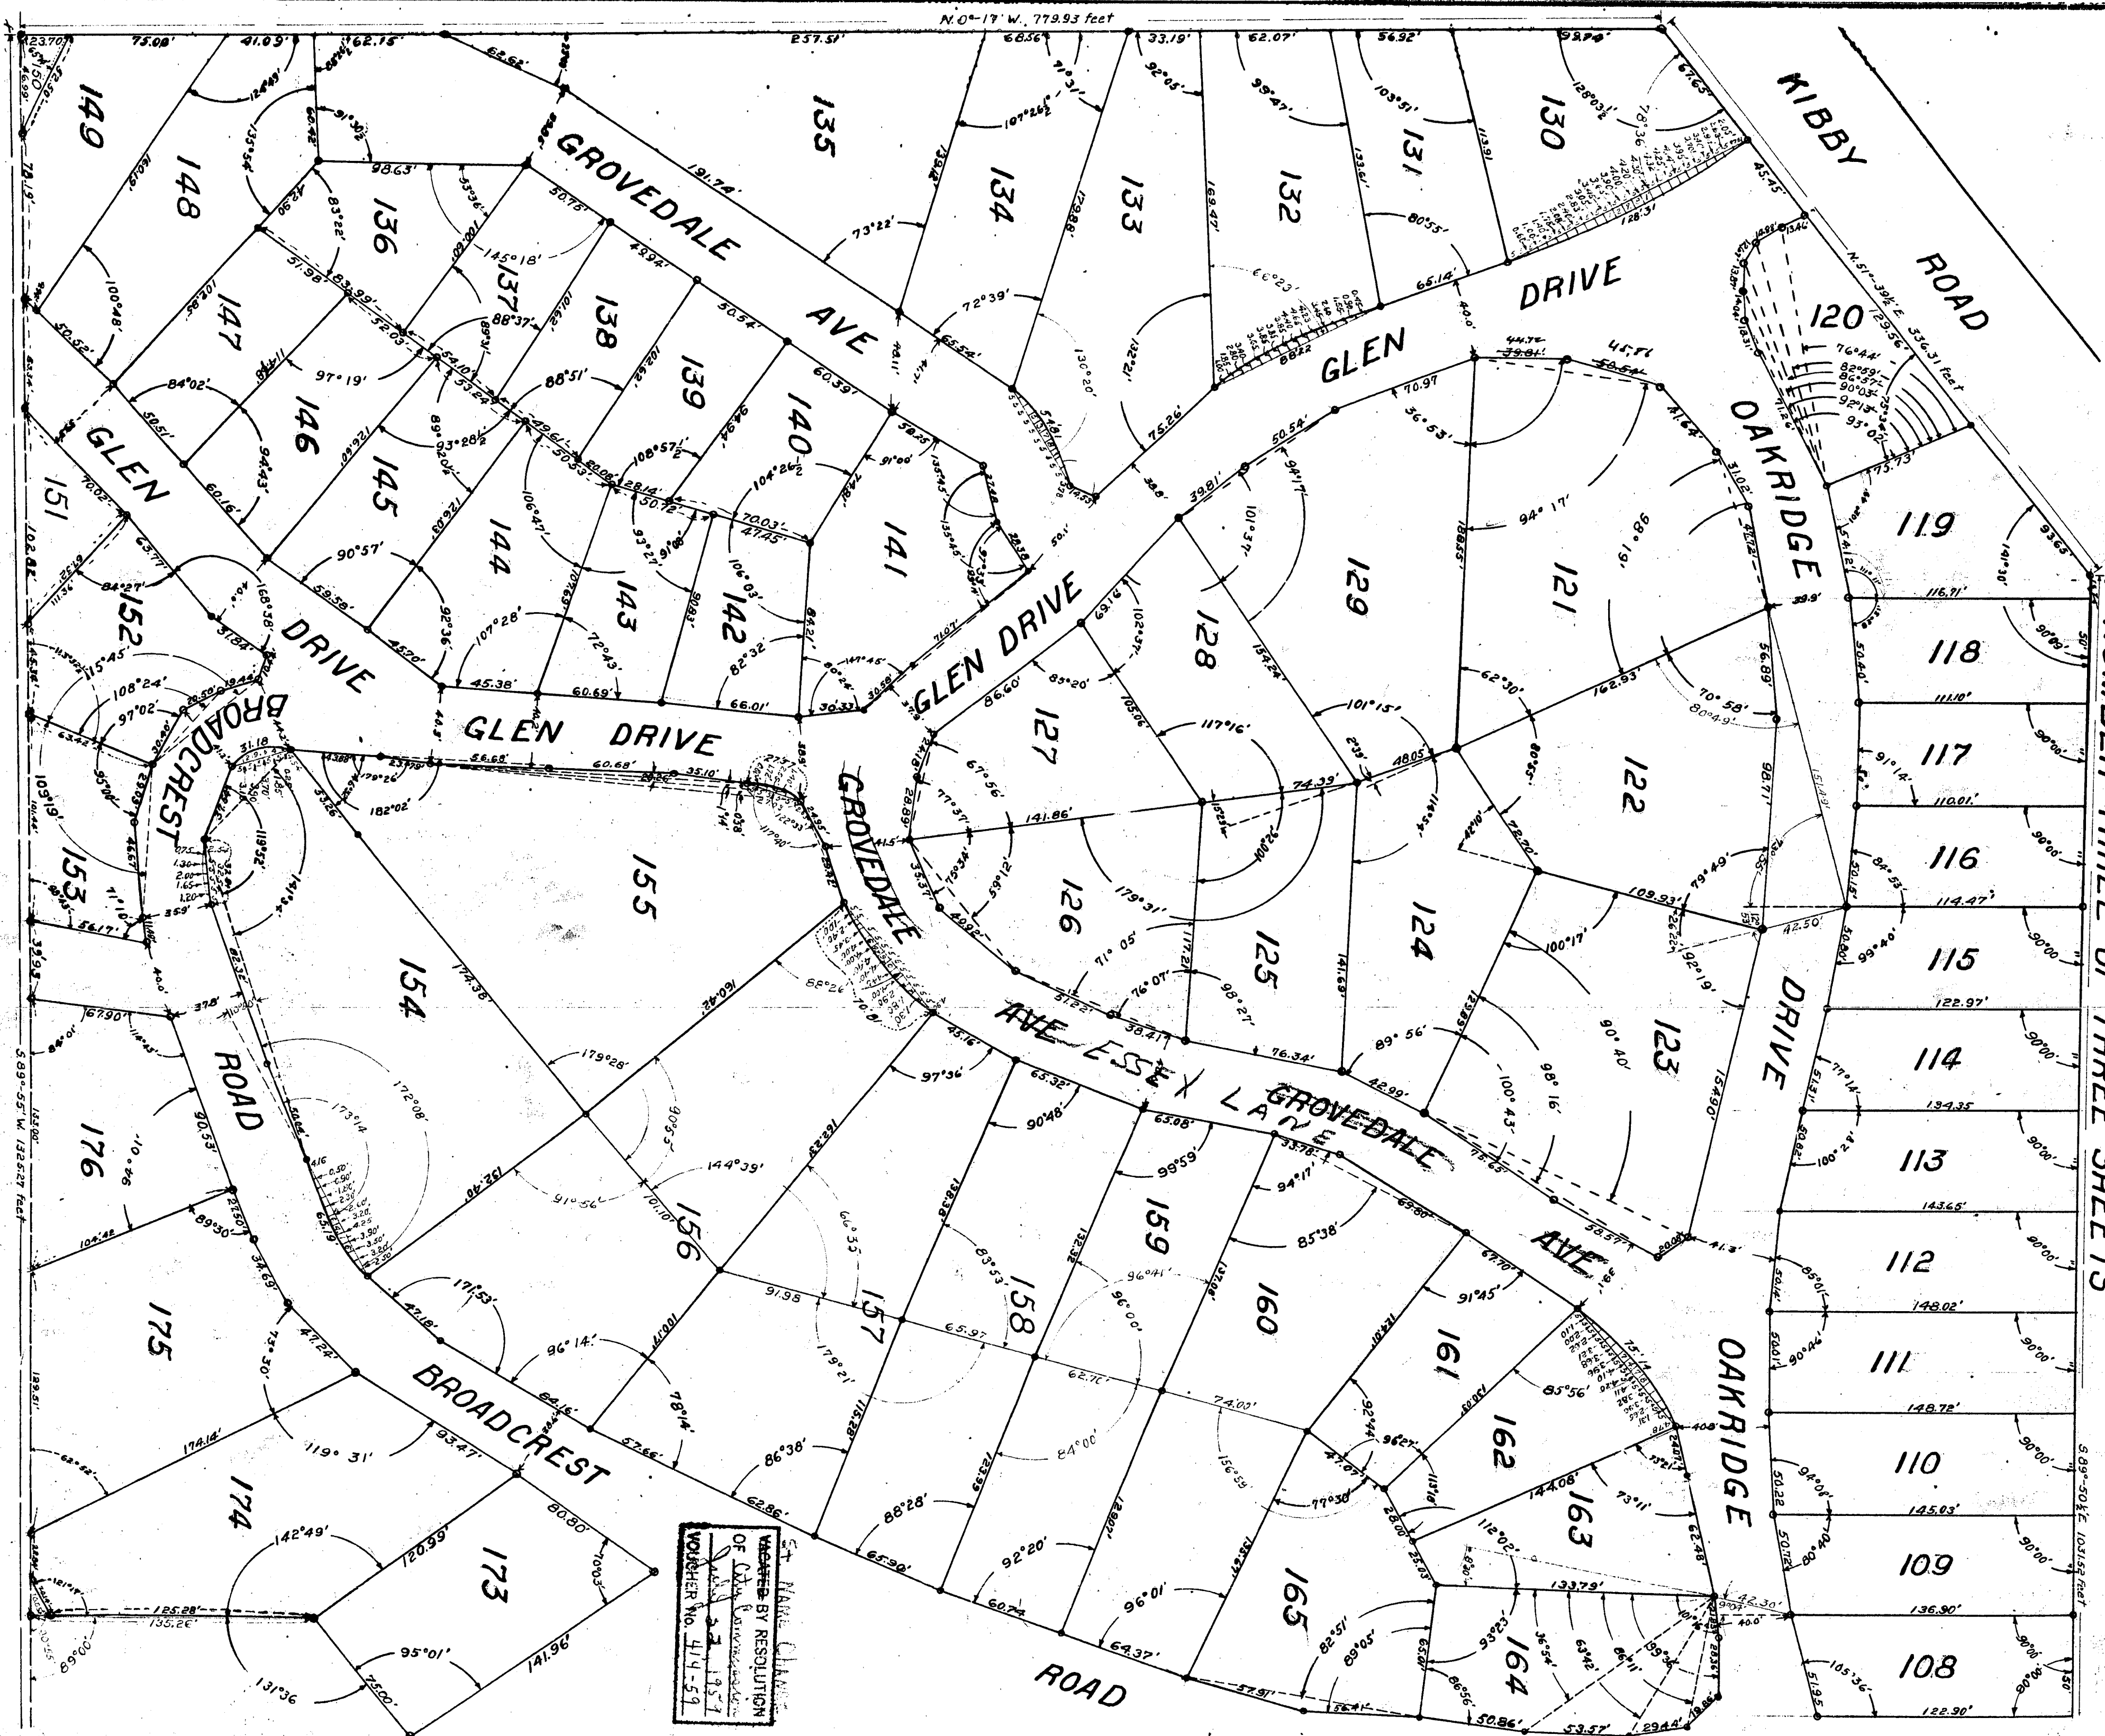


ST. NAME CHANGE
MADE BY RESOLUTION
OF THE BOARD OF
SUPERVISORS
VOLUME NO. 414-59

CONTINUED FROM SHEET NUMBER TWO

ESSEX HEIGHTS NUMBER TWO
SHEET NUMBER TWO OF THREE SHEETS


CONTINUED TO SHEET NUMBER THREE

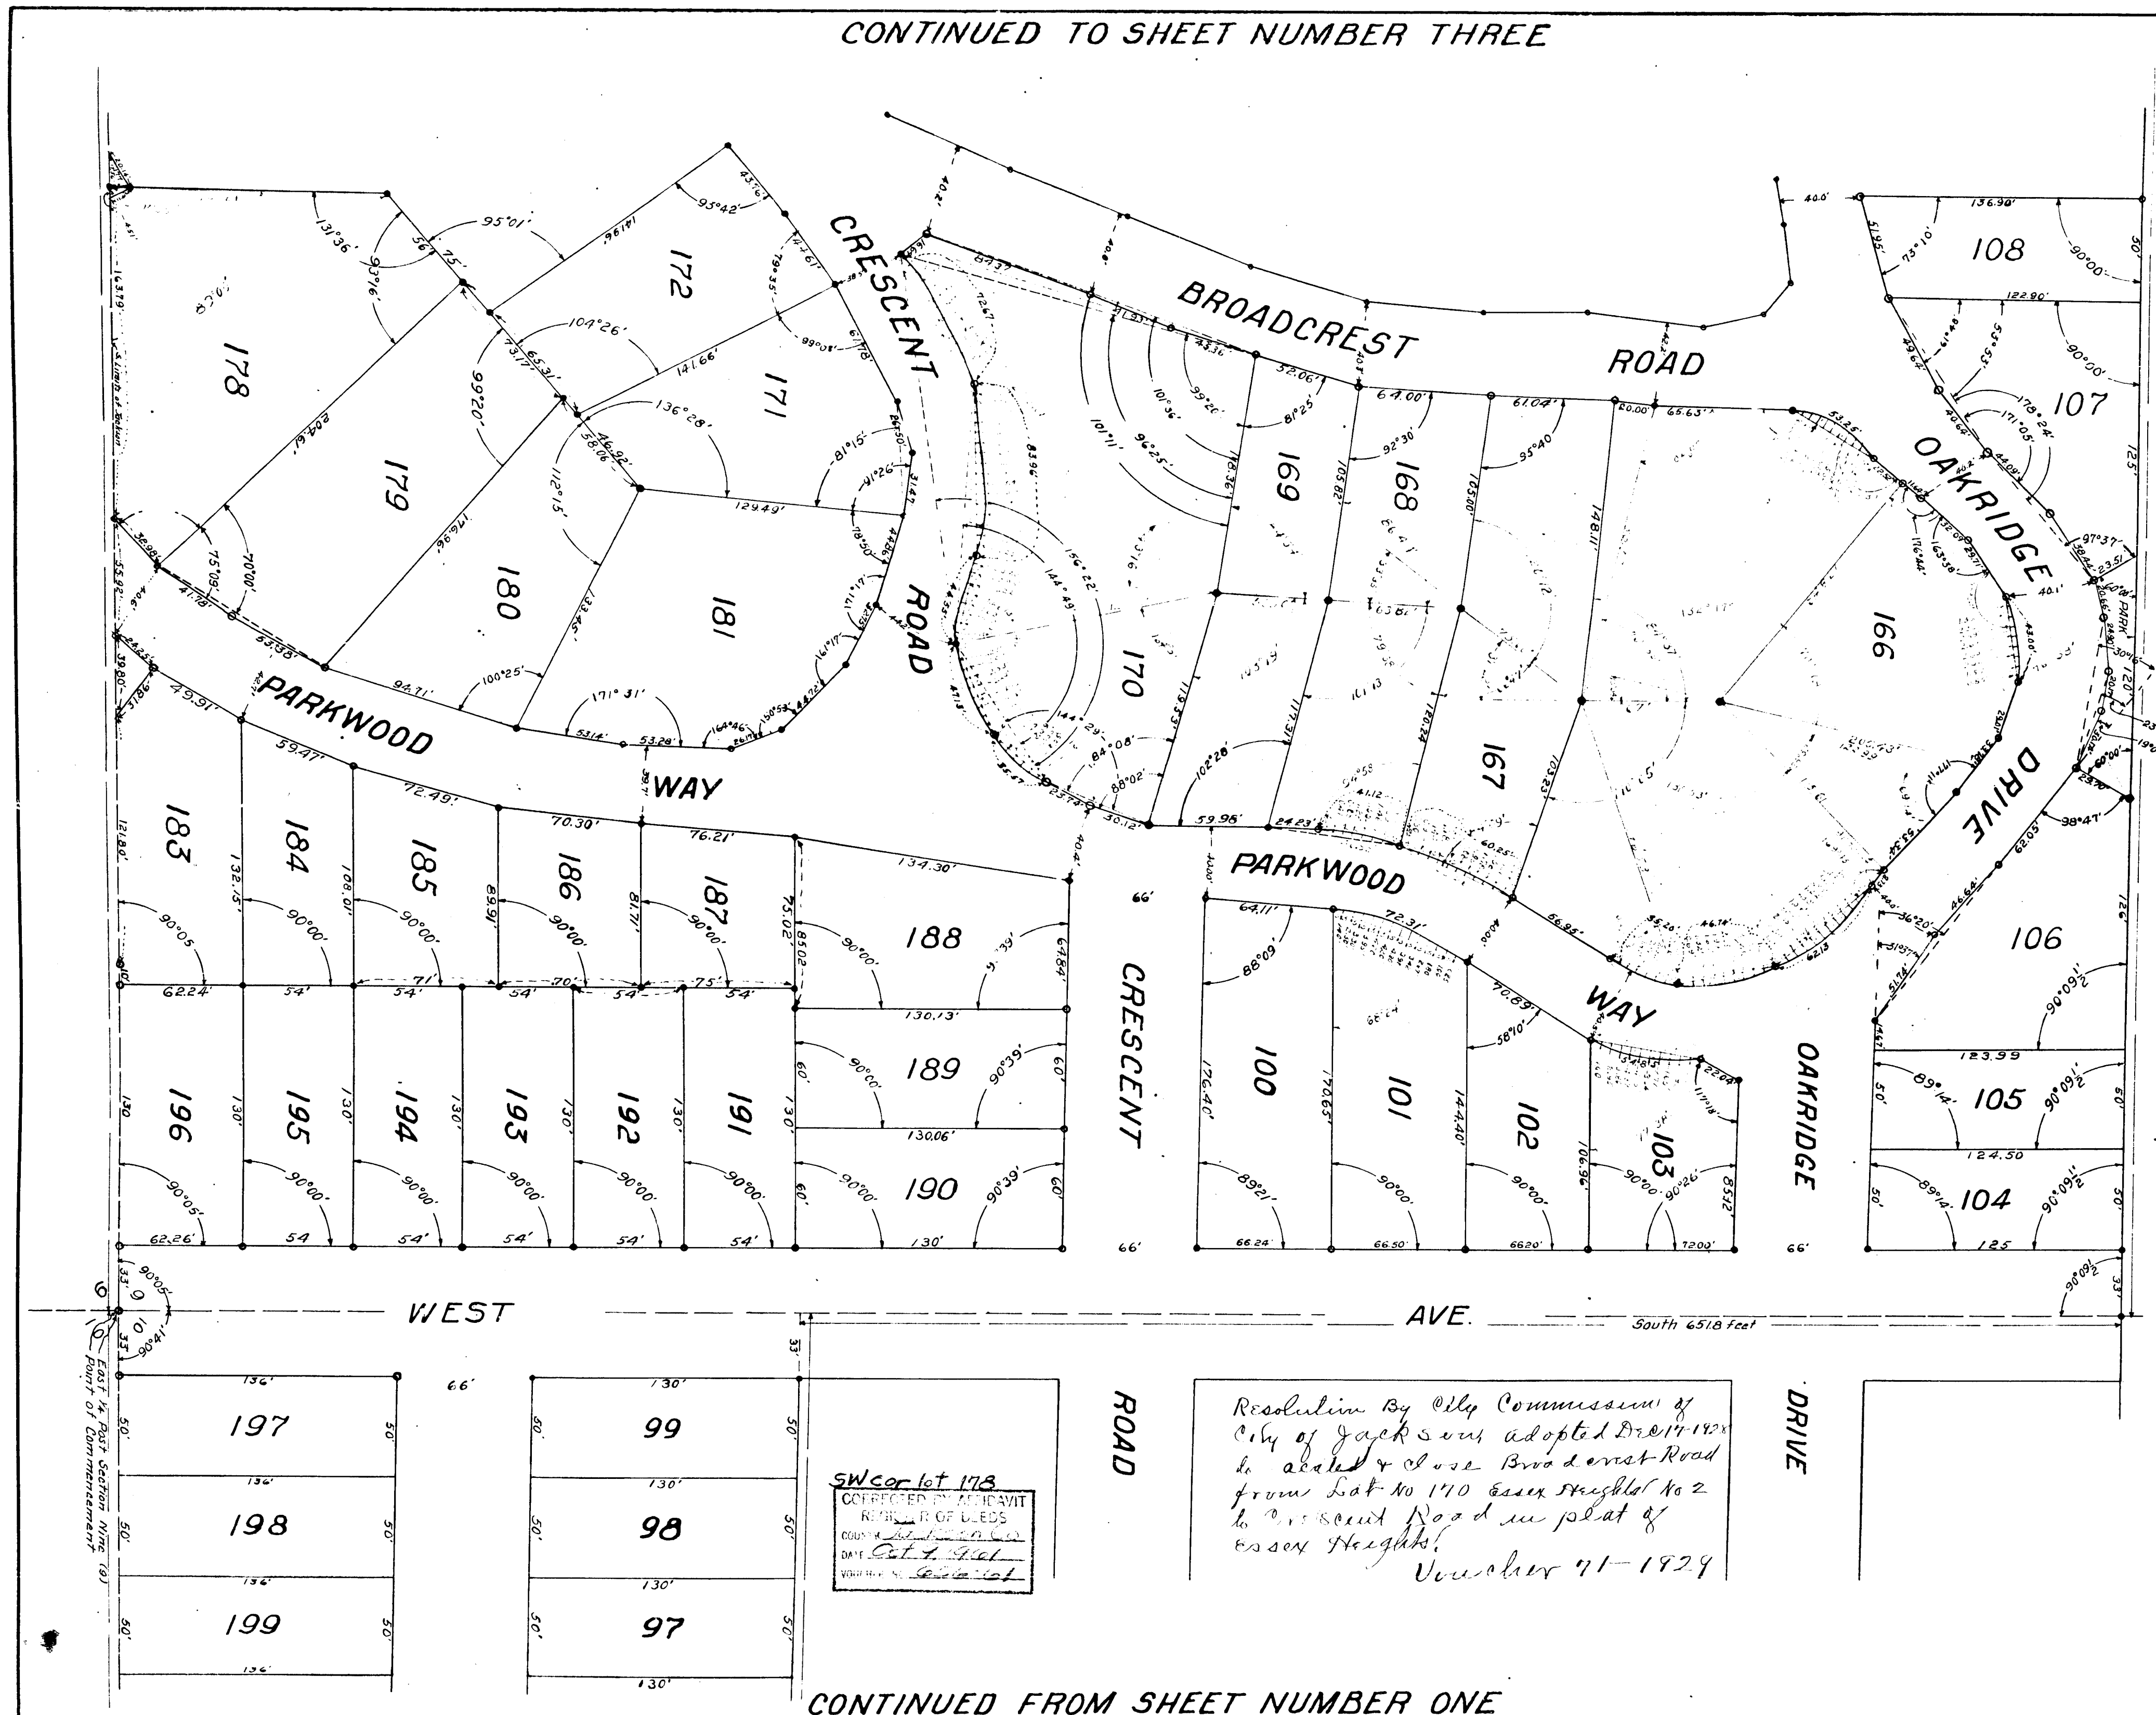

13917

CONTINUED TO SHEET NUMBER THREE

ESSEX HEIGHTS NUMBER TWO
SHEET NUMBER TWO OF THREE SHEETS

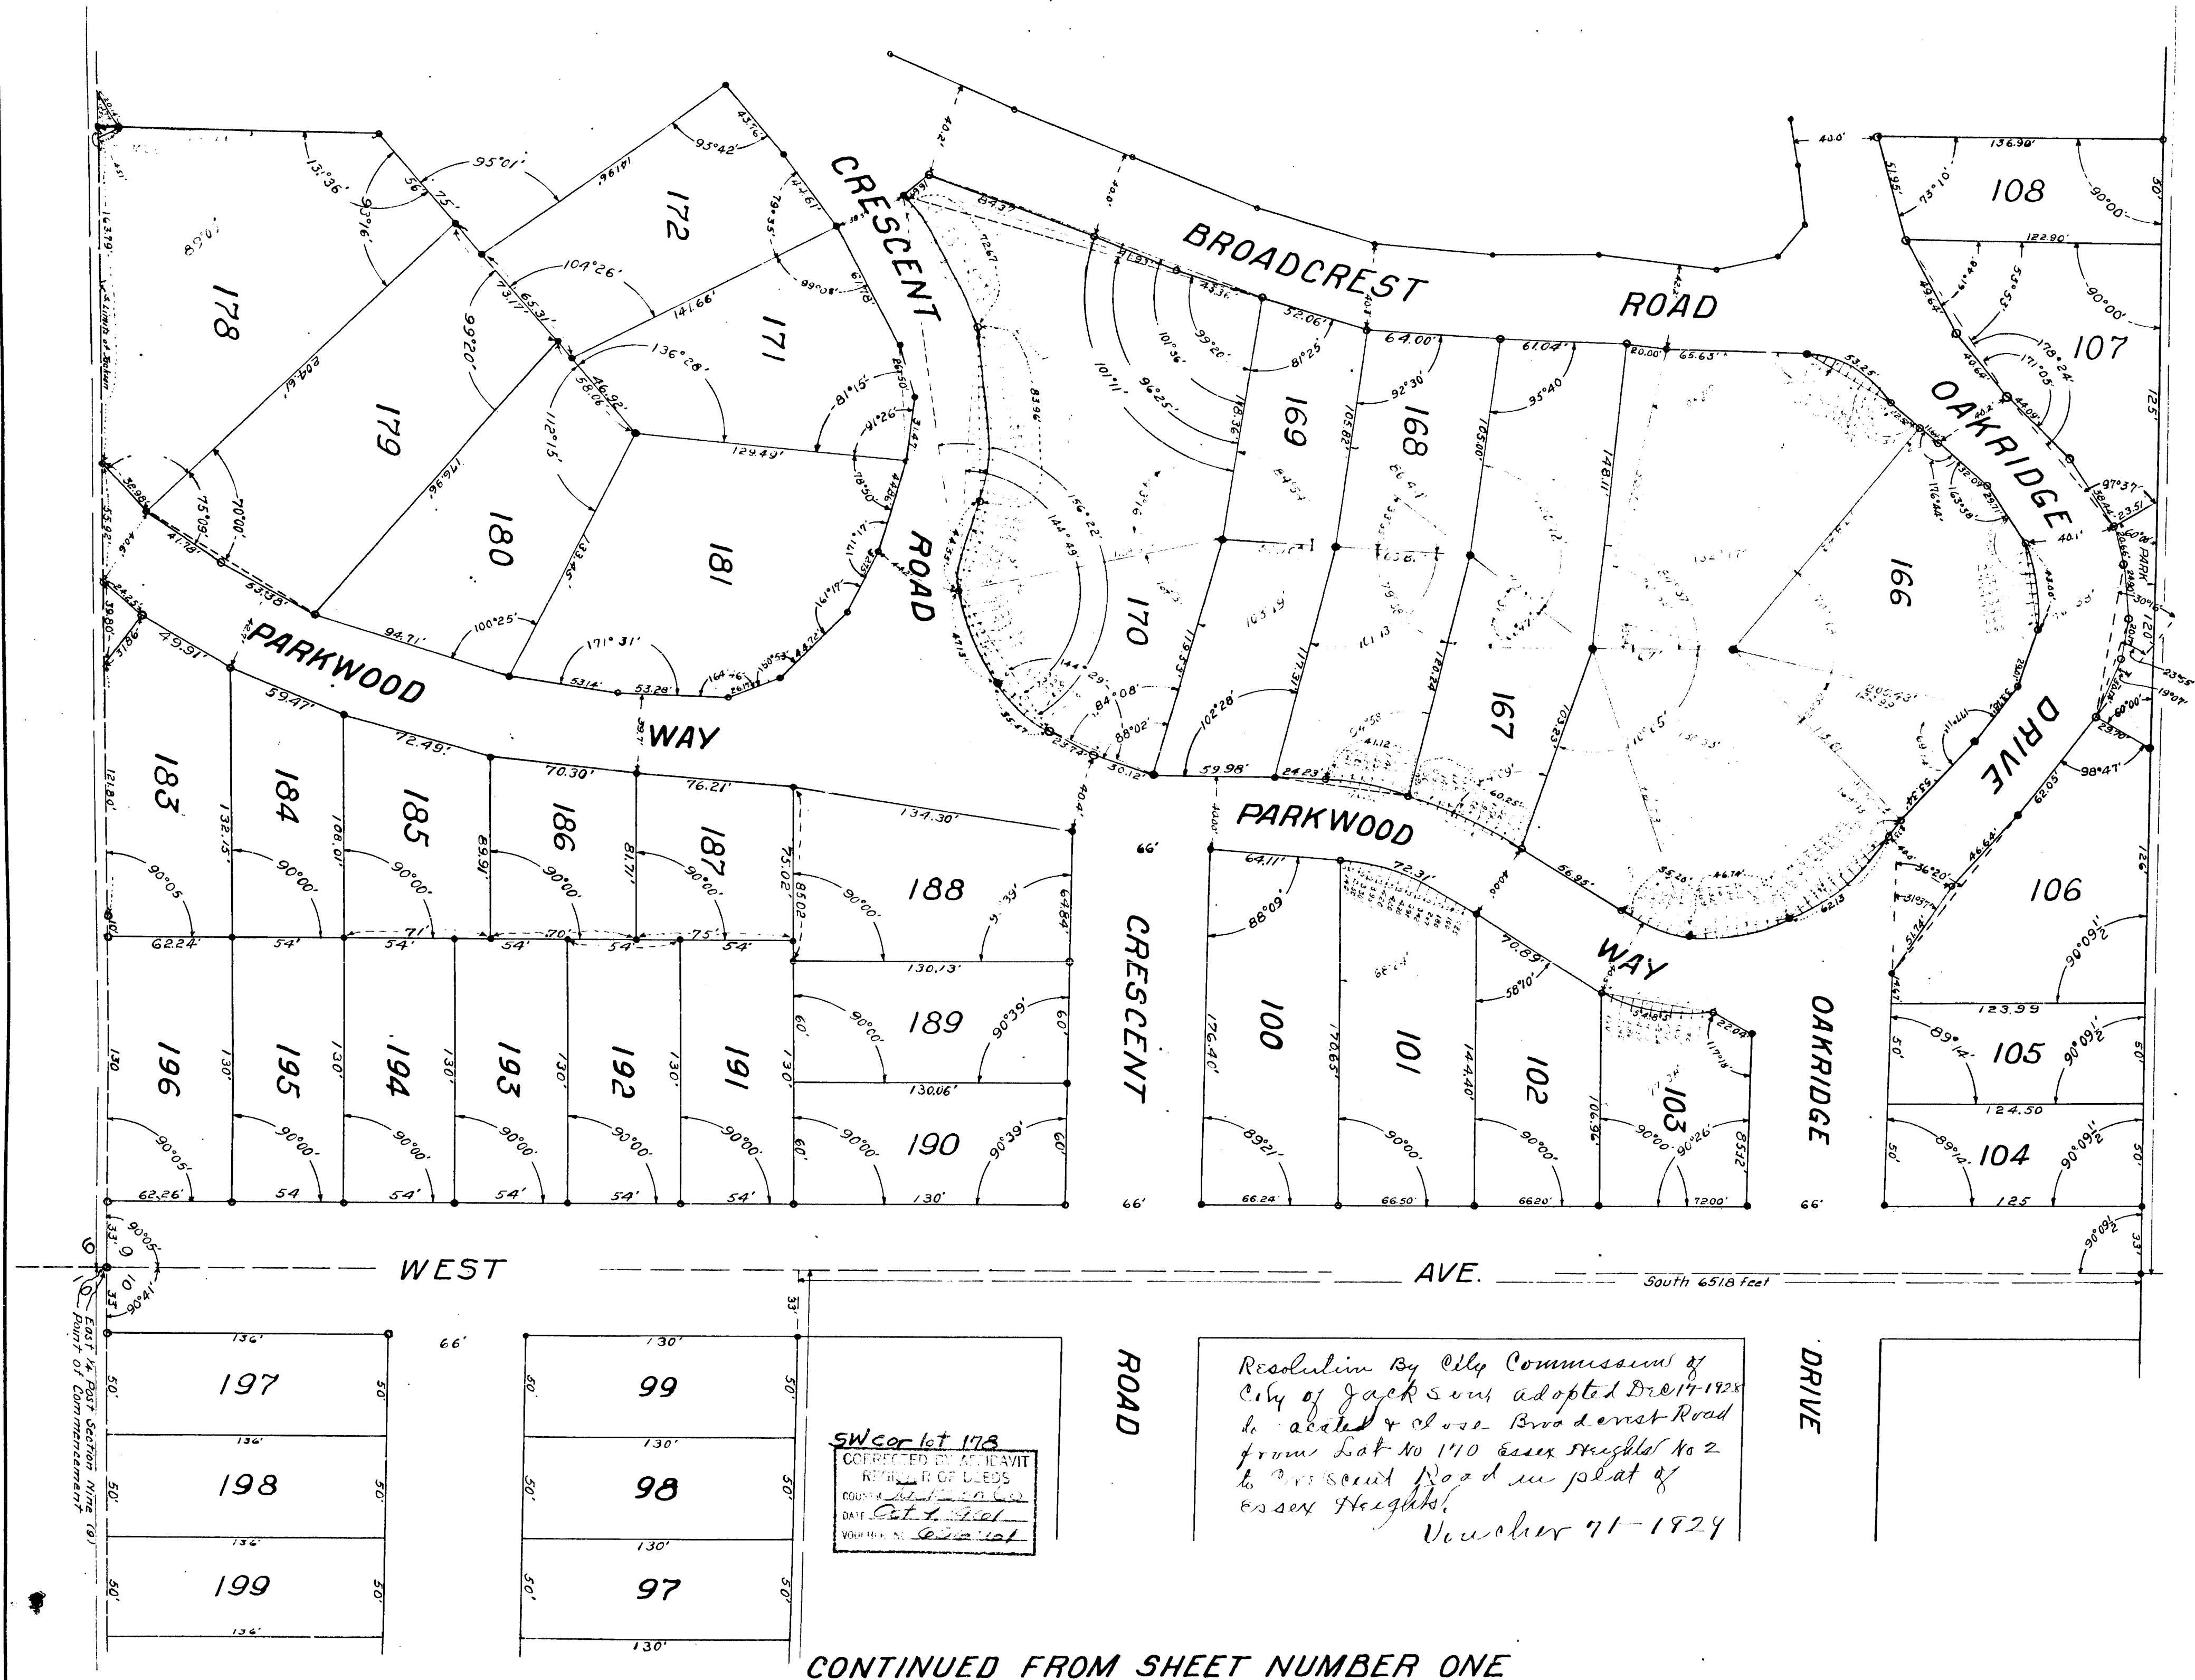


CONTINUED FROM SHEET NUMBER ONE

13917

ESSEX HEIGHTS NUMBER TWO
SHEET NUMBER THREE OF THREE SHEETS

13917

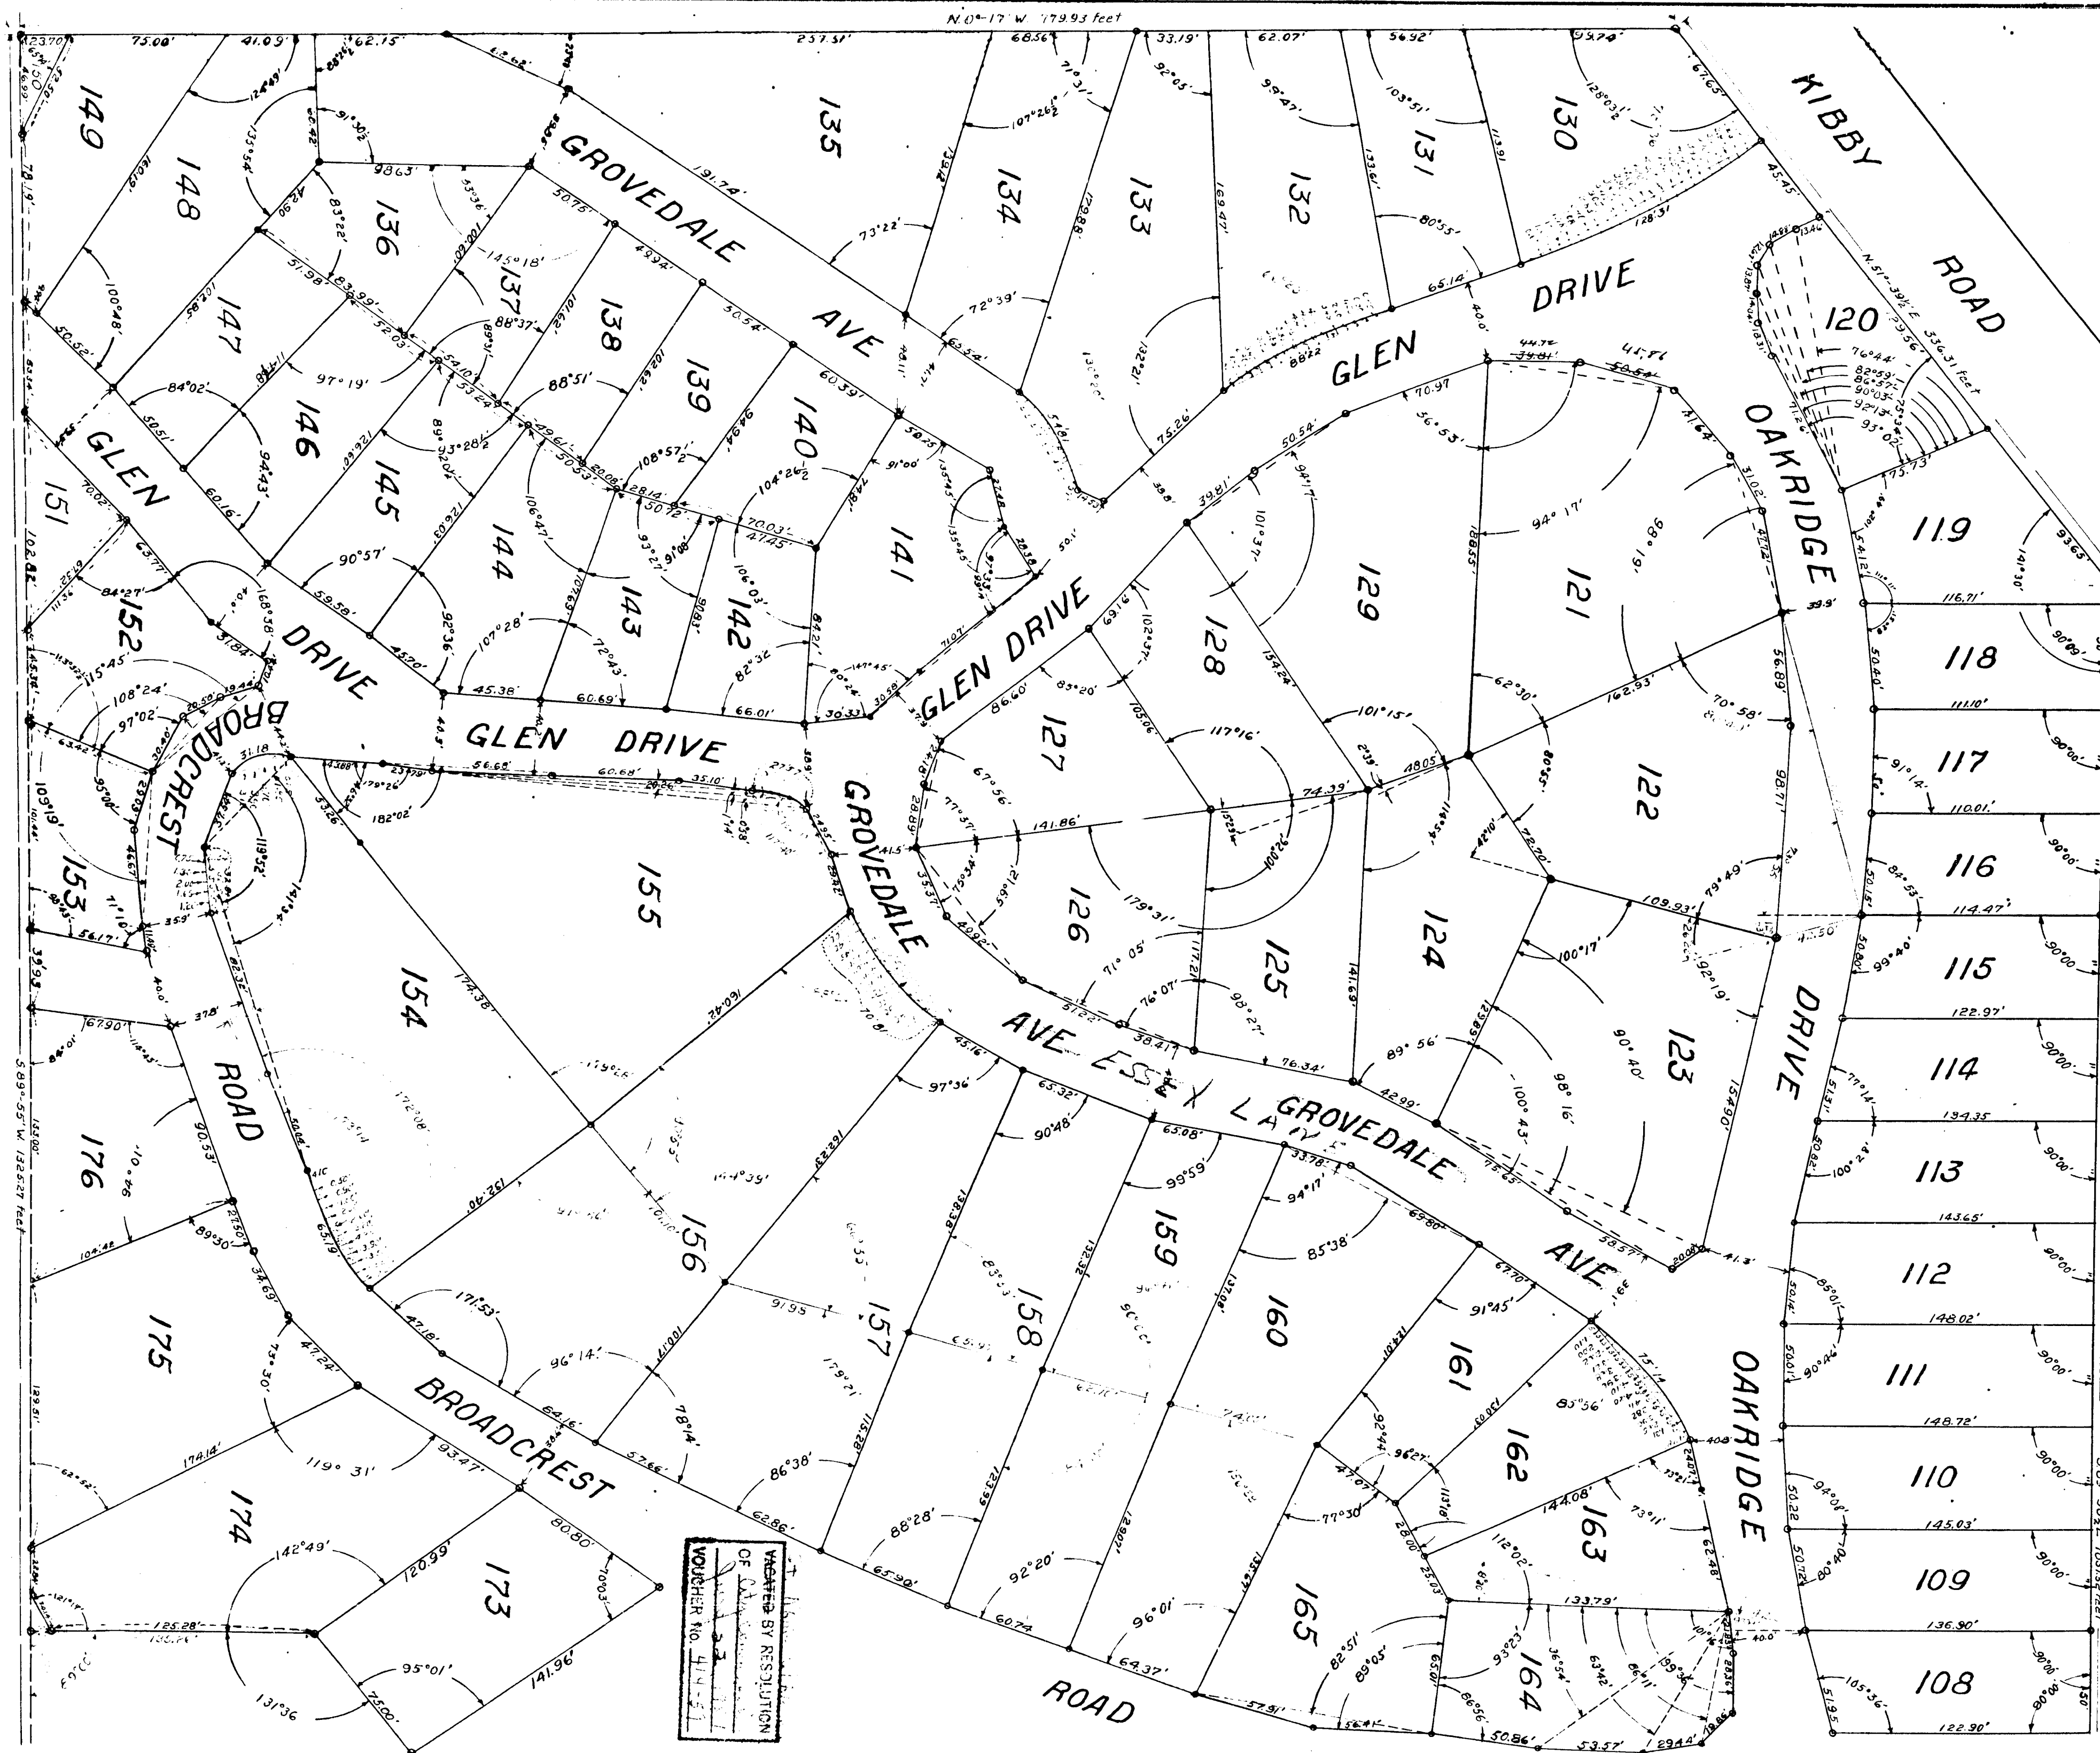

CONTINUED FROM SHEET NUMBER TWO

WATERED BY RESOLUTION
OF C.A.
VOUCHER NO. 414-51

OFFICE OF
EVERETT D. CATTELL
CITY CLERK

MICHIGAN
June 30, 1964



Plat Engineer,
Auditor General's Office,
Lansing, Michigan

Dear Sir:

Enclosed herewith is a resolution adopted May 5, 1964, by the Jackson City Commission, together with map, showing the vacation of a parcel of land located in Essex Heights No. 2 Subdivision in the City of Jackson.

Very truly yours,

E. D. Cattell
Everett D. Cattell
City Clerk

CITY OF JACKSON

13917

RESOLUTION

BY THE CITY COMMISSION:

WHEREAS, Essex Heights Number Two is a subdivision in the Southwest quarter (4) of the Northwest quarter (3) of Section 10, and the Southeast quarter (4) of the Northeast quarter (4) of Section 9, both in Town three (3) South, Range one (1) West, City of Jackson, Jackson County, Michigan, and that said subdivision was duly approved and recorded on September 25, 1916, in accordance with the Plat Act in Liber 9 of Plats at page 4 in the Register of Deeds Office for the County of Jackson, Michigan; and

WHEREAS, at the time of the dedication of said plat a parcel of land located between Lots No. 106 and No. 107 of said subdivision was dedicated, reserved, and set aside as a public park, and more particularly described hereinafter; and

WHEREAS, it appears that said parcel of land appearing on the plat as a public park has never been used or considered by the public as a park; it further appearing that said parcel of land has been used, occupied, and dealt with as the private property of the owners of Lots No. 107 and No. 106 of said subdivision and their predecessors in the chain of title since about 1927, who have been solely responsible for the care and maintenance of said parcel; and

WHEREAS, it appears that Carl A. Skolberg and Evelyn G. Skolberg are the sole owners of Lot No. 107 and Blanche E. Lowery, as survivor of herself and Emmett A. Lowery, deceased, is the sole owner of Lot No. 106, except the East eighteen (18) inches thereof; it further appearing that all of said persons have consented in writing to the vacating of said parcel; and

WHEREAS, it appears the owners of said Lots No. 106, except the East eighteen (18) inches thereof, and No. 107 are all of the persons interested in such part of said subdivision as will be affected by the vacating of said parcel of land as a park,

NOW, THEREFORE, BE IT RESOLVED, that the following described property located in the City of Jackson, County of Jackson, and State of Michigan and described as follows:

Commencing at the Northwest corner of Lot 106, Essex Heights No. 2, a recorded plat in the City of Jackson, Michigan; thence West 120.0' to the Northeast corner of Lot 107, Essex Heights No. 2; thence Southeast 25.51' along the Easement line of Lot 107 to the Northern line of Oakridge Drive; thence Easterly 95.87' along the Northern line of Oakridge Drive to the Southeast corner of Lot 106; and thence Northeast 29.70' to the place of beginning of this description, formerly known as a "Park" in Essex Heights No. 2.

be and the same hereby is vacated and discontinued as a public park and revert and annex to the abutting property, being Lots No. 106, except the East eighteen (18) inches thereof, and No. 107, Essex Heights Number Two, according to the recorded plat thereof, free from any claims or rights on the part of the public, and that all public claims and rights in and to the same are forever barred.

BE IT FURTHER RESOLVED, that there are hereby expressly reserved and excepted from such vacation of said park, all rights or interests in such existing water and sewage mains, gas lines, electric or telephone lines, or other public utility easements or rights-of-way now installed or in use in said park.

* * *

State of Michigan)
County of Jackson)
City of Jackson)

I, Everett D. Cattell, Clerk in and for the City of Jackson, County and State aforesaid, do hereby certify that the foregoing is a true and compared copy of a resolution adopted by the City Commission of the City of Jackson, Michigan, on May 5, 1964.

IN WITNESS WHEREOF, I have hereto
affixed my signature and the seal
of the City of Jackson, Michigan,
on this 6th day of May, 1964.

Everett D. Cattell CITY CLERK

