

Dep. Aud. Gen.

at J. Line 19 M R. 2.00. Sec. 1

13936

Front. Fouch and Johnsons.
Addition to Cedar Village, Gladwin County, Michigan.

Scale 1 inch = 5 rods



I hereby certify that the above plat of
 Front, Fouch and Johnsons Addition to
 Cedar Village, Gladwin County, Michigan, as
 situated on the North East Quarter and East
 half of the North West Quarter of section one in
 Town Eighteen North of Range Two West in the
 County of Gladwin and State of Michigan and that
 the figures are in feet and fractions of a foot
 and that the Scale is two hundred feet to an
 inch and this plat was made the twenty third
 day of June A.D. 1883
 W. S. Johnson
 S. S. Townsend

State of Michigan, ss. On this 26th day of June
 County of Gladwin, ss. before me a Notary Public
 in and for said County personally
 appeared the above named S. S. Townsend
 known to me to be the person who
 executed the above and acknowledges the
 same to be his own free act and deed.


We hereby certify that we are the owners of the above described
 and plotted pieces of land and that we have caused the
 same to be plotted as above and further that C. E. Fouch is
 the owner of the S.E. 1/4 of NW 1/4 and S.W. 1/4 of NW 1/4
 Lot marked B in Block 77 herefore sold and that
 B. S. Johnson is the owner of the N.W. 1/4 of NW 1/4 and NW 1/4 of NW 1/4
 and that W. S. Johnson is the owner of the S.W. 1/4 of NW 1/4 of NW 1/4
 of NW 1/4. All in section one Town Eighteen North Range
 Two West.
 W. S. Johnson
 S. S. Townsend

State of Michigan, ss. On this 26th day of June A.D. 1883 before me the
 County of Gladwin, ss. Subscribed and sworn to and for said County
 personally appeared C. E. Fouch, W. S. Johnson and W. S. Johnson
 known to me to be the same persons who executed
 and signed the above instrument and severally acknowledged
 the same to be their own free act and deed.

State of Michigan, ss. We S. S. Townsend Register of Deeds and S. S. Townsend
 County of Gladwin, ss. Surveyor hereby certify that we have carefully compared this
 plat of Front, Fouch and Johnsons Addition to Cedar
 Village, Michigan with the plat of said addition on
 Record in this office of said Register of Deeds and that
 it is a true transcript thereof and the whole of said Record.

Register of Deeds
 Gladwin Co.
 Received for Record this
 26th day of June A.D. 1883 and recorded
 in Book of Plats on Page 32
 S. S. Townsend

1883

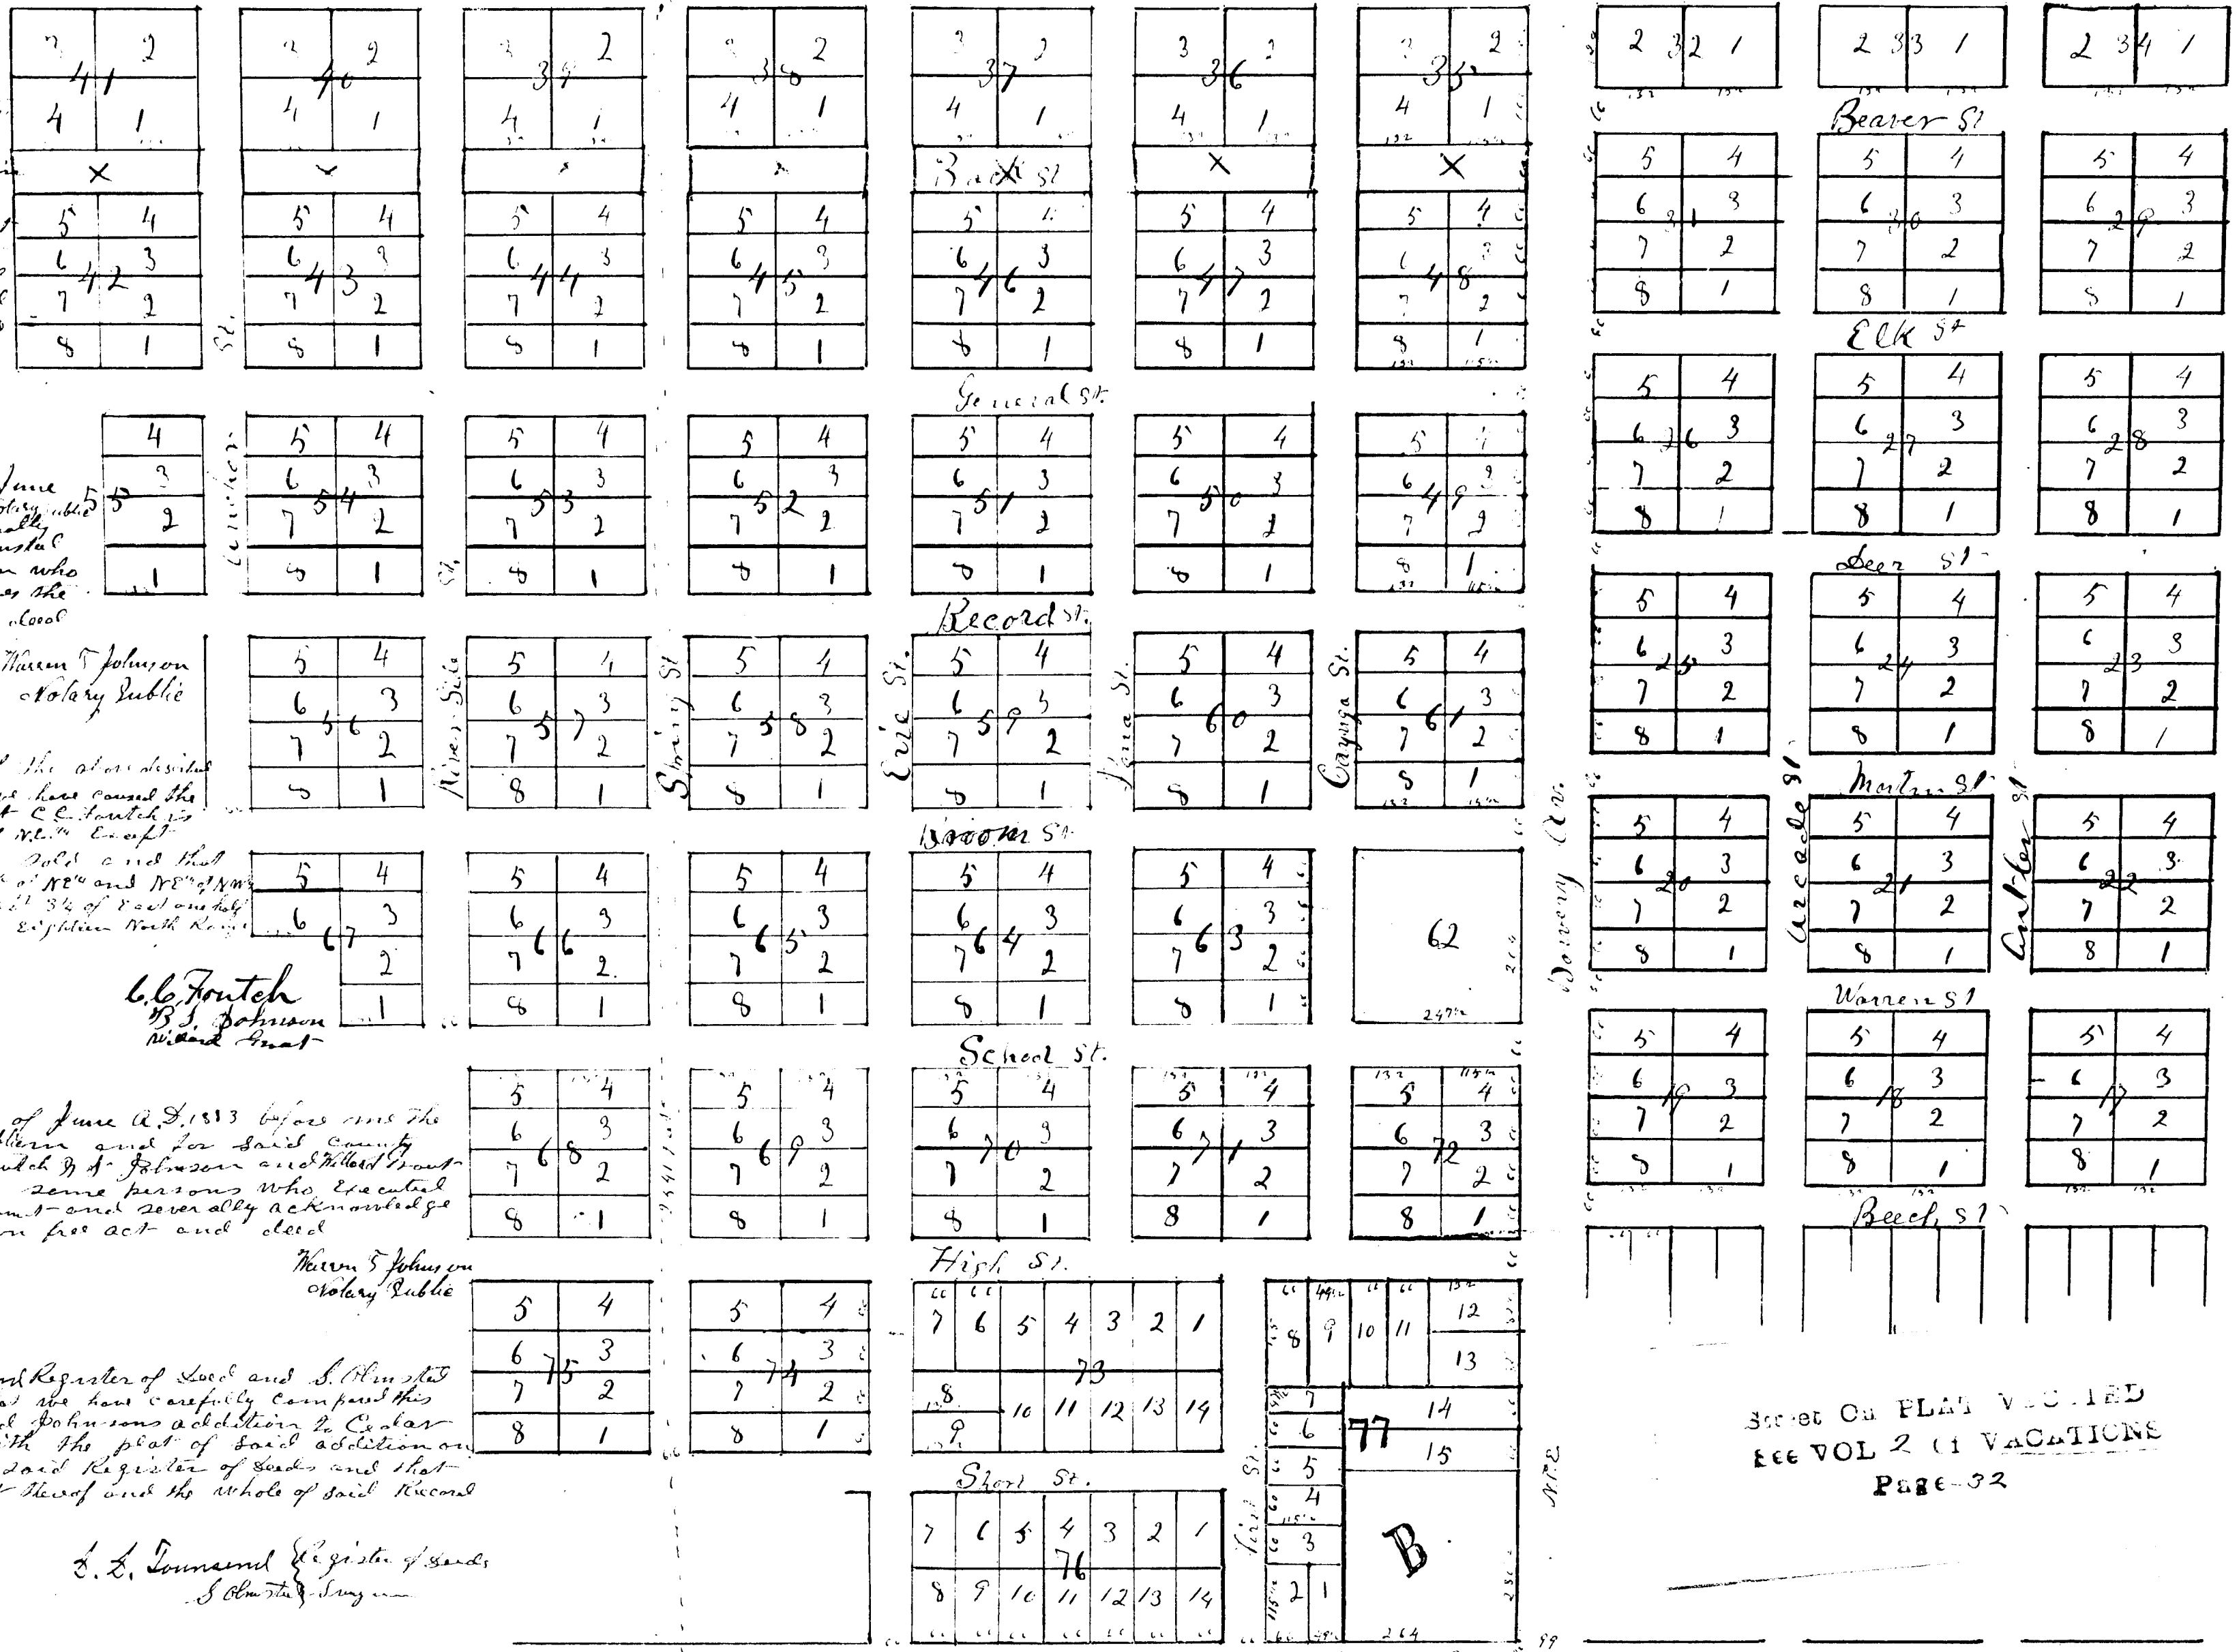

SEEK ON PLAT VACATED
 SEE VOL 2 (1 VACATIONS)
 Page 32

East of Line 19 N. R. 20. Sec. 1

13936

PLAT -GROUT, FOUCH & JOHNSON'S ADDITION CEDAR VILLAGE

In re petition)
of Warren T Johnson
and Belva S. Johnson
proceedings to alter and
amend the Plat.)


Liber 12 of Deeds
Pages 501 -502

C C Journal Liber 1 page 79

ORDERED: That the said plat be and the same is hereby
altered and ammended so as to vacate the street known and designated on said
plat, as Back Street, except where said Back Street is intersected by any Street,
on Streets, extending North and South and that the title to the land in said
Street so vacated vest in said Petitioners agreeable to the prayer thereof.

Curts & Taylor
Plat Examiners

Vol-170- Page 13936

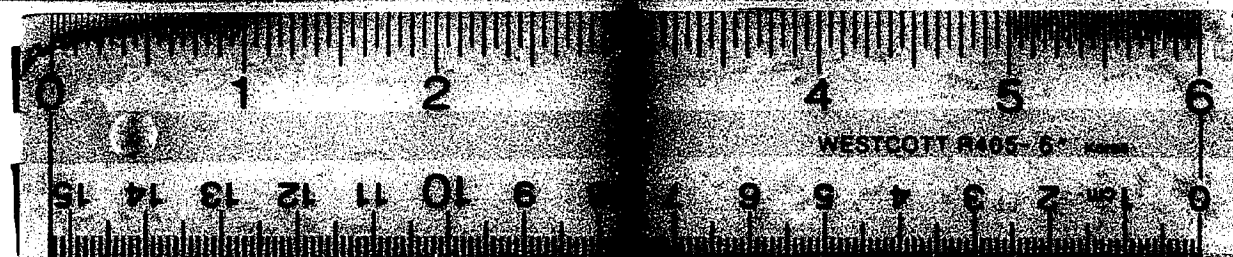

16 X