


"Exhibit A"

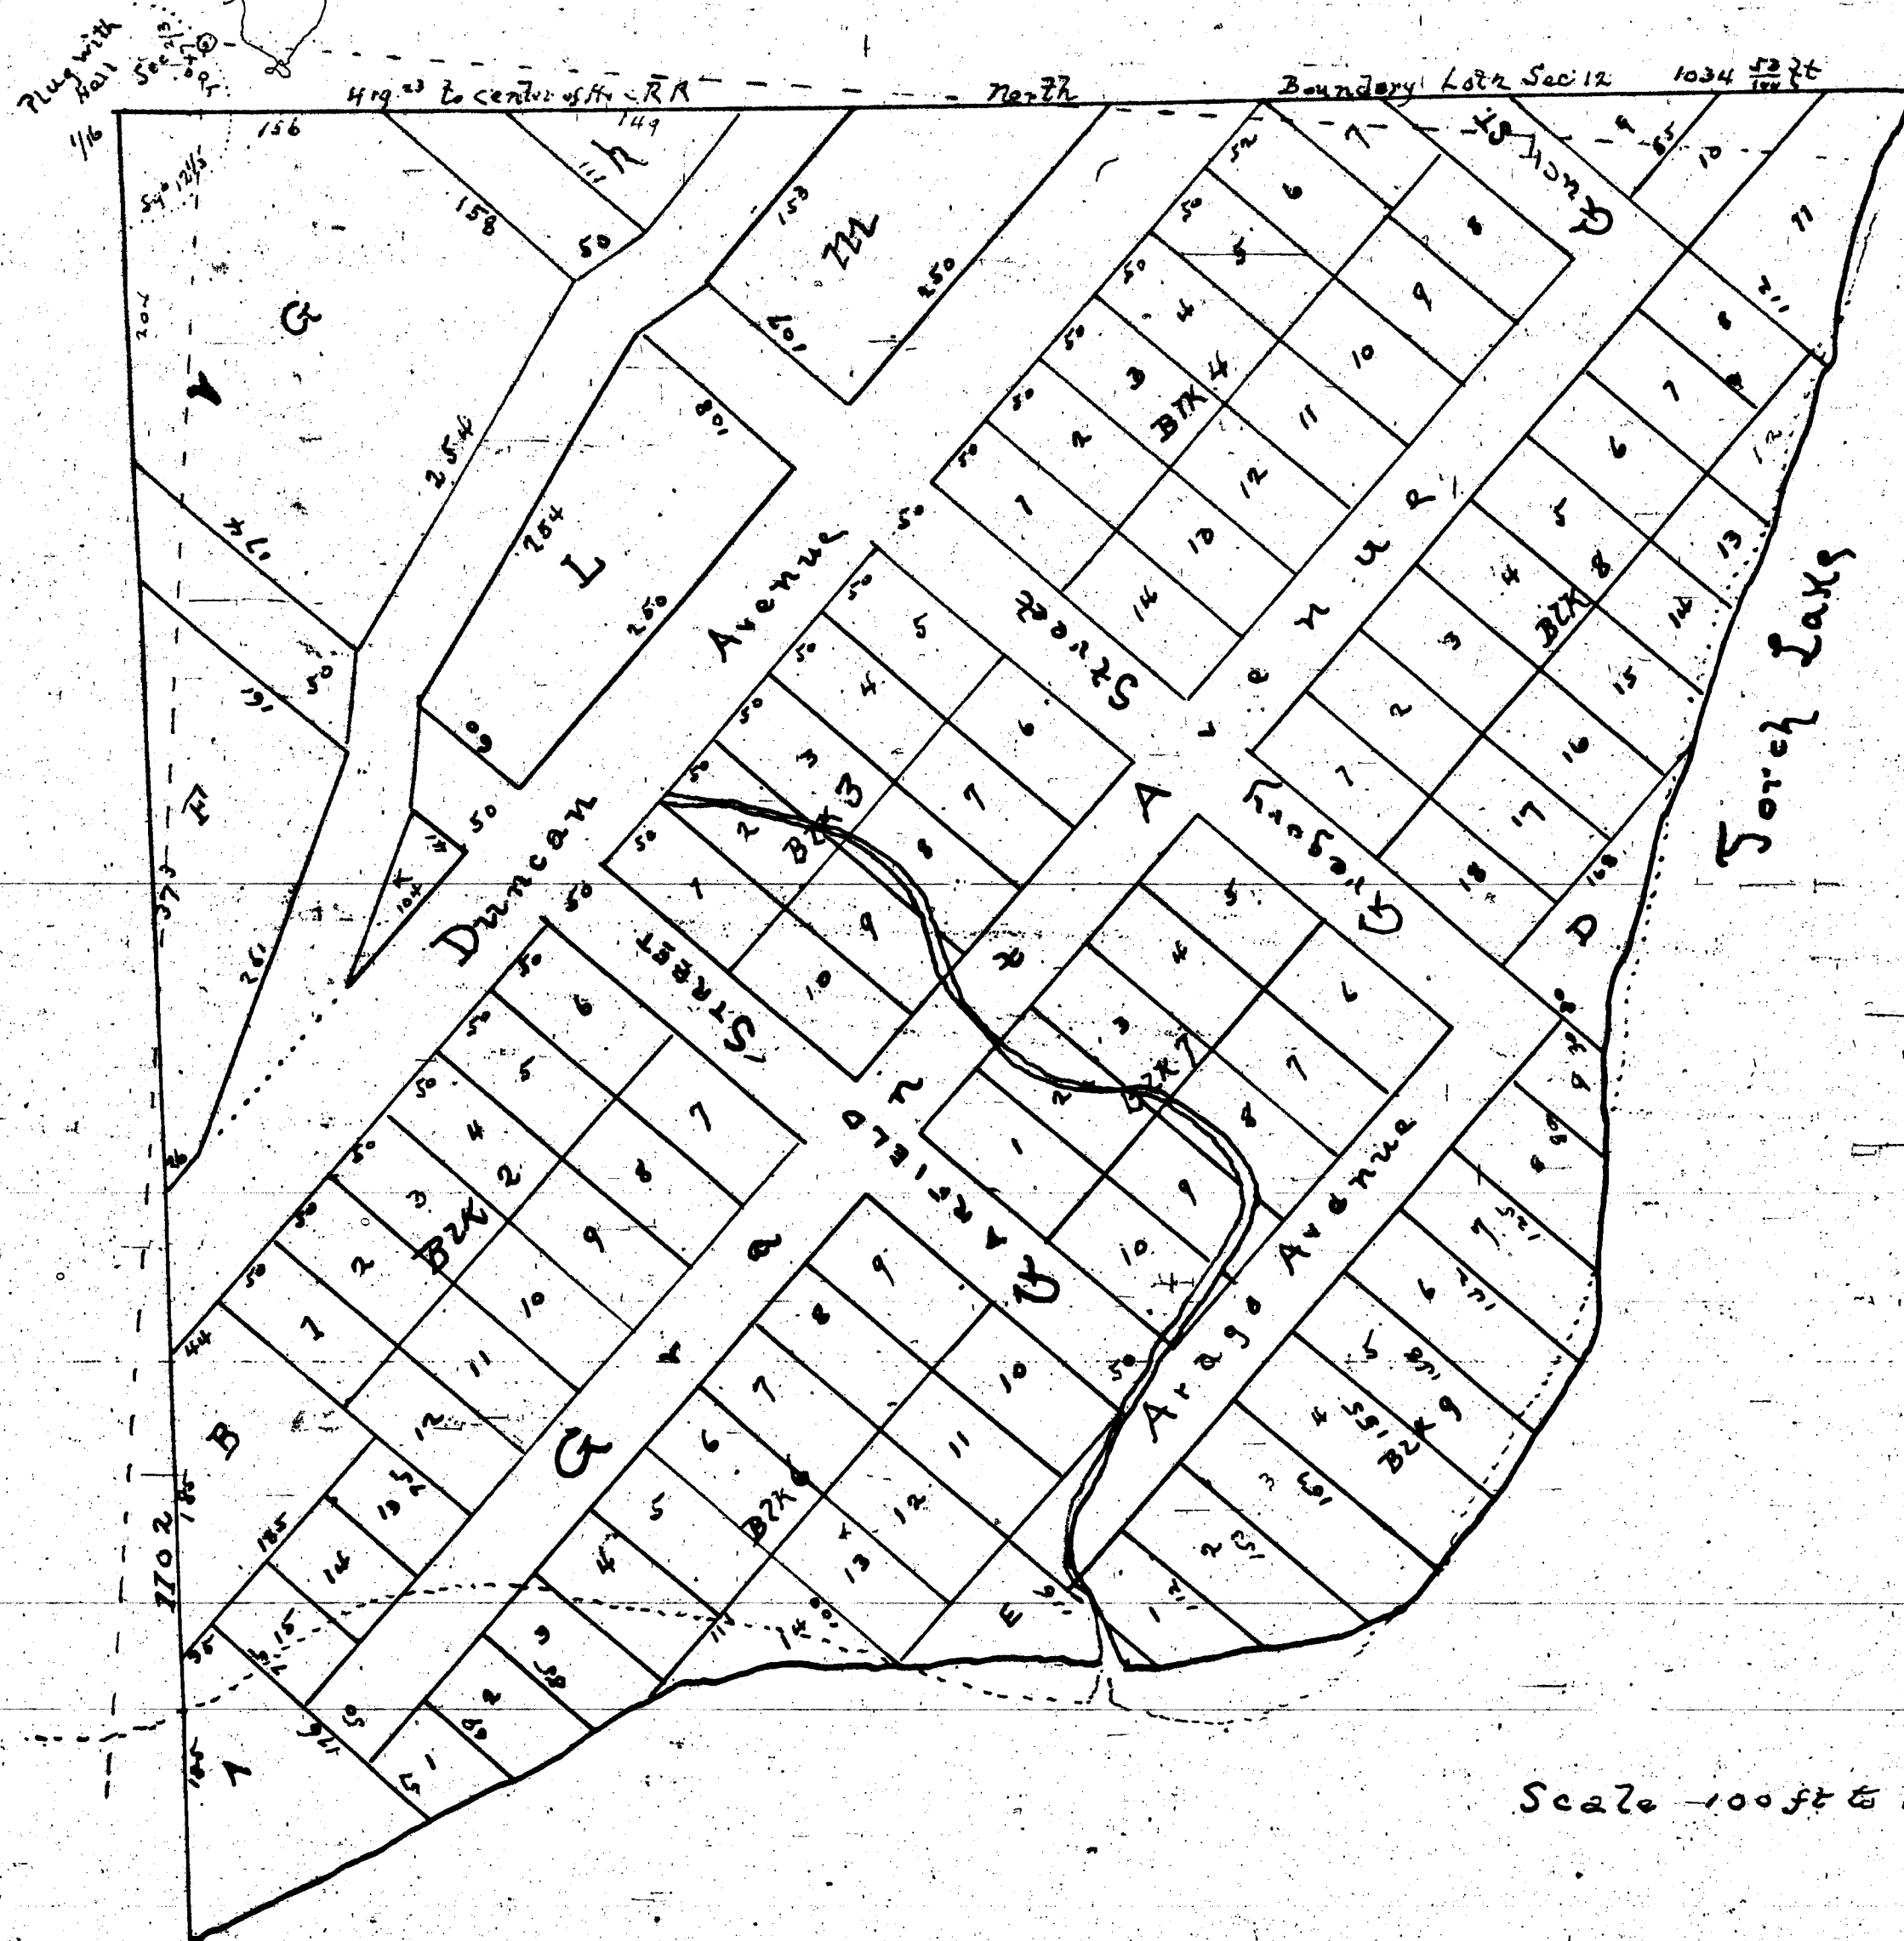

Scale 100 ft to 1 inch

Explanation

The full lines show 5222mans Location
The dotted lines show the corrected

This is a true Compared Copy of a Plat in Circuit Court file No 615 in County Clerk's Office, Houghton County, made for and by authority of Auditor General at Houghton. Witness my hand and seal this 2nd day of September 1915 by
J. S. Bennett
Plat Examiner H. S. Dept

Jas. P. Edwards, C.E.

13939


TOWN OF GROVER

Lot 2 Sec. 12 T. 55 N. R. 33 W.

"Exhibit B"




This is a true compared copy of a Map on file in the
Circuit Court of Houghton County (file No. 615)
Made for and by authority of Auditor General at Houghton
Mich. September 2, 1915, by
J. J. Bennett
Not. Public, A. G. W. ft

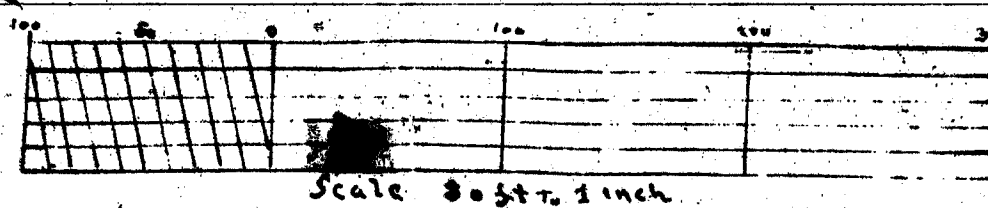

Jas P Edwards. C. E.

18757

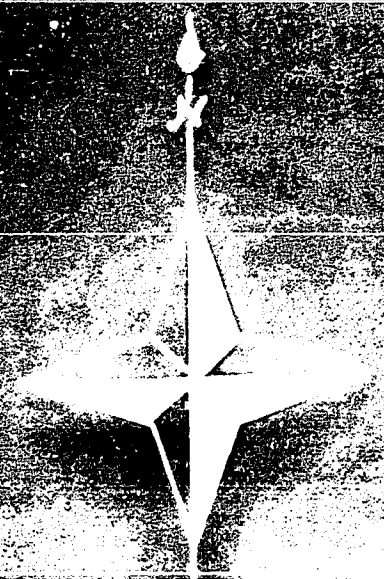

Scale - 100 ft to 1 inch

Section of the ... Plate ...

13939

