

MAP OF CENTENNIAL HEIGHTS.

Situated partly in the southwest quarter of the southwest quarter and partly in the northwest quarter of the southwest quarter of Section twelve, Township fifty-six North, Range thirty-three West.

HOUGHTON, COUNTY, MICHIGAN.

NOTE - Lot Numbers on B's K's J and K correct
see voucher 1504-1926

Note 2 - Lot 24 - Bl'k "H" Corrected - Register of Deeds - 5/22/33
V635 - 1933

STATE OF MICHIGAN
County of Houghton

William Walls Register of Deeds
Charles Chynoweth Surveyor
that we have each carefully compared the
original copy with the plat of Centennial Heights

now of record in the
is a true and correct copy of the whole of said record
William Walls Register of Deeds
Charles Chynoweth Surveyor

DESCRIPTION.

The land embraced in the annexed plat of Centennial Heights is as follows: Commencing at a point six hundred seven (607) feet north and seven hundred eighty two and three-tenths (782.3) east of south west corner post of section twelve Township 56 North Range 33 west, thence, running north 89° 41' west seven hundred fifty five (755) feet, thence north 0° 19' east nineteen hundred eighty (1980) feet, thence south 89° 41' east nine hundred six (906) feet, thence south 0° 19' west thirteen hundred twenty (1320) feet, thence north 89° 41' west one hundred fifty one (151) feet, thence south 0° 19' west six hundred sixty (660) feet to starting point.

SURVEYOR'S CERTIFICATE.

I, Charles Chynoweth, that the plat hereon delineated is a correct one and that permanent monuments consisting of iron pins have been planted at all points marked thus O as thereon shown at all angles in the boundaries of the land platted and at all intersections of the streets or of streets and alleys.

Charles Chynoweth, Eng.

DEDICATION.

Know All Men by These Presents, That the Centennial Copper Mining Company, a corporation duly organized and existing under the general mining laws of the State of Michigan, is the proprietor of the land embraced in the plat hereon drawn, that it has caused said land to be surveyed, laid out and platted by its engineer, Charles Chynoweth of Calumet Township, Houghton County, Michigan. That the plat shall be and is hereafter designated CENTENNIAL HEIGHTS, and that the streets and alleys as shown on said plat are hereby dedicated to the use of the public, provided, in case the public consents to use said streets, or any of them, for the purpose for which they are herein dedicated then, and in that case they shall revert to the above named Centennial Copper Mining Company, its successors or assigns.

In Witness Whereof, the said Centennial Copper Mining Company has caused these presents to be executed by its duly authorized Superintendent the 17th day of January, A. D. 1900.

J. H. Story
Alonso Nicholas
James Chynoweth
Attorney in fact

State of Michigan,
County of Houghton,

On this 17th day of January, A. D. 1900,
before me the undersigned, a Notary Public in and for said County, personally appeared James Chynoweth, known to me to be the attorney-in-fact of the Centennial Copper Mining Company, the proprietor of the land hereon platted, and acknowledged the execution thereof by him to be the free act and deed of said Centennial Copper Mining Company, he having been duly authorized to execute this plat by the Board of Directors of said Company.

John M. Wagner
Notary Public, Houghton County, Mich.

Examined and approved January 27th, 1900
John F. Wilkinson - Deputy Auditor General.

OFFICE OF COUNTY TREASURER,
HOUGHTON COUNTY,
HOUGHTON, MICH.
I HEREBY CERTIFY, That there are no tax liens or tax titles held by the State on the lands described within, and that there are no tax liens or titles held by individuals on the said lands, and that the taxes on said lands for the five years preceding the 27th day of Jan. 1900, are all paid, as shown by the records of this office.
Charles Chynoweth
COUNTY TREASURER.



REGISTER'S OFFICE, ss.
HOUGHTON COUNTY, MICH.
Received for record the 27th day of January, A. D., 1900, at 11 o'clock P.M. and recorded in Vol. 1 of Plats, page 191.
William Walls
REGISTER.

STATE OF MICHIGAN,
HOUGHTON COUNTY, ss.
Houghton, Mich., Jan. 27, 1900.
And I further certify that the Certificate required by Sect. 135, of Act No. 208, of the Public Acts of 1893, was presented to me at the same time said deed was presented.
William Walls
Register.

State of Michigan } ss.
County of Houghton }

RECEIVED AND
IN AUDITOR GENERAL'S OFFICE,
APR 13 - 1900
John F. Wilkinson
Deputy Auditor General.

Wm. Walls Register of Deeds and Charles Chynoweth Surveyor hereby certify that we have each carefully compared this copy with the original plat of "Centennial Heights" and that it is an exact copy thereof, and of the whole of each original map or plat.
William Walls Register of Deeds
Charles Chynoweth Surveyor
191-1900

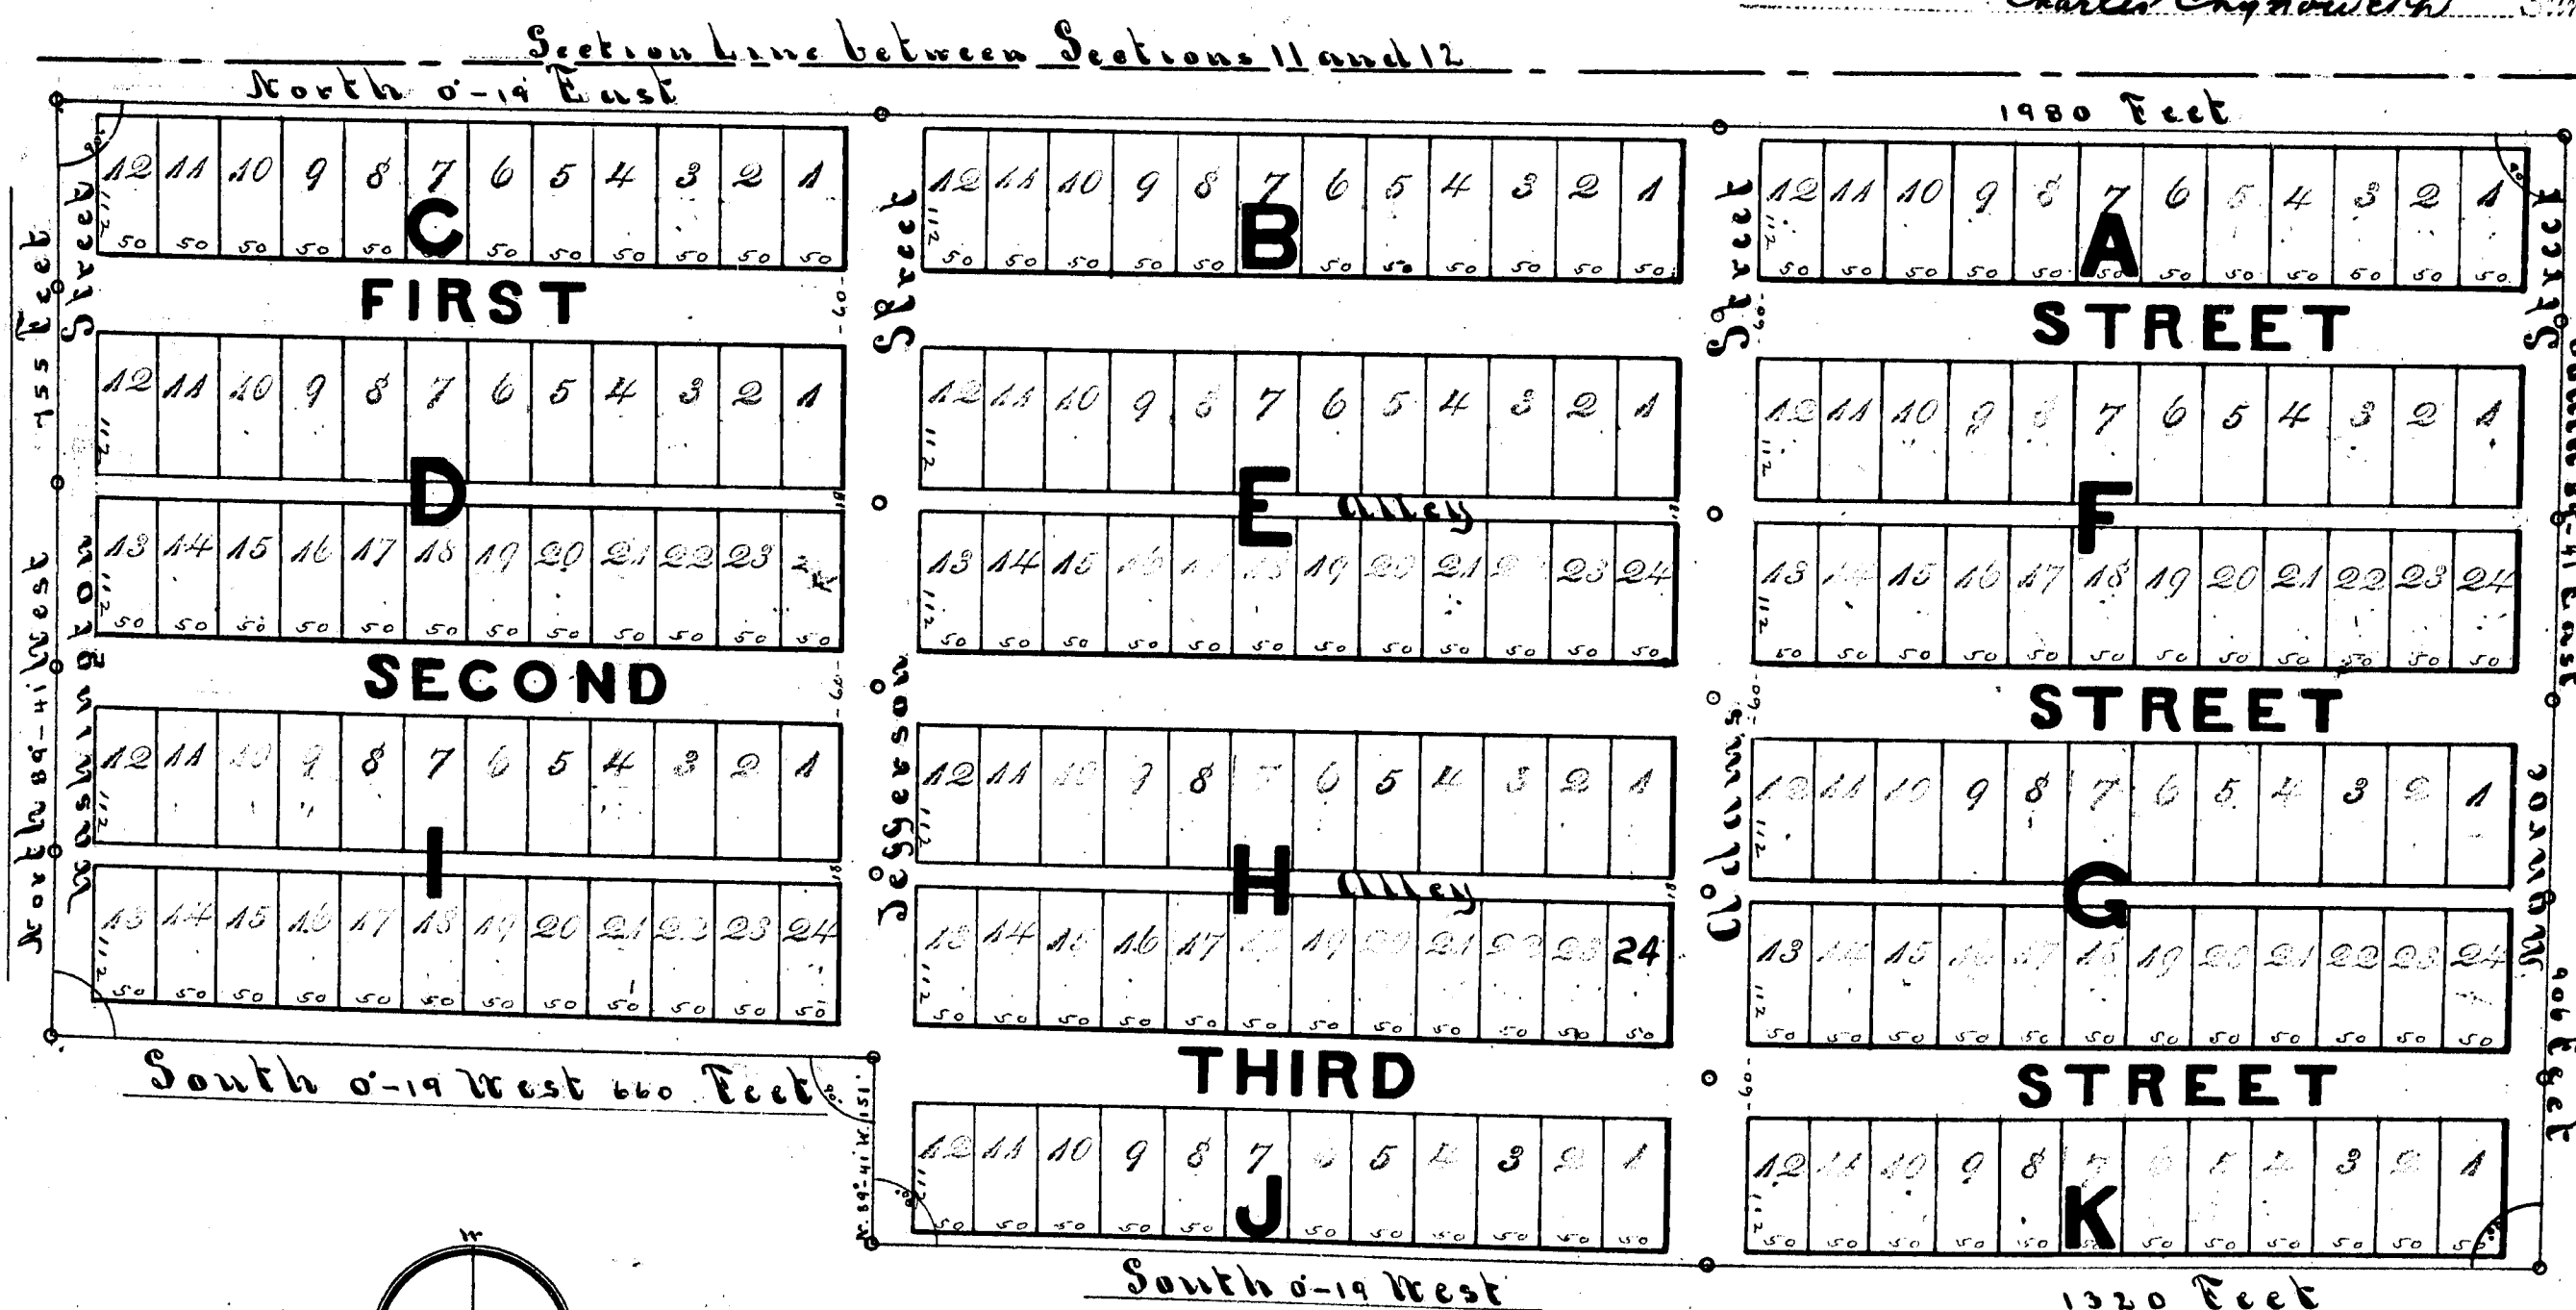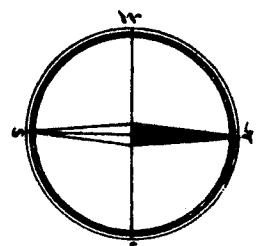

Scale 150 Feet = one inch


4821

HOUGHTON, COUNTY, MICHIGAN.

William Hall
Charles Chynoweth
that we have each carefully
copy with the flat of Centennial Heights

in the

William Wells
Charles Chynoweth

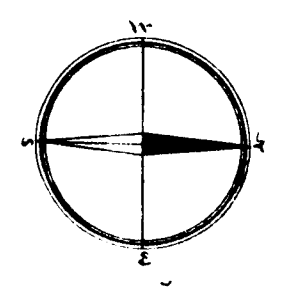

Grade 150 Feet = one man

APR 13 - 1900
John F. Williams
Sergeant and General.

Mr Wm Hall's Register of Deeds and Charles Chynoweth
Surveyor hereby certify that we have each carefully
"compared this copy with the original plat of
"Continental Heights" and that it is an exact copy
thereof, and of the whole of such original map or plat
William Hall's Register of Deeds
Charles Chynoweth. Surveyor
191-1900

The land embraced in the annexed plat of Centennial Heights is as follows: Commencing at a point six hundred seven (607) feet north and seven hundred eighty two and three-tenths (782.3) east of south west corner post of section twelve townships 56 North Range 33 west, thence, running north 89° 41' west seven hundred fifty five (755) feet, thence north 0° 19' east nineteen hundred eighty (1980) feet, thence south 89° 41' east nine hundred six (906) feet, thence south 0° 19' west thirteen hundred twenty (1320) feet, thence north 89° 41' west one hundred fifty one (151) feet, thence south 0° 19' west six hundred sixty (660) feet to starting point.

I **Hereby Certify**, that the plat hereon delineated is a correct one and that permanent monuments consisting of iron pins have been planted at all points marked thus O as thereon shown at all angles in the boundaries of the land platted and at all intersections of the streets or of streets and alleys.

Charles Chynoweth Esq

Know All Men by These Presents, That the Centennial Copper Mining Company, a corporation duly organized and existing under the general mining laws of the State of Michigan, is the proprietor of the land embraced in the plat hereon drawn, that it has caused said land to be surveyed, laid out and platted by its engineer, Charles Chynoweth of Calumet Township, Houghton County, Michigan. That the plat shall be and is hereafter designated CENTENNIAL HEIGHTS, and that the streets and alleys as shown on said plat are hereby dedicated to the use of the public, provided, in case the public ceases to use said streets, or any of them, for the purpose for which they are herein dedicated then, and in that case they shall revert to the above named Centennial Copper Mining Company, its successors or assigns.

In Witness Whereof, the said Centennial Copper Mining Company has caused these presents to be executed by its duly authorized Superintendent the 17th day of January, 1900, A. D. 1900.

Y. H. Spry
Along Nicholas

State of Michigan, } ss.
County of Houghton,
On this 17th day of January A. D. 1908
before me the undersigned, a Notary Public in and for said County, personally appeared James Chynoweth, known to me to be the ~~owner~~ attorney-in-fact of the Centennial Copper Mining Company, the proprietor of the land herein platted, and acknowledged the execution thereof by him to be the free act and deed of said Centennial Copper Mining Company, he having been duly authorized to execute this plat by the Board of Directors of said Company.

John M Wagner
Notary Public, Houghton County, Mich

Examined and approved January 27th, 1900
John F. Wilkinson. Deputy Auditor General.

OFFICE OF COUNTY TREASURER,
HOUGHTON COUNTY.
HOUGHTON, MICH. *Jan 29, 1900*

I HEREBY CERTIFY, That there are *Two* tax
liens or tax titles held by the State on the lands
described within, and that there are *Two* tax
liens or titles held by individuals on the said lands,
and that the taxes on said lands for the five years
preceding the *27* day of *Jan* *1900*
are paid, as shown by the records of this
County.

George W. Moore
COUNTY TREASURER.

REGISTER'S OFFICE, } SS.
HOUGHTON COUNTY, MICH.
Received for record the 24th day
of January, A. D., 1906, at 4
o'clock P.M. and recorded in Vol
1 of Book page 121
William Starks
REGISTER

STATE OF MICHIGAN, } ss.
HOUGHTON COUNTY, }
Houghton, Mich., Jan. 19 1902
And I further certify that the Certificate
required by Sect. 135, of Act No. 206,
of the Public Acts of 1893, was pre-
sented to me at the same time said deed
was presented.
W. C. Carr Stall
Register