

WITH A NEW

SUBDIVISION OF

J. FRASER'S OUTLOTS
TO LOWER 6 AGAIN NW


SURVEYED DRAWN

MEACERBONBAR

1867

SCALE TWO HUNDRED FEET TO AN INCH

ADDITION TO LOWER SECTION

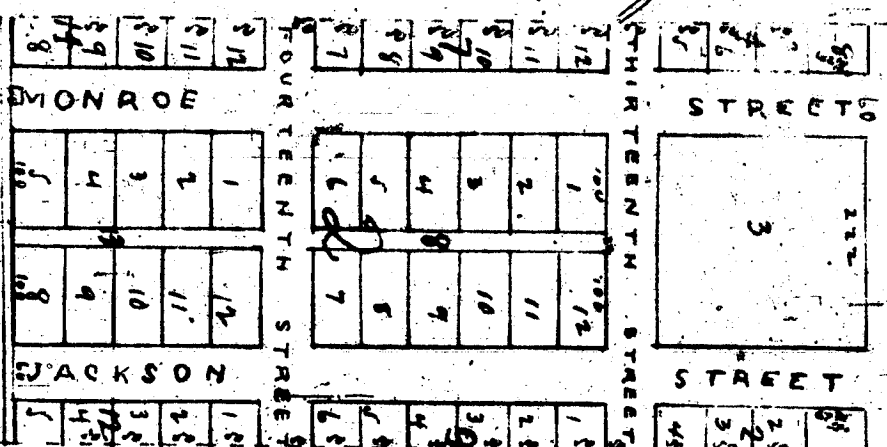

LOGHE
3 aens

[illegible]

Republic of Texas
 Bay County
 Received and Remitted here
 at 6 O'clock P.M.
 Bay Co. Jail
 Friday 9 June 20 1868
 Remitted to County Jail
 over Bay Co. Jail

we haven't seen this is a true and
compared copy of a plant on island.

Region of Snowy Plover County
including - dropped from 1910-1911
the distribution of the Audubon's sp.

Q. Cuts
Value 1000000
Cuts and - 3000000

Description of Peat

[illegible][illegible][illegible]

affidavit of living on

John Jay
Notary Public
Bay Co. Ind.

[illegible]

CITY OF BAY CITY, MICH.
OFFICE OF CITY CLERK

(AFFIDAVIT)

RECORDED

14217

STATE OF MICHIGAN

COUNTY OF BAY
CITY OF BAY CITYI, Walter Wozniak, Jr. Clerk of the City of BayCity, County and State aforesaid, Do hereby Certify, that I have compared the
annexed excerpt from the regular meeting of the City Commission held September
5, 1972with the original on file in this office and that it is a true and correct
transcript therefrom and of the whole of such original.In Witness Whereof, I have hereunto set my hand affixed the
Corporate Seal of the City of Bay City, Mich., this**SPECIAL ORDER**

Of Commission as a Whole:

Whereas, Duane P. Campbell and 8 others on June 19, 1972, petitioned this commission to close the alley between 14th, 15th, Monroe and Jackson Streets, as set forth in said petition;

And Whereas, the planning commission recommended that same be closed and vacated;

And Whereas, it appears that the closing and vacating thereof would constitute an improvement and advantage to both the city and the adjacent property owners;

And Whereas, a resolution was adopted by the city commission on August 7, 1972, ordering publication of notices and holding of a hearing; said notices having been published in the Bay City Democrat, the official newspaper of the City of Bay City, on August 10, 17, 24 and 31, 1972, relative to the aforesaid hearing; and certified notice thereof having been mailed to the railroads and public utilities and to the abutting property owners;

And Whereas, a public hearing was held by the city commission on September 5, 1972, relative to the aforesaid petition for said closing;

26th day of September 1972

Walter Wozniak Jr.
City Clerk

Now, Therefore, Be It Resolved and Ordered, by the City Commission that the alley between 14, 15, Monroe and Jackson Streets be and the same is hereby closed and vacated with all utility easements being retained and on condition that no permanent buildings or structures be erected, and on further condition that any fences erected thereon shall be removed at the property owners expense if and when ordered by the City of Bay City.

RULES SUSPENDED

Commissioner Meagher moved that rules be suspended to allow any interested persons to speak. There was no objection. No one appeared.

Commissioner Meagher moved for adoption of the resolution. Adopted unanimously.