

MAP

4737


JOSEPH TROMBLES

addition to the Village of

BANKS

(Mich)

Scale 200 ft to an inch

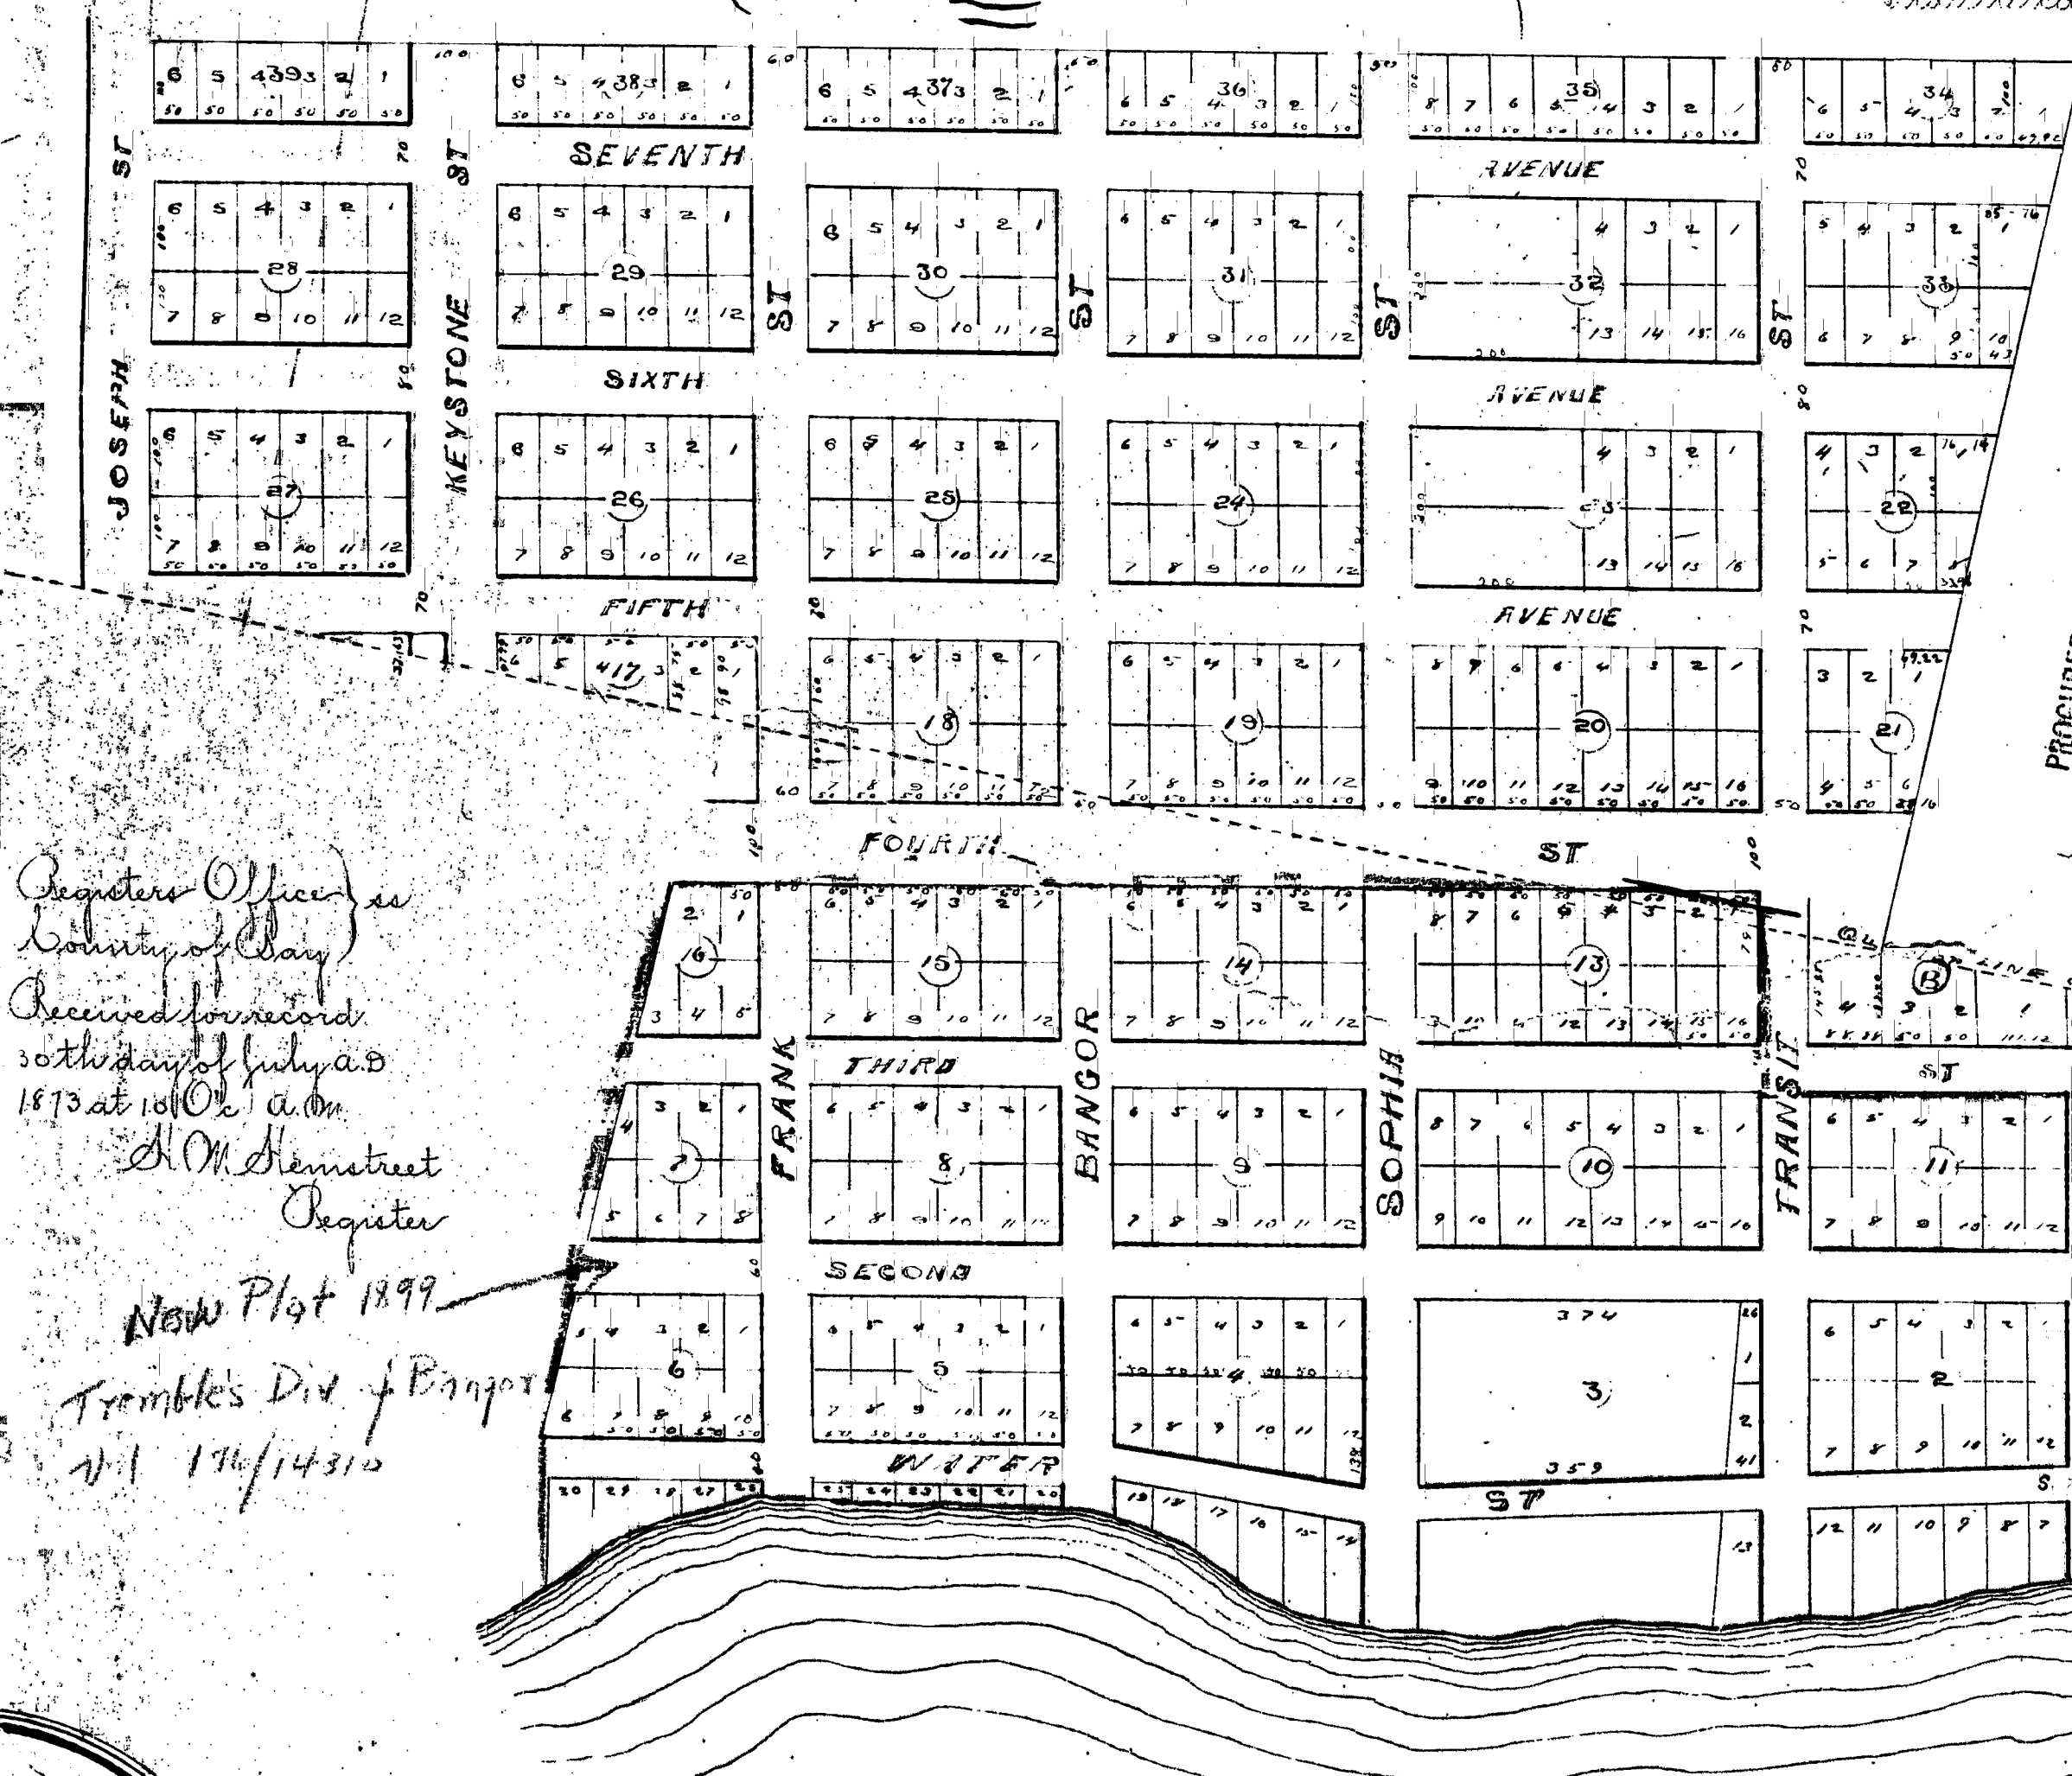

Registers Office
County of Bay
Received for record
30th day of July A.D.
1893 at 10 O'Clock A.M.
H.M. Hemstreet
Register

New Plot 1899
Tromble's Div. of Bangor
11/17/14310

Note: Those two East and West lines passing through a Block 13
show the old and new surveys.
The blue dotted line represents the new and corrected one.

State of Michigan }
County of Bay }
I, Joseph Trombles, do hereby certify that I have
carefully compared the foregoing copy of plat with the
original record of the same in this office, and that the
same is a true and correct copy of the original
record, and of the whole thereof. Witness my hand
and official seal this 29th day of July A.D. 1893.

W.H. Hemstreet
Notary Public

On the 29th day of July A.D. 1893 before me a Notary Public and for said
County of Bay personally appeared Joseph Trombles, who is known to me to be the same person
who executed and acknowledged the above acknowledged plat, and who acknowledged that he executed the same for the purposes and uses herein named, expressed and
intended, and for no other use or purpose whatever, and that the same was his free act and deed, and that the said map or plat
recorded according to law. I in testimony whereof I have hereunto set my hand and seal this
29th day of July A.D. 1893.

PROCESSED AND FILED
IN AUDITOR GENERAL'S OFFICE
Oct. 7 1893
Auditor General

Lot Numbers
Added per
Voucher 12/1/93

I know all men by these presents that I, J.M. Johnston, Bay City, Michigan, on the application and request of Joseph Trombles, proprietor of the land described in this map of Joseph Trombles' addition to the Village of Banks, Michigan, did in the month of July A.D. 1893 make a survey of said land, the particulars of which survey are given in this map or plat, and that the survey was made by me for the purposes and uses herein named, expressed and intended, and for no other use or purpose whatever, that the same was my free act and deed, and that the said map is correct to the best of my knowledge and belief. In testimony whereof I have hereunto set my hand and seal this 29th day of July A.D. 1893.

In presence of
W.H. Hemstreet
Notary Public

J.M. Johnston
Surveyor

State of Michigan }
County of Bay }
On the 29th day of July A.D. 1893 before me a Notary Public and for said County of Bay personally appeared J.M. Johnston, Surveyor, who is known to me to be the same person who signed and executed the above acknowledged and acknowledged that he executed the same for the purposes and uses therein named, expressed and intended, and for no other use or purpose whatever, and that the same was his free act and deed, and that the said J.M. Johnston further acknowledged that he is a surveyor, and that he made said survey in said capacity, and I further certify that I know said J.M. Johnston to be such a surveyor. In testimony whereof I have hereunto set my hand and official seal this 29th day of July A.D. 1893.

W.H. Hemstreet
Notary Public
Bay Co. Mich
I, John Boston, Register of Deeds for Bay Co. Mich, do hereby certify that I have carefully compared the foregoing copy of plat with the original record of the same in this office, and that the same is a true and correct copy of the original record, and of the whole thereof. Witness my hand and official seal this 29th day of July A.D. 1893.

14219

CITY OF BAY CITY, MICH.
OFFICE OF CITY CLERK
(AFFIDAVIT)

STATE OF MICHIGAN

COUNTY OF BAY
CITY OF BAY CITY

Emm. G. Hickey
REG. CLERK OF BAY CITY
BAY COUNTY, MICH.

Bay
14219

I, Walter Wozniak, Jr. Clerk of the City of Bay

City, County and State aforesaid, Do hereby Certify, that I have compared the
annexed excerpt from the regular meeting of the City Commission held on
August 20, 1973

with the original on file in this office and that it is a true and correct
transcript therefrom and of the whole of such original.

Commission as a Whole:
Whereas, Mr. and Mrs. Earl Bran-
on June 4, 1973, petitioned this
mission to close a portion of
stone Street which runs north-
from Smith Street for 100 feet,
set forth in said petition, and
Whereas, the Planning Commission
recommended that same be closed
vacated, and
Whereas, it appears that the clos-
and vacating thereof would con-
te an improvement and advant-
to both the city and the adjacent
erty owners, and
Whereas, a resolution was adopted
the city commission on July 23,
ordering publication of notices
holding of a hearing, said notic-
having been published in the Bay
Democrat, the official news-
er of the City of Bay City, on
23, August 2, 9 and 16, 1973,
relative to the aforesaid hearing and
ified notice thereof having been
lled to the railroads and public
ities and to the abutting property
ners, and
Whereas, a public hearing was
d by the city commission on Aug-
20, 1973, relative to the aforesaid
ition for said vacation,
Now, Therefore, Be It Resolved
Ordered, by the city commission
t Keystone Street northerly from
ith Street for one hundred (100)
be and the same is hereby clos-
and vacated with the city reserv-
unto itself all public utility rights
an easement for public utilities

In Witness Whereof, I have hereunto set my hand affixed the
Corporate Seal of the City of Bay City, Mich., this

29th day of August 19 73

Walter Wozniak Jr.

City Clerk

and on condition that no structures
including garages be constructed
within the area and further that any
fences erected be removed at the
owners' expense if and when ordered
by the city.

RULES SUSPENDED

Commissioner Voisine moved that
rules be suspended and a Public Hear-
ing be held to permit interested per-
sons to be heard. There was no obj-
ection.

Mr. Bert Braun, Business Mana-
ger of the Bay City Public Schools,
mentioned that the street abuts
Board of Education property and as
it is not known what the property
may be used for in the future on
behalf of the School Board he asked
that the street not be closed.

Commissioner Voisine moved for
adoption of the resolution.

Adopted by the following vote:

Yes: Commissioners Janikens, Pow-
ers, Meagher, Timm, Compau, Will-
ertz, Voisine 7. No: Commissioners
Fenton, Neveu, 2.