

Affidavit of Proprietors
 Know all men by these presents, that we, Louis Gaselmeier, John Kohler & Frederick Hanning, of Bay County, State of Michigan, in the County of Bay, do hereby certify that the plat, map, plan, and survey, and said map or plat to be made, by William Meyer, Civil Engineer and Surveyor, of Bay City, Bay County, State of Michigan, for the purpose of laying out and an addition to the City of Bay City, State of Michigan, known as the "First Addition to the City of Bay City," and by virtue of Chapter 28 of the Compiled Laws of Michigan, and the amendments thereto, approved and published, and for no other use or purpose whatever; and that the same is our free act and deed.
 In testimony whereof we have hereunto set our hands and seals the 24th day of June A.D. 1873.
 In presence of:
 H. H. Hemstreet
 Frank Remington. Frederick Hanning.

State of Michigan
County of Bay
 ss. On the 24th day of June A.D. 1873 before me, a Notary Public in and for said County, personally appeared Louis Gaselmeier, John Kohler & Frederick Hanning, known to me to be the same persons who signed and set out the above as true and correct, and the proprietors of the land described in this plat, and acknowledged to me that they were the free act and deed.
 In testimony whereof I have hereunto set my hand and official seal the 24th day of June A.D. 1873.
 H. H. Hemstreet
 Notary Public
 Bay Co. Mich.

VACATED BY RESOLUTION
 OF CITY COUNCIL
 OCT. 7, 1894
 VOLUME 1 No. 231-49

MAP
 of
ZAGELMEYER & CO'S

FIRST ADDITION

WENONA
 Now Part of West Bay City
MICH.


Received and filed
 in Auditor General's
 Office November 28, 1873
 H. R. Pratt
 Dep. Aud. Genl.

Affidavit of Surveyor
 Know all men by these presents, that I, William Meyer, Civil Engineer and Surveyor, residing in Bay City, Bay County, State of Michigan, on the application and request of Louis Gaselmeier, John Kohler and Frederick Hanning, proprietors of the land described in the plat did at the request of the City of Bay City, State of Michigan, lay out and set out an addition to the City of Bay City, State of Michigan, known as the "First Addition to the City of Bay City," and by virtue of Chapter 28 of the Compiled Laws of Michigan, and the amendments thereto, approved and published, and for no other use or purpose whatever; and that the same is my free act and deed.
 In testimony whereof I have hereunto set my hand and official seal the 24th day of June A.D. 1873.
 In presence of:
 H. H. Hemstreet
 Frank Remington.

State of Michigan
County of Bay
 ss. On the 24th day of June A.D. 1873 before me, a Notary Public in and for said County, personally appeared William Meyer, Civil Engineer and Surveyor, known to me to be the same person who signed and set out the above as true and correct, and the surveyor of the land described in this plat, and acknowledged to me that they were the free act and deed.
 In testimony whereof I have hereunto set my hand and official seal the 24th day of June A.D. 1873.
 H. H. Hemstreet
 Notary Public
 Bay Co. Mich.

Description
 The land embraced in this plat is composed of the West half of the North East quarter of the West quarter of Section 10, Township 23 N., Range 17 E., 1st Meridian, in the County of Bay, State of Michigan.

In the undersigned, Harvey M. Hemstreet, Register of Deeds of Bay County, State of Michigan, and William Meyer, Civil Engineer and Surveyor of Bay City, Bay County, State of Michigan, do hereby certify that in their case fully compared this map or plat with the original and find that the same is an exact copy of the survey of said original map or plat.
 H. M. Hemstreet
 Register of Deeds
 William Meyer
 C. E. & L.

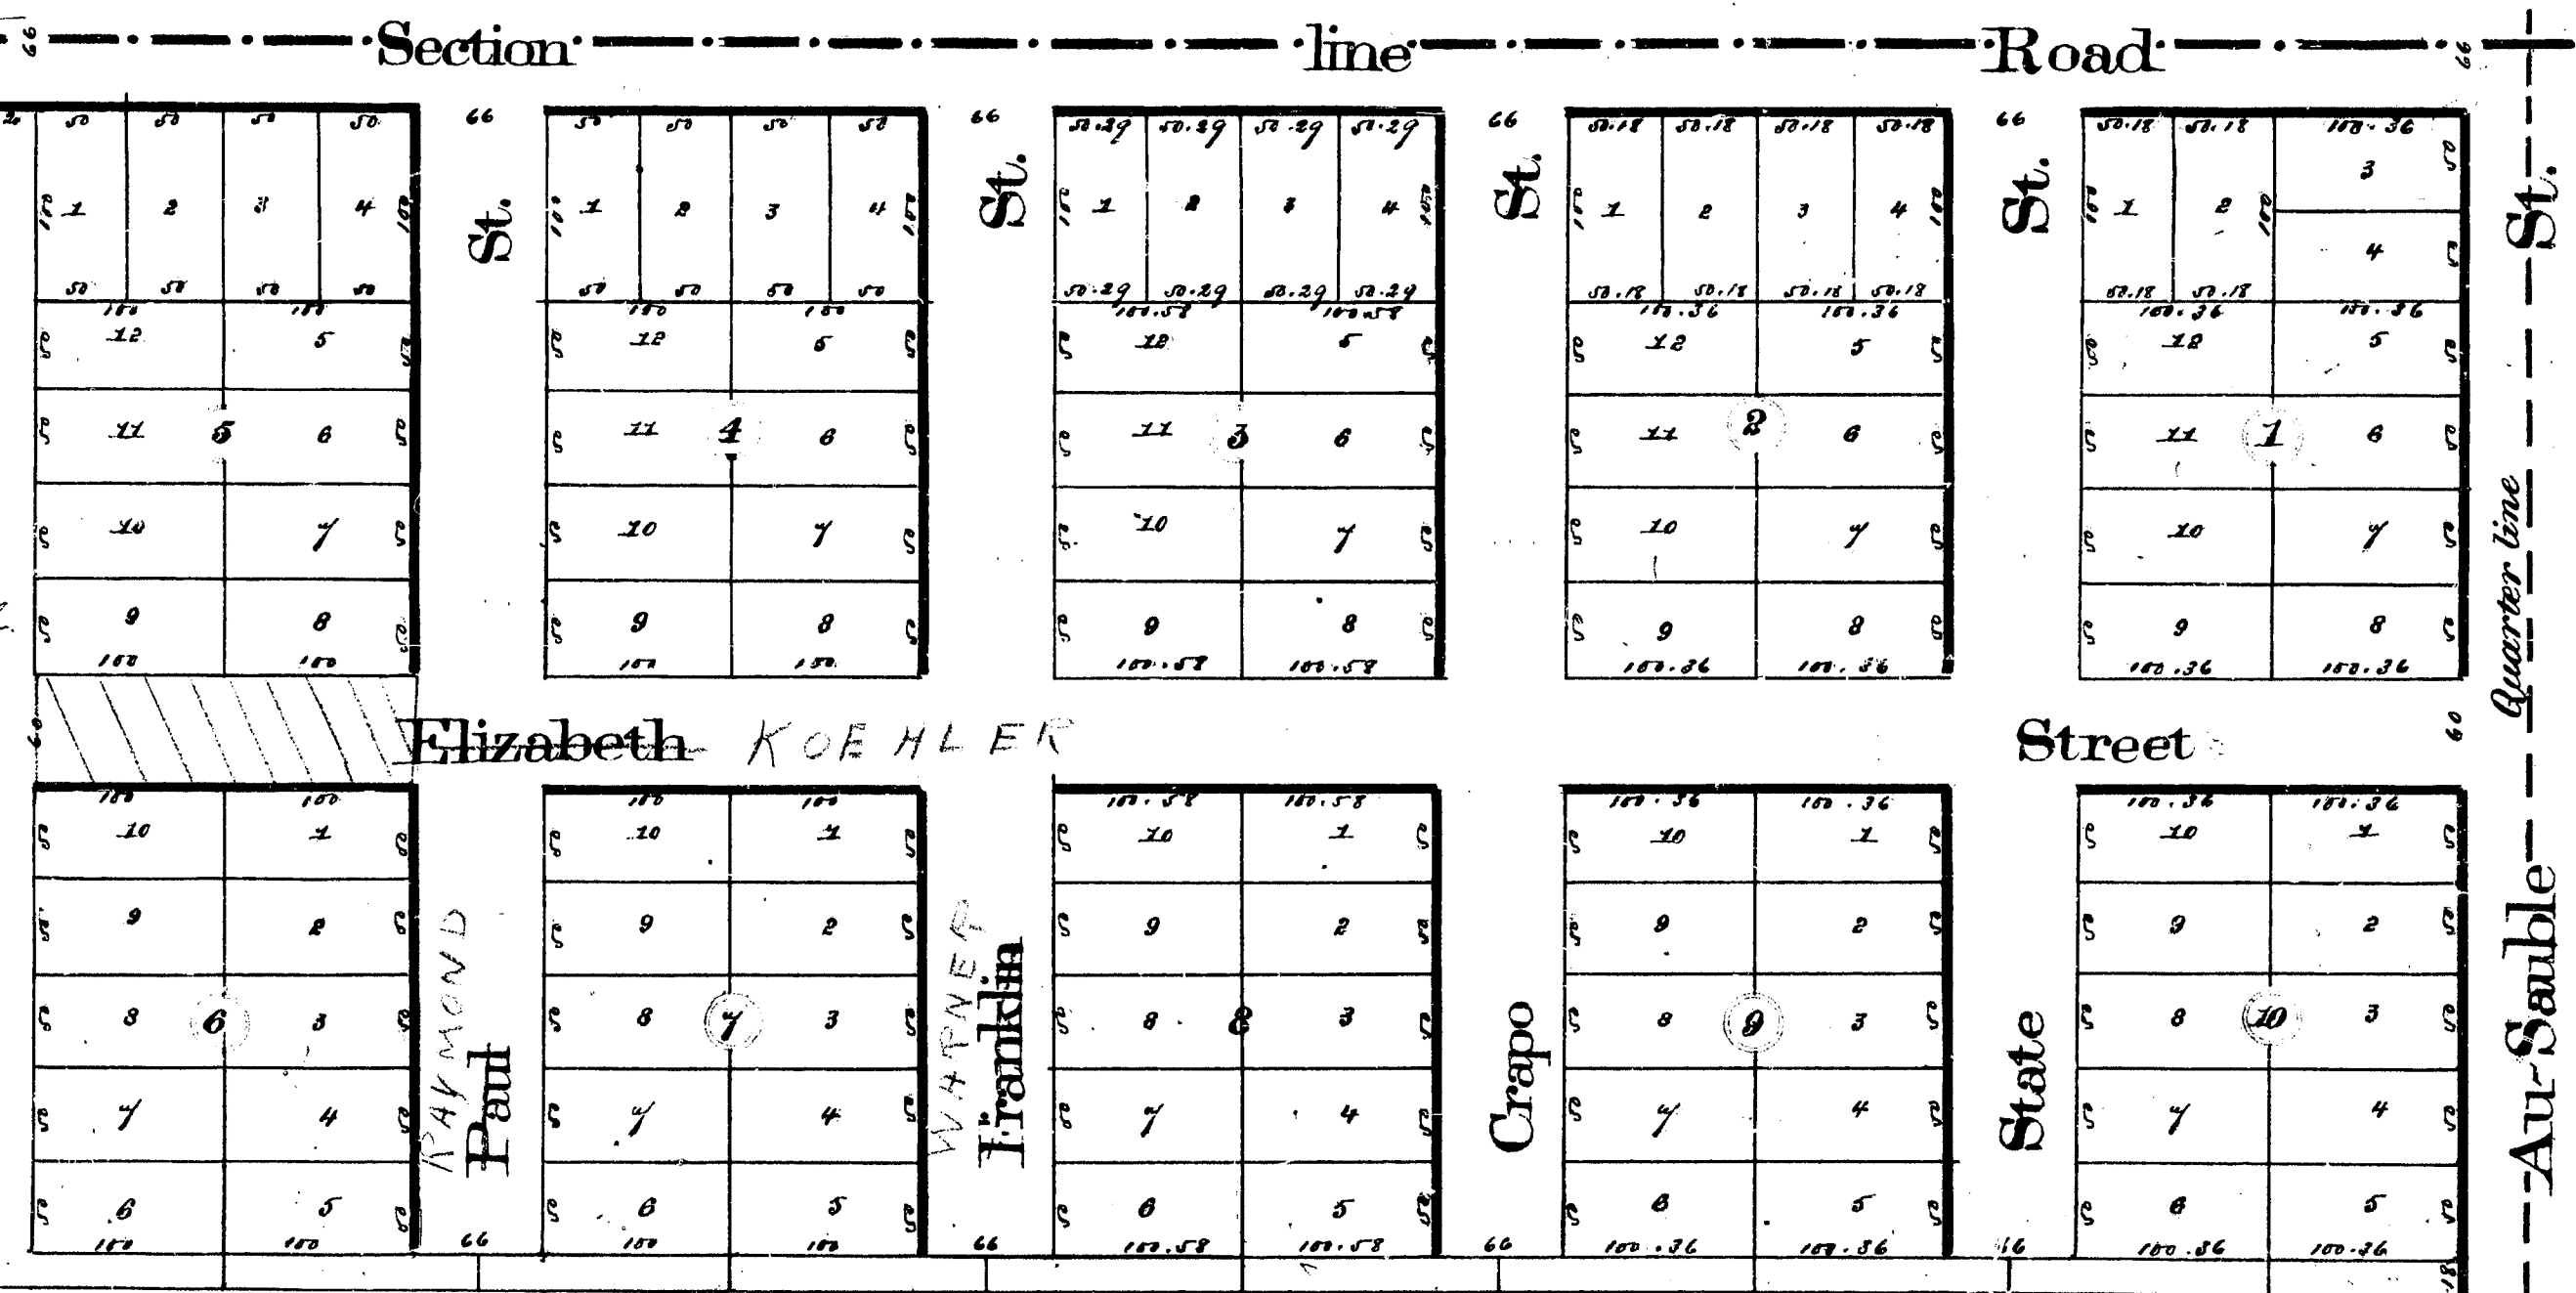

Scale 100 feet to an inch

Register of Deeds
 Bay County
 Received for Record
 25th November 1873
 at 2 o'clock P.M.
 H. M. Hemstreet Register
 WM. MERCER C. E. & S. BAY CITY MICH.

Affidavit of Proprietors

Know all men by these presents that we, Louis Ziegelmeier, John Tobler & Frederick Hamann, of Bay County, State of Michigan, are the proprietors of the land described in the plat, and that we caused said land to be surveyed and laid out as follows to be made by William Meyer, Civil Engineer and Surveyor, of Bay City, Bay County, State of Michigan, for the purpose of laying out an addition to the City of Bay City, and adding to the same, high and low water, and by virtue of Chapter 28 of the Compiled Laws, and the amendments thereto, now in force, and of the plat, and the same for the purpose of laying out said plat, and the same, and for no other use or purpose whatever; and that the same is now for sale and lease.

On testimony whereof we have hereunto set our hands and seals the 20th day of June, A.D. 1873.

In presence of:
 J. H. Hamann
 Louis Ziegelmeier
 John Tobler
 Frederick Hamann

State of Michigan
County of Bay
 ss. On the 20th day of June, A.D. 1873 before me, a Notary Public in and for said County, personally appeared Louis Ziegelmeier, John Tobler & Frederick Hamann, known to me to be the same persons who signed and executed the above affidavit, and they acknowledged to me the same as their own act and deed, and that the same was for sale and lease, and that said plat is now for sale and lease.

In testimony whereof I have hereunto set my hand and official seal the 20th day of June, A.D. 1873.

Notary Public
 Chas. L. Dick

Affidavit of Surveyor
 Know all men by these presents that I, William Meyer, Civil Engineer and Surveyor, residing in Bay City, Bay County, State of Michigan, on the application and request of Louis Ziegelmeier, John Tobler and Frederick Hamann, proprietors of the land described in the plat, did on the 20th day of June, A.D. 1873, survey and lay out said land into an addition to the City of Bay City, and the same, and by virtue of Chapter 28 of the Compiled Laws, and the amendments thereto, now in force, and of the plat, and the same for the purpose of laying out said plat, and the same, and for no other use or purpose whatever; and that the same is now for sale and lease.

On testimony whereof I have hereunto set my hand and official seal the 20th day of June, A.D. 1873.

In presence of:
 J. H. Hamann
 Louis Ziegelmeier
 John Tobler
 Frederick Hamann

Notary Public
 Chas. L. Dick

State of Michigan
County of Bay
 ss. On the 20th day of June, A.D. 1873 before me, a Notary Public in and for said County, personally appeared Louis Ziegelmeier, John Tobler and Frederick Hamann, known to me to be the same persons who signed and executed the above affidavit, and they acknowledged to me the same as their own act and deed, and that the same was for sale and lease, and that said plat is now for sale and lease.

On testimony whereof I have hereunto set my hand and official seal the 20th day of June, A.D. 1873.

Notary Public
 Chas. L. Dick

Description
 The land embraced in this plat is composed of the West half of the North East quarter of the North West quarter of Section 10, Township 36 North (14) Range 5 West, in the County of Bay, State of Michigan.

In the undersigned, Henry H. Hamann, Register of Deeds of Bay County, State of Michigan, do hereby certify that on this day fully compared the map to this plat with the original map, and find that the same is a true and correct copy of said original map or plat.

Notary Public
 Chas. L. Dick

MAP


ZAGELMEYER AND CO'S

FIRST ADDITION

WENONA

Now in West Bay City
MICH.

Received and filed
 in Auditor General's
 Office November 28, 1873
 H. R. Pratt
 Dep. Aud. Genl.

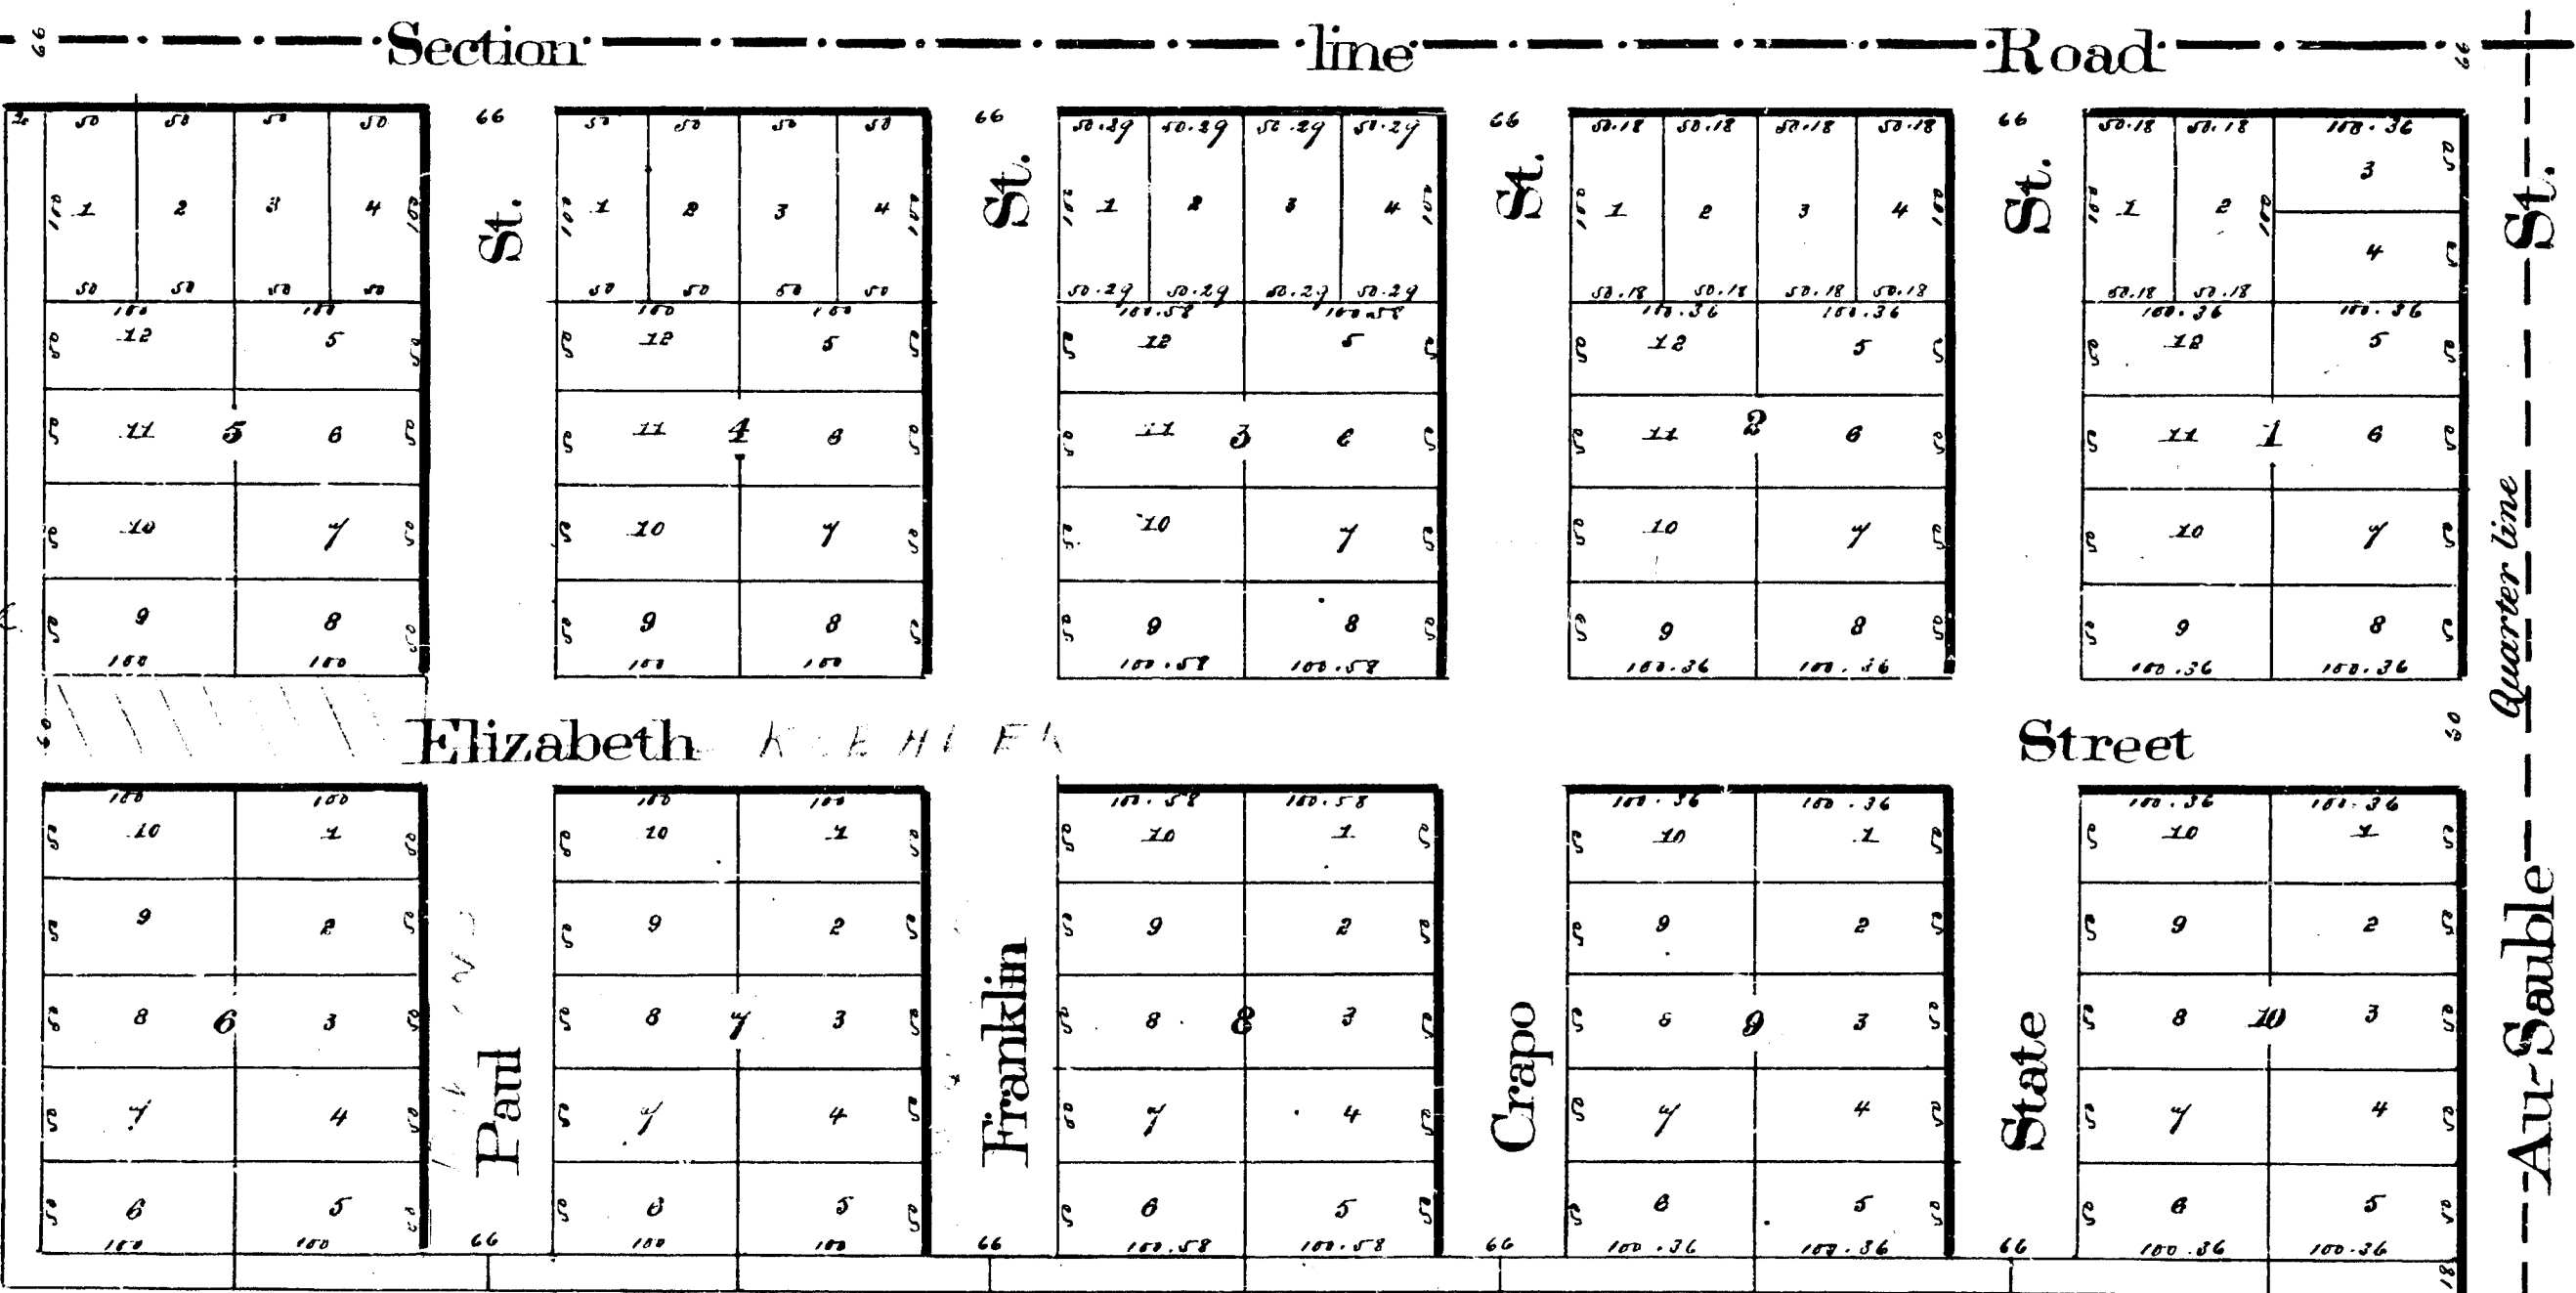

Scale 100 feet to an inch

Register of Deeds
 Bay County
 Henry H. Hamann
 25th day of June, A.D. 1873
 Chas. L. Dick

WM. MERCER C. E. & S. BAY CITY MICH.

14224