

RECEIVED AND FILED
IN AUDITOR GENERAL'S OFFICE


April 27 1892
H. R. Pratt
Deputy Auditor General

F.W. WHEELER & CO'S SECOND ADDITION TO WEST BAY CITY MICH.

SCALE 200 FEET TO ONE INCH.
F.W. WHEELER & CO. PROPRIETORS.
H.C. THOMPSON SURVEYOR

DEDICATION
Shew all men by these presents that M. F. W. Wheeler & Co a corporation as proprietors, by F. W. Wheeler President, have caused the land embraced in the annexed plat to be surveyed, laid out and plotted to be known as F. W. Wheeler & Co Second Addition to West Bay City Mich. and that the streets as shown on said plat are hereby dedicated to the use of the public.
Signed and Sealed in presence of
Frederick S. Gilbert
Chas. W. Slom
F. W. Wheeler
by F. W. Wheeler
President

State of Michigan } ss. On this Seventh day of July A.D. 1891 before me a Notary Public in and for said County personally came the above named F. W. Wheeler President of an incorporated company known as F. W. Wheeler & Co. known to me to be the person who executed the above dedication and acknowledged the same to be his free act and deed as such President.
Frederick S. Gilbert
Notary Public for
Bay County Mich.

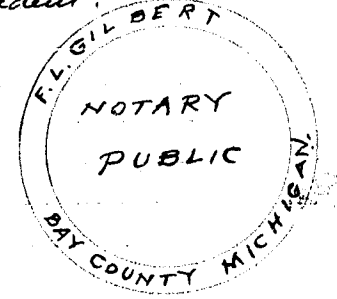

SURVEYOR'S CERTIFICATE
I hereby certify that the plat herein delineated is a correct one and that permanent monuments consisting of one inch round iron have been planted at points marked two o (small circle) as thereon shown at all angles in the boundaries of the land plotted and at all intersections of streets.
H.C. Thompson
Surveyor


Approved by the Common Council of
West Bay City Mich. this 21st day of Sept. A.D. 1891
N. H. Phillips Recorder
N. J. Martin Mayor

Received for record this 8th day of Oct. A.D. 1891 at 10 o'clock P.M. and recorded in Plat Book No. 3 Page 16
W. A. Pettapiece
Register

EXAMINED AND APPROVED
AUGUST 8 1891
H. R. PRATT
DEPUTY AUDITOR GENERAL

VACATED BY RESOLUTION
OF CITY COUNCIL
JAN 3 1902
VOUCHER No. 15-22

14289

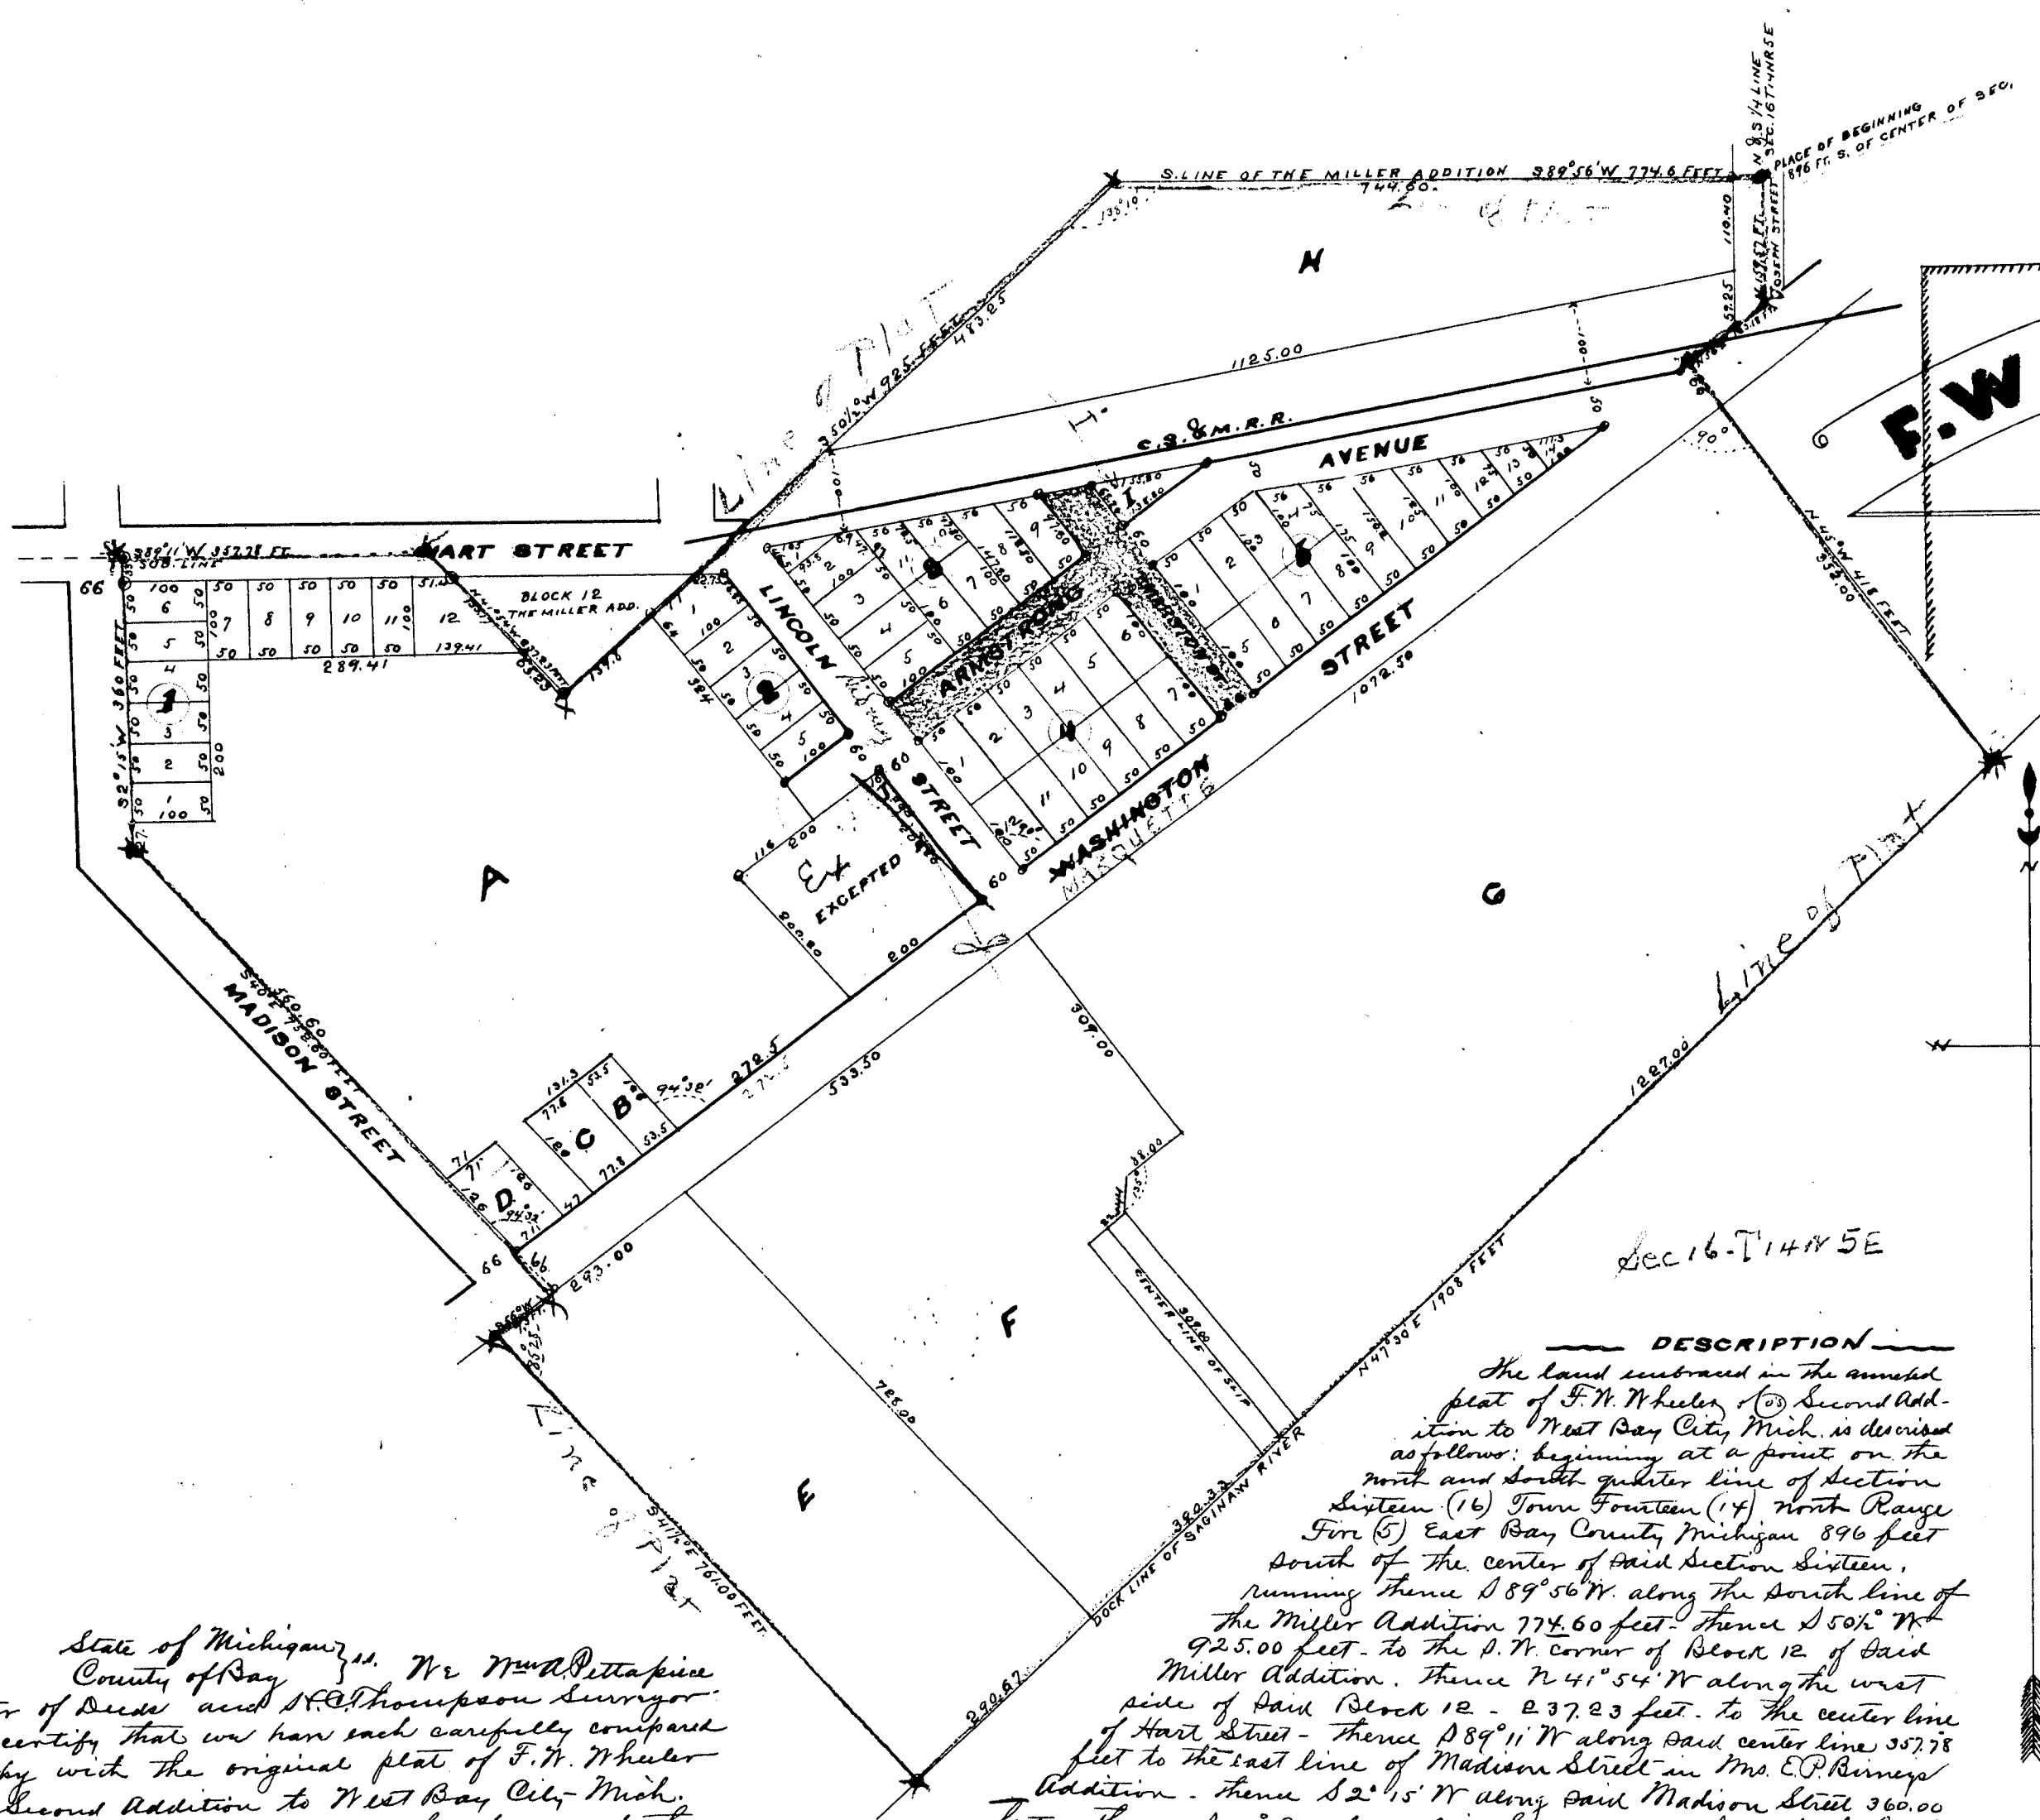

DESCRIPTION
The land embraced in the annexed plat of F. W. Wheeler & Co Second Addition to West Bay City Mich. is described as follows: beginning at a point on the north and south quarter line of Section Sixteen (16) Town Fourteen (14) North Range Four (4) East Bay County Michigan 896 feet south of the center of said Section Sixteen, running thence S 89° 56' W along the south line of the Miller Addition 774.60 feet. Thence S 50° W 925.00 feet. to the S.W. corner of Block 12 of said Miller Addition. Thence N 41° 54' W along the west side of said Block 12 - 237.23 feet. to the center line of Hart Street - Thence S 89° 11' W along said center line 357.78 feet to the east line of Madison Street in Mrs. E. P. Berners Addition. Thence S 2° 15' W along said Madison Street 360.00 feet. Thence S 41° E along said Street 752.60 feet. to the south line of Washington Street. Thence S 56° W along said Street 93 feet. Thence S 41° E 761.00 feet to the dock line on Saginaw River. Thence along said dock line N 47° 30' E 1908 feet to lands of the C.S. & M. R.R. - Thence N 45° W 418 feet to the north line of Washington Street. Thence N 56° E 122.18 feet to the N & S 1/4 line of said Section 16. Thence North along said 1/4 line 159.57 feet to place of beginning except a piece of land at the north west corner of Madison and Washington Streets marked "excepted".

State of Michigan } ss. We M. A. Pettapiece
County of Bay
Register of Deeds and H. C. Thompson Surveyor
hereby certify that we have each carefully compared this copy with the original plat of F. W. Wheeler & Co Second Addition to West Bay City Mich. and that it is an exact copy thereof and of the whole of such original map or plat

W. A. Pettapiece
H. C. Thompson
Register
Surveyor


State of Michigan } ss. We M. A. Pettapiece Register
County of Bay
of Deeds and H. C. Thompson Surveyor hereby
certify that we have each carefully compared this copy with the plat of F. W. Wheeler & Co Second Addition to West Bay City Mich. now of record in the office of said Register of Deeds and that it is a true transcript therefrom and of the whole of such record

W. A. Pettapiece
H. C. Thompson
Register
Surveyor

RECEIVED AND FILED
IN AUDITOR GENERAL'S OFFICE

April 27 1892

H. R. Pratt
Deputy Auditor General

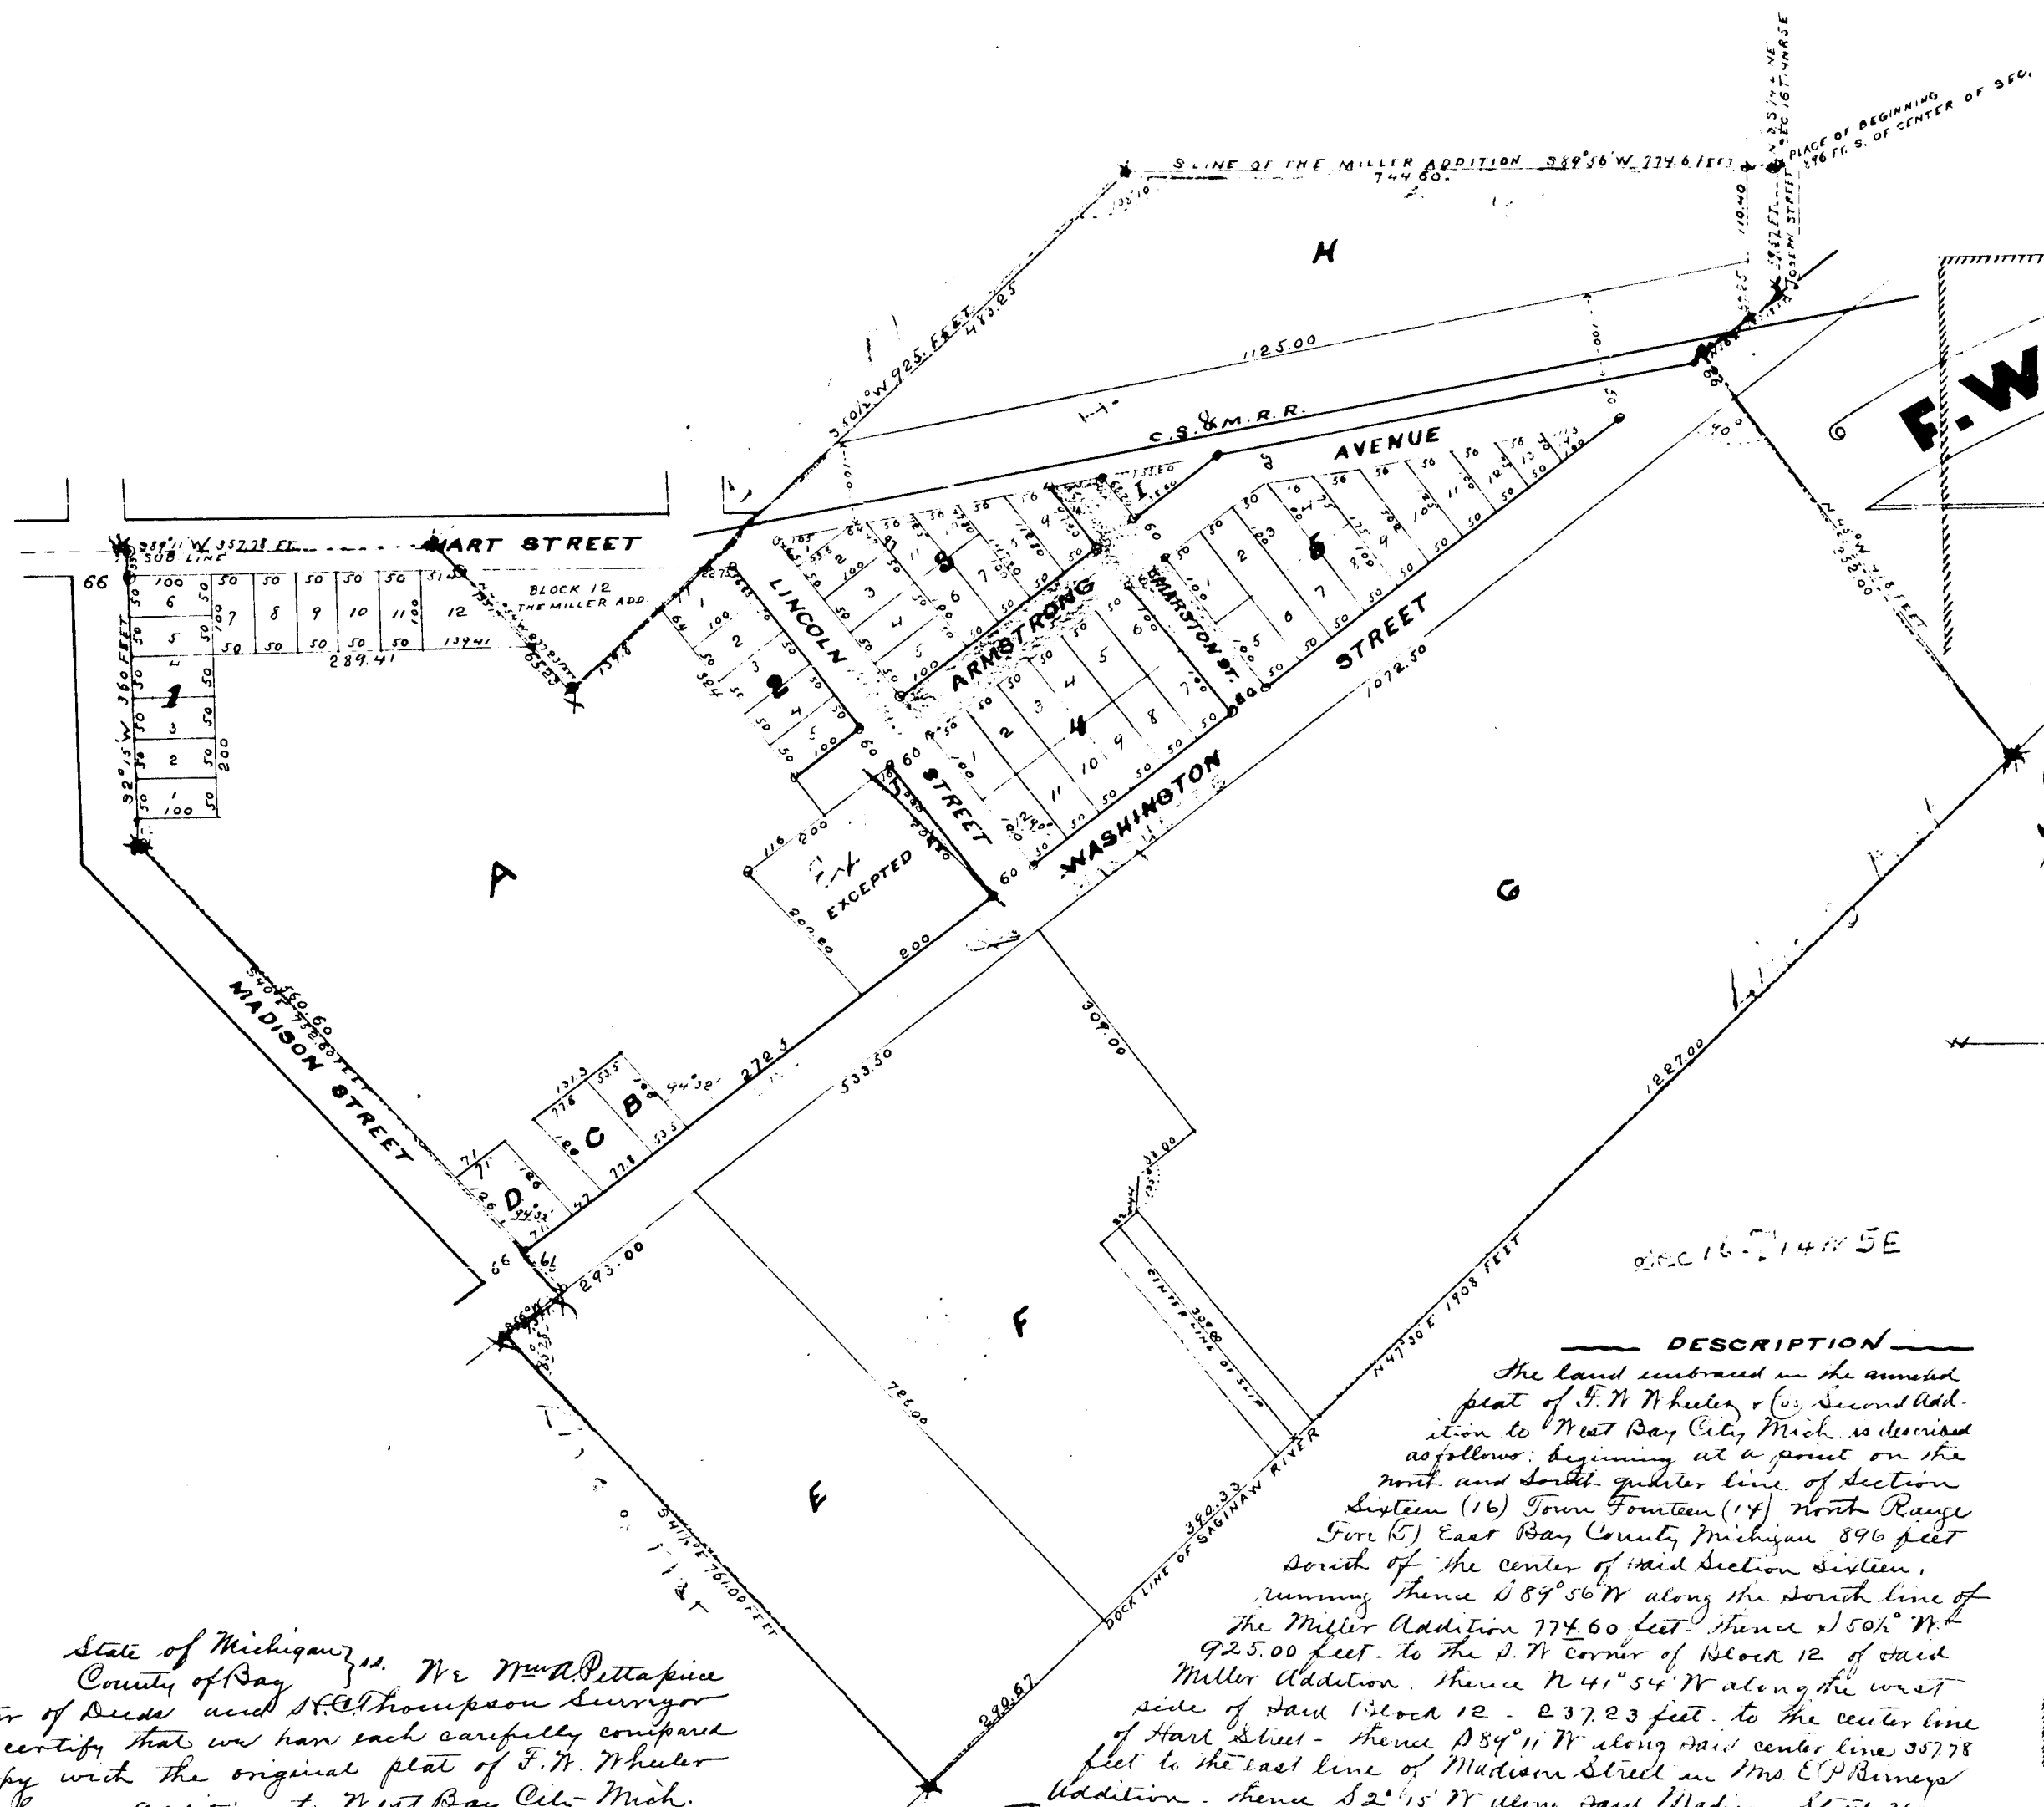

F.W. WHEELER & CO'S SECOND ADDITION

TO WEST BAY CITY MICH.

SCALE 200 FEET TO ONE INCH.
F.W. WHEELER & Co. PROPRIETORS.
H.C. THOMPSON SURVEYOR

DEDICATION

Shew all men by these presents that the F.W. Wheeler & Co a corporation as proprietors, by F.W. Wheeler President, have caused the land embraced in the annexed plat to be surveyed, laid out and plotted to be known as F.W. Wheeler & Co's Second Addition to West Bay City Mich. and that the streets as shown on said plat are hereby dedicated to the use of the public.
Signed and Sealed in presence of
Frederick S. Gilbert
Chas. W. Storer
F.W. Wheeler & Co.
by F.W. Wheeler President

State of Michigan, ss. On this Second day of July A.D. 1891 before me a Notary Public in and for said County personally came the above named F.W. Wheeler President of an incorporated company known as F.W. Wheeler & Co. known to me to be the person who executed the above dedication and acknowledged the same to be his free act and deed as such President.
Frederick S. Gilbert
Notary Public for
Bay County Mich.

NOTARY
PUBLIC
BAY COUNTY MICHIGAN

SURVEYOR'S CERTIFICATE

I hereby certify that the plat hereon delineated is a correct one and that permanent monuments consisting of one inch round iron have been planted at points marked two o (small circle) as thereon shown at all angles in the boundaries of the land plotted and at all intersections of streets.
H.C. Thompson
Surveyor

Approved by the Common Council of
West Bay City Mich. this 21st day of Sept. A.D. 1891
N. H. Phillips Recorder
N. J. Martin Mayor

Record for record this 8th day of Oct. A.D. 1891 at 12 o'clock P.M. and recorded in Plat Book No. 3 Page 16
H. A. Pettapiece
Register

EXAMINED AND APPROVED
AUGUST 8 1891
H. R. PRATT
DEPUTY AUDITOR GENERAL

VACATED BY RESOLUTION
OF CITY COUNCIL
JAN 8 1900
VOUCHER No. 15-02

State of Michigan, ss. We Mr. M. A. Pettapiece Register of Deeds and H. C. Thompson Surveyor hereby certify that we have each carefully compared this copy with the original plat of F.W. Wheeler & Co's Second Addition to West Bay City Mich. and that it is an exact copy thereof and of the whole of such original map or plat.

M. A. Pettapiece
Register
H. C. Thompson
Surveyor

State of Michigan, ss. We Mr. M. A. Pettapiece Register of Deeds and H. C. Thompson Surveyor hereby certify that we have each carefully compared this copy with the plat of F.W. Wheeler & Co's Second Addition to West Bay City Mich. now of record in the office of said Register of Deeds and that it is a true transcript therefrom and of the whole of such record.

M. A. Pettapiece
Register
H. C. Thompson
Surveyor