

Office of the Secretary

Dep. Aud. Gen.

PLAT
OF
the village of
TORCH LAKE
Guthrie County, Michigan.

The village of Stark ¹ is so delimited by the Stark ² and Stark ³ ⁴ ⁵ ⁶ ⁷ ⁸ ⁹ ¹⁰ ¹¹ ¹² ¹³ ¹⁴ ¹⁵ ¹⁶ ¹⁷ ¹⁸ ¹⁹ ²⁰ ²¹ ²² ²³ ²⁴ ²⁵ ²⁶ ²⁷ ²⁸ ²⁹ ³⁰ ³¹ ³² ³³ ³⁴ ³⁵ ³⁶ ³⁷ ³⁸ ³⁹ ⁴⁰ ⁴¹ ⁴² ⁴³ ⁴⁴ ⁴⁵ ⁴⁶ ⁴⁷ ⁴⁸ ⁴⁹ ⁵⁰ ⁵¹ ⁵² ⁵³ ⁵⁴ ⁵⁵ ⁵⁶ ⁵⁷ ⁵⁸ ⁵⁹ ⁶⁰ ⁶¹ ⁶² ⁶³ ⁶⁴ ⁶⁵ ⁶⁶ ⁶⁷ ⁶⁸ ⁶⁹ ⁷⁰ ⁷¹ ⁷² ⁷³ ⁷⁴ ⁷⁵ ⁷⁶ ⁷⁷ ⁷⁸ ⁷⁹ ⁸⁰ ⁸¹ ⁸² ⁸³ ⁸⁴ ⁸⁵ ⁸⁶ ⁸⁷ ⁸⁸ ⁸⁹ ⁹⁰ ⁹¹ ⁹² ⁹³ ⁹⁴ ⁹⁵ ⁹⁶ ⁹⁷ ⁹⁸ ⁹⁹ ¹⁰⁰ ¹⁰¹ ¹⁰² ¹⁰³ ¹⁰⁴ ¹⁰⁵ ¹⁰⁶ ¹⁰⁷ ¹⁰⁸ ¹⁰⁹ ¹¹⁰ ¹¹¹ ¹¹² ¹¹³ ¹¹⁴ ¹¹⁵ ¹¹⁶ ¹¹⁷ ¹¹⁸ ¹¹⁹ ¹²⁰ ¹²¹ ¹²² ¹²³ ¹²⁴ ¹²⁵ ¹²⁶ ¹²⁷ ¹²⁸ ¹²⁹ ¹³⁰ ¹³¹ ¹³² ¹³³ ¹³⁴ ¹³⁵ ¹³⁶ ¹³⁷ ¹³⁸ ¹³⁹ ¹⁴⁰ ¹⁴¹ ¹⁴² ¹⁴³ ¹⁴⁴ ¹⁴⁵ ¹⁴⁶ ¹⁴⁷ ¹⁴⁸ ¹⁴⁹ ¹⁵⁰ ¹⁵¹ ¹⁵² ¹⁵³ ¹⁵⁴ ¹⁵⁵ ¹⁵⁶ ¹⁵⁷ ¹⁵⁸ ¹⁵⁹ ¹⁶⁰ ¹⁶¹ ¹⁶² ¹⁶³ ¹⁶⁴ ¹⁶⁵ ¹⁶⁶ ¹⁶⁷ ¹⁶⁸ ¹⁶⁹ ¹⁷⁰ ¹⁷¹ ¹⁷² ¹⁷³ ¹⁷⁴ ¹⁷⁵ ¹⁷⁶ ¹⁷⁷ ¹⁷⁸ ¹⁷⁹ ¹⁸⁰ ¹⁸¹ ¹⁸² ¹⁸³ ¹⁸⁴ ¹⁸⁵ ¹⁸⁶ ¹⁸⁷ ¹⁸⁸ ¹⁸⁹ ¹⁹⁰ ¹⁹¹ ¹⁹² ¹⁹³ ¹⁹⁴ ¹⁹⁵ ¹⁹⁶ ¹⁹⁷ ¹⁹⁸ ¹⁹⁹ ²⁰⁰ ²⁰¹ ²⁰² ²⁰³ ²⁰⁴ ²⁰⁵ ²⁰⁶ ²⁰⁷ ²⁰⁸ ²⁰⁹ ²¹⁰ ²¹¹ ²¹² ²¹³ ²¹⁴ ²¹⁵ ²¹⁶ ²¹⁷ ²¹⁸ ²¹⁹ ²²⁰ ²²¹ ²²² ²²³ ²²⁴ ²²⁵ ²²⁶ ²²⁷ ²²⁸ ²²⁹ ²³⁰ ²³¹ ²³² ²³³ ²³⁴ ²³⁵ ²³⁶ ²³⁷ ²³⁸ ²³⁹ ²⁴⁰ ²⁴¹ ²⁴² ²⁴³ ²⁴⁴ ²⁴⁵ ²⁴⁶ ²⁴⁷ ²⁴⁸ ²⁴⁹ ²⁵⁰ ²⁵¹ ²⁵² ²⁵³ ²⁵⁴ ²⁵⁵ ²⁵⁶ ²⁵⁷ ²⁵⁸ ²⁵⁹ ²⁶⁰ ²⁶¹ ²⁶² ²⁶³ ²⁶⁴ ²⁶⁵ ²⁶⁶ ²⁶⁷ ²⁶⁸ ²⁶⁹ ²⁷⁰ ²⁷¹ ²⁷² ²⁷³ ²⁷⁴ ²⁷⁵ ²⁷⁶ ²⁷⁷ ²⁷⁸ ²⁷⁹ ²⁸⁰ ²⁸¹ ²⁸² ²⁸³ ²⁸⁴ ²⁸⁵ ²⁸⁶ ²⁸⁷ ²⁸⁸ ²⁸⁹ ²⁹⁰ ²⁹¹ ²⁹² ²⁹³ ²⁹⁴ ²⁹⁵ ²⁹⁶ ²⁹⁷ ²⁹⁸ ²⁹⁹ ³⁰⁰ ³⁰¹ ³⁰² ³⁰³ ³⁰⁴ ³⁰⁵ ³⁰⁶ ³⁰⁷ ³⁰⁸ ³⁰⁹ ³¹⁰ ³¹¹ ³¹² ³¹³ ³¹⁴ ³¹⁵ ³¹⁶ ³¹⁷ ³¹⁸ ³¹⁹ ³²⁰ ³²¹ ³²² ³²³ ³²⁴ ³²⁵ ³²⁶ ³²⁷ ³²⁸ ³²⁹ ³³⁰ ³³¹ ³³² ³³³ ³³⁴ ³³⁵ ³³⁶ ³³⁷ ³³⁸ ³³⁹ ³⁴⁰ ³⁴¹ ³⁴² ³⁴³ ³⁴⁴ ³⁴⁵ ³⁴⁶ ³⁴⁷ ³⁴⁸ ³⁴⁹ ³⁵⁰ ³⁵¹ ³⁵² ³⁵³ ³⁵⁴ ³⁵⁵ ³⁵⁶ ³⁵⁷ ³⁵⁸ ³⁵⁹ ³⁶⁰ ³⁶¹ ³⁶² ³⁶³ ³⁶⁴ ³⁶⁵ ³⁶⁶ ³⁶⁷ ³⁶⁸ ³⁶⁹ ³⁷⁰ ³⁷¹ ³⁷² ³⁷³ ³⁷⁴ ³⁷⁵ ³⁷⁶ ³⁷⁷ ³⁷⁸ ³⁷⁹ ³⁸⁰ ³⁸¹ ³⁸² ³⁸³ ³⁸⁴ ³⁸⁵ ³⁸⁶ ³⁸⁷ ³⁸⁸ ³⁸⁹ ³⁹⁰ ³⁹¹ ³⁹² ³⁹³ ³⁹⁴ ³⁹⁵ ³⁹⁶ ³⁹⁷ ³⁹⁸ ³⁹⁹ ⁴⁰⁰ ⁴⁰¹ ⁴⁰² ⁴⁰³ ⁴⁰⁴ ⁴⁰⁵ ⁴⁰⁶ ⁴⁰⁷ ⁴⁰⁸ ⁴⁰⁹ ⁴¹⁰ ⁴¹¹ ⁴¹² ⁴¹³ ⁴¹⁴ ⁴¹⁵ ⁴¹⁶ ⁴¹⁷ ⁴¹⁸ ⁴¹⁹ ⁴²⁰ ⁴²¹ ⁴²² ⁴²³ ⁴²⁴ ⁴²⁵ ⁴²⁶ ⁴²⁷ ⁴²⁸ ⁴²⁹ ⁴³⁰ ⁴³¹ ⁴³² ⁴³³ ⁴³⁴ ⁴³⁵ ⁴³⁶ ⁴³⁷ ⁴³⁸ ⁴³⁹ ⁴⁴⁰ ⁴⁴¹ ⁴⁴² ⁴⁴³ ⁴⁴⁴ ⁴⁴⁵ ⁴⁴⁶ ⁴⁴⁷ ⁴⁴⁸ ⁴⁴⁹ ⁴⁵⁰ ⁴⁵¹ ⁴⁵² ⁴⁵³ ⁴⁵⁴ ⁴⁵⁵ ⁴⁵⁶ ⁴⁵⁷ ⁴⁵⁸ ⁴⁵⁹ ⁴⁶⁰ ⁴⁶¹ ⁴⁶² ⁴⁶³

The allegation of the buying out of the town that above described, the proprietors have, John W. Stillman and Mrs. Charles Stillman, his wife, of Milwaukee, Wisconsin by an attorney in fact, and George C. State of Johnson County of record, as lawyers, do hereby certify that the lots of flats and boards here shown were actually surveyed and staked out in May and June 1878, and they hereby declare this plat is in strict conformity therewith and is a faithful representation of said survey.

11 wood turn round and dead but 13 day of July
A-B-1878 L. P. S. D

John W. Johnson
 Rachel J. Johnson

By your Obedient servant
Geo. E. Stead
Archibald Cameron Jr.
The presence of

William H. Thompson
Richard Knight

State of Michigan } 45.
County of Jackson }


Before me the witnesses, a Whig Public in and for said County ^{of} generally appeared J^r Thos^s Silliman and Rachel Silliman, his wife, by which said ^{deceased} ~~deceased~~ ^{deceased} testimony in fact, to me known to be the same persons described as appearing in and who executed the in-
surance and who actually acknowledged such accounts as, "in fire out and dead, and that they had paid out the sum paid above described, and designated the same to the use and purpose herein mentioned, and the said testimony acknowledged that he was one of the set and died of Rachel Silliman
the wife of a Power of attorney dated the 17th day of June, 1878, and recorded in the office of the Register of deeds of said County, includes 1st of said pages 293 and 296, on the third day of June 1878,
"given under my hand" the day and year past above written

Richard Knight
Notary Public

Regidius Office
Johnson County

Maximal for record this 26th day of
winter 1878 at 8 am or close of it and records
in diary A of mileage photo on page 10

Arthur S. Turner
Register of Seeds.

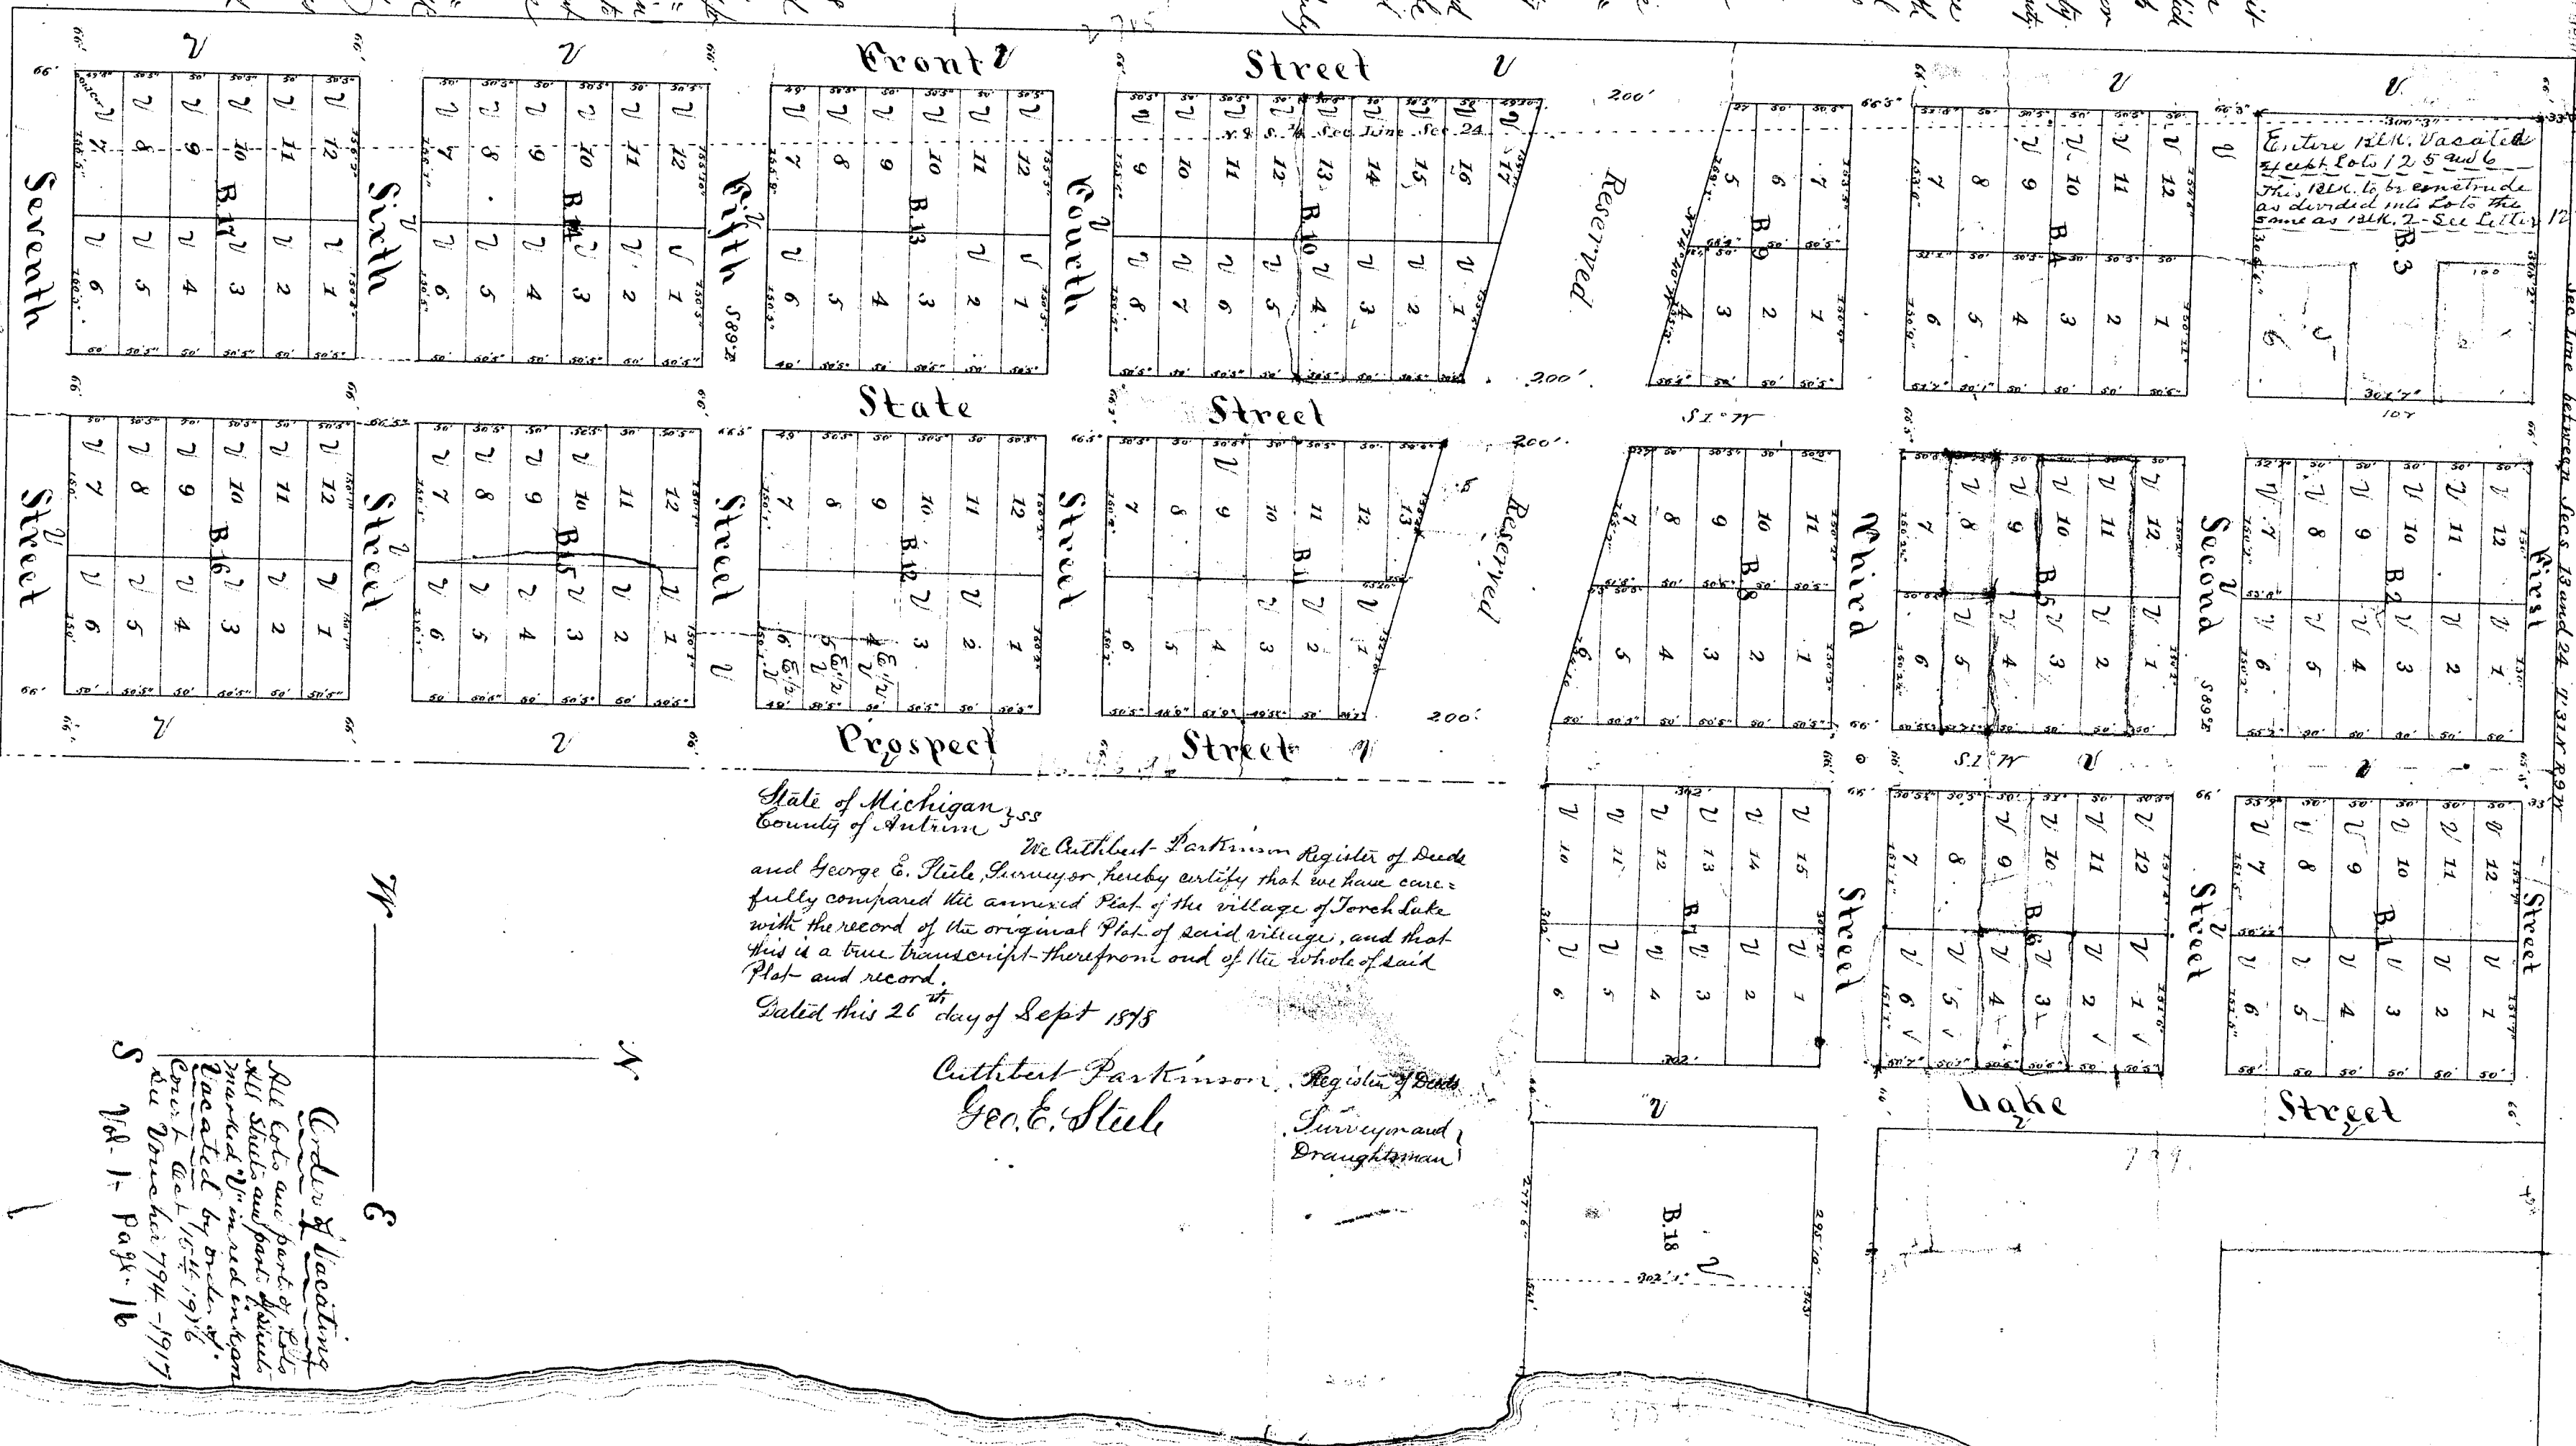

State of Michigan } ss
County of Autum

We Authenticated Particulars Register of Deeds
and George C. Steele, Surveyor, hereby certify that we have care-
fully compared the annexed Plat of the village of Torch Lake
with the record of the original Plat of said village, and that
this is a true transcript therefrom out of the whole of said
Plat and record.

Dated this 26th day of Sept 1878

Authent Parkinson
Geo. E. Steele

Register of Deeds
Surveyor and
Draughtsman

Order of Vacating

du Zuechi 794-1917
S Vol. 1- Page 16

Scale, 150 ft. = 1 inch

North-Western
Geo. E. Steel
Napier & Steel
Glasgow and B.

Heaven and Earth.

Oct 17 1878
A. R. Pratt

The village of North Lake is delineated by this flat wet
matted on beds 1, 2, 3 and 4 of sec. twenty four 24 of town
twenty one 31 North of Range line 9 West, Adams County, Ark.
again, and extend on the flat and reach a short distance on to
beds two, three, four and five of the same sec. The Northwest cor-
ner of lot twenty 22 of block three 3 of said village is thirty
two feet South of the prairie cor. between Secs. thirteen and twenty
four of said town, which pr. cor. was determined from
both of the original survey but was obliterated by a fire
of last year about 4 1/2 ft. long and a mound of earth. The North
line of said sec. was run from that pr. cor. to the original
mound cor. on each side. At this central intersection of
third and twentieth there is a large iron grate bar upon dam
which the line runs with the surveyor. The dimensions of beds
1, 2, 3, 4, 5 are given in feet, matted in, to nine 9 and twelve
in second 2. The water bar is 16 feet.

The celebration of the laying out of the town plat above described, the prebidders being John W. Stillman and his chief partner was, his wife, of Milwaukee Wisconsin by her attorney in fact, and George C. State of Auburn County of Nevada, as witnesses, do hereby certify that the said fields and stream do now remain now actually unappropriated shakal seed in May year 1878, and they hereby declare this plat is in it's conformity therewith and do hereby ratify and confirm celebration of said survey.

5.

Michael J. Dickinson
 By his Attorney in fact
 David H. Chapman, Jr.
 Sec. & Clerk
 1899

William A. Van Hook
Richard Knight

State of Michigan }
County of Jackson } Ind.

(On this 13th day of July 1878
before me the undersigned a Notary Public in and for said
County of Berkeley and State of California, the said William
Robert Stillman and wife by their said husband, personally
the attorney in fact, to me known to be the same persons
detected in person on and who created this in-
spection and who personally returned to me such execution
as, in the act and deed, and that they said husband
the same past above described, and executed the same
to be the said and party in the in, intended, and the
said
and the said one third of Robert Stillman
one of the three of attorney dated on 17th day
of June 1878, and recited in the office of said Notary
of State of California County of Alameda 17th of October 1878,
and yet in the said day of June 1878,
even earlier and found in day and year past
to be the said

Richard Knight
Notary Public

Weybridge Office
Dublin County

Received for record this 26th day of September 1898 at \$100.00 each of 15 and receipted in this A of savings photo on page 10
Cuthbert Harrison
Register of Seals.



	25	75	150	200	M.	300
--	----	----	-----	-----	----	-----

Scale, 150 ft. = 1 inch

State of Michigan
County of Eastern

The Undersigned, Paul Tenen, Register of Deeds for said County, and George C. Steele the Surveyor who made this plat of the village of Torch Lake do hereby certify that we have carefully compared this duplicate with the recorded plat of said village, and that this is an exact duplicate therefrom and of the whole of said plat.

Dated this 30 day of September A.D. 1893

Paul Tenen, Register of Deeds
Geo. C. Steele, Surveyor and Recorder

10	20	30	40	50	60	70	80	90	100
----	----	----	----	----	----	----	----	----	-----

STATE OF MICHIGAN
IN THE CIRCUIT COURT FOR THE COUNTY OF ANTRIM

Antrim
14465

CHARLES L. DAWSON and NOLA B.
DAWSON, husband and wife,

File No. 1183

Plaintiffs,

-vs-

TREASURER OF THE STATE OF
MICHIGAN,

ORDER

Defendant.

At a session of said Court, held in the Courthouse in the Village of
Bellaire, in said County and State on the 16th day of August, 1973.

PRESENT: HONORABLE WILLIAM R. BROWN, CIRCUIT JUDGE.

This matter having come on to be heard upon the Petition of the
Plaintiffs to alter, correct and revise the Plat of Torch Lake Village, Torch Lake
Township, Antrim County, Michigan by the vacation of a part of Second Street
in said Plat, or in the alternative for a Declaratory Judgment that said part of
Second Street in said Plat, never having been in the public domain, belong to
and are owned by the owners of the land abutting and adjoining such portion of
the street or on the opposite sides of said street pursuant to the provisions of Act
288 of 1967, being MCL 560.1 to 560.80 and the Court having heard the wit-
nesses and all evidence thereon, and being well and duly advised in the premises,
and all persons, agencies or parties entitled to notice of the hearing on said
matter having been timely and duly served such notice, and proof of service
thereof and of the posting of such notice in accordance with the statute in such
case provided having been duly filed.

IT IS HEREBY ORDERED AND ADJUDGED as follows:

14465

I.

Notices and service of process required by the provisions of Act 288 of 1967 (MCL 560.1 - 560.80) have been properly complied with and all the necessary and proper parties to this action were thereby subjected to the jurisdiction of this Court.

II.

Neither the public nor any member thereof, no party to this action, and no governmental subdivision ever used said portion of Second Street of the said Plat, more particularly described as follows:

Commencing at the Southeast corner of Lot 6, Block 3 of Plat of Torch Lake Village, thence West on the South line of said Lot 6, 150 feet to the Southwest corner of said Lot 6; thence South 66 feet to the Northwest corner of Lot 1, Block 4 of Plat of Torch Lake Village, thence East on the North line of said Lot 1, to the Northeast corner of said Lot 1, thence North 66 feet to the point of beginning, Torch Lake Township, Antrim County, Michigan.

or have formerly accepted the same, and they have never been opened, laid out, built, maintained or improved the same, and use and ownership of said portion of Second Street has never been in the public domain, nor in any person adverse to the abutting owner or owners of the lands on opposite sides of said portion of Second Street within the subdivision.

III.

That pursuant to the provisions of Act 288 of 1967 being MSA 26.430 (226)

(a) The following described portion of Second Street of the Plat of Torch Lake Village, Torch Lake Township, Antrim County, Michigan, to-wit:

Commencing at the Southeast corner of Lot 6, Block 3 of Plat of Torch Lake Village, thence West on the South line of said Lot 6, 150 feet to the Southwest corner of said Lot 6; thence South 66 feet to the Northwest corner of Lot 1, Block 4 of Plat of Torch Lake Village, thence East on the North line of said Lot 1, to the Northeast corner of said Lot 1, thence North 66 feet to the point of beginning, Torch Lake Township, Antrim County, Michigan.

14445

is hereby vacated and the Plat of Torch Lake Village is altered and revised accordingly.

(b) That the title to and ownership of said portion of Second Street, Torch Lake Village, Torch Lake Township, Antrim County, Michigan is vested in the following named persons, to-wit:


a. Charles A. Sweet and Jessie Sweet, husband and wife and grantees of John Yadron and Marie Yadron, husband and wife as to the North one-half of said vacated portion of Second Street.

b. Charles L. Dawson and Nola B. Dawson, husband and wife as to the South half of said vacated portion of Second Street.

(c) The vacation and alteration herein adjudicated is subject to any recorded easements of record, if any.

(d) A public question being involved no costs are awarded.

(e) The Register of Deeds for Antrim County, Michigan shall record this Judgment when received, and place upon the original Plat of Torch Lake Village, the date, liber and page number.

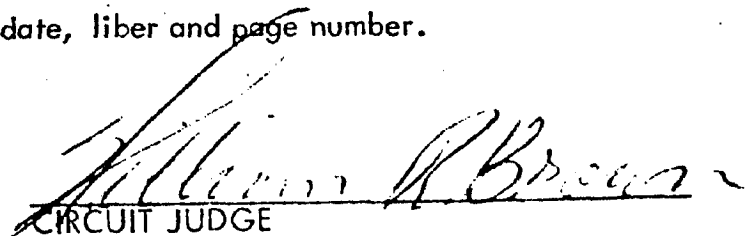
CIRCUIT JUDGE

PLAT

TORCH LAKE.

In the matter of the petition
of Herbert R. Page, individually
and as Trustee of Will B. Page
for the vacation of certain
portions of said plat.

ORDERED that the following portions of
said plat be vacated: Blocks 1-2-7-10-13 (ex-
cepting Lots 3-4-5 of said Block 13) 11-16-17-18
Block 3 except Lots 1-2-5-6, Block 4 except
Lots 1 to 8, Block 5 except Lots 6-7, Block 6
except Lots 7-8, Block 11 except Lots 4-5-6-7-8-
10-11-12-13, Block 12 except Lots 1-7-8-9-10-11-
12 and the W. $\frac{1}{2}$ of Lots 4-5-6, Block 15 except
Lots 11-12.

Also, all of Lake St. lying north and south
of Third St., all of Prospect St. lying north of the south line of Lot 4, Block 5
extended east, all of Prospect St. lying between the south line of Lot 6, Block 8
extended east, and the south line of Lot 3, Block 11 extended east, without pre-
judice to the public to assert any right it may have acquired by user, if any; also
all of Prospect St. lying south of the south line of Lot 1, Block 12 extended east,
all of Front St. lying north of the south line of Lot 9, Block 4, extended west,
also all of Front St. lying south of the south line of Lot 5, Block 9 extended west;
all of Second St. lying west of the west line of Lot 1, Block 4 extended north; also
all of Second St. lying between the State Road and Lake St.; all of Fourth St. lying
west of the State Road, without prejudice to the public to assert any right it may have
acquired by use, if any; all of Fifth St. lying west of the State Road, also all of
Fifth St. lying east of the division line between the east and west halves of Lot 1,
Block 15, extended north; all of Sixth St. except the intersection of the State Road,
and all of Seventh St. lying east of the State Road.

Voucher-794-1917- Vol-179- Page-14465-✓

PLAT

TYLER'S ADDITION TO VILLAGE OF SPENCER CREEK.

In the matter of
the petition of Jared W.
Tyler, et al. to vacate
said plat.

ORDERED that all that portion of Tyler's
Addition to the Village of Spencer Creek in said
County of Antrim lying west of the C. & W. M. R.R.
Right of Way be and the same is vacated.

Oct. 24, 1905.

Voucher No. 798 -- 1917.

Frederick W. Mayne,
Circuit Judge.

Vol. 179 page, 14509.

PLAT- VILLAGE OF BELLAIRE (ORIGINAL)

Circuit Court Journal
Liber 2 page 55-Nov 12-1884

Petition to alter and vacate Plat

All that portion of Cedar Street, Bridge Street and Blocks F and K and all other portions of the original plat of village of Bellaire, according to plat recorded in the office of the Register of Deeds of said county of Antrim, on 24th of June 1879 lying North of Intermediate River be and the same is hereby vacated- And it is further ordered that in lieu of such streets so vacated such portions of land, as are necessary to join with other portions of lands, heretofore platted, or dedicated as will make a streets 83 feet, in width extending from south line of Richardi and Bechtold's Addition to village of Bellaire to north line of the original plat of said village of Bellaire, 50 feet- of said street to lie to the east and 33 feet, to lie to the west of the following line Beginning at south west corner of Richardi's Bechtold's addition to village of Bellaire, go south on the range line to south west corner of North west fractional $\frac{1}{4}$ of south west fractional $\frac{1}{4}$ of section 19, Township 30 N of Range 7 West State of Michigan, and also the piece or parcel of land bounded by following lines Beginning at S W corner of N W fractional $\frac{1}{4}$ of E W fractional $\frac{1}{4}$ of section 19, Township 30, N of R 7 West 30 east 50 feet, thence south 13 degrees east to Intermediate River, thence along said river, to a point lying south 13 degrees east, Thence in straight, line to beginning, be and the same is hereby dedicated to public use.

Petitioners (Rupert Richardi Frederick Bechtold
(Louise Richardi Maximeluis Bechtold

Voucher No- 83- 1912 Vol- 179- Page 14466

PLAT- VILLAGE OF MAUCELONA

Circuit Court, Journal Liber 2 page 103
May 4-1886

Ashbury Lybarker
Julia Lybarker
Perry G Rogers
F Jackson
Sarah Rogers
H R Hale and
E Spencer


Petition to vacate plat
of Portion of Village of Maucelona

ORDERED: That the plat of the South $\frac{1}{2}$ of Lot 5, Lots 6-7-8-9-and 10, and the alley lying between Lots 7 and 8, and Lots 9 and 10 of the Plat of Maucelona Antrim County, be and the same is hereby vacated.

J G Ramsdell
Circuit Judge

Curtis & Taylor
Plat Examiners

Vol- 179- Page 14463

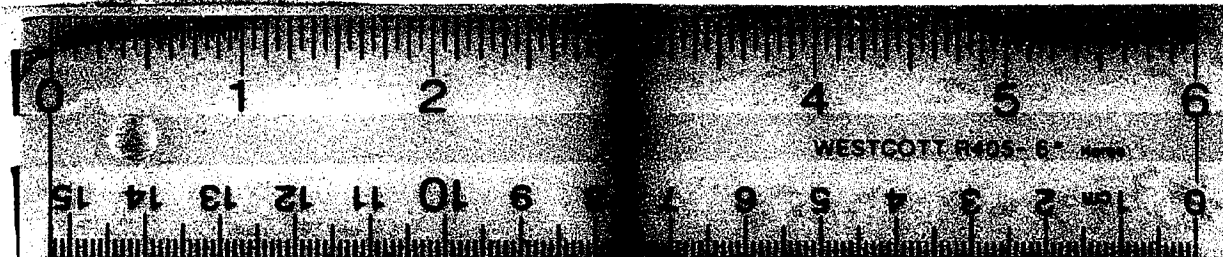

16 X