

Location

Plat showing the size form and No. of lots, location name course and width of streets, and width of Alleys, in the village of Bellaire in the south fractional half of the south west fractional quarter of Section 19, in Town 30 North of Range 7 West and in the south east quarter of the south east quarter of Section 24, in Town 30 North of Range 8 West, all in Antrim County and State of Michigan, bounded as follows, to wit:— Beginning at the Section corner on Range line between Sections 19 and 30 in Town 30 North of Range 7 West and Sections 24 and 25 in Town 30 North of Range 8 West— thence North $87^{\circ} 45'$ East (magnetic) on the south line of said Section 19, 1781 feet to $\frac{1}{4}$ S between Sections 19 and 30, — thence North $1^{\circ} 37'$ West (magnetic) on the $\frac{1}{4}$ line 1327 feet to $\frac{1}{8}$ S — thence South $87^{\circ} 15'$ West (magnetic) 1767 feet to $\frac{1}{8}$ S on Range line — thence South $1^{\circ} 30'$ East (magnetic) 1322 $\frac{1}{2}$ feet to place of beginning — also all that part of Section 24 Town 30 North of Range 8 West lying East of Intermediate River — Lots (1) one to (38) thirty eight, inclusive of Block "C" are each 100 feet long and 111 71 feet East and 29 feet West of the Range line —

The Government corners effecting this survey were established and perpetuated from unmistakable witnesses.

The complete blocks and lots are right parallelograms having their respective dimensions marked in feet this ("') and inches thus ("")

Blocks are designated by red capital letters — Numbers of Lots are indicated by red figures

State of Michigan } ss. We John A. Harriman, Register of Deeds of said County and David C. McVean Surveyor hereby certify that we have carefully compared the annexed plat with the plat of the Village of Bellaire on record in the Office of the said Register of Deeds and that it is a true transcript thereof and of the whole of such record.

John A. Harriman Register of Deeds.

D. E. McVean Surveyor.

Certificates

Know all men by these presents that we the undersigned Ambrose E. Palmer and Mattie L. Palmer his wife as proprietors and David C. McVean as Surveyor have plotted the above described pieces of land to be known as the Village of Bellaire and the said parties do hereby dedicate to the use of the Public all the Streets, Alleys and Public ground as shown on the annexed plat. Witness our hands and seals this 23^d day of June A.D. 1879.

Witness
Chas. M. Seckins
D. E. McVean

Ambrose E. Palmer. [LS]
Mattie L. Palmer. [LS]
D. E. McVean. [LS]

State of Michigan } ss. On this 23^d day of June A.D. 1879 County of Kalamazoo } before me a Notary Public in and for said County personally appeared Ambrose E. Palmer and Mattie L. Palmer his wife and David C. McVean as Surveyor known to me to be the persons who executed the above instrument and acknowledged the same to be their free act and deed.

[Signature]
Notary Public
for Kalamazoo County.

State of Michigan } ss. We John A. Harriman Register of Deeds for said County and David C. McVean the Surveyor who made the plat of the Village of Bellaire hereby certify that we have carefully compared this copy with the said original plat of the Village of Bellaire and it is an exact copy thereof and of the whole of such map or plat.


John A. Harriman Register of Deeds.

D. E. McVean Surveyor.

Register Office } ss. I hereby certify that this Antrim County } plat of the Village of Bellaire was received for record the 24th day of June A.D. 1879 at 2 o'clock P.M. and recorded in plat book letter A. page 10

John A. Harriman Register of Deeds.


701

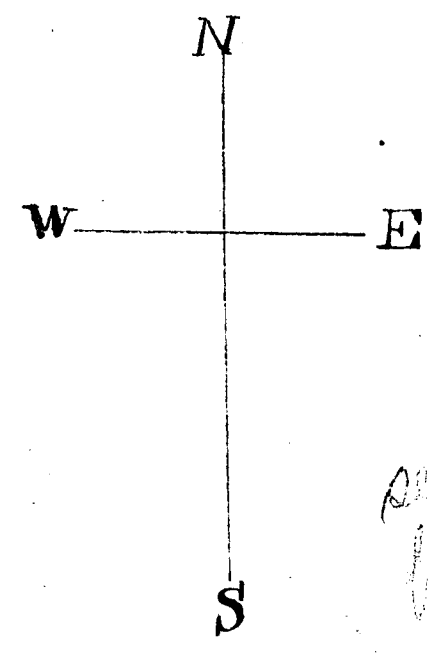

RECEIVED AND FILED
In Auditor General's Office,
July 3 1879
H. R. Pratt
Dep. Aud. Genl.

PLAT OF THE VILLAGE OF BELLAIRE, ANTRIM COUNTY, MICHIGAN.

701
101

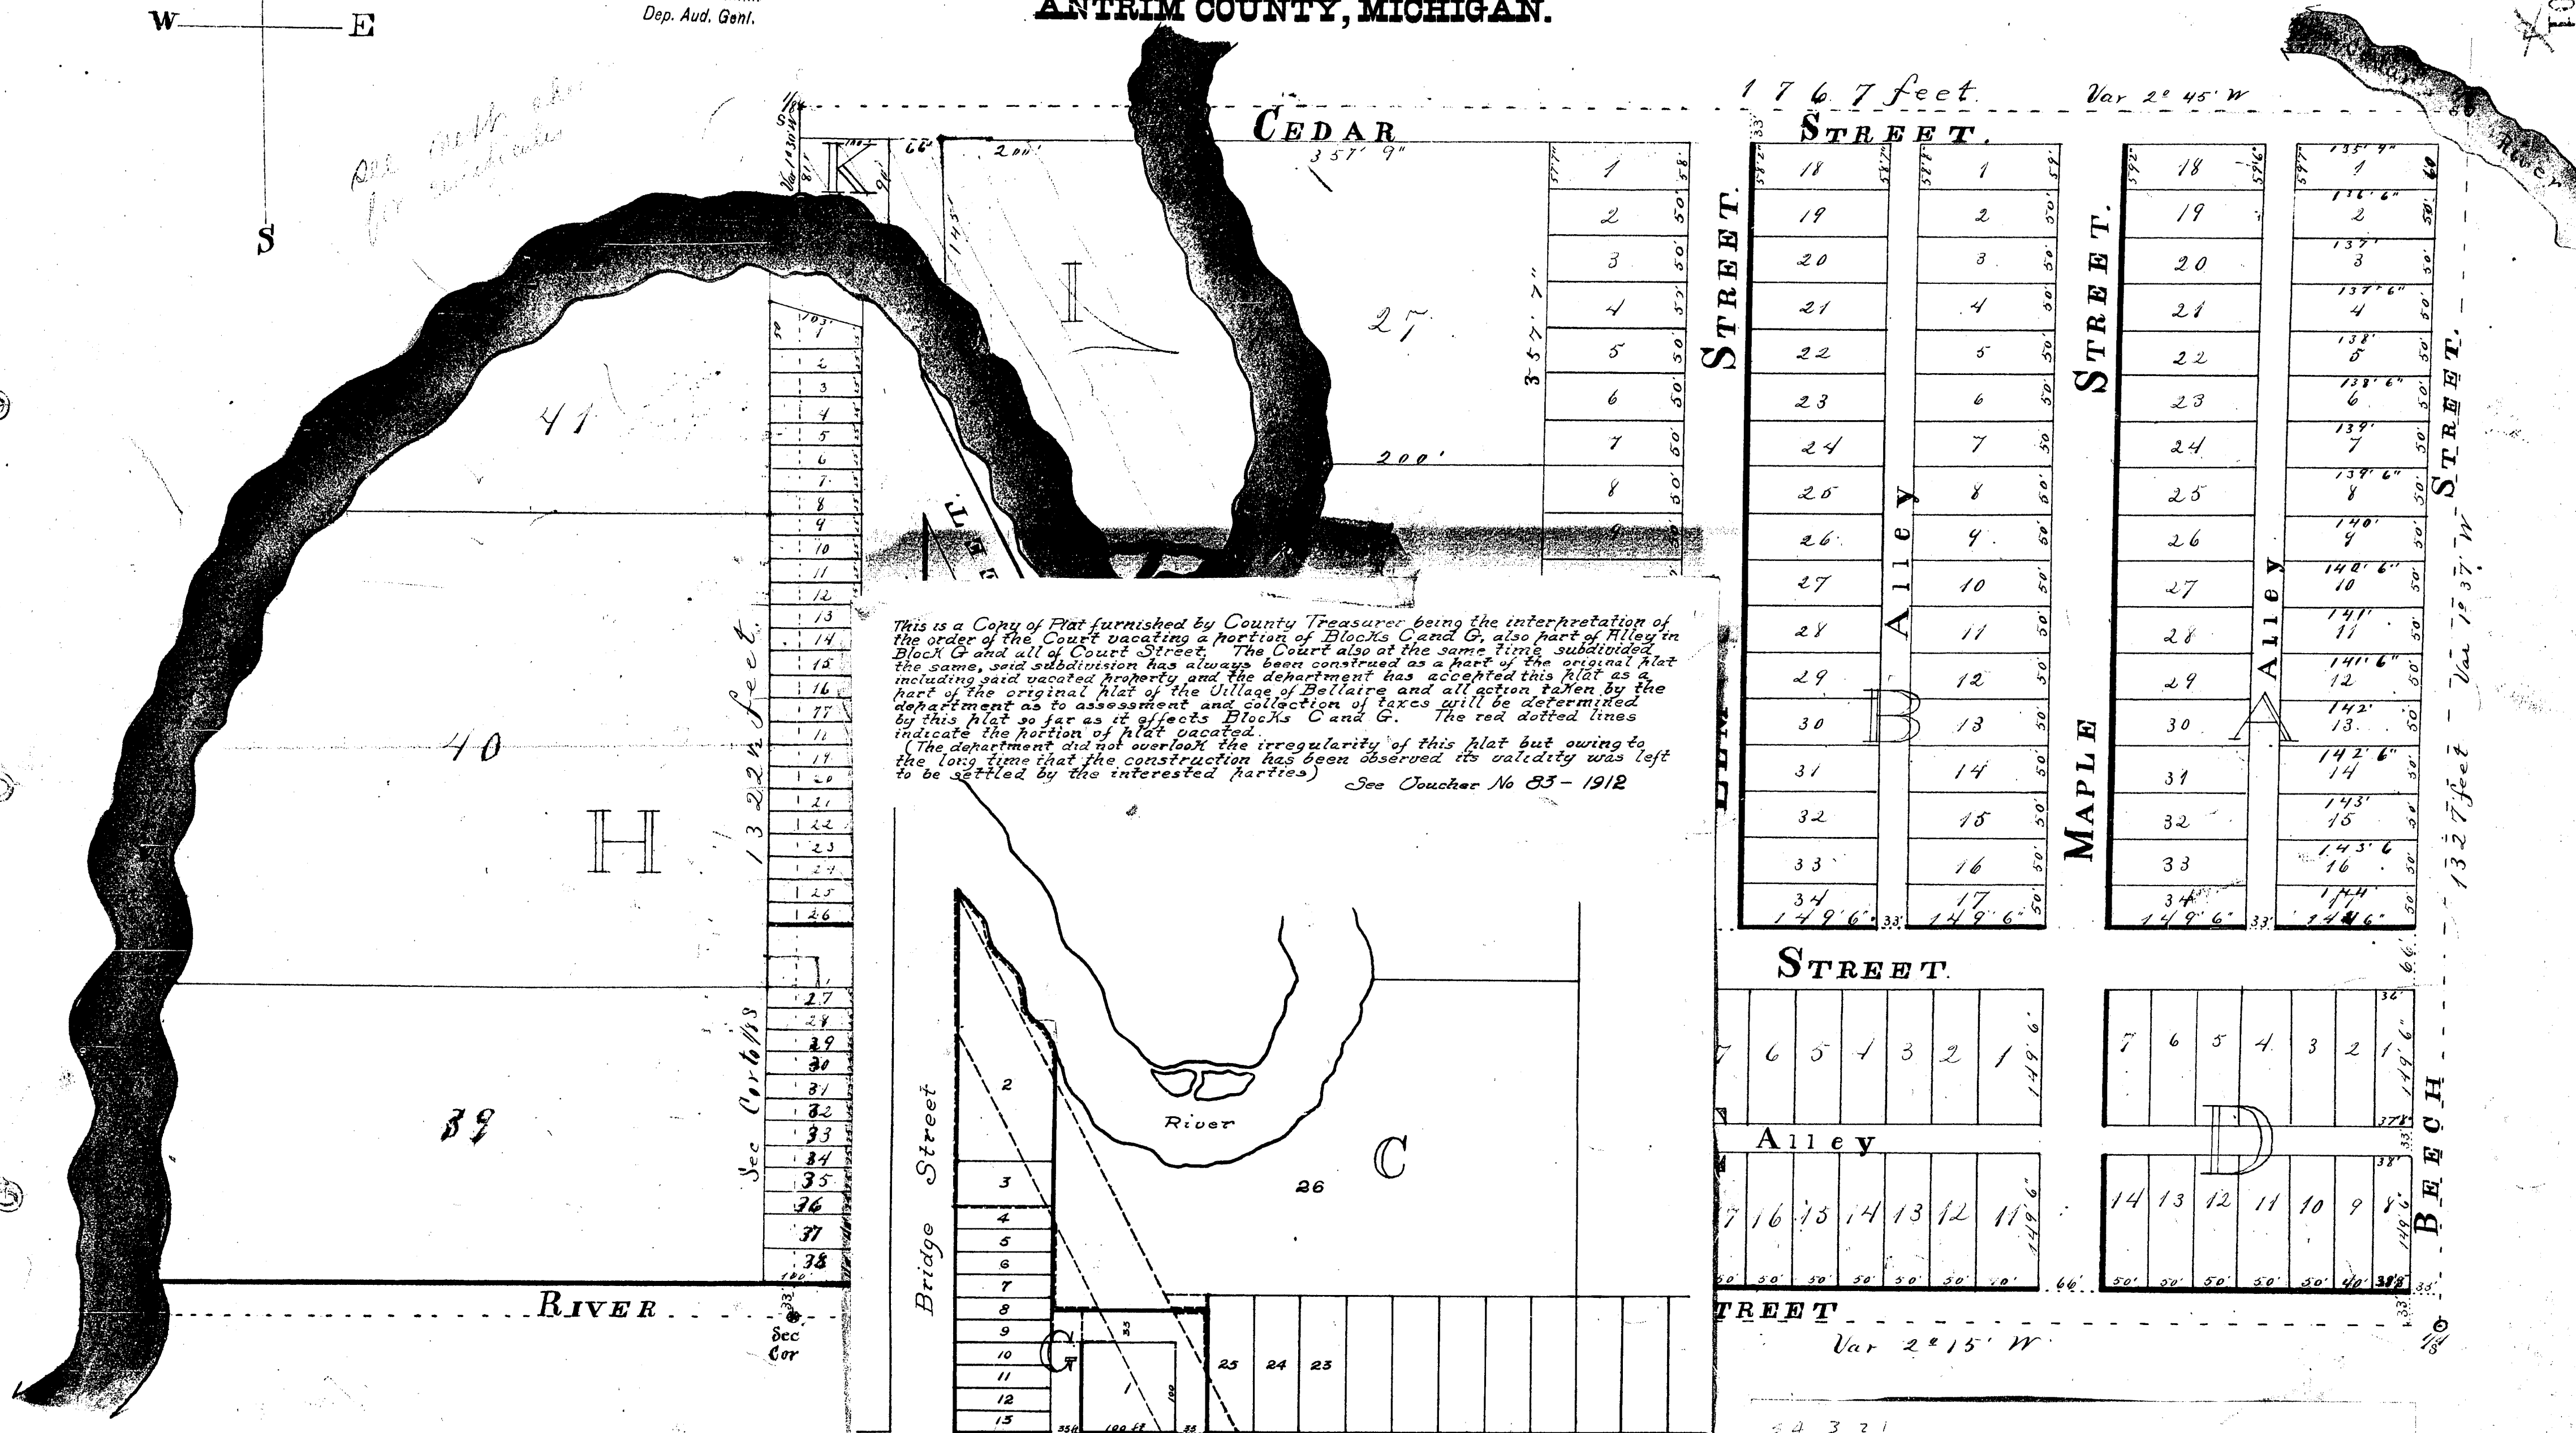


This is a Copy of Plat furnished by County Treasurer being the interpretation of the order of the Court vacating a portion of Blocks C and G, also part of Alley in Block G and all of Court Street. The Court also at the same time subdivided the same, said subdivision has always been construed as a part of the original plat including said vacated property and the department has accepted this plat as a part of the original plat of the Village of Bellaire and all action taken by the department as to assessment and collection of taxes will be determined by this plat so far as it affects Blocks C and G. The red dotted lines indicate the portion of plat vacated.
(The department did not overlook the irregularity of this plat but owing to the long time that the construction has been observed its validity was left to be settled by the interested parties) See Voucher No 83-1912

Scale 120 feet to the inch


176.7 feet		Var 2° 45' W	
Cedar Street		Maple Street	
18	1	18	1
19	2	19	2
20	3	20	3
21	4	21	4
22	5	22	5
23	6	23	6
24	7	24	7
25	8	25	8
26	9	26	9
27	10	27	10
28	11	28	11
29	12	29	12
30	13	30	13
31	14	31	14
32	15	32	15
33	16	33	16
34	17	34	17
149' 6"	149' 6"	149' 6"	149' 6"
Alley		Alley	
6	1	7	1
5	2	6	2
4	3	5	3
3	4	4	4
2	5	3	5
1	6	2	6
149' 6"	149' 6"	149' 6"	149' 6"
Alley		Alley	
7	1	14	1
16	2	13	2
15	3	12	3
14	4	11	4
13	5	10	5
12	6	9	6
11	7	8	7
149' 6"	149' 6"	149' 6"	149' 6"
Alley		Alley	
16	1	14	1
15	2	13	2
14	3	12	3
13	4	11	4
12	5	10	5
11	6	9	6
149' 6"	149' 6"	149' 6"	149' 6"
Alley		Alley	
16	1	14	1
15	2	13	2
14	3	12	3
13	4	11	4
12	5	10	5
11	6	9	6
149' 6"	149' 6"	149' 6"	149' 6"
Alley		Alley	
16	1	14	1
15	2	13	2
14	3	12	3
13	4	11	4
12	5	10	5
11	6	9	6
149' 6"	149' 6"	149' 6"	149' 6"

701

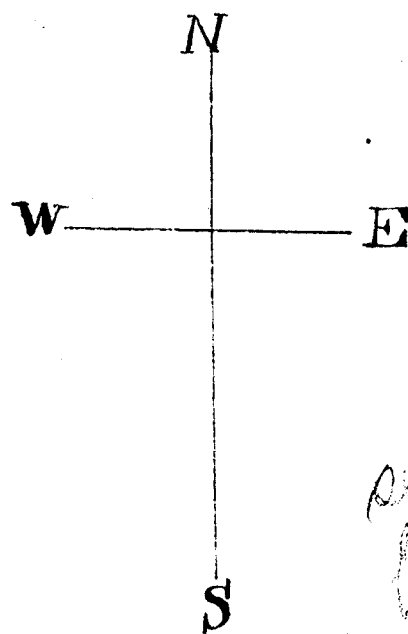

RECEIVED AND FILED
In Auditor General's Office,
July 3, 1879
H. R. Pratt
Dep. Aud. Genl.

PLAT OF THE VILLAGE OF BELLAIRE, ANTRIM COUNTY, MICHIGAN.

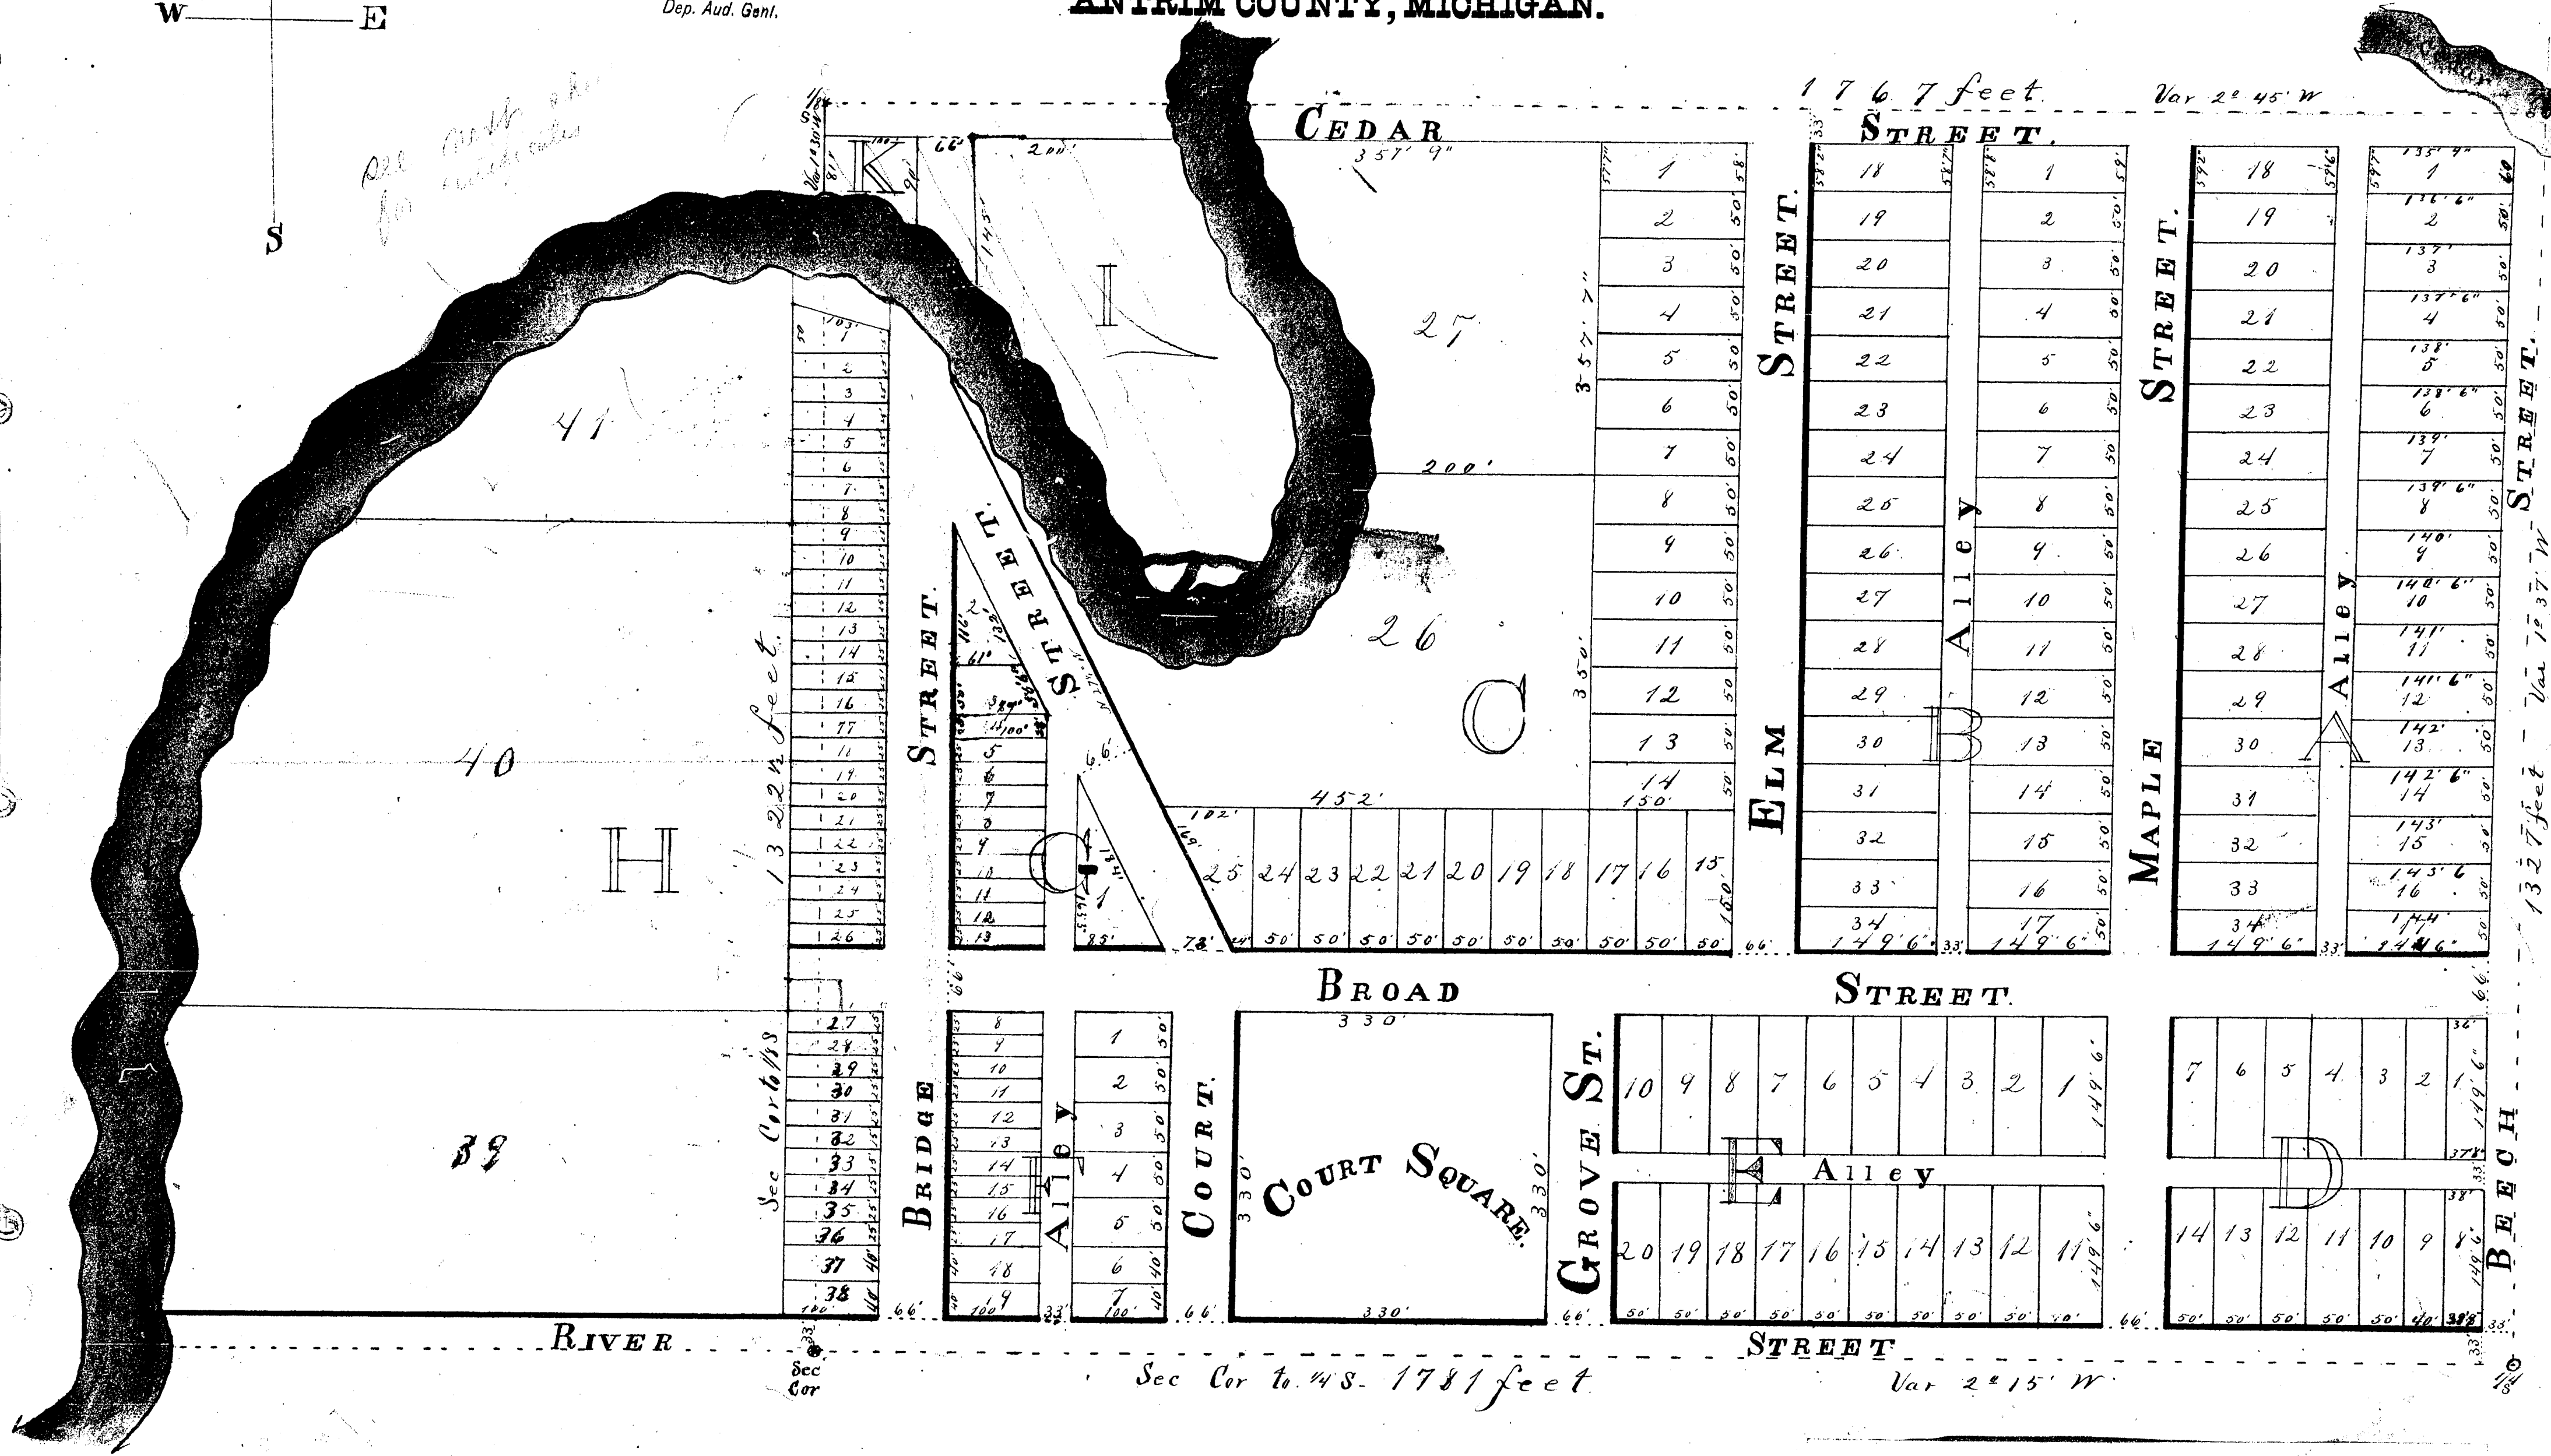

Scale 120 feet to the inch

Part of PLAT VACATED
RE VOL. 1 of VACATIONS
Page 18-20

See two orders

79471

Location

Plat showing the size form and No. of lots, location name course and width of streets, and width of Alleys; in the village of Bellaire in the south fractional half of the south west fractional quarter of Section 19 in Town 30 North of Range 7 West and in the south east quarter of the south east quarter of Section 24 in Town 30 North of Range 8 West - all in Antrim County and State of Michigan; bounded as follows to wit. - Beginning at the Section corner on Range line between Sections 19 and 30 in Town 30 North of Range 7 West and Sections 24 and 25 in Town 30 North of Range 8 West - thence North $87^{\circ} 45'$ East (magnetic) on the south line of said Section 19, 1,781 feet to $1/4$ between Sections 19 and 30. - thence North $1^{\circ} 37'$ West (magnetic) on the $1/4$ line 1,327 feet to $1/8$ - thence South $87^{\circ} 15'$ West (magnetic) 1,767 feet to $1/8$ on Range line - thence South $1^{\circ} 30'$ East (magnetic) 1,322 $1/2$ feet to place of beginning - also all that part of Section 24 Town 30 North of Range 8 West lying East of Intermediate River - Lots (1) one to (38) thirty eight inclusive of Block "C" are each 100 feet long and 111 feet East and 29 feet West of the Range line -

The Government corners effecting this survey were re-established and perpetuated from unmistakable witnesses.

The complete Blocks and Lots are right parallelograms having their respective dimensions marked in feet thus (') and inches thus (")

Blocks are designated by red capital letters - Numbers of Lots are indicated by red figures

State of Michigan } ss. We John A. Harriman, Register of Deeds of said County and David C. McVean Surveyor hereby certify that we have carefully compared the annexed plat with the plat of the Village of Bellaire on record in the Office of the said Register of Deeds and that it is a true transcript thereof and of the whole of such record.

John A. Harriman Register of Deeds.

D. C. McVean Surveyor.

Certificates

Know all men by these presents that we the undersigned Ambrose E. Palmer and Mattie L. Palmer his wife as Proprietors and David C. McVean as Surveyor have plotted the above described pieces of land to be known as the Village of Bellaire and the said parties do hereby dedicate to the use of the Public all the Streets, Alleys and Public ground as shown on the annexed plat. Witness our hands and seals this 23^d day of June A.D. 1879.

Witnesses
Charles E. Kirk
D. C. McVean

Ambrose E. Palmer. LS
Mattie L. Palmer LS
D. C. McVean. LS

State of Michigan } ss. County of Nankaska } On this 23^d day of June A.D. 1879 before me a Notary Public in and for said County personally appeared Ambrose E. Palmer and Mattie L. Palmer his wife and David C. McVean as Surveyor known to me to be the persons who executed the above instrument and acknowledged the same to be their free act and deed.

T. J. Lyne
Notary Public
For Nankaska County.

State of Michigan } ss. County of Antrim } We John A. Harriman Register of Deeds for said County and David C. McVean the Surveyor who made the plat of the Village of Bellaire hereby certify that we have carefully compared this copy with the said original plat of the Village of Bellaire and it is an exact copy thereof and of the whole of such map or plat.

John A. Harriman Register of Deeds.




D. C. McVean Surveyor.

Register Office } ss. Antrim County } I hereby certify that this plat of the Village of Bellaire was received for record the 24th day of June A.D. 1879 at 2 o'clock P.M. and recorded in plat book liber A. page 10



John A. Harriman Register of Deeds.

RECEIVED AND FILED
In Auditor General's Office,
July 3 1879
H. V. Bull
Dep. Aud. Genl.

PLAT OF THE VILLAGE OF BELLAIRE, ANTRIM COUNTY, MICHIGAN.

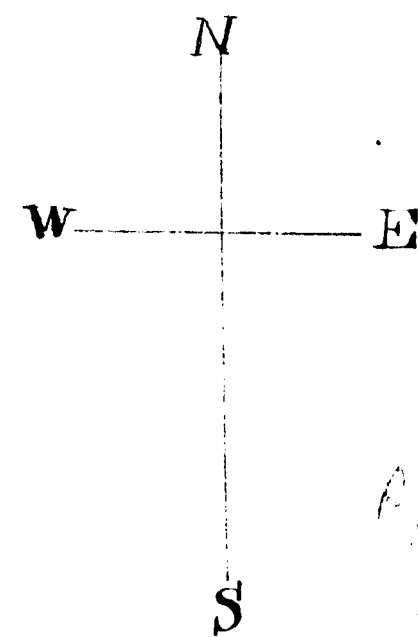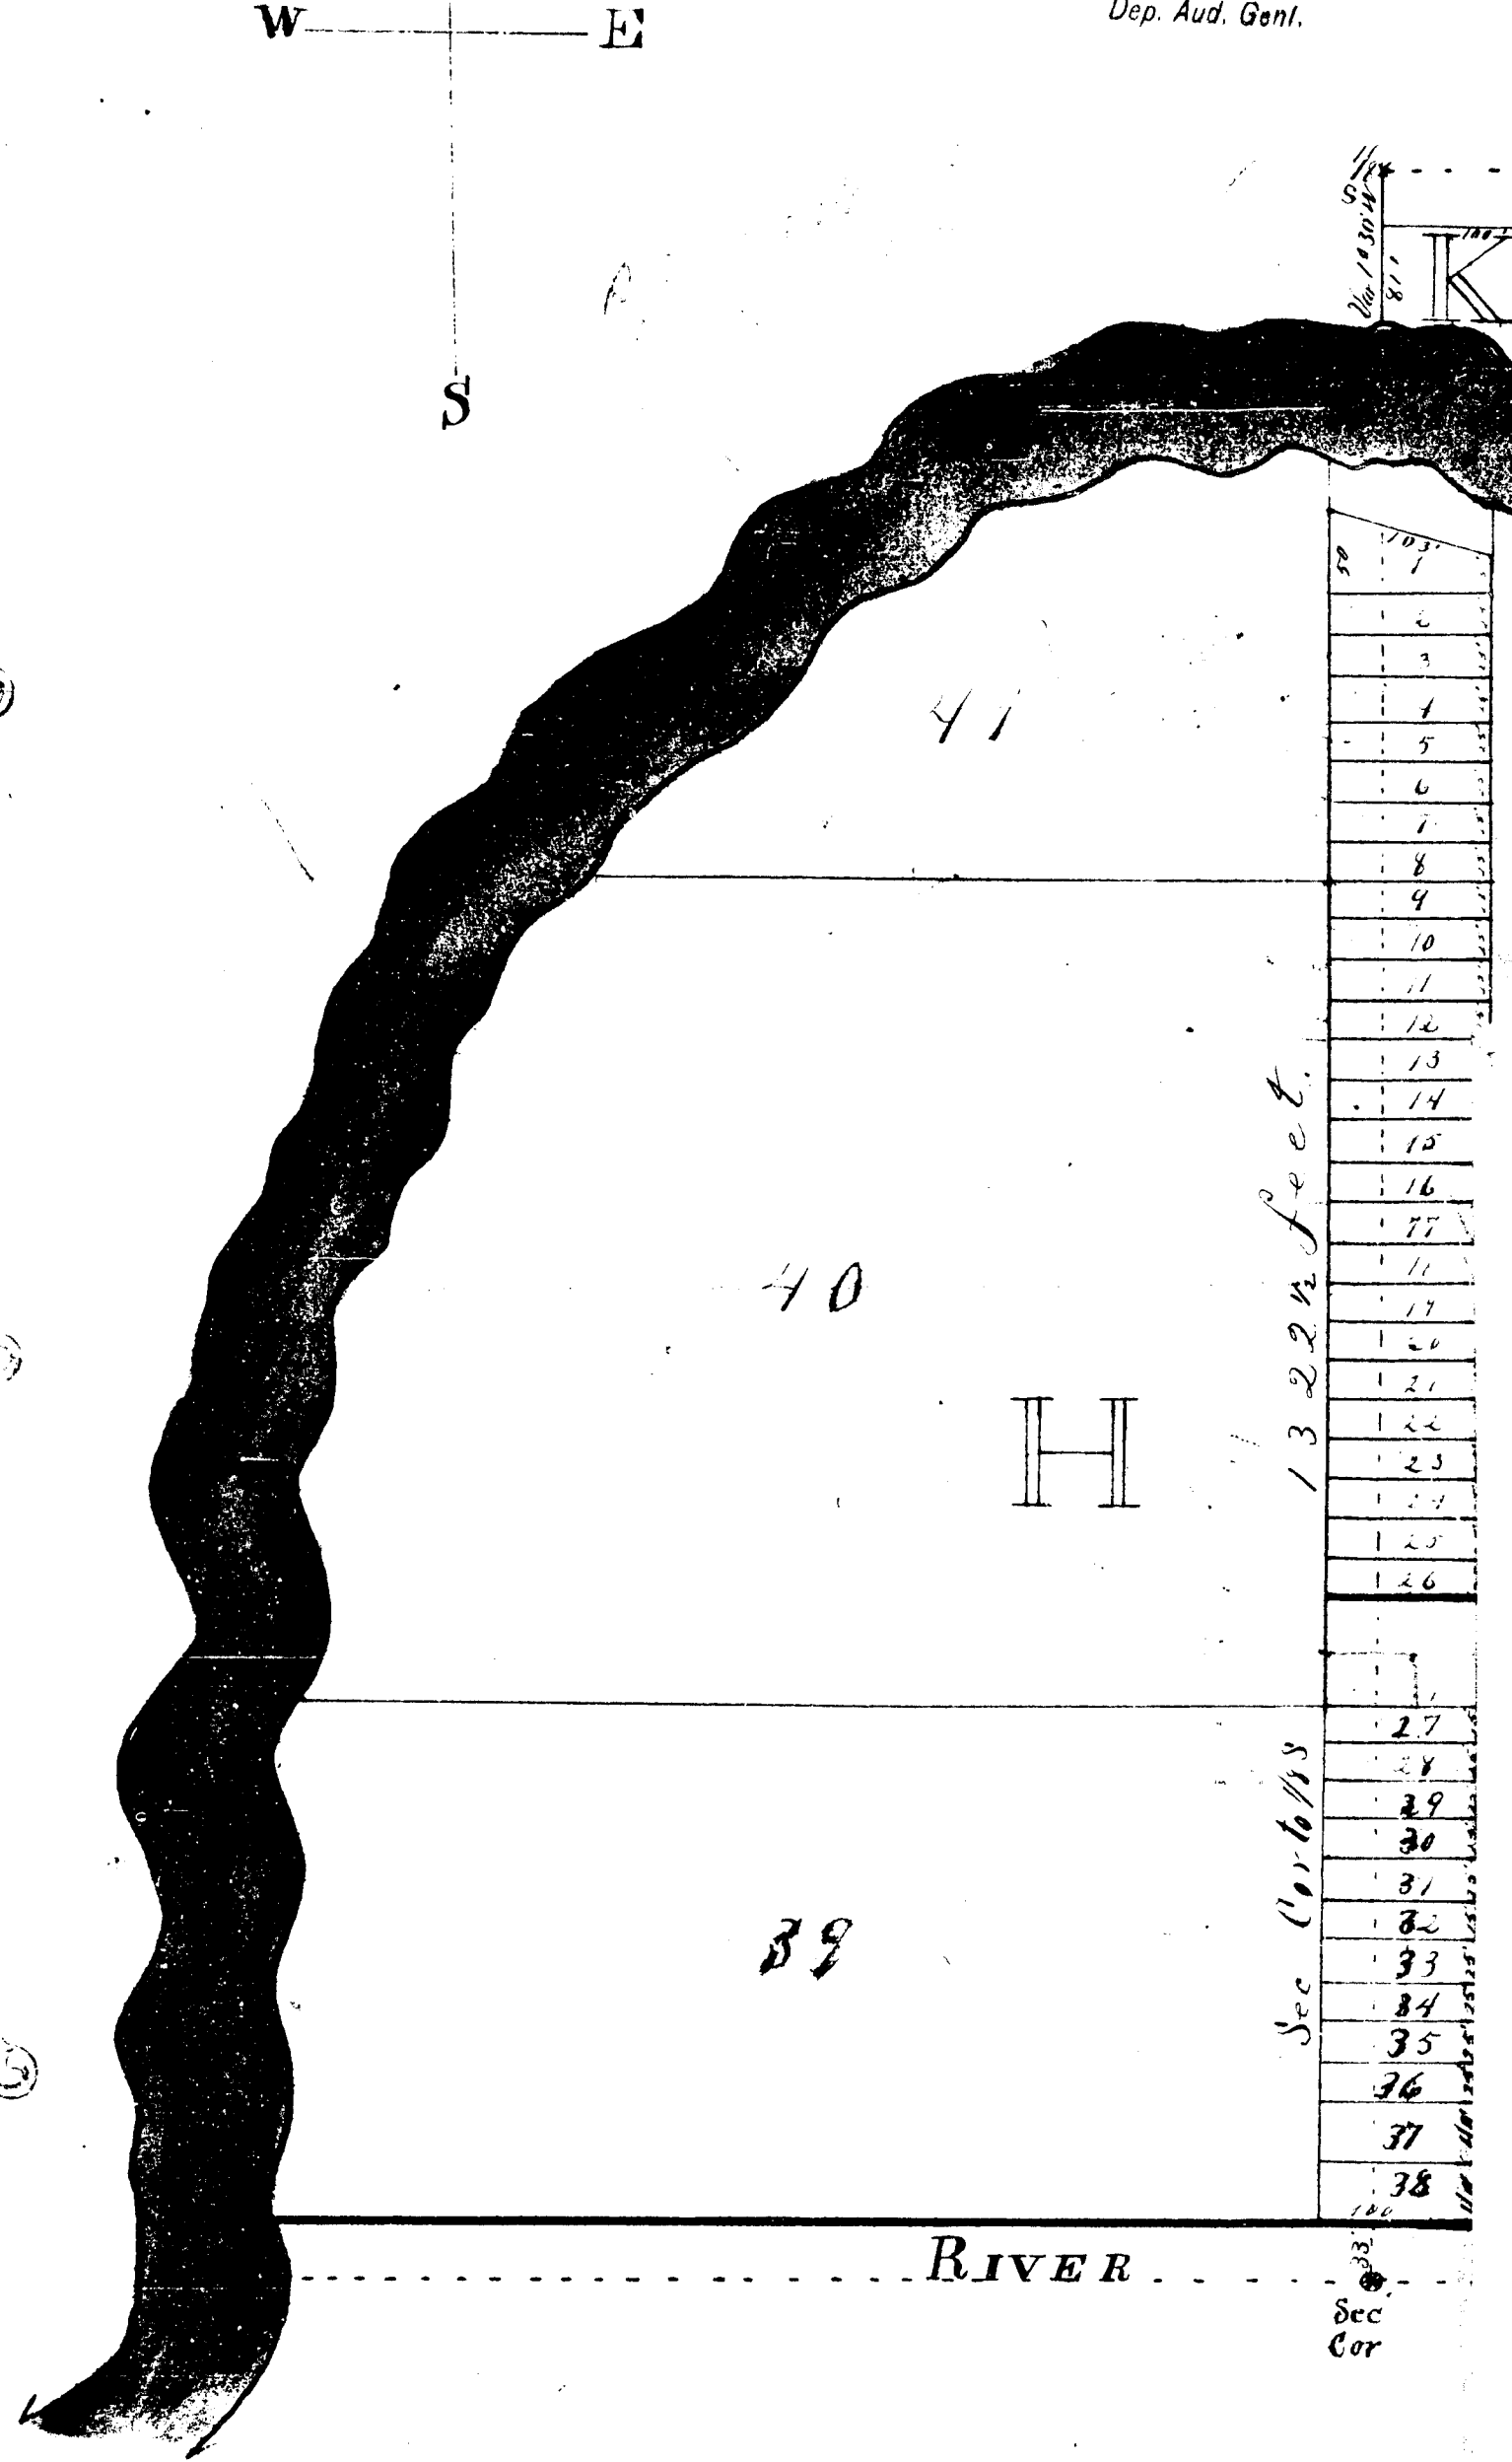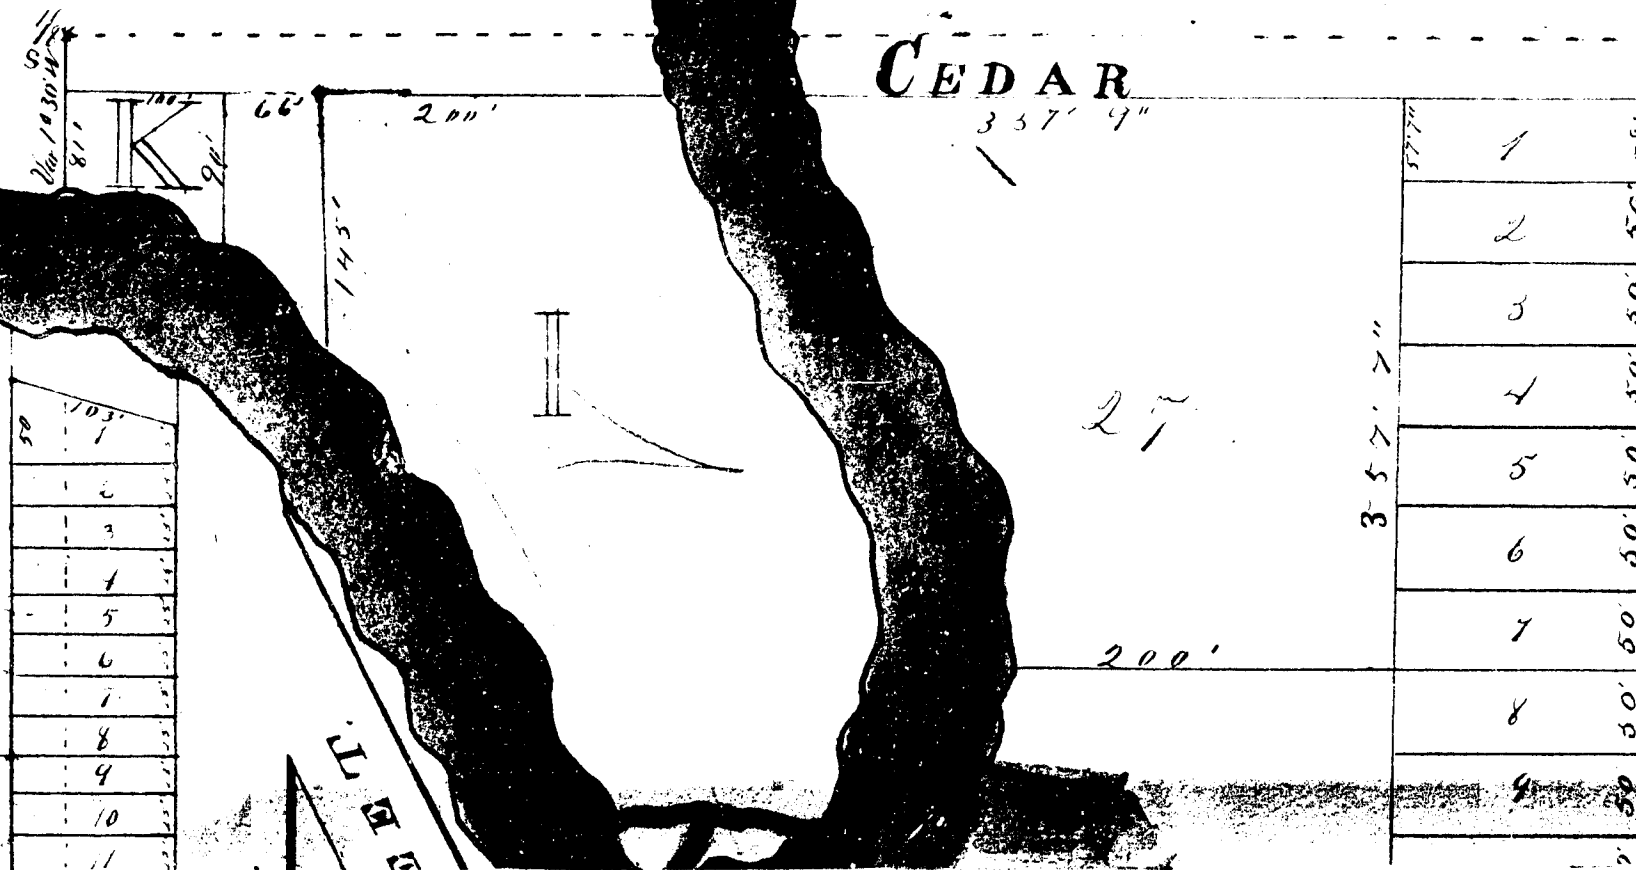


This is a Copy of Plat furnished by County Treasurer being the interpretation of the order of the Court vacating a portion of Blocks C and G, also part of Alley in Block G and all of Court Street. The Court also at the same time subdivided the same, said subdivision has always been construed as a part of the original plat including said vacated property and the department has accepted this plat as a part of the original plat of the Village of Bellaire and all action taken by the department as to assessment and collection of taxes will be determined by this plat so far as it affects Blocks C and G. The red dotted lines indicate the portion of plat vacated. (The department did not overlook the irregularity of this plat but owing to the long time that the construction has been observed its validity was left to be settled by the interested parties) Seeoucher No 83-1912

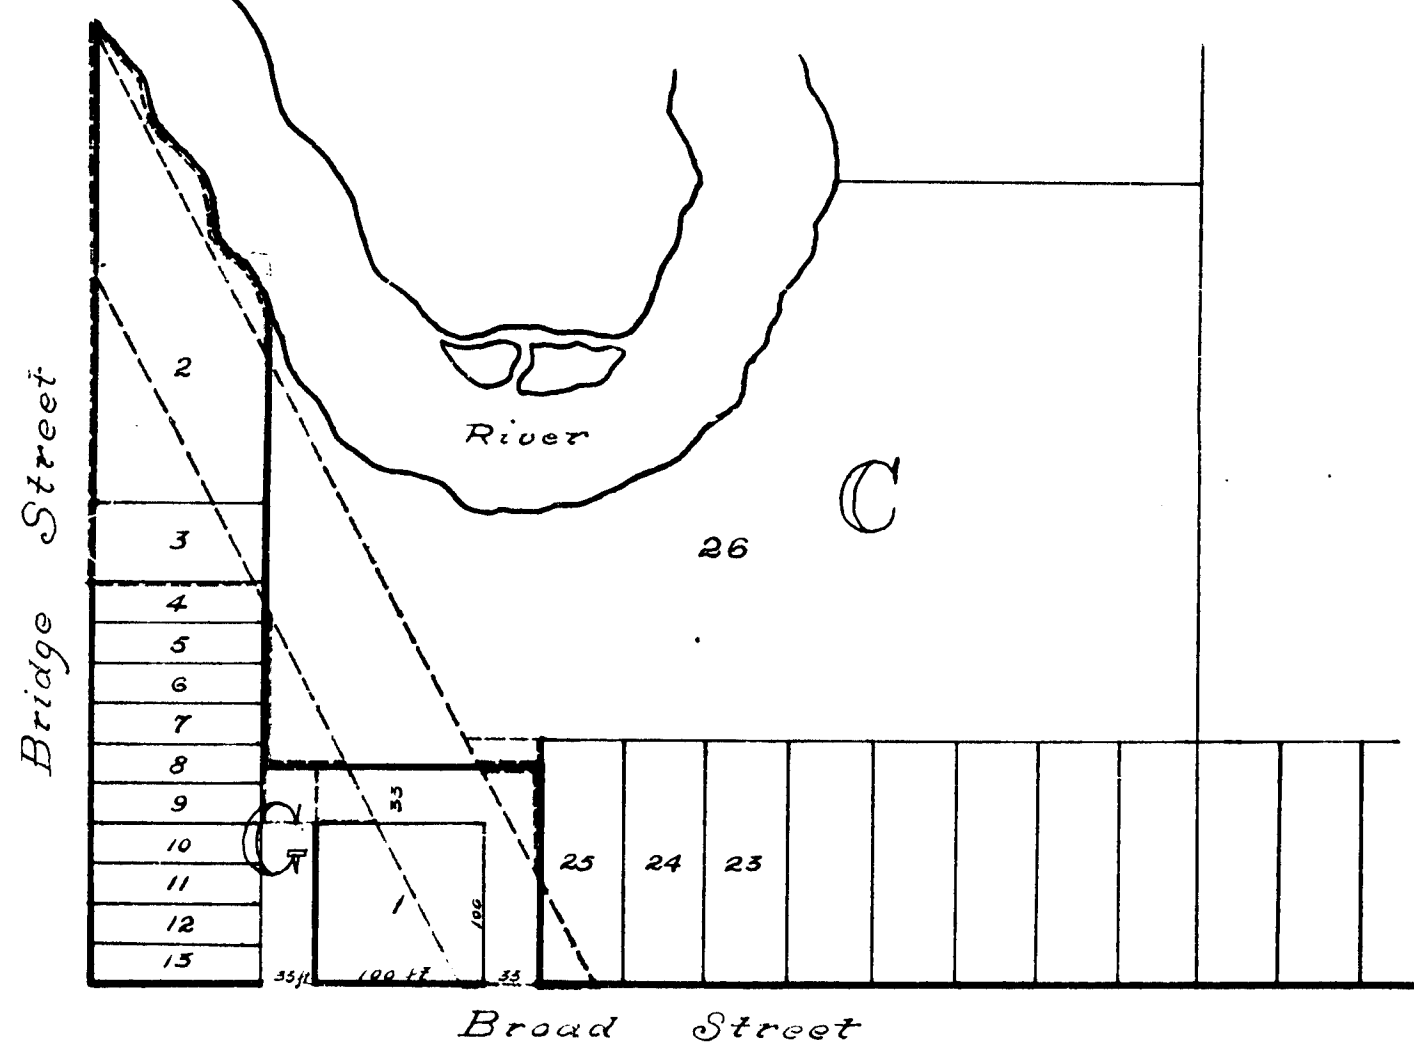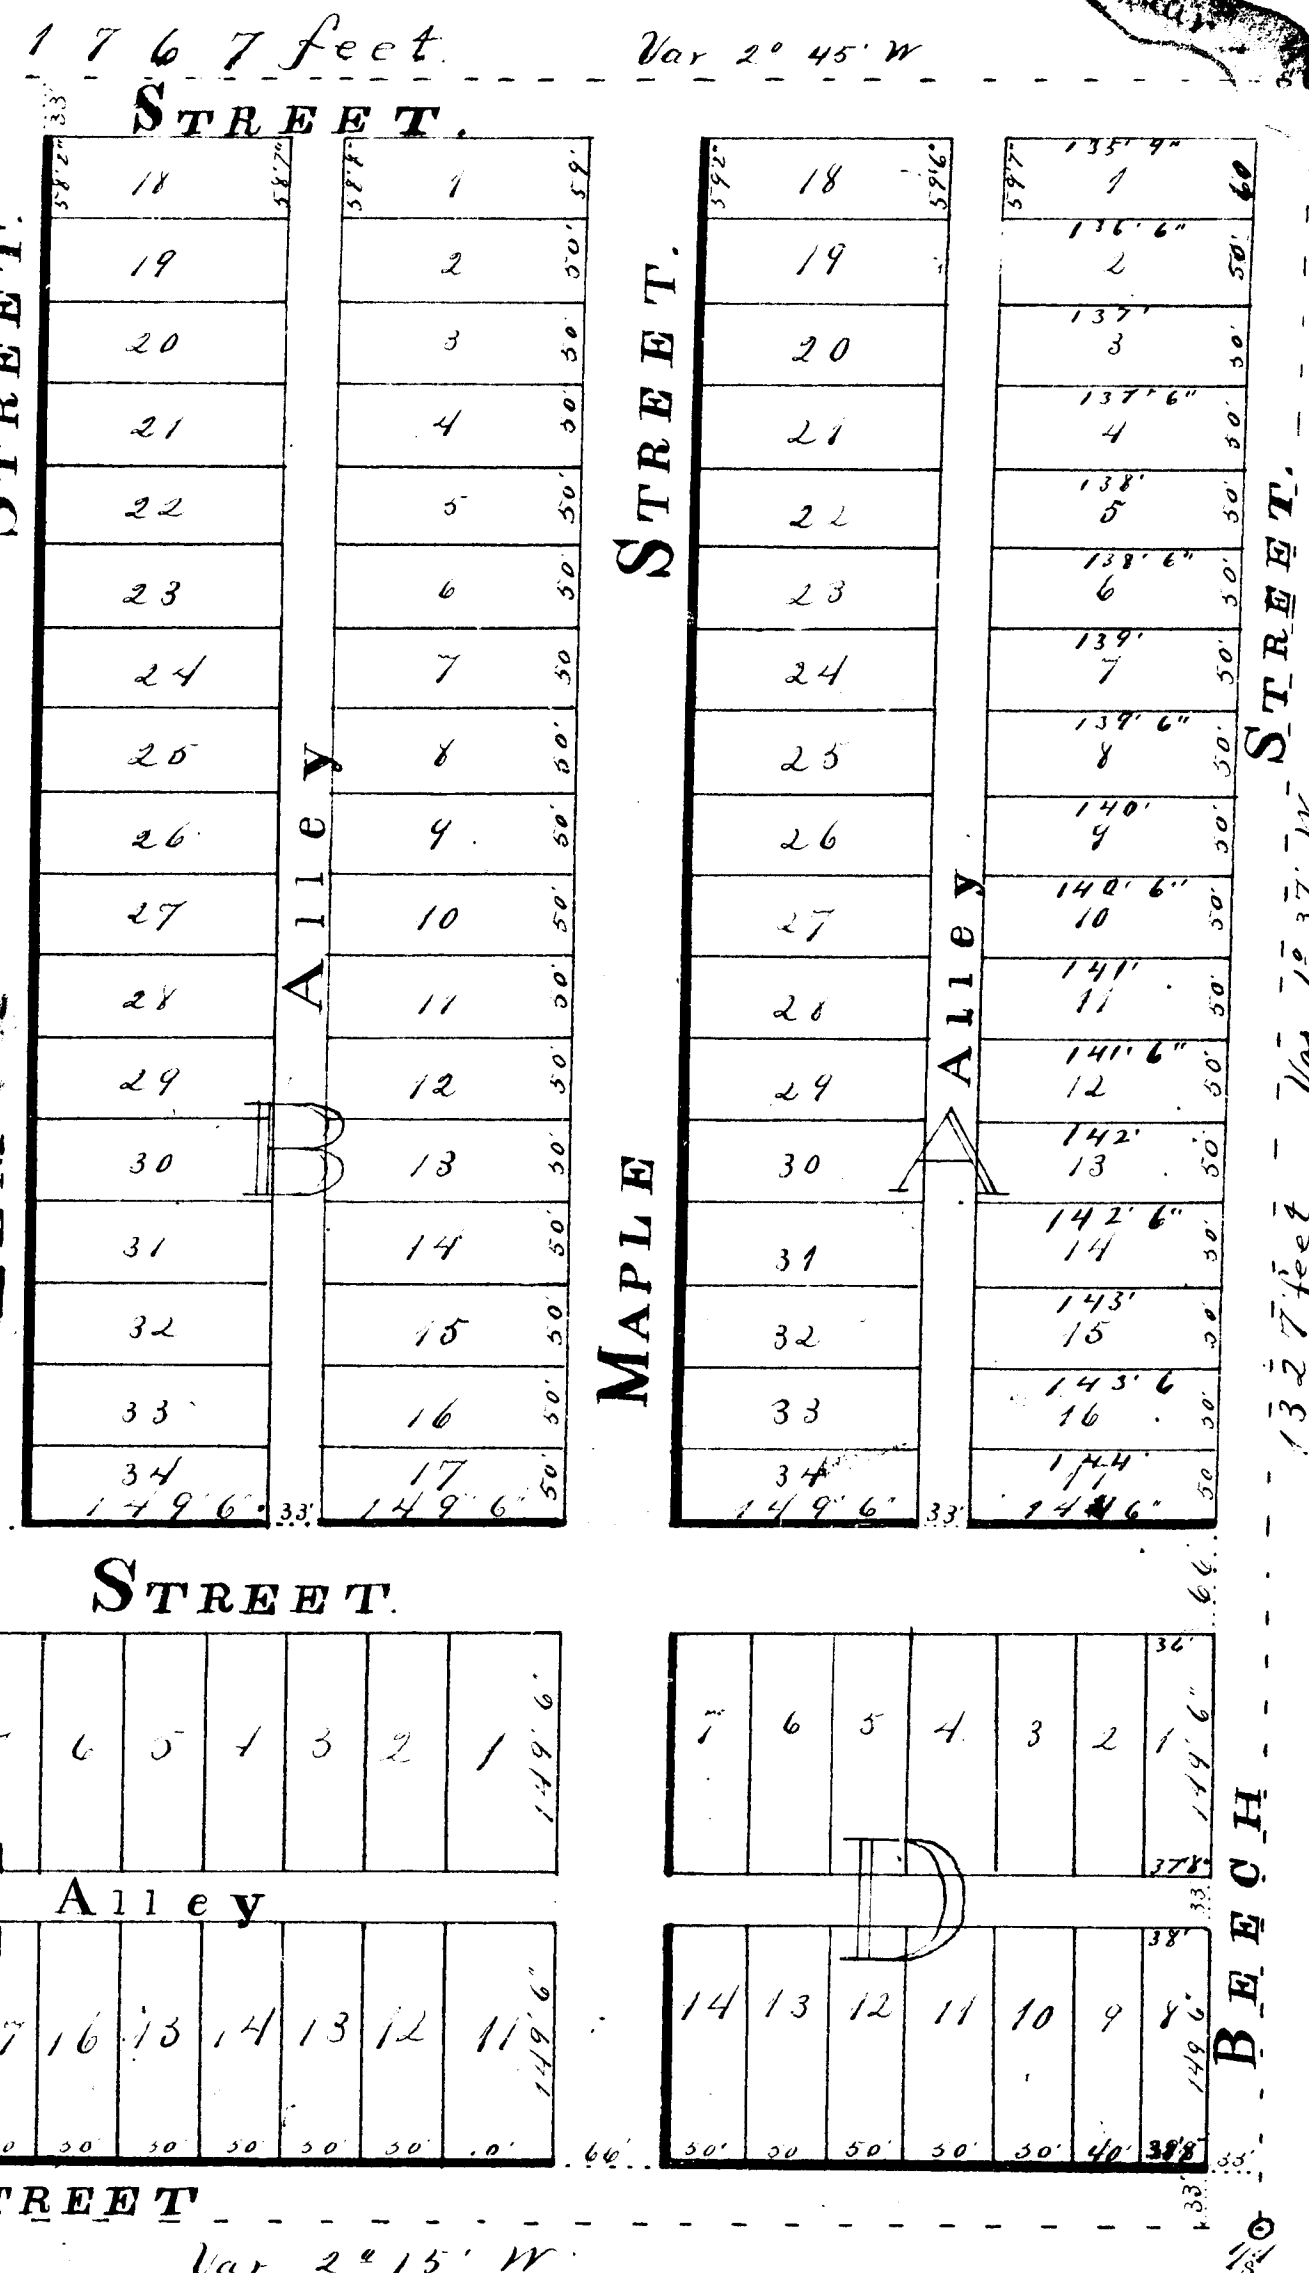


Scale 120 feet to the inch

1446

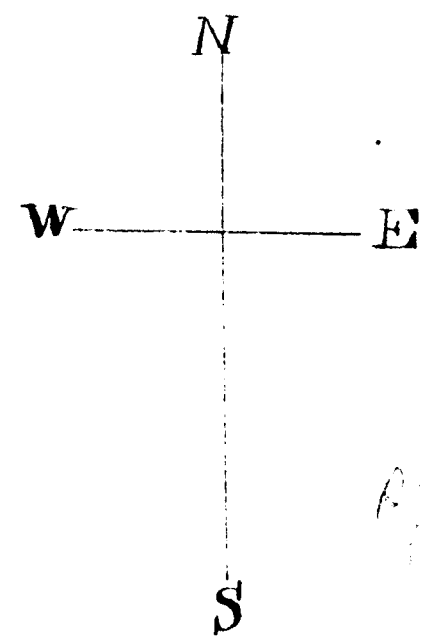

RECEIVED AND FILED
In Auditor General's Office,
July 3 1879
R. D. Bull
Dep. Aud. Genl.

PLAT OF THE
VILLAGE OF BELLAIRE,
ANTRIM COUNTY, MICHIGAN.

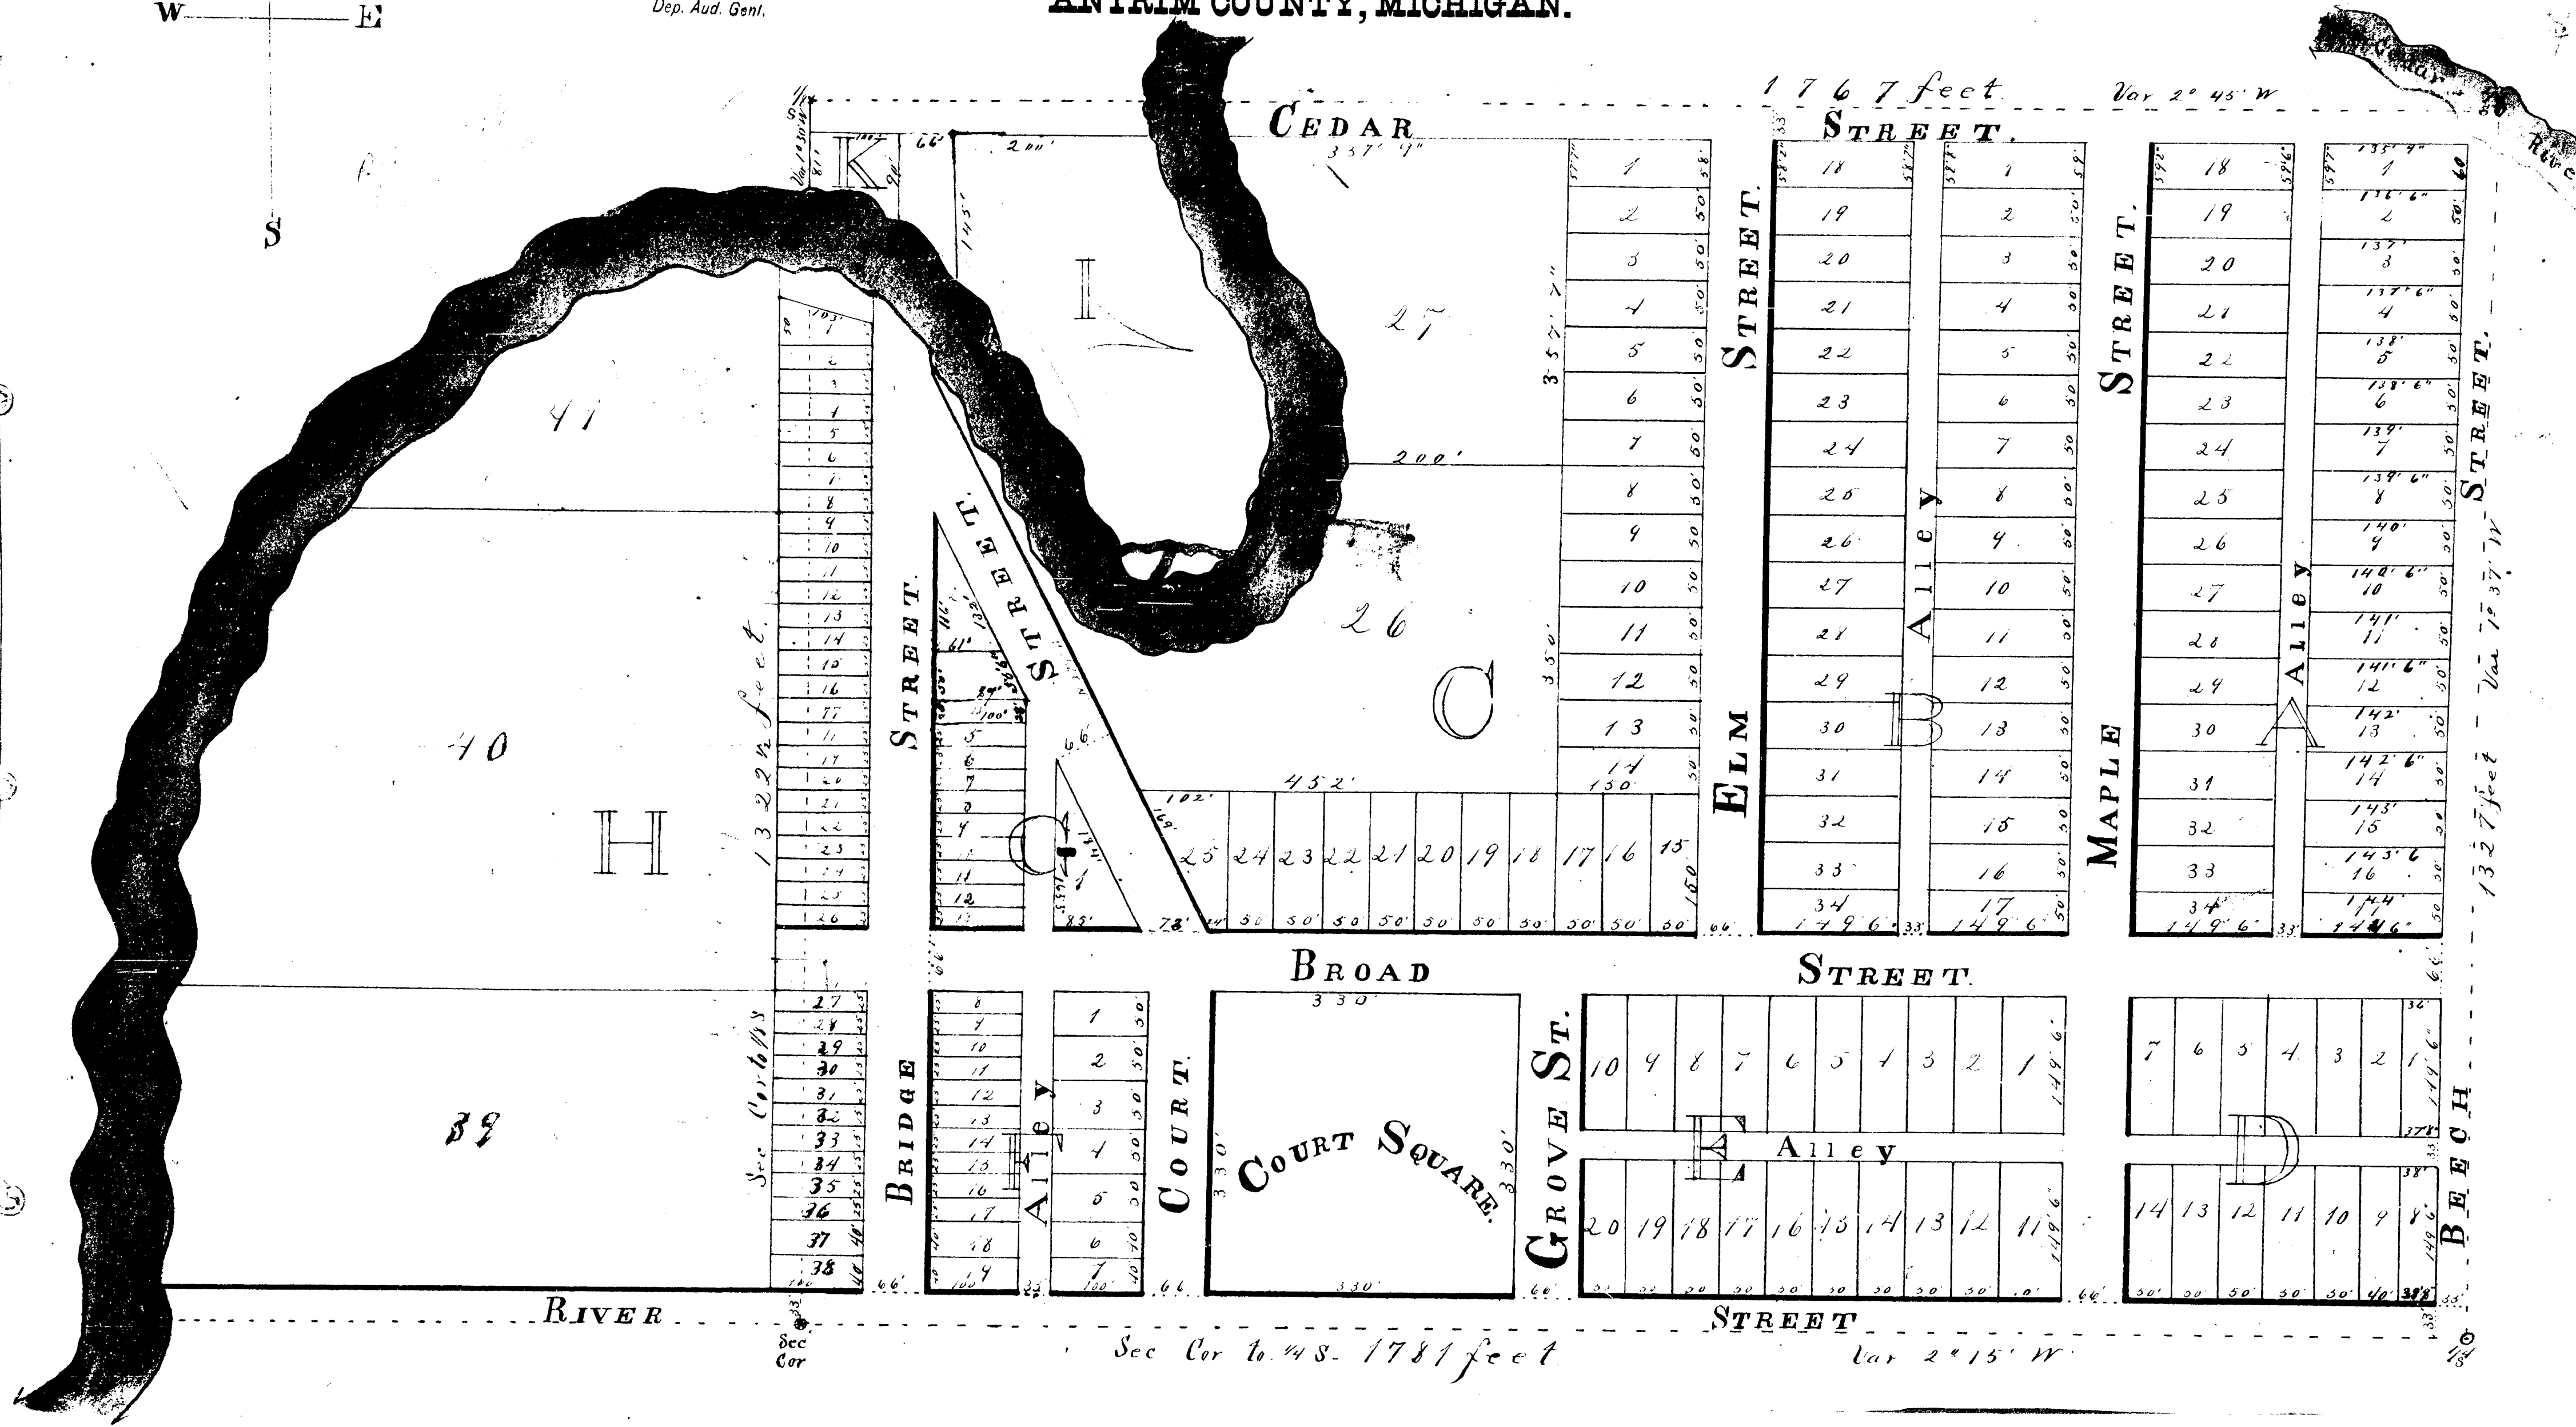

Scale 120 feet to the inch

97641

PLAT- VILLAGE OF BELLAIRE

Circuit Court May 17-1905

Received for record May
18-1905
Miss Liber 1 page 58

In re petition)
of Fred S. Flye)
and Ira A. Adams)
to vacate part of
PLAT)


ORDERED: That all that portion of the Plat of the Village of Bellaire in the County of Antrim and State of Michigan described in said petition and as hereinafter more particularly described be and the same is hereby vacated and attached to Lot No. twenty seven (27) of the Village of Bellaire aforesaid, said parcels of said Plat hereby vacated and attached to said Lot No. Twenty seven (27) is situate in the Village of Bellaire, County of Antrim and state of Michigan and is more particularly described as follows viz;

Commencing at the West end of Broad Street and on the South side thereof, which point would be at the North west corner of Lot Twenty seven (27) of Block H. in said Village of Bellaire, run thence North parallel with the West line of said Broad Street 26 feet, Thence East parallel with the North line of said Lot number 27 of Block H. 60 feet, Thence South parallel to the West end of said Broad Street 26 feet, to the North line of said Lot number 27 of Block H. Thence West 60 feet, along the North line of said Lot number 27 of Block H to point of commencement and to attach said parcel to said Lot number 27 of Block H.

Frederick M. Wayne,
Circuit Judge

Curtis & Taylor
Plat Examiners

Vol. 179. Page-14466

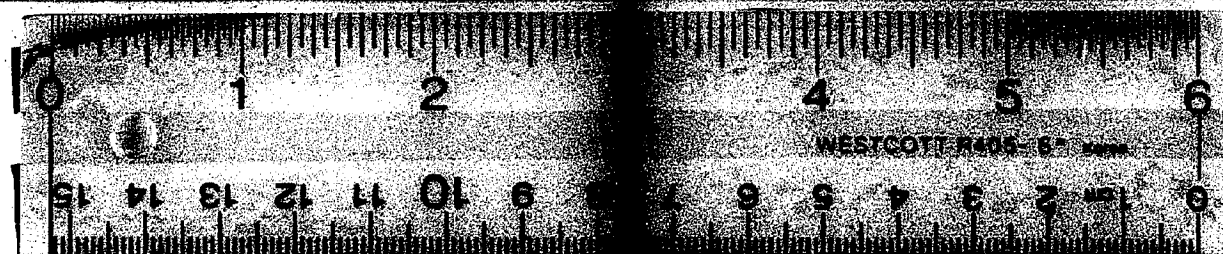

16 X

PLAT- VILLAGE OF BELLAIRE (ORIGINAL)

Circuit Court Journal
Liber 2 page 55-Nov 12-1884

Petition to alter and vacate Plat

All that portion of Cedar Street, Bridge Street and Blocks F and K and all other portions of the original plat of village of Bellaire, according to plat recorded in the office of the Register of Deeds of said county of Antrim, on 24th of June 1879 lying North of Intermediate River be and the same is hereby vacated- And it is further ordered that in lieu of such streets so vacated such portions of land, as are necessary to join with other portions of lands, heretofore platted, or dedicated as will make a streets 85 feet, in width extending from south line of Richardi and Bechtold's Addition to village of Bellaire to north line of the original plat of said village of Bellaire, 50 feet- of said street to lie to the east and 35 feet, to lie to the west of the following line Beginning at south west corner of Richardi's Bechtold's addition to village of Bellaire, go south on the range line to south west corner of North west fractional $\frac{1}{4}$ of south west fractional $\frac{1}{4}$ of section 19, Township 30 N of Range 7 West State of Michigan, and also the piece or parcel of land bounded by following lines Beginning at S W corner of N W fractional $\frac{1}{4}$ of N W fractional $\frac{1}{4}$ of section 19, Township 30, N of R 7 West 20 east 50 feet, thence south 13 degrees east to Intermediate River, thence along said river, to a point lying south 13 degrees east, Thence in straight, line to beginning, be and the same is hereby dedicated to public use.

Petitioners (Rupert Richardi Frederick Bechtold
(Louise Richardi Maxine Luis Bechtold

Voucher No- 83- 1912 Vol- 179- Page 14466

PLAT- VILLAGE OF MAUCELONA

Circuit Court, Journal Liber 2 page 103
May 4-1886

Ashbury Lybarker
Julia Lybarker
Perry G Rogers
F Jackson
Sarah Rogers
H R Hale and
E Spencer

Petition to vacate plat
of Portion of Village of Maucelona

ORDERED: That the plat of the South $\frac{1}{2}$ of Lot 5, Lots 6-7-8-9-and 10, and the alley lying between Lots 7 and 8, and Lots 9 and 10 of the Plat of Maucelona Antrim County, be and the same is hereby vacated.

J G Ramsdell
Circuit Judge

Curtis & Taylor
Plat Examiners

Vol- 179- Page 14465