
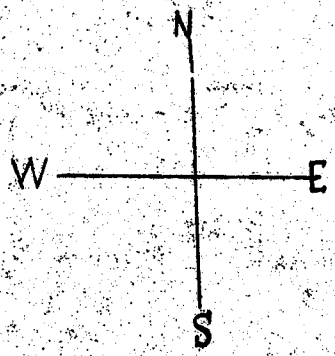


County of Antrim }
 Deeds for said County, and Edward Hobden
 The Surveyor who made the original Plat of the Village of Wetzell
 is hereby certified that we have carefully compared this duplicate
 with the said original Plat of said Village of Wetzell and that it is
 and exact duplicate thereof and of the whole of said original Plat
 John A. Harriman Register of Deeds
 Edward Hobden Surveyor

Register's Office }
 Antrim County }
 Received for Record the 10th day of February
 1882 at 3 O'clock PM and Recorded in
 Liber A of Village Plots at Page 17
 John A. Harriman
 Register of Deeds

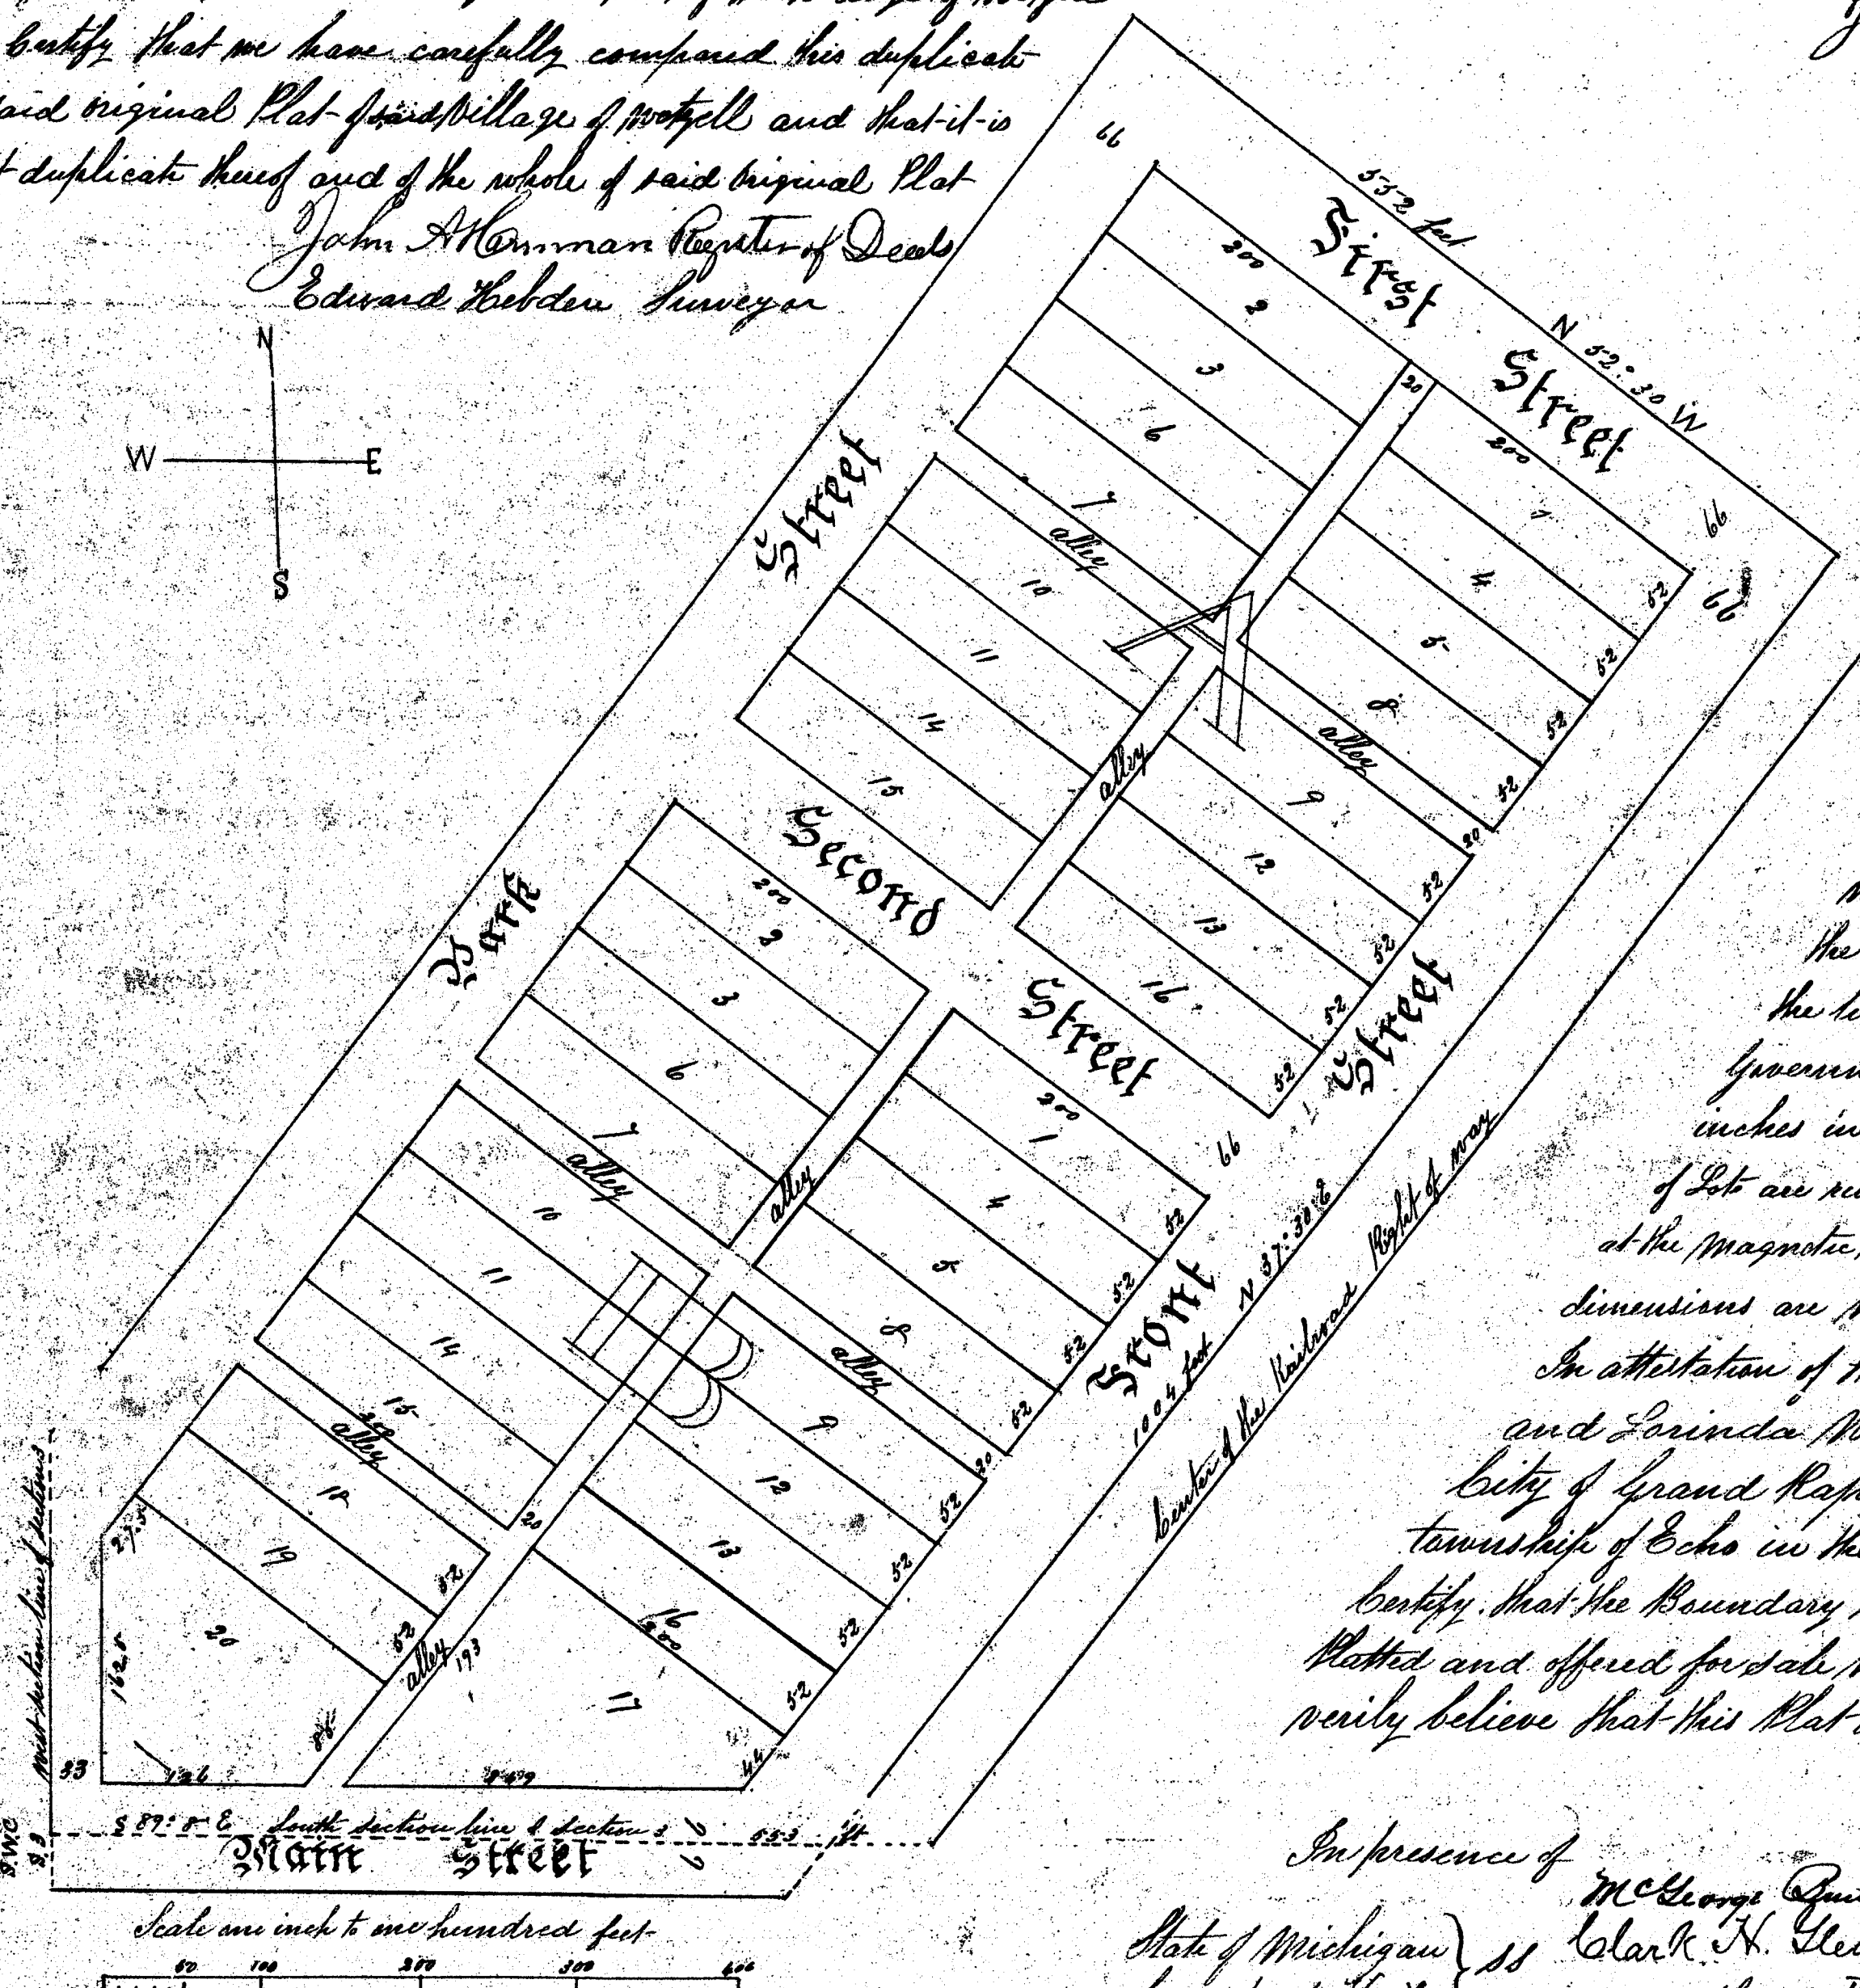

RECEIVED AND FILED
 Auditor General's Office,
 March 11 1882
 W. R. Pratt
 Dep. Aud. Genl.

PLAT
 of the
 Village of Wetzell
 Antrim County
 MICHIGAN

The Village of Wetzell as delineated by this Plat is situated on the south west and fourth of
 the south west and fourth of section three, in township No. twenty nine North of Range 10, in
 west Antrim County Michigan. The south east corner of Lot No. sixteen Block B is deter-
 mined by measuring East on the section line, one hundred and fifty three feet, to the center of
 the Railroad Right of Way; then North fifty two degrees and thirty minutes west, and at right angles to
 the line of Railroad one hundred and sixteen feet, from the south west corner of said section, which
 Government corner was established from one original witness, and from which a large tree twenty
 inches in diameter bears North sixty four degrees East twenty nine and one half feet distant. Boundaries
 of Lots are run North thirty seven degrees and thirty minutes East; and North fifty two degrees and thirty minutes
 at the magnetic variation of one degree East. Blocks are designated by large letters with Red Ink. Lots by small figures.
 Dimensions are marked in feet and tenths, all Lot are right parallelograms, excepting two fractional Lots.
 In attestation of the Laying out of the town Plat above described the Proprietors thereof Henry B. Wetzell
 and Lorinda Wetzell his Wife, Daniel M. Wetzell and Mary H. Wetzell his Wife, all of the
 City of Grand Rapids, in the County of Kent, and State of Michigan and Edward Hobden of the
 township of Echo in the County of Antrim and State of Michigan who surveyed the said Village do hereby
 certify that the Boundary lines of said Village, and the Lots, streets, alleys, and grounds thereof intended to be
 Platted and offered for sale were actually surveyed and laid out in the month of December 1881, and they
 verily believe that this Plat is a faithful representation of said Survey.

Witness their hands this 10th day of January 1882

In presence of
 State of Michigan } ss Clark H. Gleason
 County of Kent }
 Henry B. Wetzell
 Lorinda Wetzell
 Daniel M. Wetzell
 Mary H. Wetzell
 Edward Hobden
 Proprietors
 Surveyor

On this 10th day of January 1882 before
 me the subscriber a Notary Public in and for said County
 personally appeared Henry B. Wetzell, and Lorinda Wetzell his
 Wife, Daniel M. Wetzell, and Mary H. Wetzell, his Wife to me known
 to be the same persons described as Proprietors in and who executed
 this instrument, who severally acknowledged such execution to be
 their free act and deed and that they had laid out the town Plat above
 described and dedicated the same to the use and purposes therein mentioned
 given under my hand the day and year first above written.

Clark H. Gleason
 Notary Public in and for Kent County Michigan



State of Michigan } ss
 County of }
 County Clerk and Clerk of the Circuit Court for said
 County the same being a Court of Record do hereby certify
 that before whom the within
 acknowledgment was taken was at the time such an
 officer as he is represented to be and that I believe the signature
 of such person subscribed thereto to be genuine
 Witness my hand and seal this 10th day of January 1882

State of Michigan }
 County of Antrim }
 John A. Harriman Register of Deeds
 Edward Hobden Surveyor
 hereby certify that we have carefully compared the
 annexed Plat with the Plat of the Village of Wetzell
 now of Record in the Office of said register of Deeds and
 that it is a true transcript therefrom and of the whole
 of such record

1034

14471

County of Antrim }
 Deeds for said County, and Edward Helsten
 the Surveyor who made the original Plat of the Village of Wetzell
 to hereby certify that we have carefully compared this duplicate
 with the said original Plat of said Village of Wetzell and that it is
 and exact duplicate thereof and of the whole of said original Plat
 John A. Hariman Register of Deeds
 Edward Helsten Surveyor

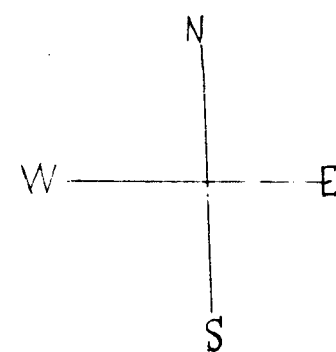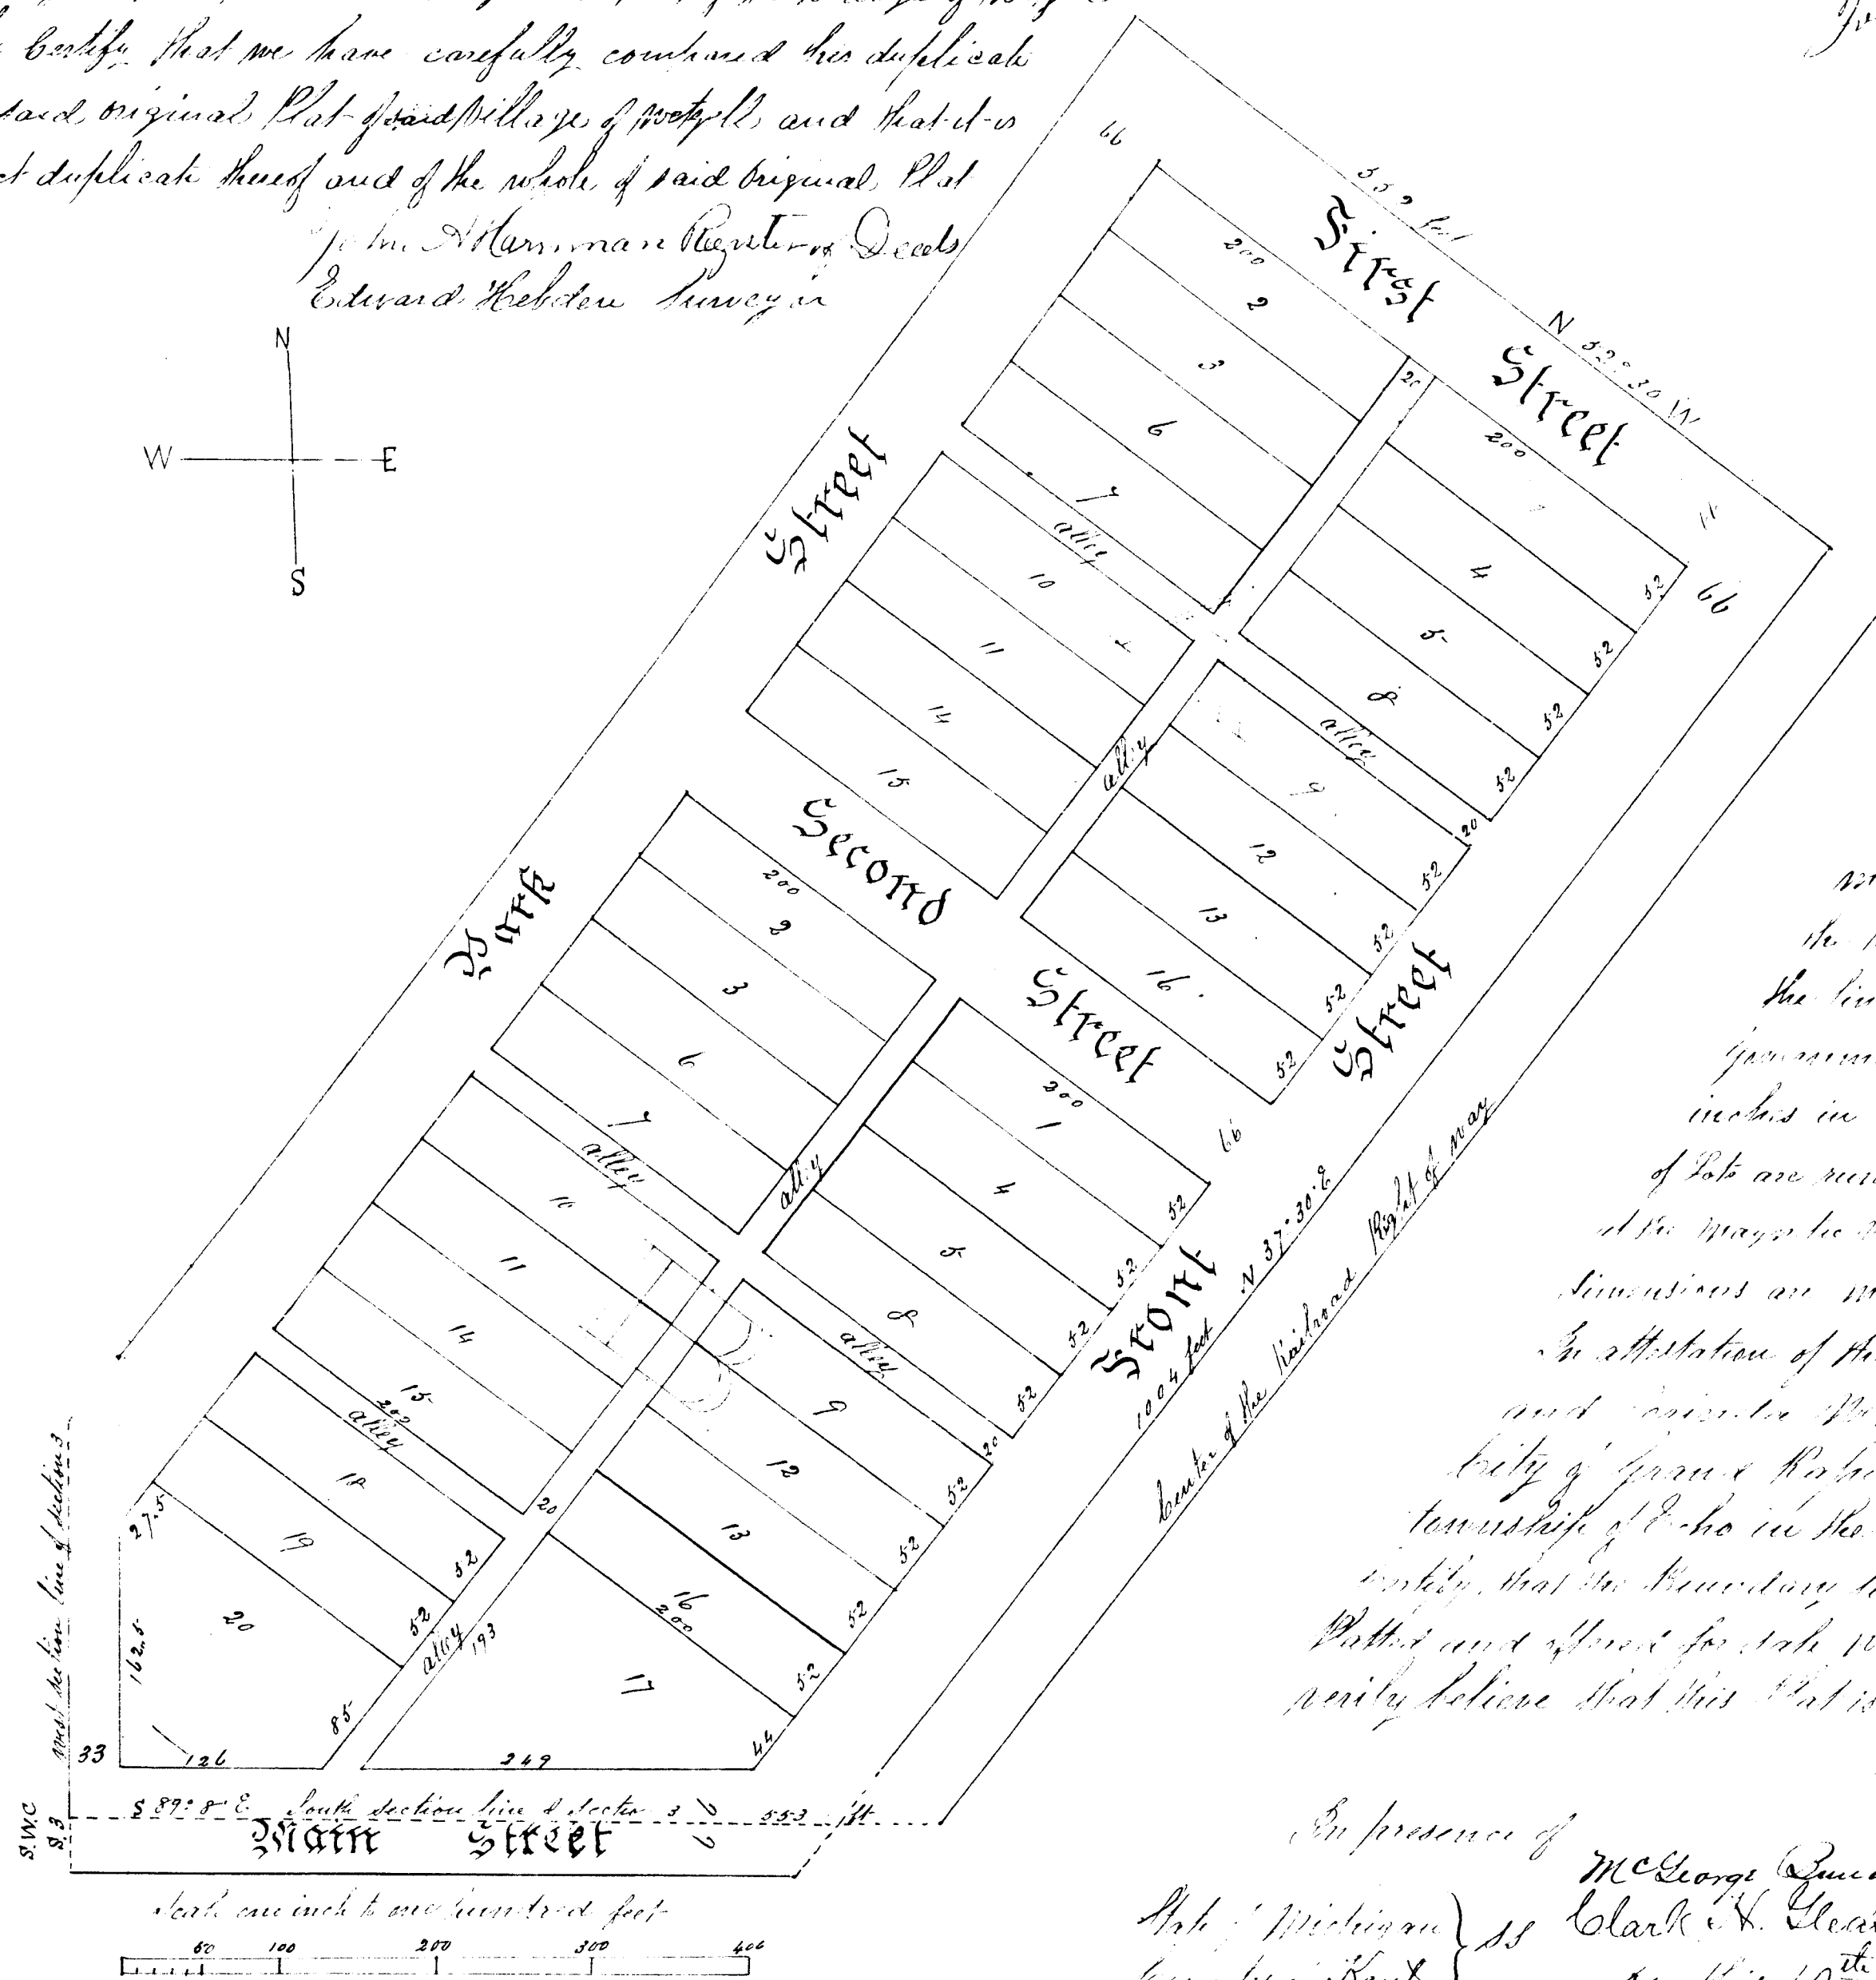

County of Antrim }
 Deeds for said County, and Edward Helsten
 the Surveyor who made the original Plat of the Village of Wetzell
 to hereby certify that we have carefully compared this duplicate
 with the said original Plat of said Village of Wetzell and that it is
 and exact duplicate thereof and of the whole of said original Plat
 John A. Hariman Register of Deeds
 Edward Helsten Surveyor

RECEIVED AND FILED
 in the
 Office of the
 Register of Deeds
 March 4, 1882
 J. A. Hariman
 Register of Deeds

PLAT of the Village of Wetzell Antrim County MICHIGAN

The Village of Wetzell as delineated by this Plat is situated on the South west one fourth of
 the South west one fourth of Section Three, in Township No. Twenty nine North of Range No. Six
 West within County Michigan. The South East corner of Lot No. sixteen Block B. is deter-
 mined by measuring East on the section line, five hundred and fifty three feet, to the center of
 the Railroad right of way; then North fifty two degrees and thirty minutes west and at right angles with
 the line of Railroad one hundred and sixteen feet, from the south west corner of said section which
 government corner was established from one original witness, and from which a Sugar tree twenty
 inches in diameter bears North sixty four degrees East twenty nine and one half feet distant. From said
 of Lot are run North thirty seven degrees and thirty minutes East, and North fifty two degrees and thirty minutes west
 at the same bearing of one degree East, etc. etc. as delineated by large letters with Red Ink. Lots by small figures
 dimensions are marked in feet and tenths, all shown right angles, excepting two fractional lots.
 In attestation of the laying out of the town Plat above described the Signatories thereof Henry B. Wetzell
 and Daniel M. Wetzell his wife, Daniel M. Wetzell and Mary H. Wetzell his wife, all of the
 City of Grand Rapids, in the County of Kent, and State of Michigan and Edward Helsten of the
 Township of Elio in the County of Antrim, in the State of Michigan who surveyed the said Village, do hereby
 certify that the boundary lines of said Village, and the Lots, Streets, Alleys, and Grounds, thereof intended to be
 Platted and shown for sale were actually surveyed and laid out in the month of December 1881, and they
 jointly believe that this Plat is a faithful representation of said Survey.

Witness their hands this 10th day of January 1882
 Henry B. Wetzell
 Daniel M. Wetzell
 Mary H. Wetzell
 Edward Helsten
 { Notaries
 Surveyor

On this 10th day of January 1882 before
 me the Subscribed Notary Public in and for said County
 personally appeared Henry B. Wetzell, and Daniel M. Wetzell his
 wife Daniel M. Wetzell and Mary H. Wetzell his wife to me known
 to be the same persons, who as Notaries in and who executed
 this instrument, who personally acknowledged such execution to be
 their act and deed and that they had laid out the town Plat above
 described and intended to show to the world and purchase therein mentioned
 given unto me about the day and year first above written.

Clark H. Henson
 Notary Public in and for Kent County Michigan

State of Michigan }
 County of Antrim }
 We John A. Hariman Register
 of Deeds and Edward Helsten Surveyor
 hereby certify that we have carefully compared the
 annexed Plat with the Plat of the Village of Wetzell
 now of Record in the Office of said Register of Deeds and
 that it is a true transcript herefrom and of the whole
 of such record
 John A. Hariman Register of Deeds
 Edward Helsten Surveyor

Township of Mancelona
P.O. Box 332
Mancelona, Michigan 49659
(616) 587-8651

14471

Township of Mancelona
P.O. Box 332
Mancelona, Michigan 49659
(616) 587-8651

4276
14471

RESOLUTION NUMBER 8, TOWNSHIP OF MANCILONA

THE VACATION OF ALLEYS IN BLOCK 'A', PLAT OF
THE VILLAGE OF WETZEL

WHEREAS: THE MANCILONA TOWNSHIP BOARD CONSIDERS IT ADVISABLE TO
ACT UPON A REQUEST BY TOWNSHIP RESIDENCES TO VACATE THE
THE FOLLOWING ALLEYS IN BLOCK 'A' OF THE PLAT OF THE
VILLAGE OF WETZEL, LOCATED IN SECTION 3, T29N, R6W,
TOWNSHIP OF MANCILONA.

ALLEY NO. 1
20 FEET WIDE AND 420 FEET IN LENGTH AND RUNS ACROSS
BLOCK 'A' IN A SOUTHEASTERLY DIRECTION FROM PARK STREET
TO FRONT STREET, SEPARATING LOTS 7 AND 8 FROM LOTS 9 AND 10,
PLAT OF THE VILLAGE OF WETZEL, TOWNSHIP OF MANCILONA.

ALLEY NO. 2
20 FEET WIDE AND 456 FEET IN LENGTH AND ALSO RUNS ACROSS
BLOCK 'A' IN A SOUTHWESTERLY DIRECTION FROM FIRST STREET
TO SECOND STREET SEPARATING LOTS 1, 4, 5, 8, 12, 13 AND 16
FROM LOTS 2, 3, 6, 10, 14, AND 15 PLAT OF THE VILLAGE OF
WETZEL, TOWNSHIP OF MANCILONA.

WHEREFORE: BE IT RESOLVED THAT THE MANCILONA TOWNSHIP BOARD, BY THIS
RESOLUTION, DOES HEREBY DECLARE THAT THE ALLEYS IN BLOCK 'A',
PLAT OF THE VILLAGE OF WETZEL LISTED IN THIS RESOLUTION, ARE
HEREBY VACATED.

THIS RESOLUTION WAS DULY ADOPTED AT THE REGULAR MANCILONA TWP.
BOARD MEETING HELD ON THE 20TH. DAY OF DECEMBER, 1993 BY THE
FOLLOWING ROLL CALL VOTE:
YAYS: 3, NAYS: 0, ABSENT: 2

MANCILONA TOWNSHIP CLERK, MANCILONA
MICHIGAN, I, MARGARET CHAPMAN, CLERK OF THE
TOWNSHIP OF MANCILONA, DO HEREBY
CERTIFY THE ABOVE IS A TRUE AND
EXACT COPY OF THE ORIGINAL RECORD
NOW REMAINING IN THIS OFFICE.
IN TESTIMONY WHEREOF, I HAVE
HEREUNTO SET MY HAND AND OFFICIAL
SEAL IN THE TOWNSHIP OF MANCILONA,
COUNTY OF ANTRIM, ON THIS 21ST. DAY
OF DECEMBER 1993.

Margaret Chapman
MARGARET CHAPMAN
MANCILONA TOWNSHIP CLERK

OFFICIAL SEAL
OF THE
TOWNSHIP OF
MANCILONA

The Regular Meeting of the Mancelona Township Board, December 20, 1993. Held in the
Township Meeting Room. Meeting called to order by Supervisor Herbert Nothstine at 7:00 P.M.
Roll call was taken: Present: Miessner, S. Nothstine and Herb Nothstine
Absent: Chapman and Ryder

Also Present: Elmer Grody

The Pledge of Allegiance was given.

Motion by Miessner supported by S. Nothstine to accept the minutes of the November meeting.
Motion carried with a yea and nay vote. Yes: Miessner, S. Nothstine, H. Nothstine No: None
Absent: Chapman and Ryder

Motion by Miessner supported by S. Nothstine that we adopt Resolution No.7, Entitled "An
Addendum to Liquor Control Commission Resolution, concerning 'Entertainment Permits' for
Establishments that are regulated by Mancelona Township Liquor Control". Motion passed
with a yea and nay vote: Yes: Miessner, S. Nothstine, H. Nothstine No: None
Absent: Chapman and Ryder

Motion by Miessner to grant "Loggers Inc." a Entertainment Permit without Dressing Rooms.
Motion supported by H. Nothstine. Motion passed with a yea and nay vote. Yes: Miessner,
S. Nothstine, H. Nothstine. NO: None Absent: Chapman and Ryder

Motion by S. Nothstine supported by Miessner to adopt Resolution No.6, Entitled
"Mancelona township bid Policy". Motion passed with a yea and nay vote: Yes: Miessner,
S. Nothstine, H. Nothstine. No: None Absent: Chapman and Ryder

Motion by Miessner supported by S. Nothstine to adopt Resolution No.8, Entitled "The
Vacation of ~~Two~~ Alleys in Block 'A', Plat of the Village of Wetzel, Located in Section 3,
T29N, R6W, Township Of Mancelona". Motion passed with a yea and nay vote: Yes: Miessner,
S. Nothstine, H. Nothstine. No: None Absent: Chapman and Ryder

Motion by S. Nothstine supported by Miessner to adopt the Mancelona Township Board Policy
Statement On Racial and/or Sexual Harassment. Motion passed with a Yea and Nay vote;
Yes: Miessner, S. Nothstine, H. Nothstine No: None Absent: Chapman and Ryder


Motion by S. Nothstine supported by Miessner to authorize pay request to the Commerce
Department in the amount of \$10,952.35, and to approve final pay request (No. 4) in the
amount of \$329.25 to D'Angelo & Son. Motion passed with a yea and nay vote; Yea: Miessner
S. Nothstine, H. Nothstine. No: None Absent: Chapman and Ryder.

Fire report given by Elmer Grody: 10 incidents for the month of November: 6 Fire
4 rescue. Discussed the need to get the tank repaired at Lakes of the North Tanker Truck.


Motion by Miessner supported by S. Nothstine to pay current bills. Motion passed with all
members present voting yes.

Motion by Miessner supported by S. Nothstine to adjourn at 8:03 P.M. Motion passed with all
members present voting yes.

Margaret Chapman, Clerk

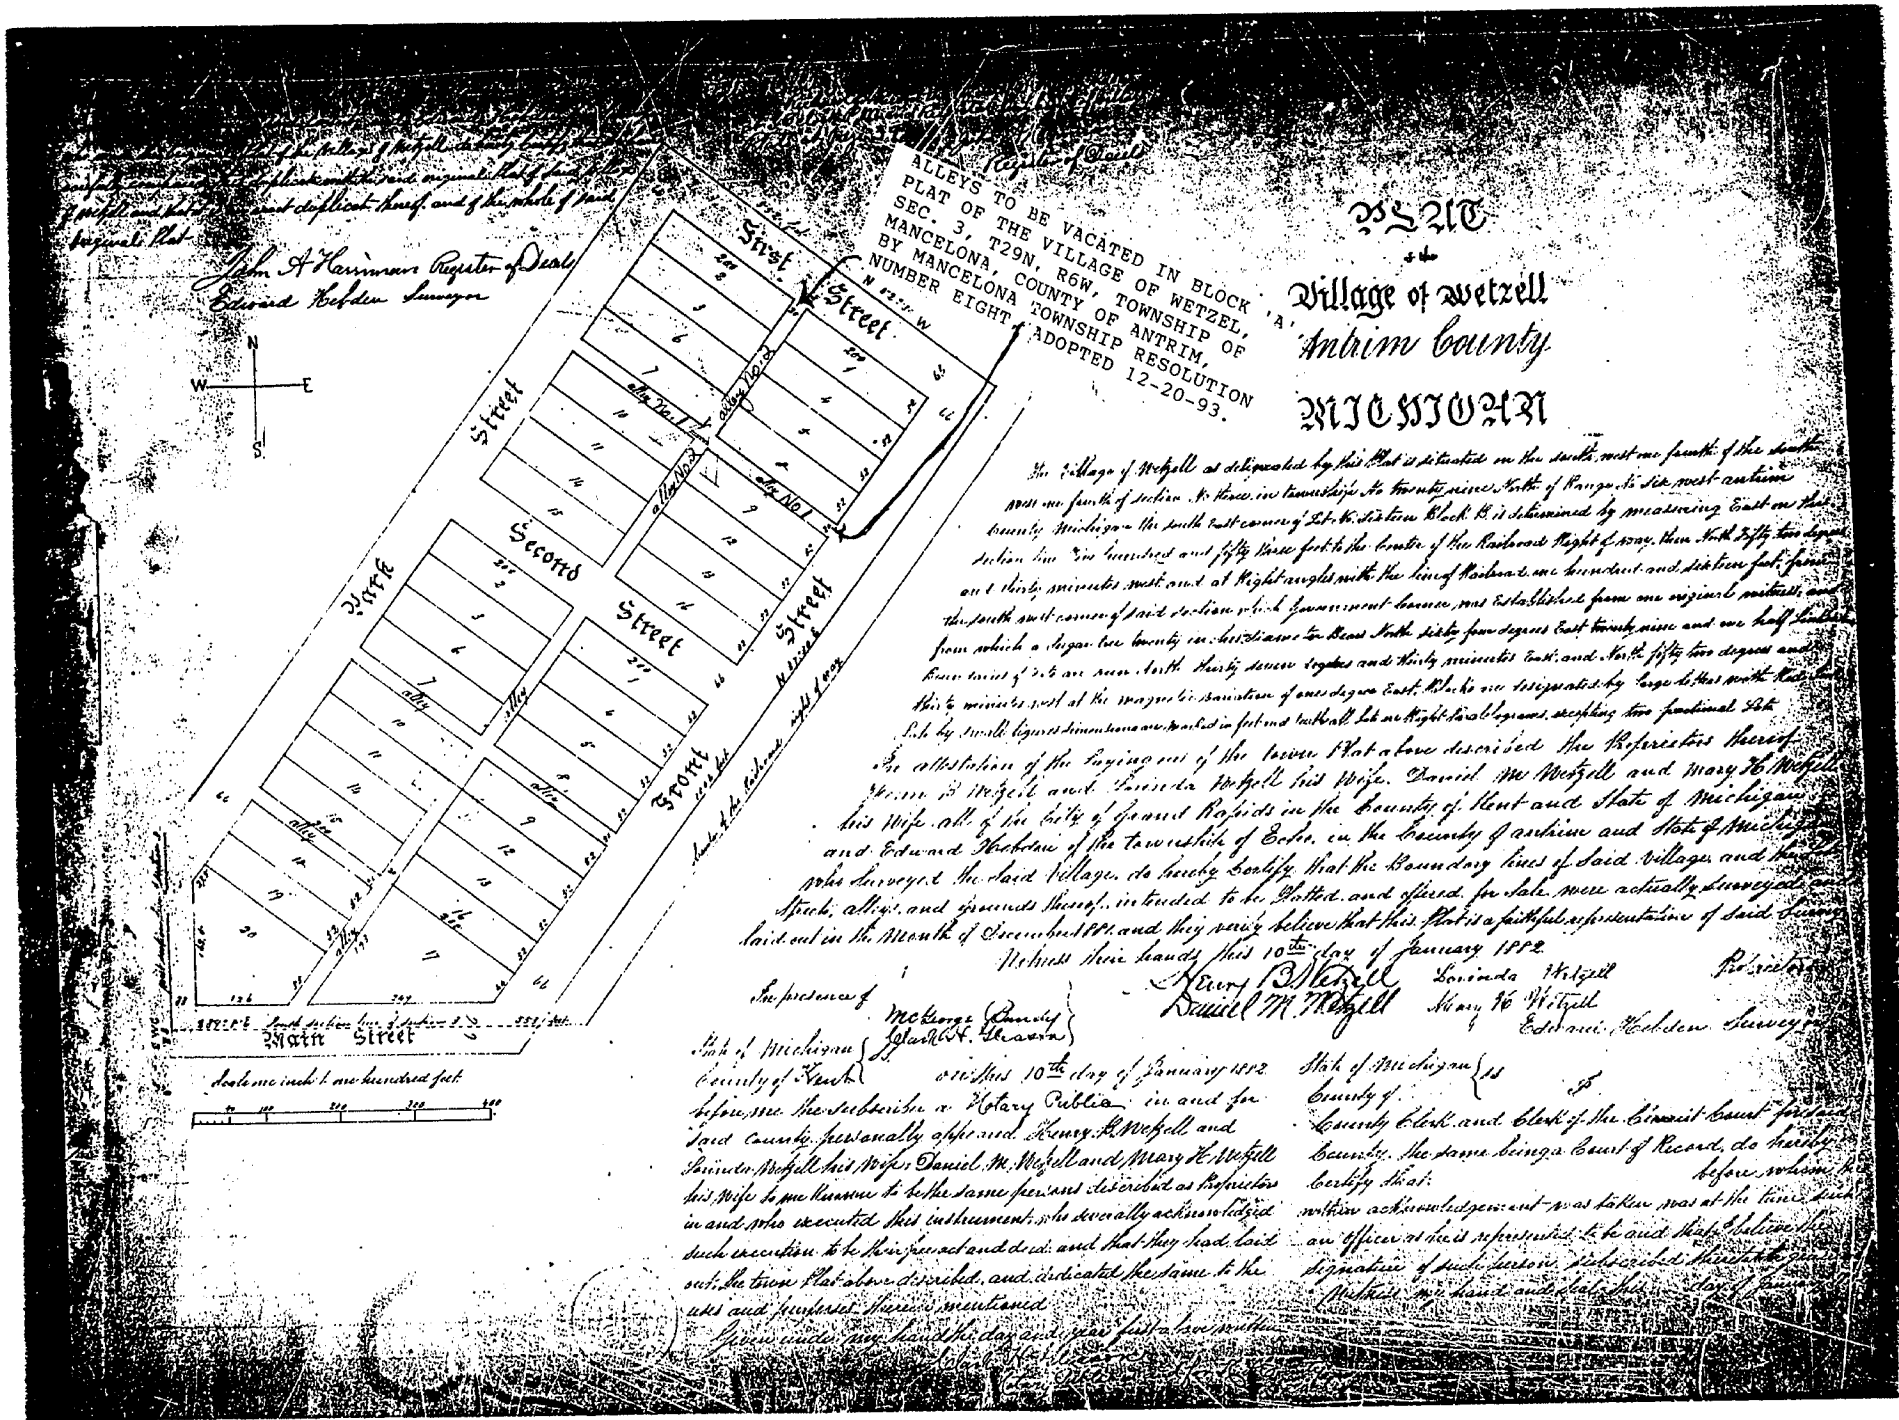

14471

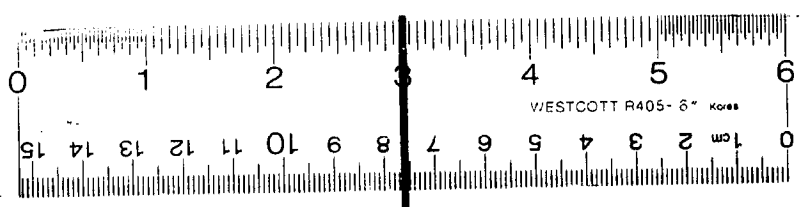

24 X