


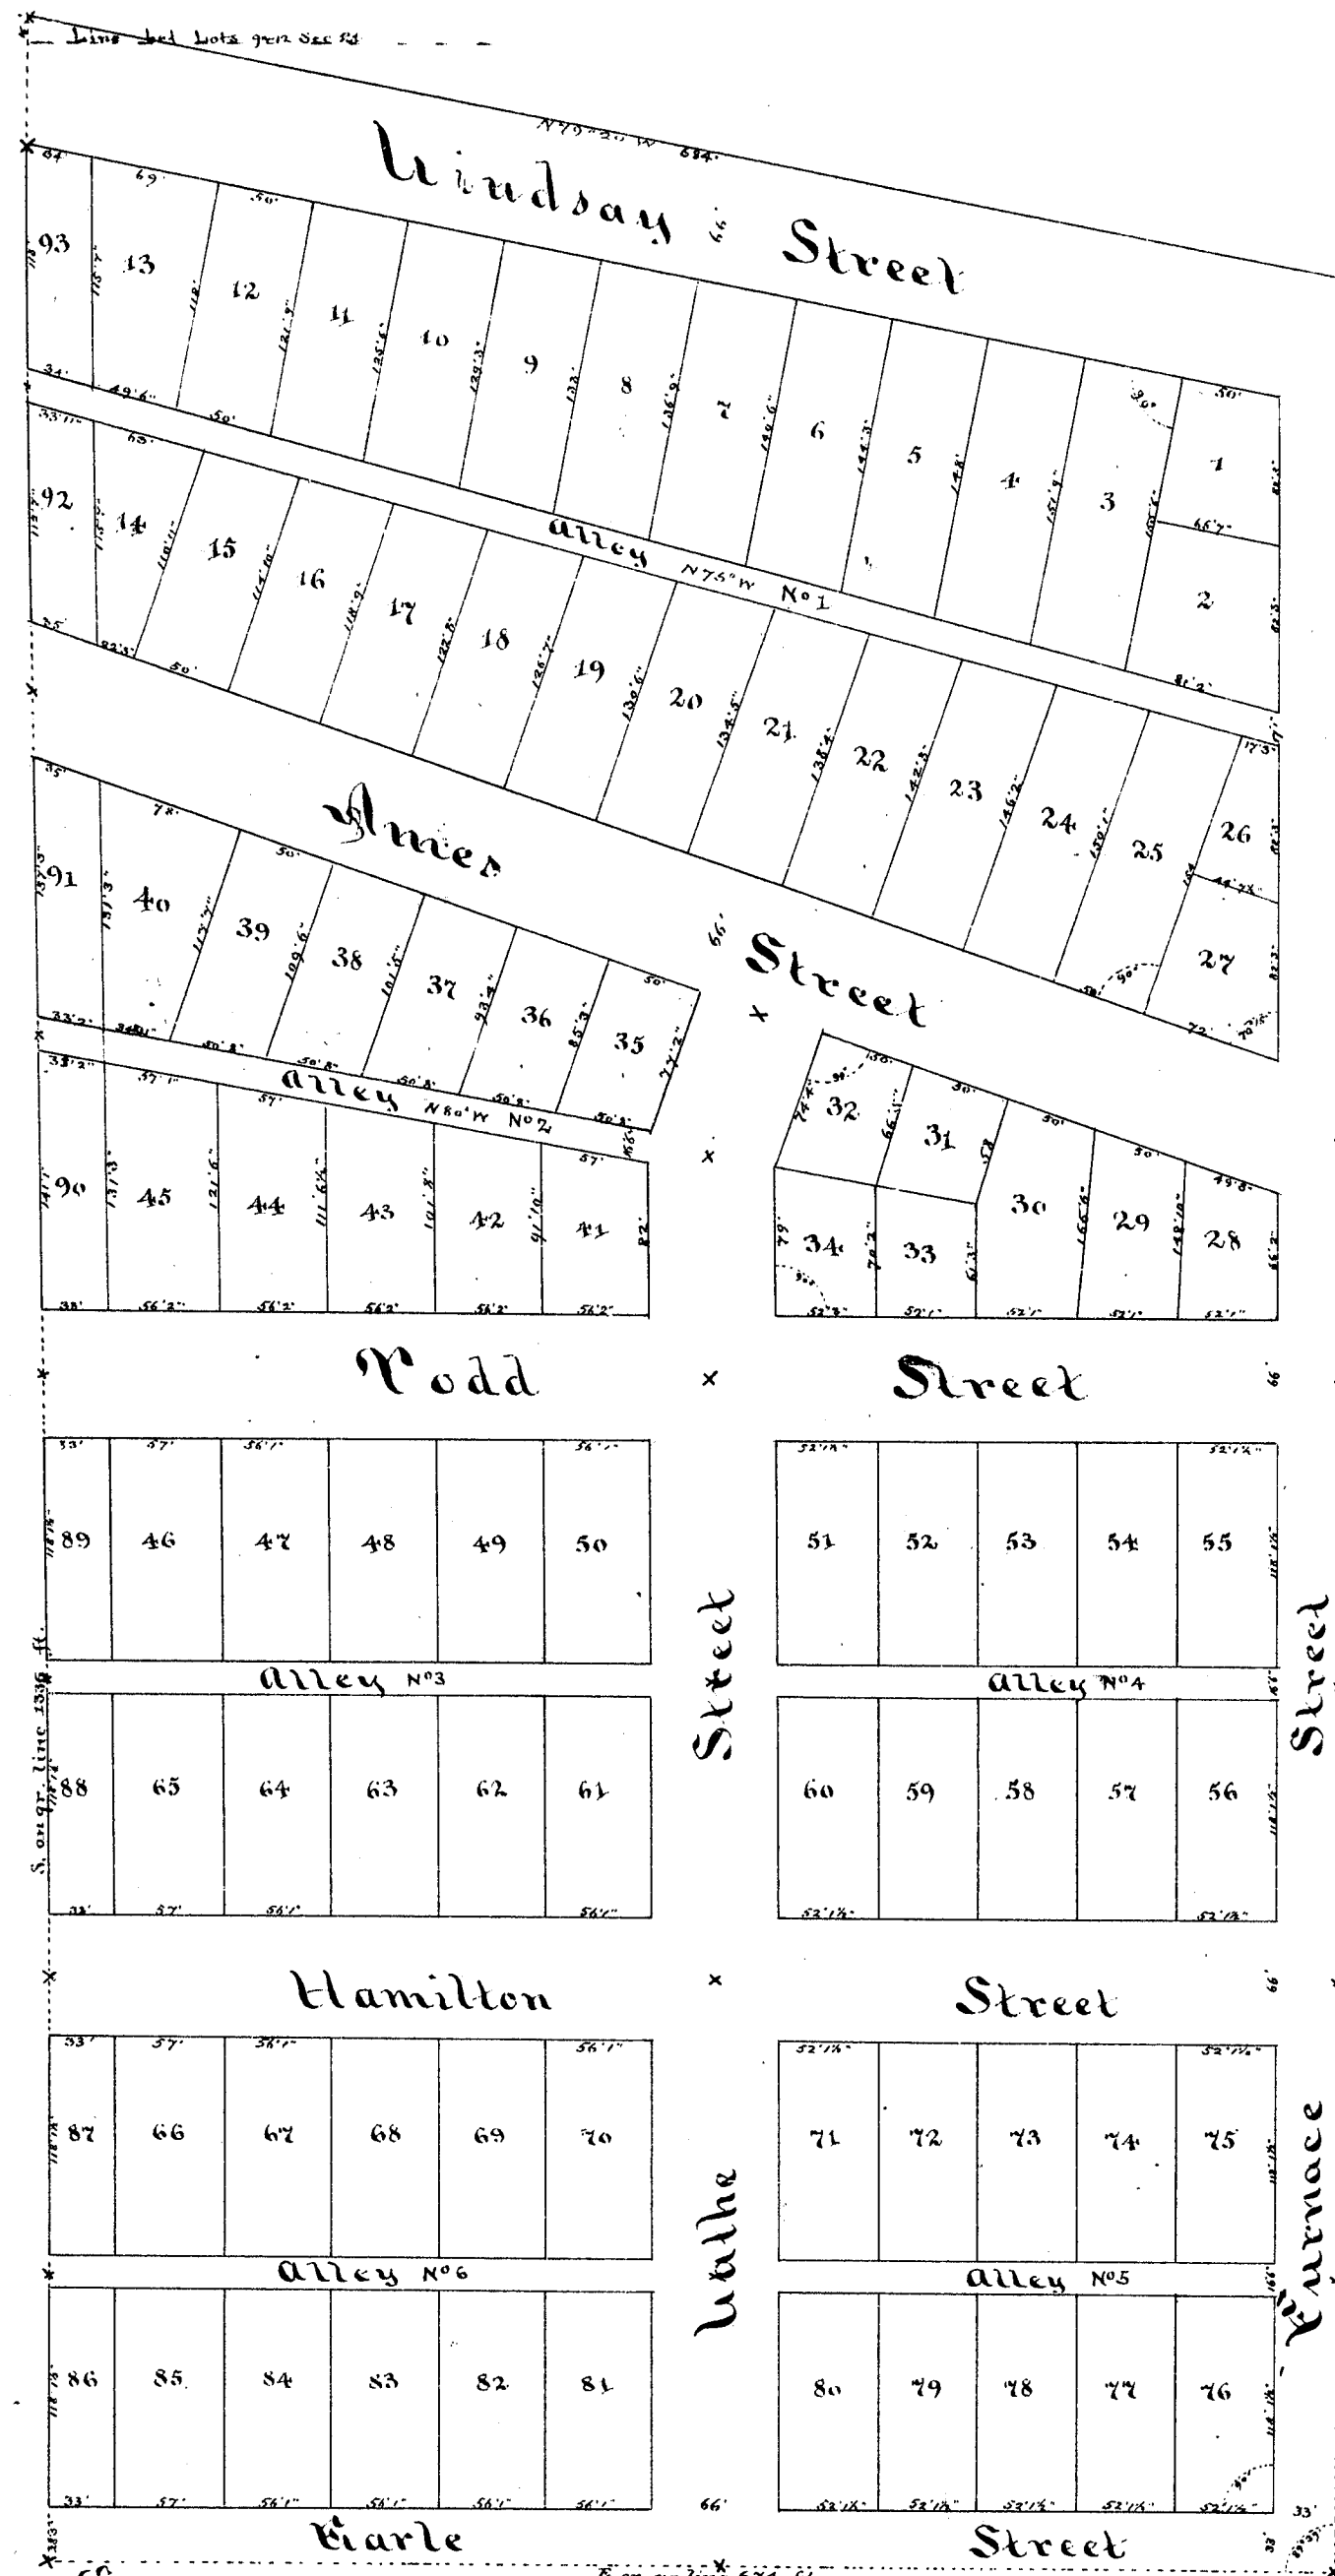

PLAT OF Rankin's Addition TO EAST ELK RAPIDS ANTRIM CO. MICH.

Received and Filed
IN AUDITOR GENERAL'S OFFICE.
May 22 1890
A.R. Pratt
Deputy Auditor General.

The Plat hereby delineated is situated on the West half of the Southwest quarter of the Northeast quarter (called also Lot 9) of section Twenty one (21) and a little of Lot 12 of the same section, of Township Twenty nine (29) North of Range Nine (9) West, Antrim Co. Michigan, and is more particularly defined as follows: Commencing at the centre of said section, thence East on quarter line six hundred and seventy-four feet to one-sixteenth line; thence North on one-sixteenth line twelve hundred and twelve and eight tenths feet; thence North seventy nine degrees and twenty minutes West six hundred and eighty four feet, or to quarter line; thence South on the North and South quarter line of said section thirteen hundred and thirty six feet to place of beginning. This Plat was first drawn with one half a street on the West, which, before execution of the Plat, was made into Lots 86 to 93 inclusive.

In dedication hereof, the Proprietor, James E. Rankin (sole), has caused the above described parcel of land to be surveyed, laid out and platted, to be known as Rankin's Addition to EAST ELK RAPIDS and now sets apart the streets and alleys shown on said plat, to the use of the public for highways, and hereby attaches his signature and seal to this original Plat, with due attestation, this 25th day of February 1890.

Signed and sealed in presence of:

Eugene Hill.
Gitch R. Williams.

James E. Rankin. L.S.

State of Michigan, ss.
County of Antrim.

On this 25th day of February 1890 before me, a Notary Public in and for said County, personally came the above named James E. Rankin (sole), known to me to be the person who executed the above dedication, and acknowledged the same to be his free act and deed.

Gitch R. Williams
Notary Public Antrim Co. Mich.

I hereby certify that this Plat is a correct representation of an actual survey made by me, and that permanent monuments of iron have been put down at the points marked thus x.

Registers Office,
Antrim County, ss.

Received for record this 19 day of May A.D. 1890 at 9 o'clock A.M. and recorded in Liber B of Village Plats on page 97

Geo. E. Steele
Surveyor.

M. W. Nulkins
Register of Deeds.

Examined and Approved
March 17 1890
A.R. Pratt
Deputy Auditor General

State of Michigan, ss.
County of Antrim.

We M. W. Nulkins Register of Deeds and Geo. E. Steele Surveyor hereby certify that we have each carefully compared this copy with the original plat of Rankin's Addition to East Elk Rapids, and that it is an exact copy thereof and of the whole of such original map or plat.


M. W. Nulkins
Geo. E. Steele
Register of Deeds
Surveyor.

State of Michigan, ss.
County of Antrim.

We M. W. Nulkins Register of Deeds and Geo. E. Steele Surveyor hereby certify that we have each carefully compared the annexed copy with the plat of Rankin's Addition to East Elk Rapids, now of record in the office of said Register of Deeds, and that it is a true transcript therefrom and of the whole of the same record.

M. W. Nulkins
Geo. E. Steele
Register of Deeds
Surveyor.

14500

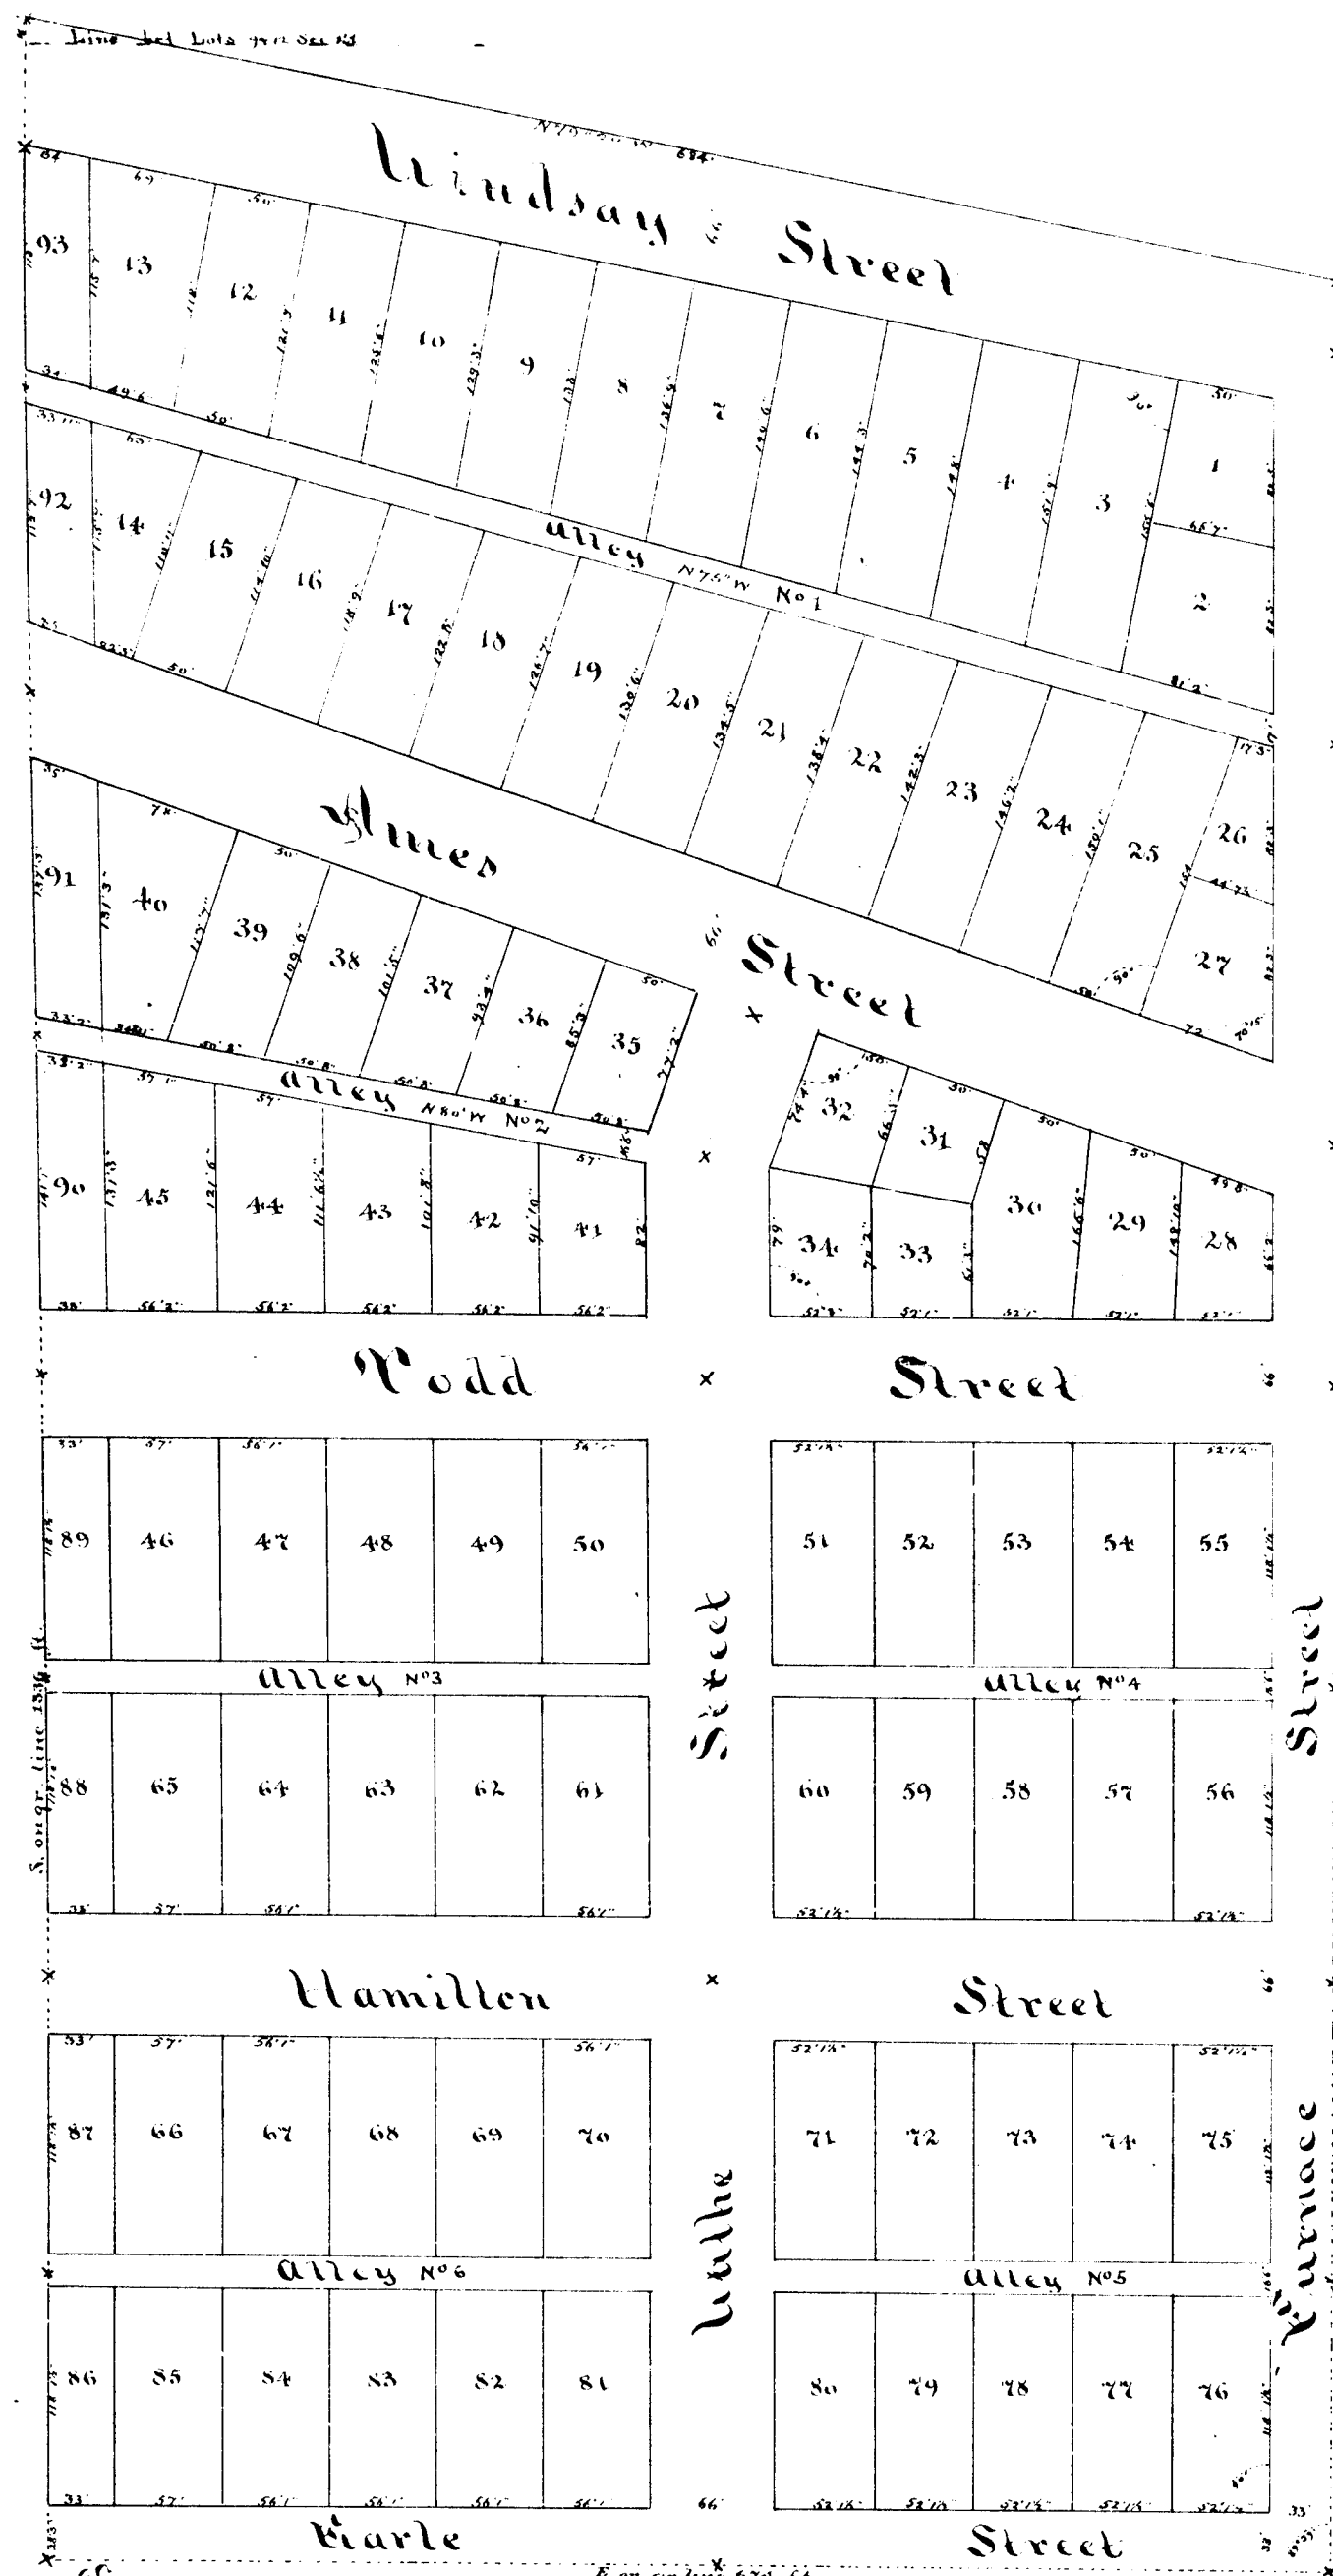

PLAT OF Rankin's Addition TO EAST ELK RAPIDS ANTRIM CO. MICH.

Received and Filed
IN AUDITOR GENERAL'S OFFICE
May 22 1890
H. R. Pratt
Deputy Auditor General.

The Plat hereby delineated is situated on the West half of the Southwest quarter of the Northeast quarter (called also Lot 9) of section Twentyone (21) and a little of Lot 12 of the same section, of Township Twenty-nine (29) North of Range Nine (9) West, Antrim Co. Michigan, and is more particularly defined as follows: Commencing at the centre of said section, thence East on quarter line six hundred and seventy-four feet to one sixteenth line; thence North on one sixteenth line twelve hundred and eighty-eight feet to the first; thence North seventy nine degrees and twenty minutes West six hundred and eighty four feet, or to quarter line; thence South on the North and South quarter line of said section thirteen hundred and thirty five feet to place of beginning.

This Plat was first drawn with one half a street on the West, which, before execution of the Plat, was made into Lots 86 to 93 inclusive.

In dedication hereby, the Proprietor James E. Rankin (sole), has caused the above described parcel of land to be surveyed, laid out and platted, to be known as Rankin's Addition to EAST ELK RAPIDS and now sets apart the streets and alleys shown on said plat, to the use of the public for highways, and hereby attests his signature and seal to this original Plat, with due attestation, this 25th day of February 1890.

Signed and Sealed in presence of:
James E. Rankin. P.S.

Eugene Hill.
Gilch R. Williams.

State of Michigan, ss.
County of Antrim.

On this 25th day of February 1890 before me, a Notary Public in and for said County, personally came the above named James E. Rankin (sole), known to me to be the person who executed the above dedication, and acknowledged the same to be his free act and deed.

Gilch R. Williams
Notary Public, Antrim Co. Mich.

I hereby certify that this Plat is a correct representation of an actual survey made by me, and that permanent monuments of iron have been put down at the points marked thus x

Registers Office
Antrim County, ss.
in Liber B of Village Plats on page 97

Geo. E. Steele
Surveyor.

Received for record this 19 day of May A.D. 1890 at 9 o'clock A.M. and recorded

M. W. Newkirk
Register of Deeds.

Examined and Approved
March 17 1890
H. R. Pratt
Deputy Auditor General

State of Michigan, ss.
County of Antrim.

We M. W. Newkirk, Register of Deeds, and Geo. E. Steele, Surveyor, hereby certify that we have each carefully compared this copy with the original plat of Rankin's Addition to East Elk Rapids, and that it is an exact copy thereof and of the whole of such original map or plat.

M. W. Newkirk
Geo. E. Steele

Register of Deeds
Surveyor.

State of Michigan, ss.
County of Antrim.

We M. W. Newkirk, Register of Deeds, and Geo. E. Steele, Surveyor, hereby certify that we have each carefully compared the annexed copy with the plat of Rankin's Addition to East Elk Rapids, now of record in the office of said Register of Deeds, and that it is a true transcript therefrom and of the whole of the record.

M. W. Newkirk
Geo. E. Steele

Register of Deeds
Surveyor.

Scale, 100 ft. to 1 in.

14500

3-176
3-214

STATE OF MICHIGAN
COUNTY OF ANTRIM

LIBER 372 PG. 0968

DATE: 3/3/92

I, Elaine A. Glowicki, being duly sworn, depose
and say that I am the Village Clerk of the Village of Elk
Rapids, that the

Resolution 92-15

a copy of which is hereunto attached, has been adopted at

the Regular Council Meeting held on: 3-2-92

at the Village Offices, 131 River St., Elk Rapids, MI 49629

Prepared by: Elaine A. Glowicki

Elaine A. Glowicki, Clerk
Village of Elk Rapids, P.O. Box 398, Elk Rapids, MI 49629

Jurat or Acknowledgement

STATE OF MICHIGAN

COUNTY OF ANTRIM

ANTRIM COUNTY
MICHIGAN
RECEIVED FOR RECORD

92 MAR -4 PM 1:36

Wanda G. Conway
REGISTER OF DEEDS

On this 3rd day of March in the year one thousand nine
hundred and 92, before me, the subscriber, in and for said
County, personally appeared Elaine A. Glowicki to me known
to be the same person described in, and who executed the within
instrument, who has acknowledged the same to be her free act
and deed.

Mary E. Chile Notary Public

March 3 19 92

My Commission expires: 19

ANTRIM COUNTY MICHIGAN

MARY E. CHILE, NOTARY PUBLIC
ANTRIM COUNTY, MICHIGAN
MY COMMISSION EXPIRES 6-8-92

LIBER 372 PG. 0969

14500

RESOLUTION 92-15 ALLEY VACATION

WHEREAS: THE VILLAGE COUNCIL OF THE VILLAGE OF ELK RAPIDS
CONSIDERS IT ADVISABLE TO VACATE THE ALLEY BOUNDED
BY PROPERTY 05-43-275-002-15 (FISHER) AND
05-43-275-002-10 (BACHI) TO THE NORTH, 05-43-275-003-00
(GLINSKI) TO THE SOUTH AND WEST TO OLDS ST IN THE
PAULIN'S ADDITION TO EAST ELK RAPIDS, AND

WHEREAS: A WIDTH OF APPROXIMATELY TEN FEET (10') FOR THE ENTIRE
LENGTH, WHICH EXTENDS FROM THE EAST BOUNDARY OF
05-43-275-002-10, APPROXIMATELY SEVENTY-FOUR FEET (74')
TO THE WEST BOUNDARY OF OLDS ST., AND

THEREFORE: BE IT RESOLVED THAT THE VILLAGE COUNCIL OF THE VILLAGE
OF ELK RAPIDS DOES HEREBY DECLARE AND BY THIS RESOLUTION
DOES VACATE THE WIDTH OF APPROXIMATELY TEN FEET (10')
OF THE ENTIRE LENGTH, WHICH EXTENDS FROM THE EAST
BOUNDARY TO THE WEST BOUNDARY OF OLDS ST.

YAYS: 6 NAYS: 0 ABSENT: 1


ADOPTED AT THE REGULAR COUNCIL MEETING HELD ON
MARCH 2, 1992.

Elaine A. Glowicki

I, ELAINE A. GLOWICKI, VILLAGE CLERK, DO HEREBY
CERTIFY THAT THE ABOVE RESOLUTION 92-15, WAS
DULY ADOPTED AT THE REGULAR COUNCIL MEETING HELD
ON 3/2/92. RESOLUTION DECLARED ADOPTED

LIBER 372 PG. 0970 MORTGAGE REPORT

14500

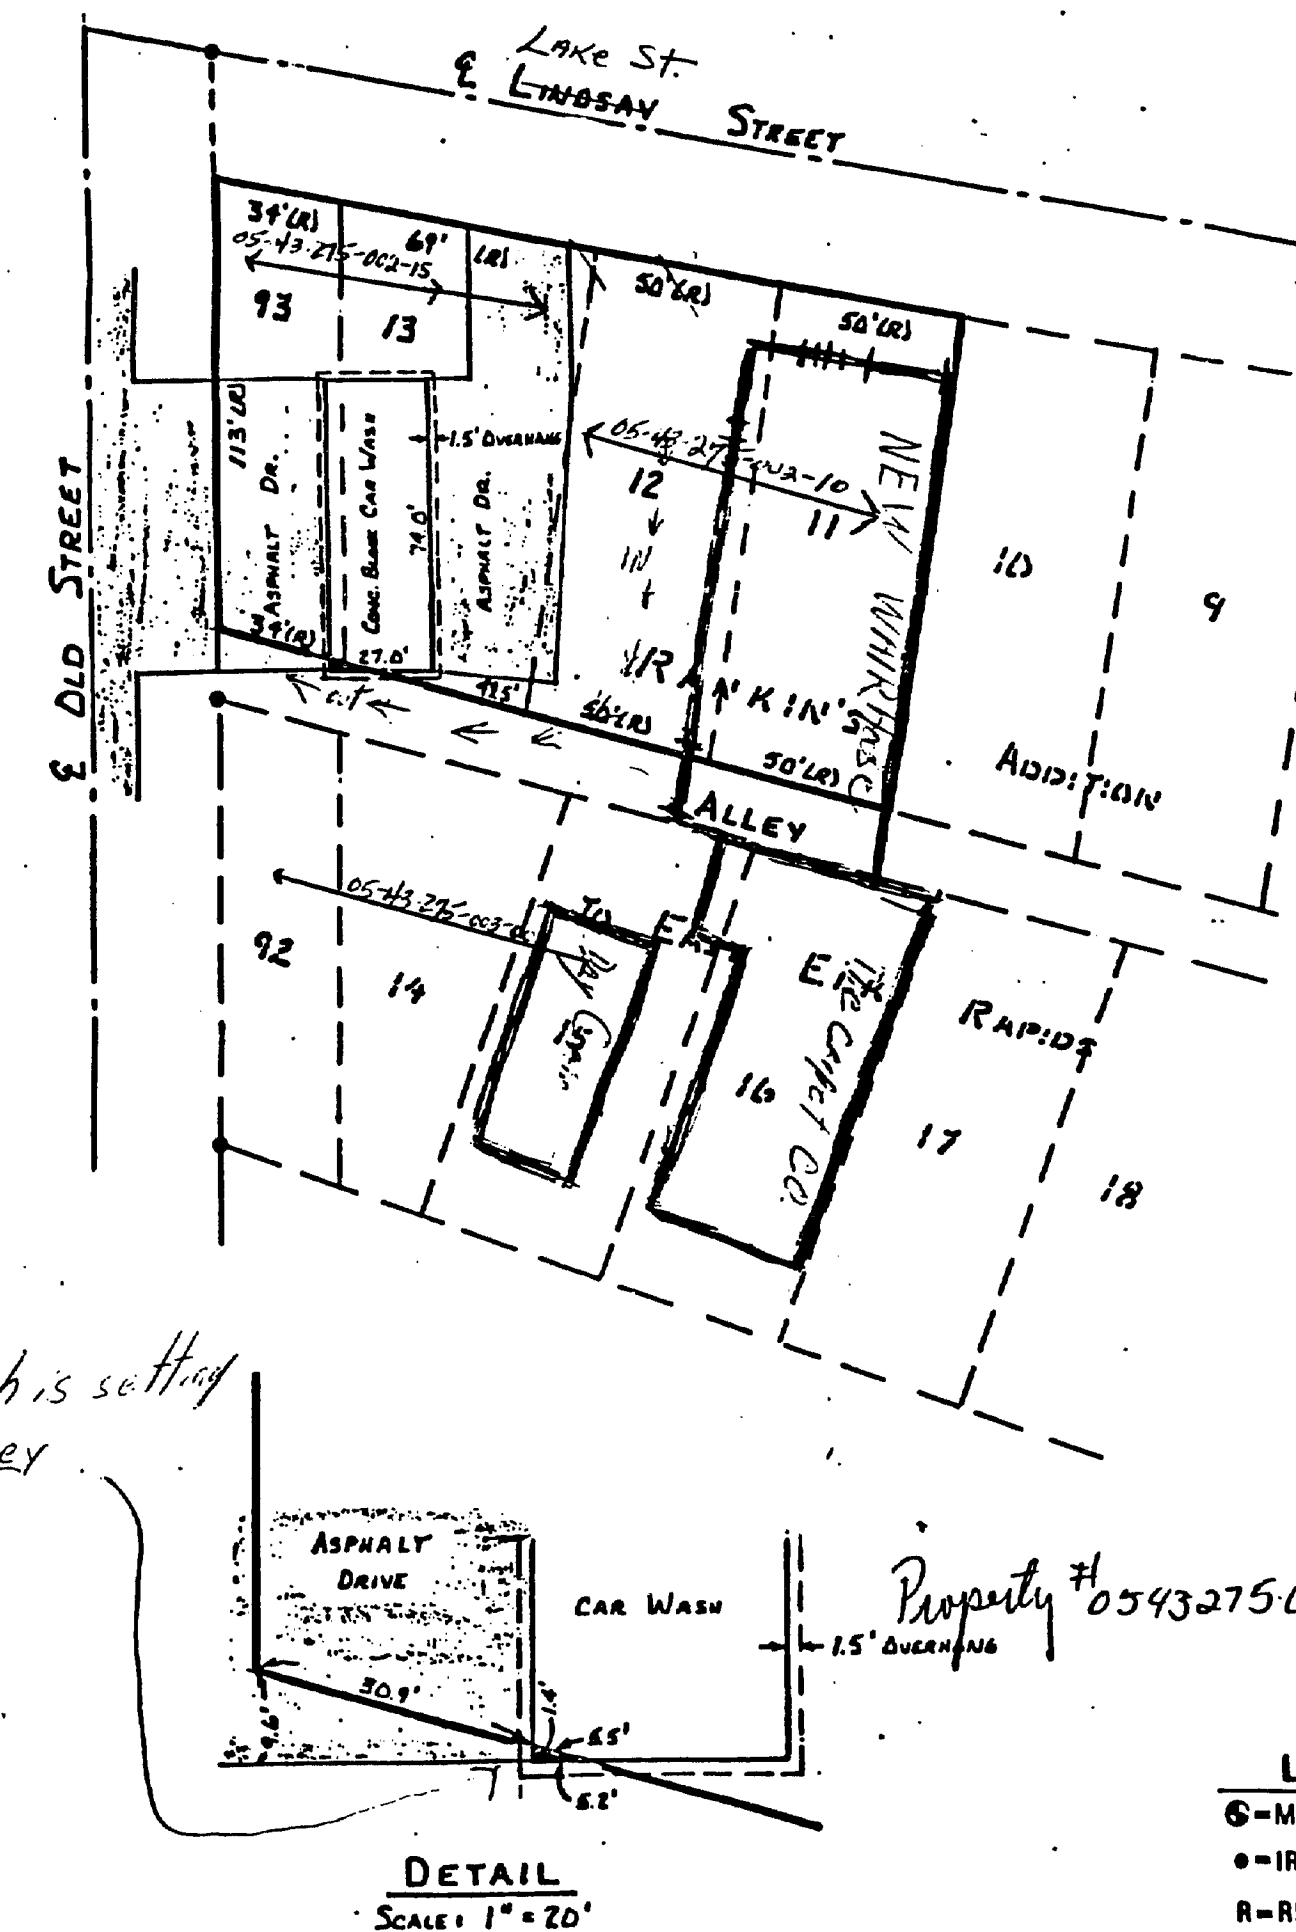


car wash is sitting
in ALLEY

N

DETAIL
SCALE: 1" = 20'

LI
6-MC
0-IRC
R-RE

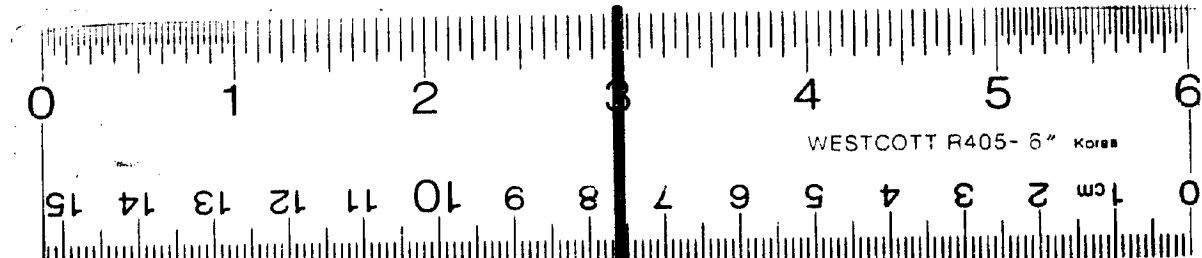

16 X