


Township N. V North, Range N. XV East of Mer. (Mich. Ter.)

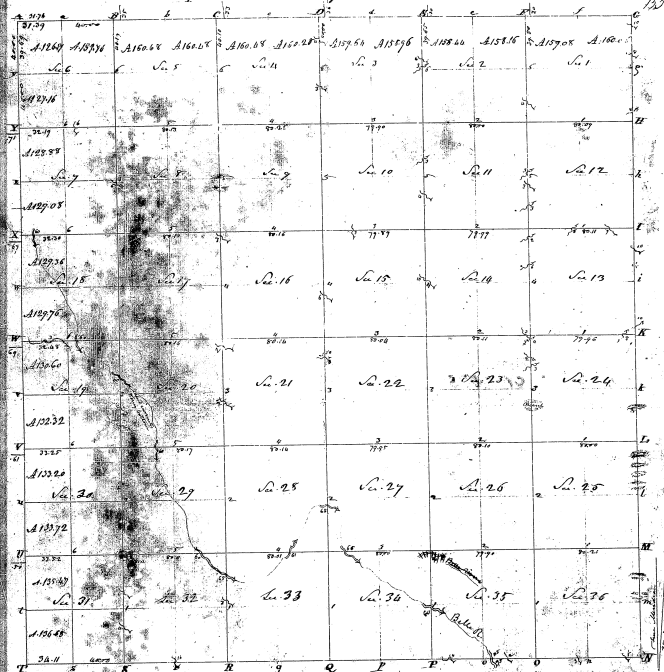

Pursuant to a contract with and Instructions from General Officer James G. Thompson of the United States having date the 20th day of November 1818 I have advanced laid out and surveyed the above described Township and hereby certify that it had such marks and bounds both natural and artificial as are represented on said Plat and described in the plat, maps made hereof and thereunto with the Plat to the Surveyor General's Office. Certified this 25th day of April 1819  
 Wm. D. P. D. S.

26-28

26-28