


11/18/13

FROM ALLEGAN DAM #1

60

(For witnesses)
See P. 7. SE Cor. Sec. 13
Heath Twp.

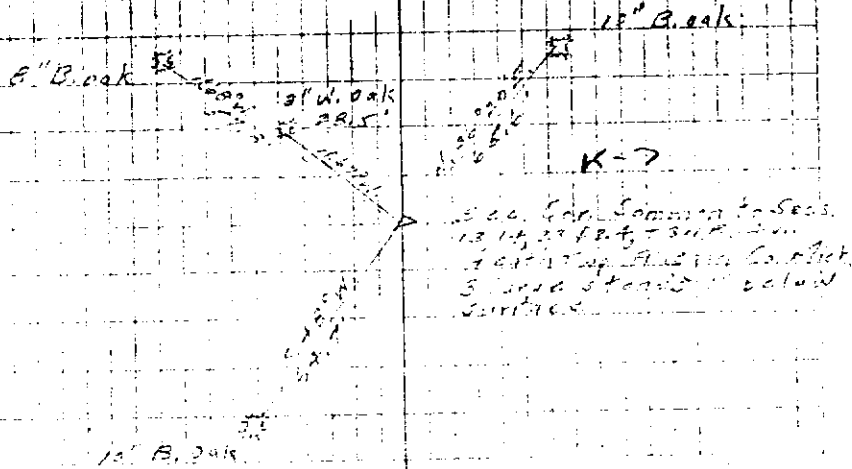

482