

**ALLEGAN COUNTY REMONUMENTATION
LAND CORNER RECORDATION CERTIFICATE
Filing Requirement of Act 74, Mich. P.A. 1970**

LIBR0006 PAGE 375

For corners in <u>Allegan</u> <small>(County)</small>	Located In:	Corner Code #
1. Public Land Survey	T4N ___ R15W ___ T ___ R ___ T ___ R ___ T ___ R ___	L-13 South 1/4 cor. Sec. 36, Fillmore Twp.
2. Property Controlling in Section	S ___ T ___ R ___ S ___ T ___ R ___	_____
3. Miscellaneous Property in Sec.	S ___ T ___ R ___ S ___ T ___ R ___	_____

FILED
1/28/1999 2:44:39 PM
JOYCE A. WATTS
Register of Deeds Stamp & File Number
ALLEGAN COUNTY, MICH

4. Lot No. _____, Recorded Plat _____
5. Private Claims _____

I, Steve Lampen _____, in a field survey on December 4, 1998, do hereby certify that under requirements of P.A. 74, Michigan P.A. of 1970, the corner points mentioned in lines 1 and 2 above were in conformance with regulations and rules therefore as required in the current manual of survey instructions of the United States Department of the Interior, Bureau of Land Management or by a decree of a Court of Law and/or that the corner points mentioned in lines 3, 4 and 5 above were in conformance with the rules of the Michigan Board of Land Surveyors or by a Decree of a Court of Law; established, re-established, monumented, re-monumented, recovered, found as expressed below:

NOTE: Not more than 4 corners, all in the same town and range, may be recorded on this certificate.

A. Description of original monument and accessories and/or subsequent restoration:
L-13 Survey - L1243, P23 - VanOrder - 1987
GLO - Lyon-Sibley - 1831 Found 1" steel rod in monument box
Set HMP Power pole N 34.00
Beech 7 N 72 E 24 Centerline monument box E 10.12
Beech 10 N 57 W 98 21" Walnut SE 34.40
Telephone pole SW 78.50

Road Commission
Stone
Telephone pole SW 48.0
Telephone pole N 25.9

B. Description of corner evidence found and/or method applied in restoring or reestablishing corner:
L-13 Found 3/4" iron in monument box.
Power pole N 34.0
Centerline monument box E 10.12
21" Walnut SE 34.4
Telephone pole SW 78.50


Replaced iron with 3/4"x24" Allegan County Remonumentation iron and cap and is accepted as a careful and Faithful perpetuation of the position of the original corner.

This corner was approved by the Allegan County Remonumentation Peer Group on December 8, 1998.

APPROVED REMONUMENTATION CORNER
P.A. 345 OF 1990
ALLEGAN COUNTY
DATE APPROVED DEC. 8, 1998
COUNTY REP. [Signature]

C. Description of monument for corner and accessories established to perpetuate locating the position of the corner:
L-13 3/4" Allegan County Remonumentation iron and cap in monument box.
Azimuth = Michigan State Plane grid direction.

Power pole Remonumentation tag in E side	3° 16'	34.61
SW corner house, brick	129° 58'	144.82
NE corner, house, brick	164° 09'	124.32
NE corner house, brick	184° 52'	109.79
NW corner house, brick	220° 27'	116.07
L-1, T3N, R15W	91° 32'	10.15

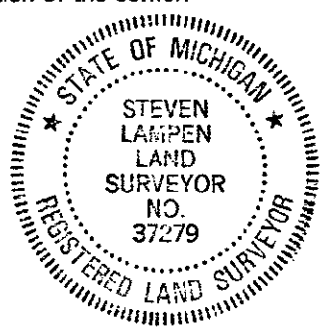

Signed by Steven Lampen Date JANUARY 11, 1999
Surveyor's Michigan License No. 37279